


SHEET WS-9

| CURVE NO. | DELTA     | RADIUS   | LENGTH  | TANGENT | DESCRIPTION |
|-----------|-----------|----------|---------|---------|-------------|
| 1         | 18°59'33" | 1175.00' | 389.49' | 196.55' | CENTERLINE  |
| 2         | 18°24'37" | 1900.00' | 610.51' | 307.91' | CENTERLINE  |
| 3         | 09°17'06" | 1165.00' | 188.79' | 94.60'  | SEWER MAIN  |
| 4         | 09°42'25" | 1165.00' | 197.37' | 98.92'  | SEWER MAIN  |
| 5         | 02°10'18" | 1910.00' | 72.39'  | 36.20'  | SEWER MAIN  |

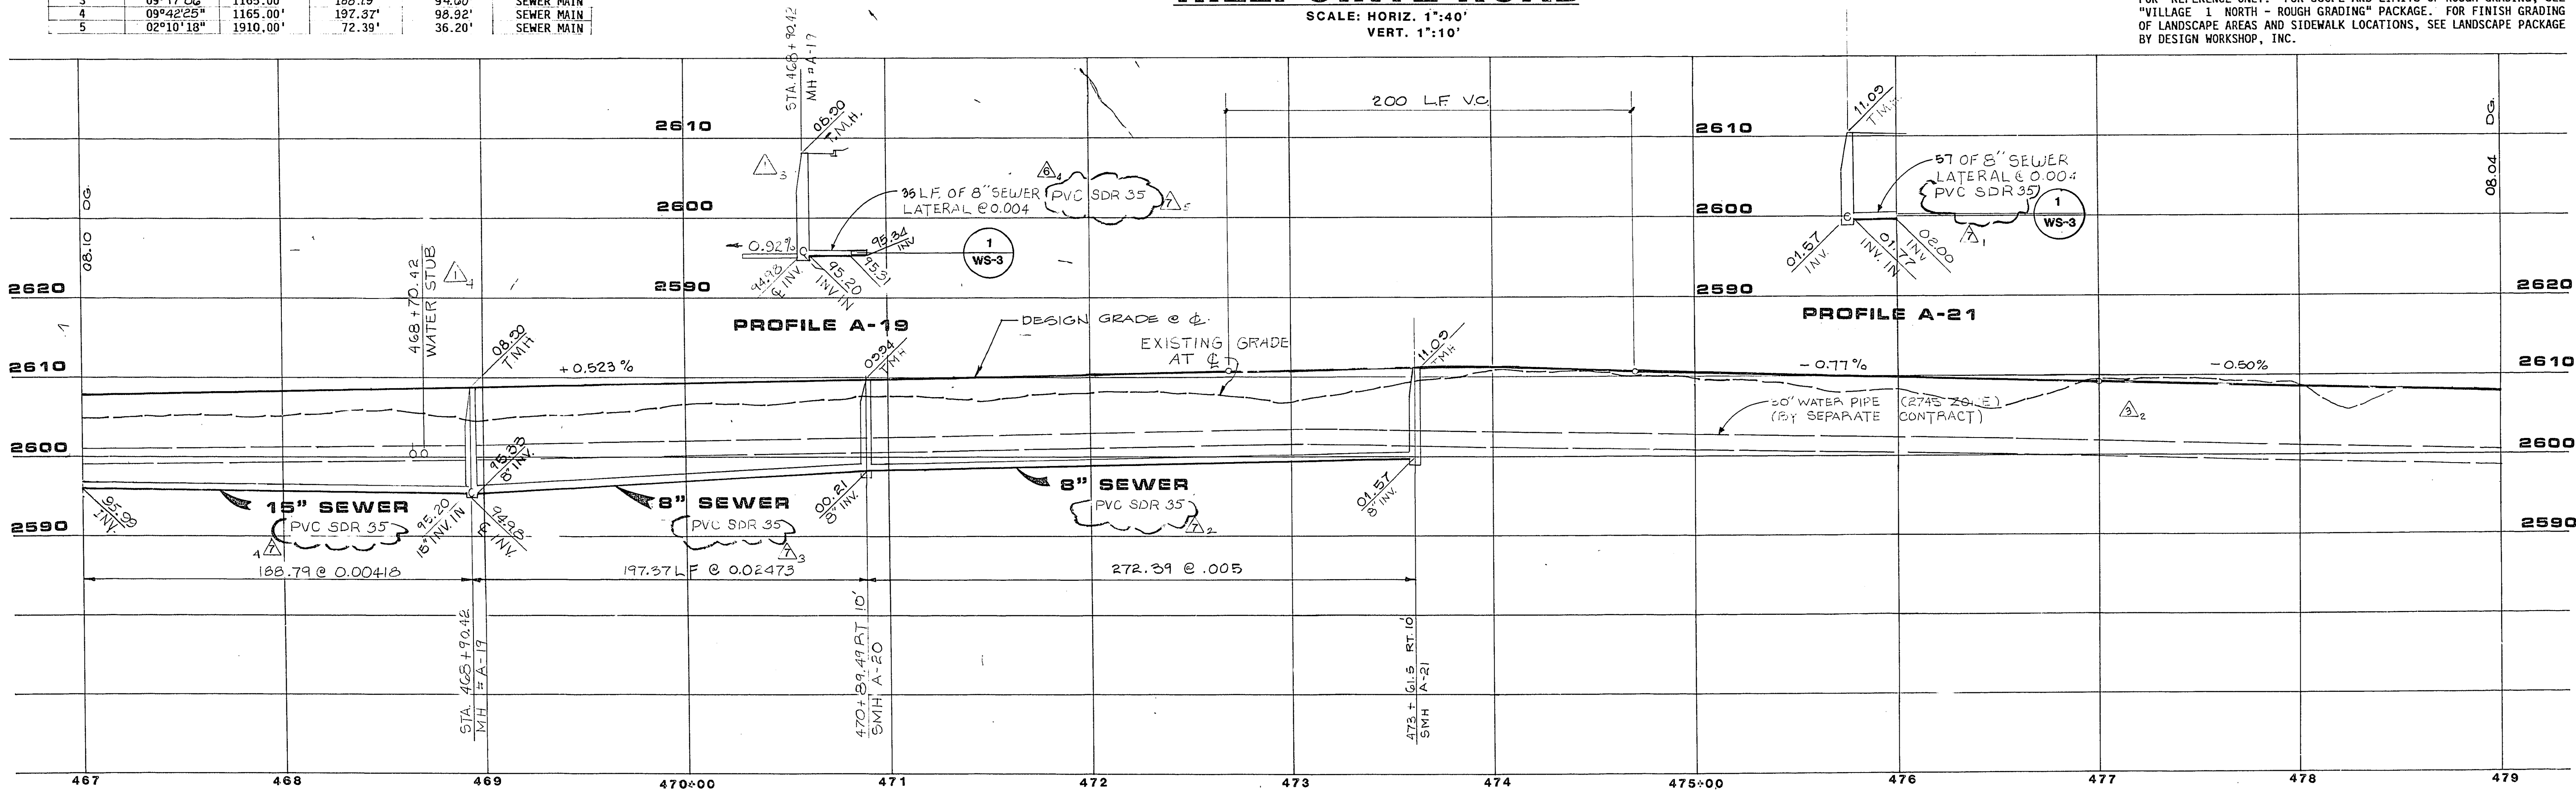

# HILLPOINTE ROAD

SCALE: HORIZ. 1"=40'  
VERT. 1"=10'

NOTE: THESE PLANS ARE FOR THE PURPOSE OF ROADWAY IMPROVEMENTS AND UTILITIES (PAVEMENT WITH BASE CURB AND GUTTER, STORM DRAIN, WATER, SEWER, ETC.). ALL ROADWAY AND LANDSCAPE AREAS HAVE BEEN PREVIOUSLY ROUGH GRADED. ANY LIMITS OF ROUGH GRADING SHOWN ARE FOR REFERENCE ONLY. FOR SCOPE AND LIMITS OF ROUGH GRADING, SEE "VILLAGE 1 NORTH - ROUGH GRADING" PACKAGE. FOR FINISH GRADING OF LANDSCAPE AREAS AND SIDEWALK LOCATIONS, SEE LANDSCAPE PACKAGE BY DESIGN WORKSHOP, INC.

CONTRACTOR WESTERN STATES DATE 5/16/90

RECORD DRAWINGS  
THESE PLANS SHOW RECORD INFORMATION RECEIVED FROM:

G.C. WALLACE, INC.  
Engineering/Architecture

HOWARD HUGHES PROPERTIES  
VILLAGE 1 NORTH  
WATER AND SEWER PLAN & PROFILE  
HILLPOINTE ROAD  
STA. 467+00 TO 479+00

SHEET 1/2

WS-9  
12 OF 24 SHEETS

307-V651