


CURVE NO.	DELTA	RADIUS	LENGTH	TANGENT	DESCRIPTION
1	80°58'14"	650.00'	918.58'	554.86'	CENTERLINE
2	00°22'55"	656.00'	4.37'	2.19'	SEWER MAIN
3	29°33'31"	656.00'	336.43'	173.07'	SEWER MAIN
4	48°21'21"	630.00'	531.70'	282.84'	WATER MAIN

RECORD DRAWINGS
THESE PLANS SHOW RECORD INFORMATION RECEIVED FROM:

CONTRACTOR WESTERN STATES DATE 5/16/90


THIS DATA MAY OR MAY NOT REFLECT THE ACTUAL FIELD LOCATIONS. ALL DATA SHOULD BE CONFIRMED PRIOR TO USE ON DEVELOPMENT OR ENGINEERING PLANS.

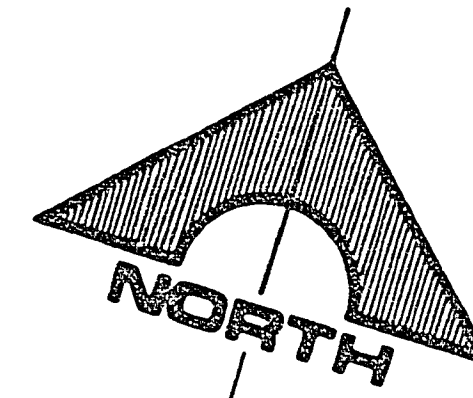

PINEWOOD HILLS DRIVE STREET "B"

SCALE: HORIZ. 1" = 40'
VERT. 1" = 10'

NOTE: THESE PLANS ARE FOR THE PURPOSE OF ROADWAY IMPROVEMENTS AND UTILITIES (PAVEMENT WITH BASE CURB AND GUTTER, STORM DRAIN, WATER, SEWER, ETC.). ALL ROADWAY AND LANDSCAPE AREAS HAVE BEEN PREVIOUSLY ROUGH GRADED. ANY LIMITS OF ROUGH GRADING SHOWN ARE FOR REFERENCE ONLY. FOR SCOPE AND LIMITS OF ROUGH GRADING, SEE "VILLAGE 1 NORTH - ROUGH GRADING" PACKAGE. FOR FINISH GRADING OF LANDSCAPE AREAS AND SIDEWALK LOCATIONS, SEE LANDSCAPE PACKAGE BY DESIGN WORKSHOP, INC.

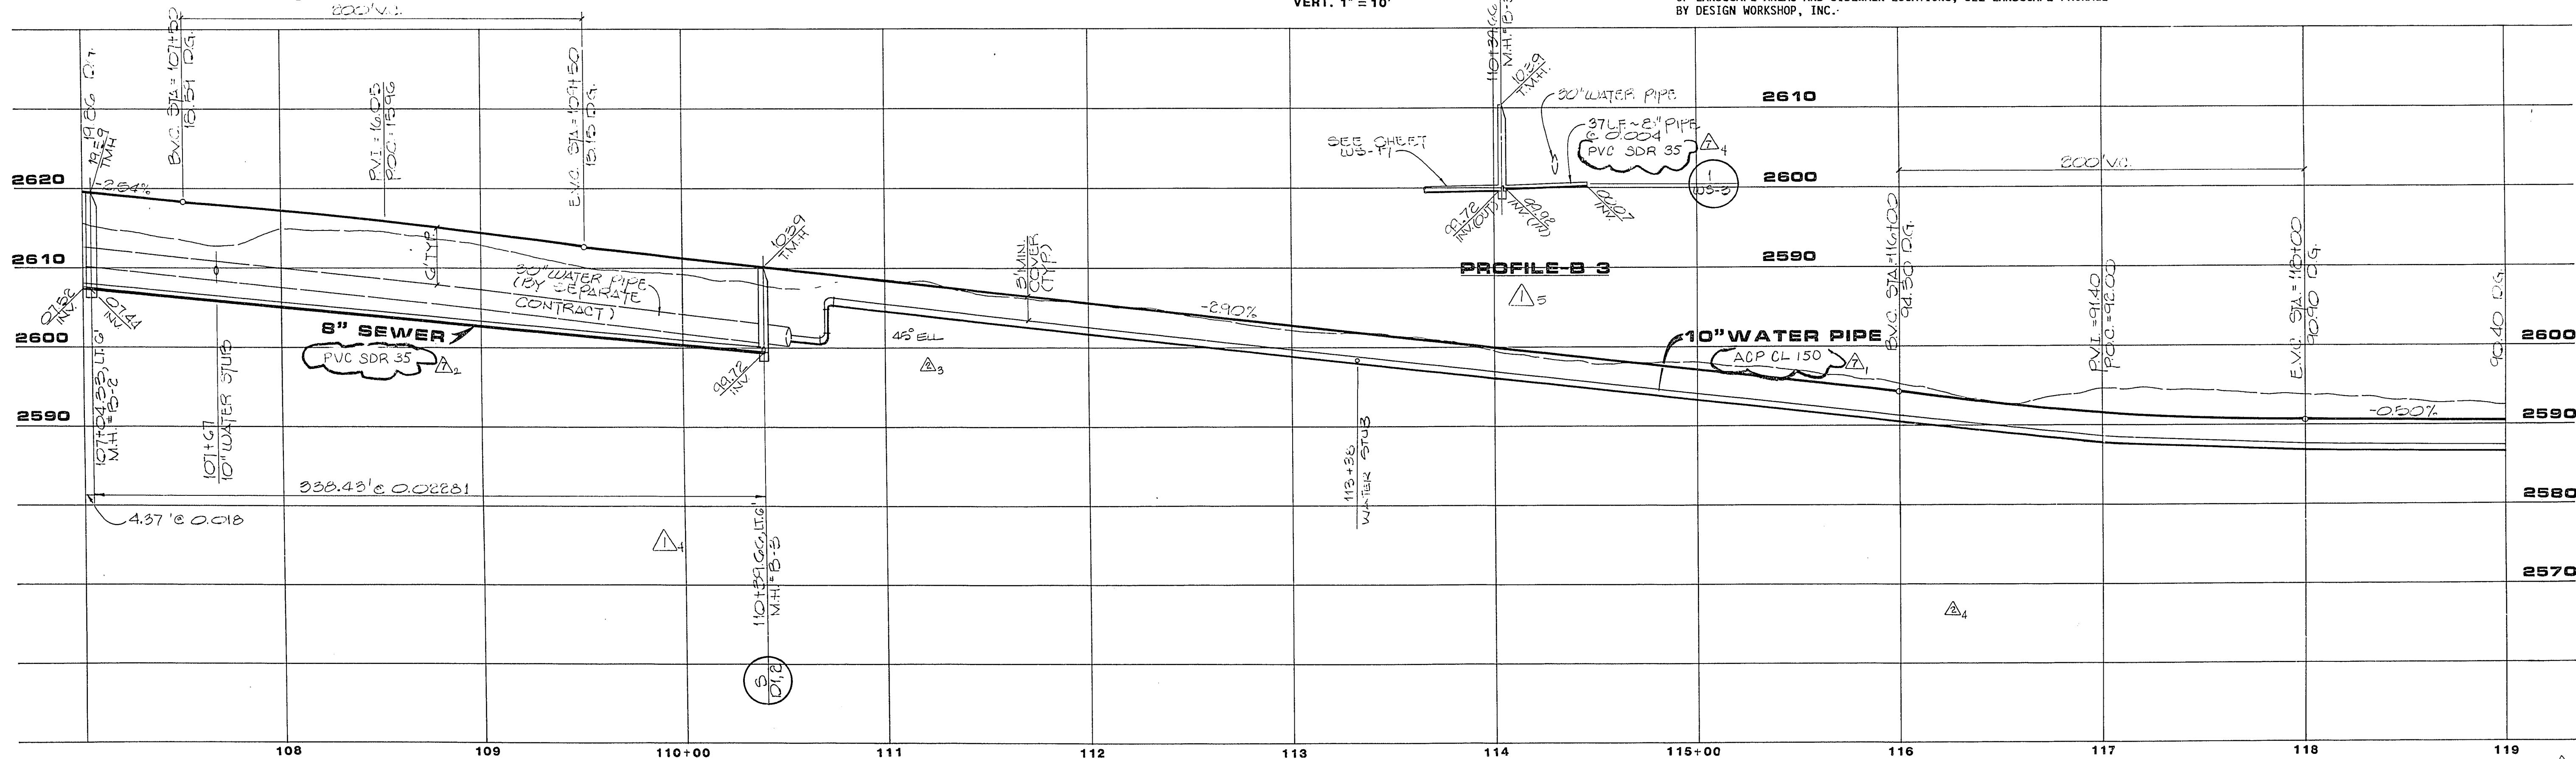

5/16/90 AS-BUILT 11/11/90 REVISIONS LVWD 82-14/15		DATE 5/16/90	REV 1	DESCRIPTION ISSUE TO BID WATER/SEWER ADDENDUM #2 ISSUE FOR CONSTRUCTION CHANGE ORDER #0 CHANGE ORDER #1
RECOMMENDED BY Christopher W. Anderson 6-22-90		DATE 6-22-90	REV 1	DESCRIPTION ISSUE FOR CONSTRUCTION CHANGE ORDER #0 CHANGE ORDER #1
G.C. WALLACE, INC. Engineering/Architecture				
PINEWOOD HILLS DRIVE HOWARD HUGHES PROPERTIES VILLAGE 1 NORTH WATER AND SEWER PLAN & PROFILE STA. 107+00 TO 119+00				
SHEET 15 WS-12 15 OF 24 SHEETS				

8-30-89
 LAS VEGAS VALLEY WATER DISTRICT

35-1-146
 307-V651