


SHEET WS-13

CURVE NO.	DELTA	RADIUS	LENGTH	TANGENT	DESCRIPTION
1	85°12'34"	650.00'	966.67'	597.80'	CENTERLINE
2	85°12'34"	630.00'	936.93'	579.41'	WATER MAIN
3	14°54'56"	650.00'	170.77'	85.87'	SEWER

PARCEL "NFC"
 RECORD DRAWINGS
 THESE PLANS SHOW RECORD INFORMATION RECEIVED FROM:
 CONTRACTOR WESTERN STATES DATE 5/16/90

THIS DATA MAY OR MAY NOT REFLECT THE ACTUAL FIELD LOCATIONS. ALL DATA SHOULD BE CONFIRMED PRIOR TO USE ON DEVELOPMENT OR ENGINEERING PLANS.
GLENSIDE DRIVE STREET "B"
 SCALE: HORIZ. 1"=40'
 VERT. 1"=10'

NOTE: THESE PLANS ARE FOR THE PURPOSE OF ROADWAY IMPROVEMENTS AND UTILITIES (PAVEMENT WITH BASE CURB AND GUTTER, STORM DRAIN, WATER, SEWER, ETC.). ALL ROADWAY AND LANDSCAPE AREAS HAVE PREVIOUSLY BEEN ROUGH GRADED. ANY LIMITS OF ROUGH GRADING SHOWN ARE FOR REFERENCE ONLY. FOR SCOPE AND LIMITS OF ROUGH GRADING, SEE "VILLAGE 1 NORTH - ROUGH GRADING" PACKAGE. FOR FINISH GRADING OF LANDSCAPE AREAS AND SIDEWALK LOCATIONS, SEE LANDSCAPE PACKAGE BY DESIGN WORKSHOP, INC.

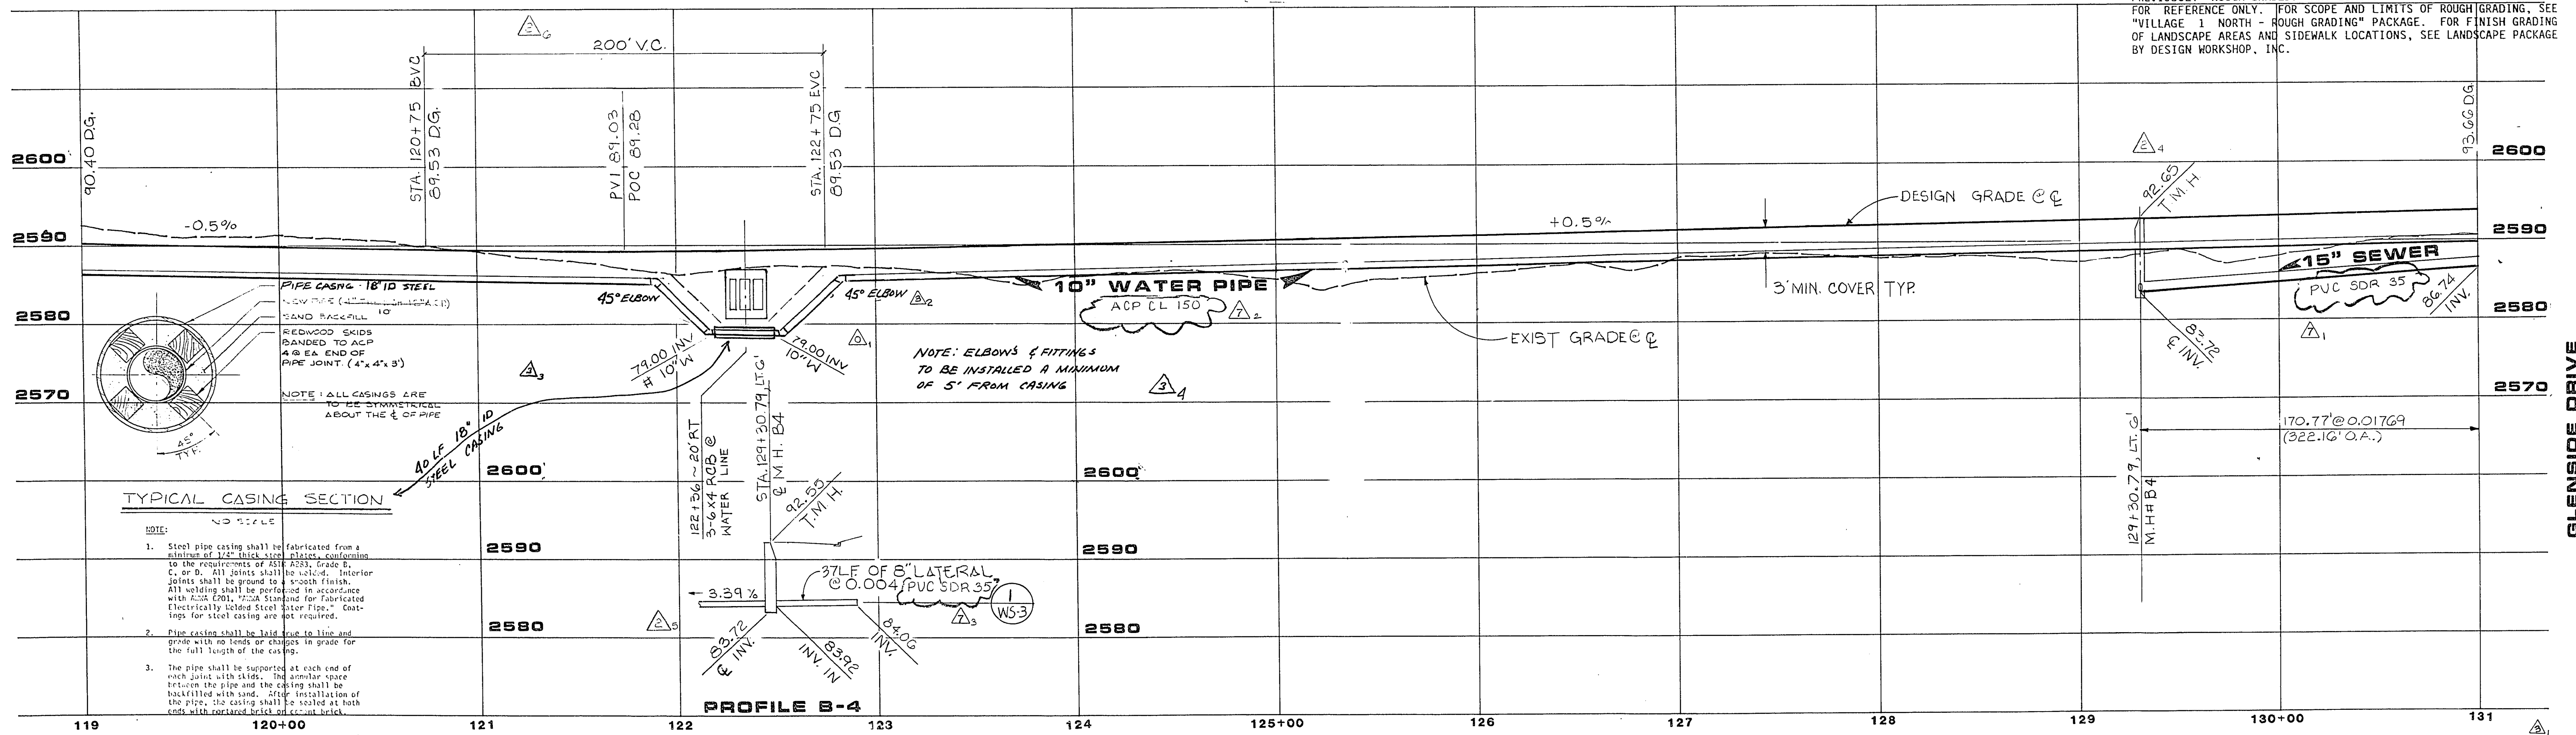

TYPICAL CASING SECTION

- NOTE:
- Steel pipe casing shall be fabricated from a minimum of 1/2" thick steel plates, conforming to the requirements of AISC, Grade 50, C, or D. All joints shall be welded. Interior joints shall be ground to a smooth finish. All welding shall be performed in accordance with AWS D11.1, "Standard for Fabricated Electrically Heated Steel Sinter Pipe." Coatings for steel casing are not required.
 - Pipe casing shall be laid out to line and grade with no kinks or checks in grade for the full length of the casing.
 - The pipe shall be supported at each end of each joint with skids. The annular space between the pipe and the casing shall be backfilled with sand. After installation of the pipe, the casing shall be sealed at both ends with concrete brick on cement brick.

RECOMMENDED BY: <i>[Signature]</i> UNIT SUPERVISOR: <i>[Signature]</i> DATE: 8/30/89	ISSUE TO BID WATER/SEWER ADDENDUM # 2 ISSUE FOR CONSTRUCTION / CHANGE ORDER # 1 CHANGE ORDER # 1
G.C. WALLACE, INC. Engineering/Architecture 1555 NORTH BARKSBY BLVD LAS VEGAS, NEVADA 89102	SHEET 16 OF 24 SHEETS WS-13

JOB NO. 620.314

984 DIETRICH POST 65328

[Signature] 8-30-89
 LAS VEGAS VALLEY WATER DISTRICT DATE

307-V651

25-1-150 307-V651