


# SUMMERLIN

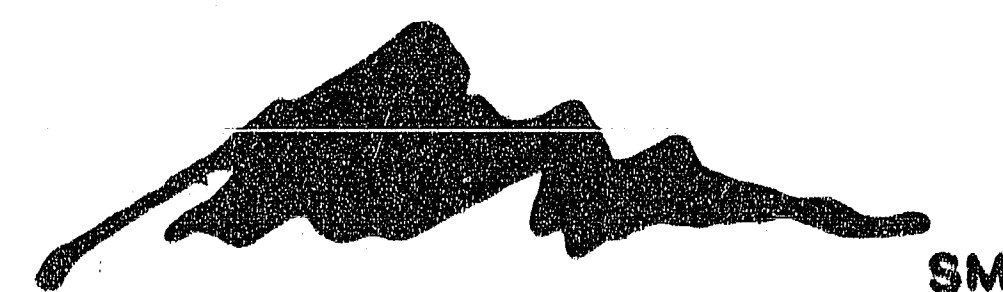


## VILLAGE 1 NORTH IMPROVEMENTS

STORM DRAIN, CURB & GUTTER, AND PAVEMENT

# Howard Hughes Properties

REVISION 12/15/89  
REVISION 8/17/89  
RECORD DRAWING  
REVISION 1/22/89  
REVISION 8/15/89  
ISSUE TO CONSTRUCT/REVISION #1  
ADDENDUM 8/21/89  
A ISSUE TO BID 8/17/89  
SUBMITTAL SET 7/28/89

Location: Las Vegas, Nevada

 **G.C. WALLACE, INC.**  
Engineering/Architecture  
1555 SOUTH RAINBOW BLVD./LAS VEGAS, NEVADA 89102

RECORD DRAWINGS  
THESE PLANS SHOW RECORD INFORMATION RECEIVED FROM:  
CONTRACTOR: SOUTHERN NEVADA PAVING/TAB  
DATE: 8-18-89  
THIS DATA MAY OR MAY NOT REFLECT THE ACTUAL  
FIELD LOCATIONS. ALL DATA SHOULD BE CONFIRMED  
PRIOR TO USE ON DEVELOPMENT OR ENGINEERING  
PLANS.

SHEET 1 OF 29

107-V1695

