


JOB NO. 680.314

804 DIETRICH-PORT 90208

VILLAGE 7 NORTH
(SEE SHEET 1-2)

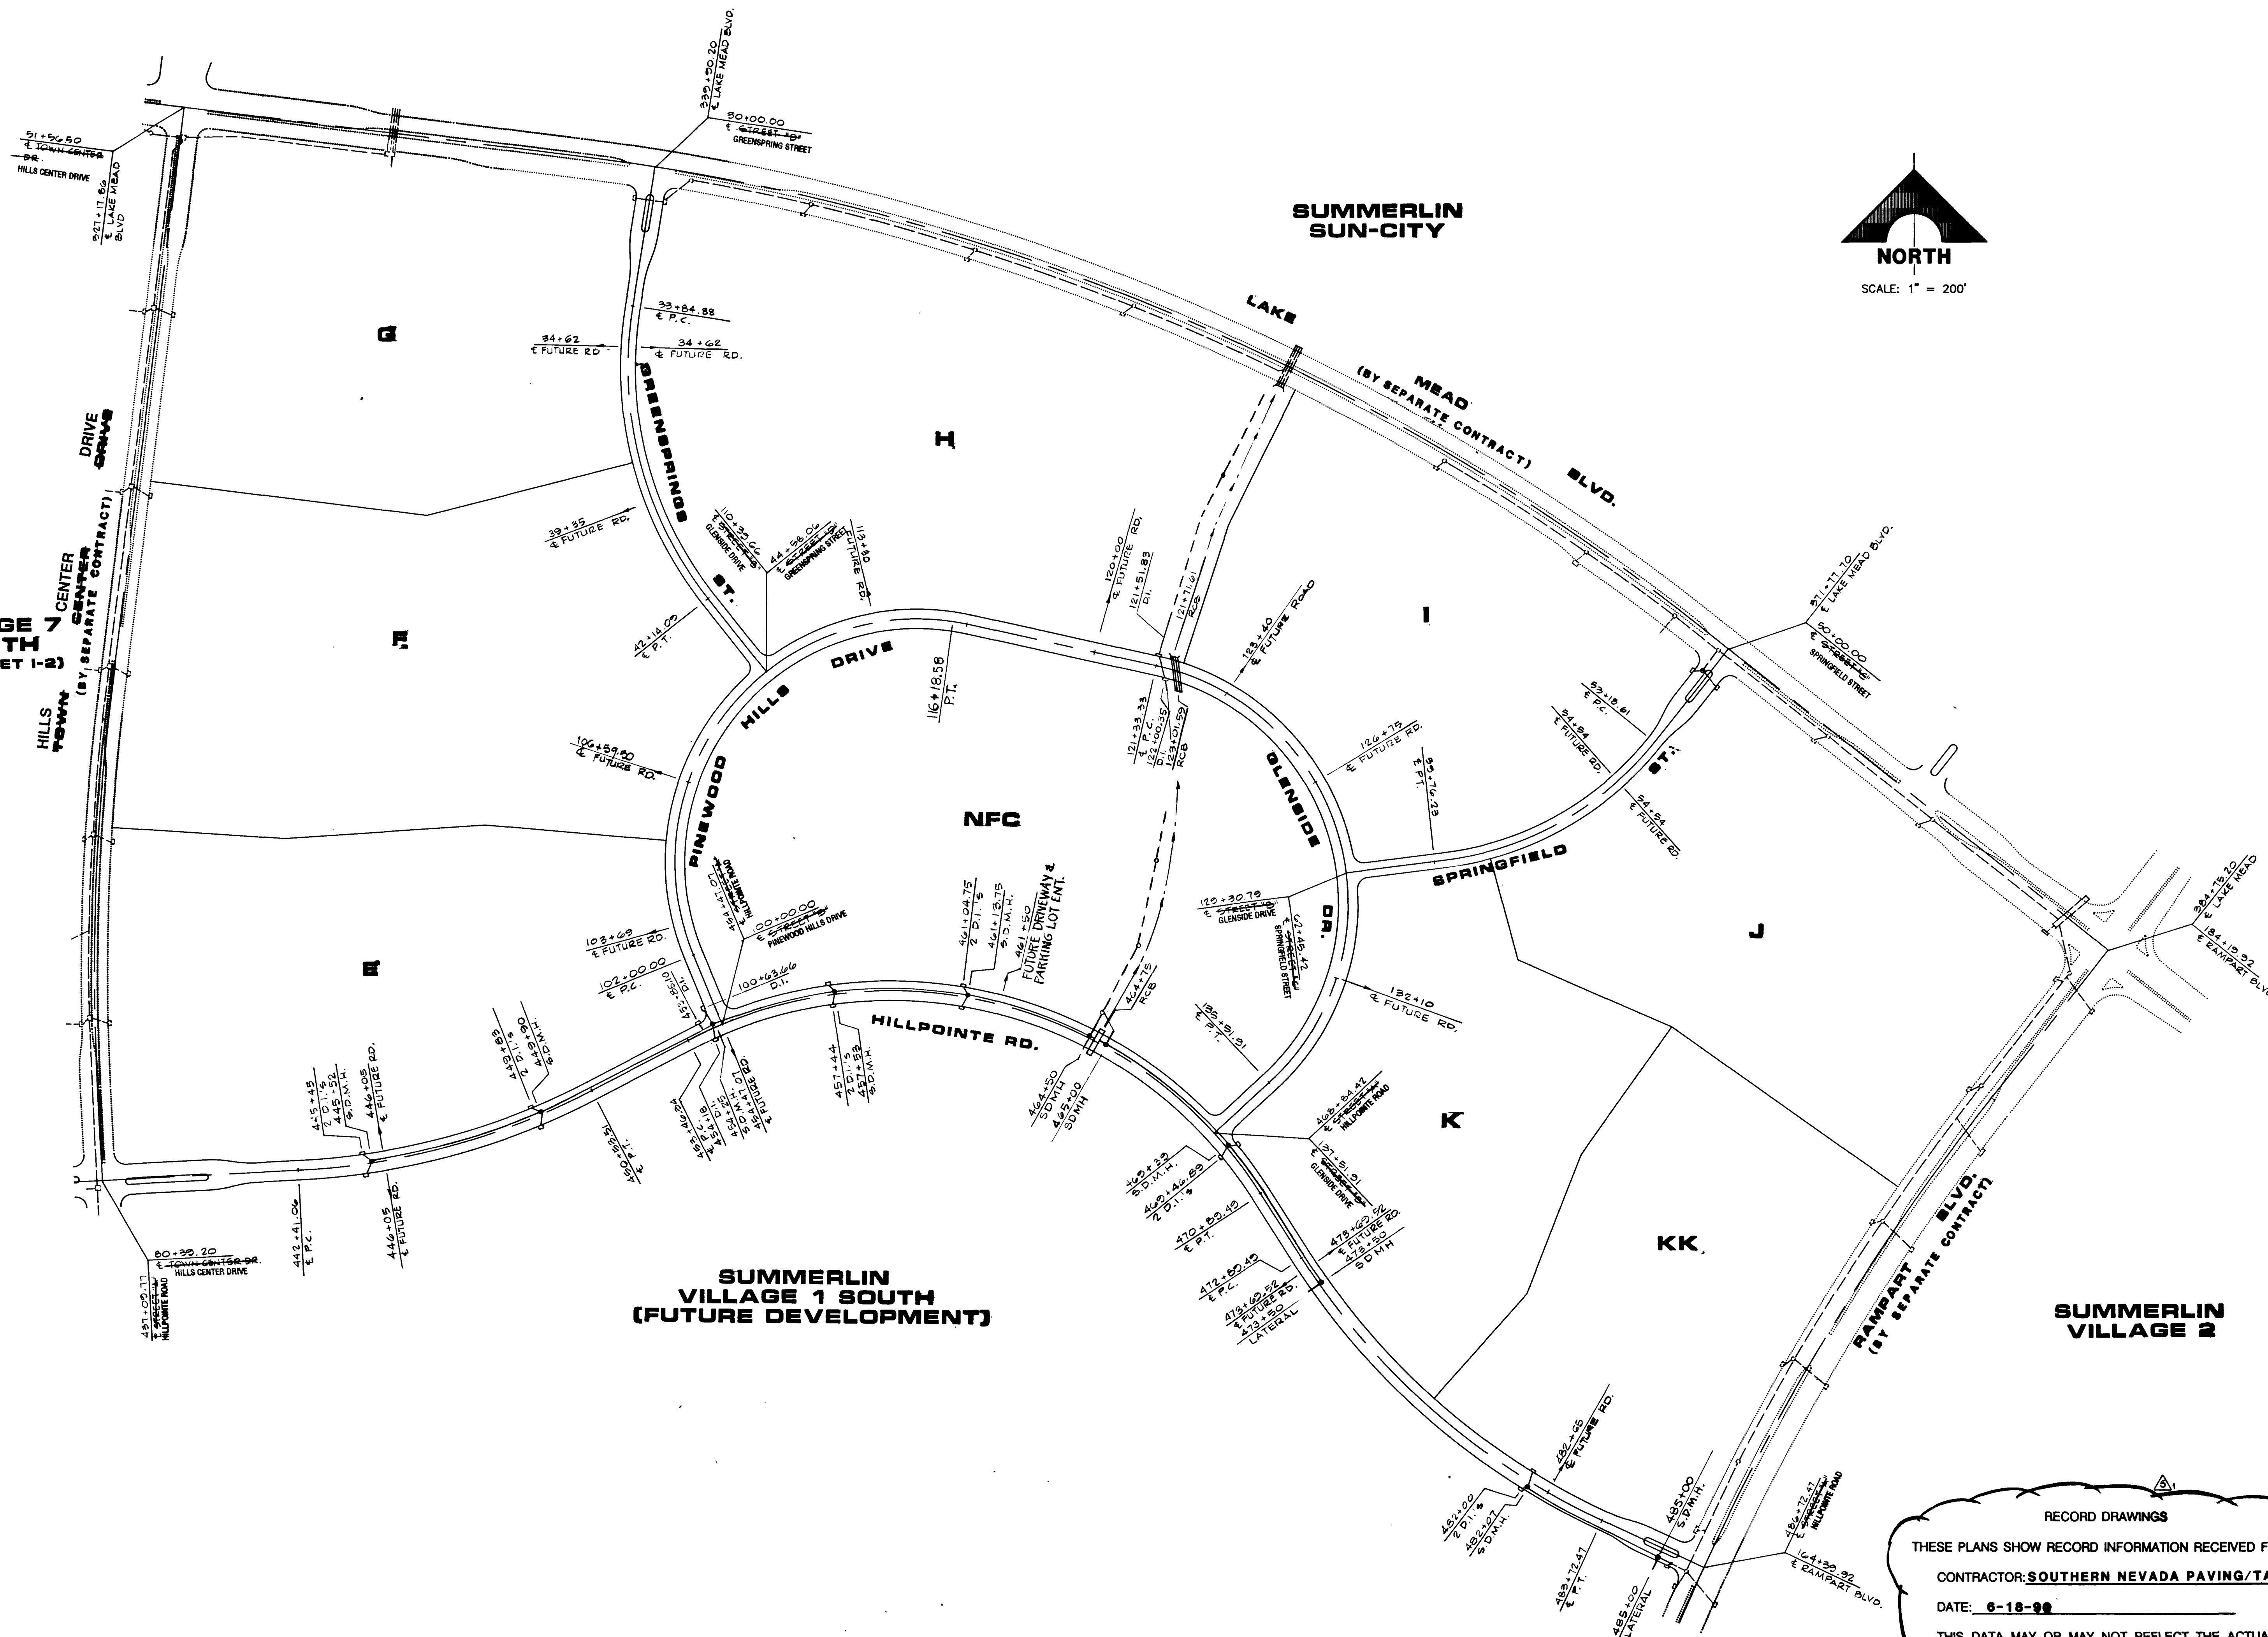

RECORD DRAWINGS
THESE PLANS SHOW RECORD INFORMATION RECEIVED FROM:
CONTRACTOR: SOUTHERN NEVADA PAVING/TAB
DATE: 6-18-99
THIS DATA MAY OR MAY NOT REFLECT THE ACTUAL FIELD LOCATIONS. ALL DATA SHOULD BE CONFIRMED PRIOR TO USE ON DEVELOPMENT OR ENGINEERING PLANS.

REV	DATE	DESCRIPTION
A	8/7/89	ISSUE TO BO
B	11/2/89	ISSUE TO CONSTRUCTION
C	8/7/90	RECORD DRAWING

HOWARD HUGHES PROPERTIES
VILLAGE 1 NORTH
MASTER IMPROVEMENT/STORM DRAIN PLAN
VILLAGE 1 NORTH AREA

G.C. WALLACE, INC.
Engineering/Architecture
155 SOUTH RAINBOW BLVD. LAS VEGAS, NEVADA 89102

SHEET
1-1
4 OF 29 SHEETS

