



JOB NO. 620.314



CURVE NO.	DELTA	RADIUS	LENGTH	TANGENT	DESCRIPTION
1	25°51'19"	672.00	303.25	154.25	BACK OF CURB
2	80°58'14"	650.00	918.58	554.86	CENTERLINE
3	80°58'14"	624.00	861.84	532.67	BACK OF CURB
4	46°56'44"	672.00	550.61	291.81	BACK OF CURB
5	85°54'56"	30.00	44.99	27.93	BACK OF CURB

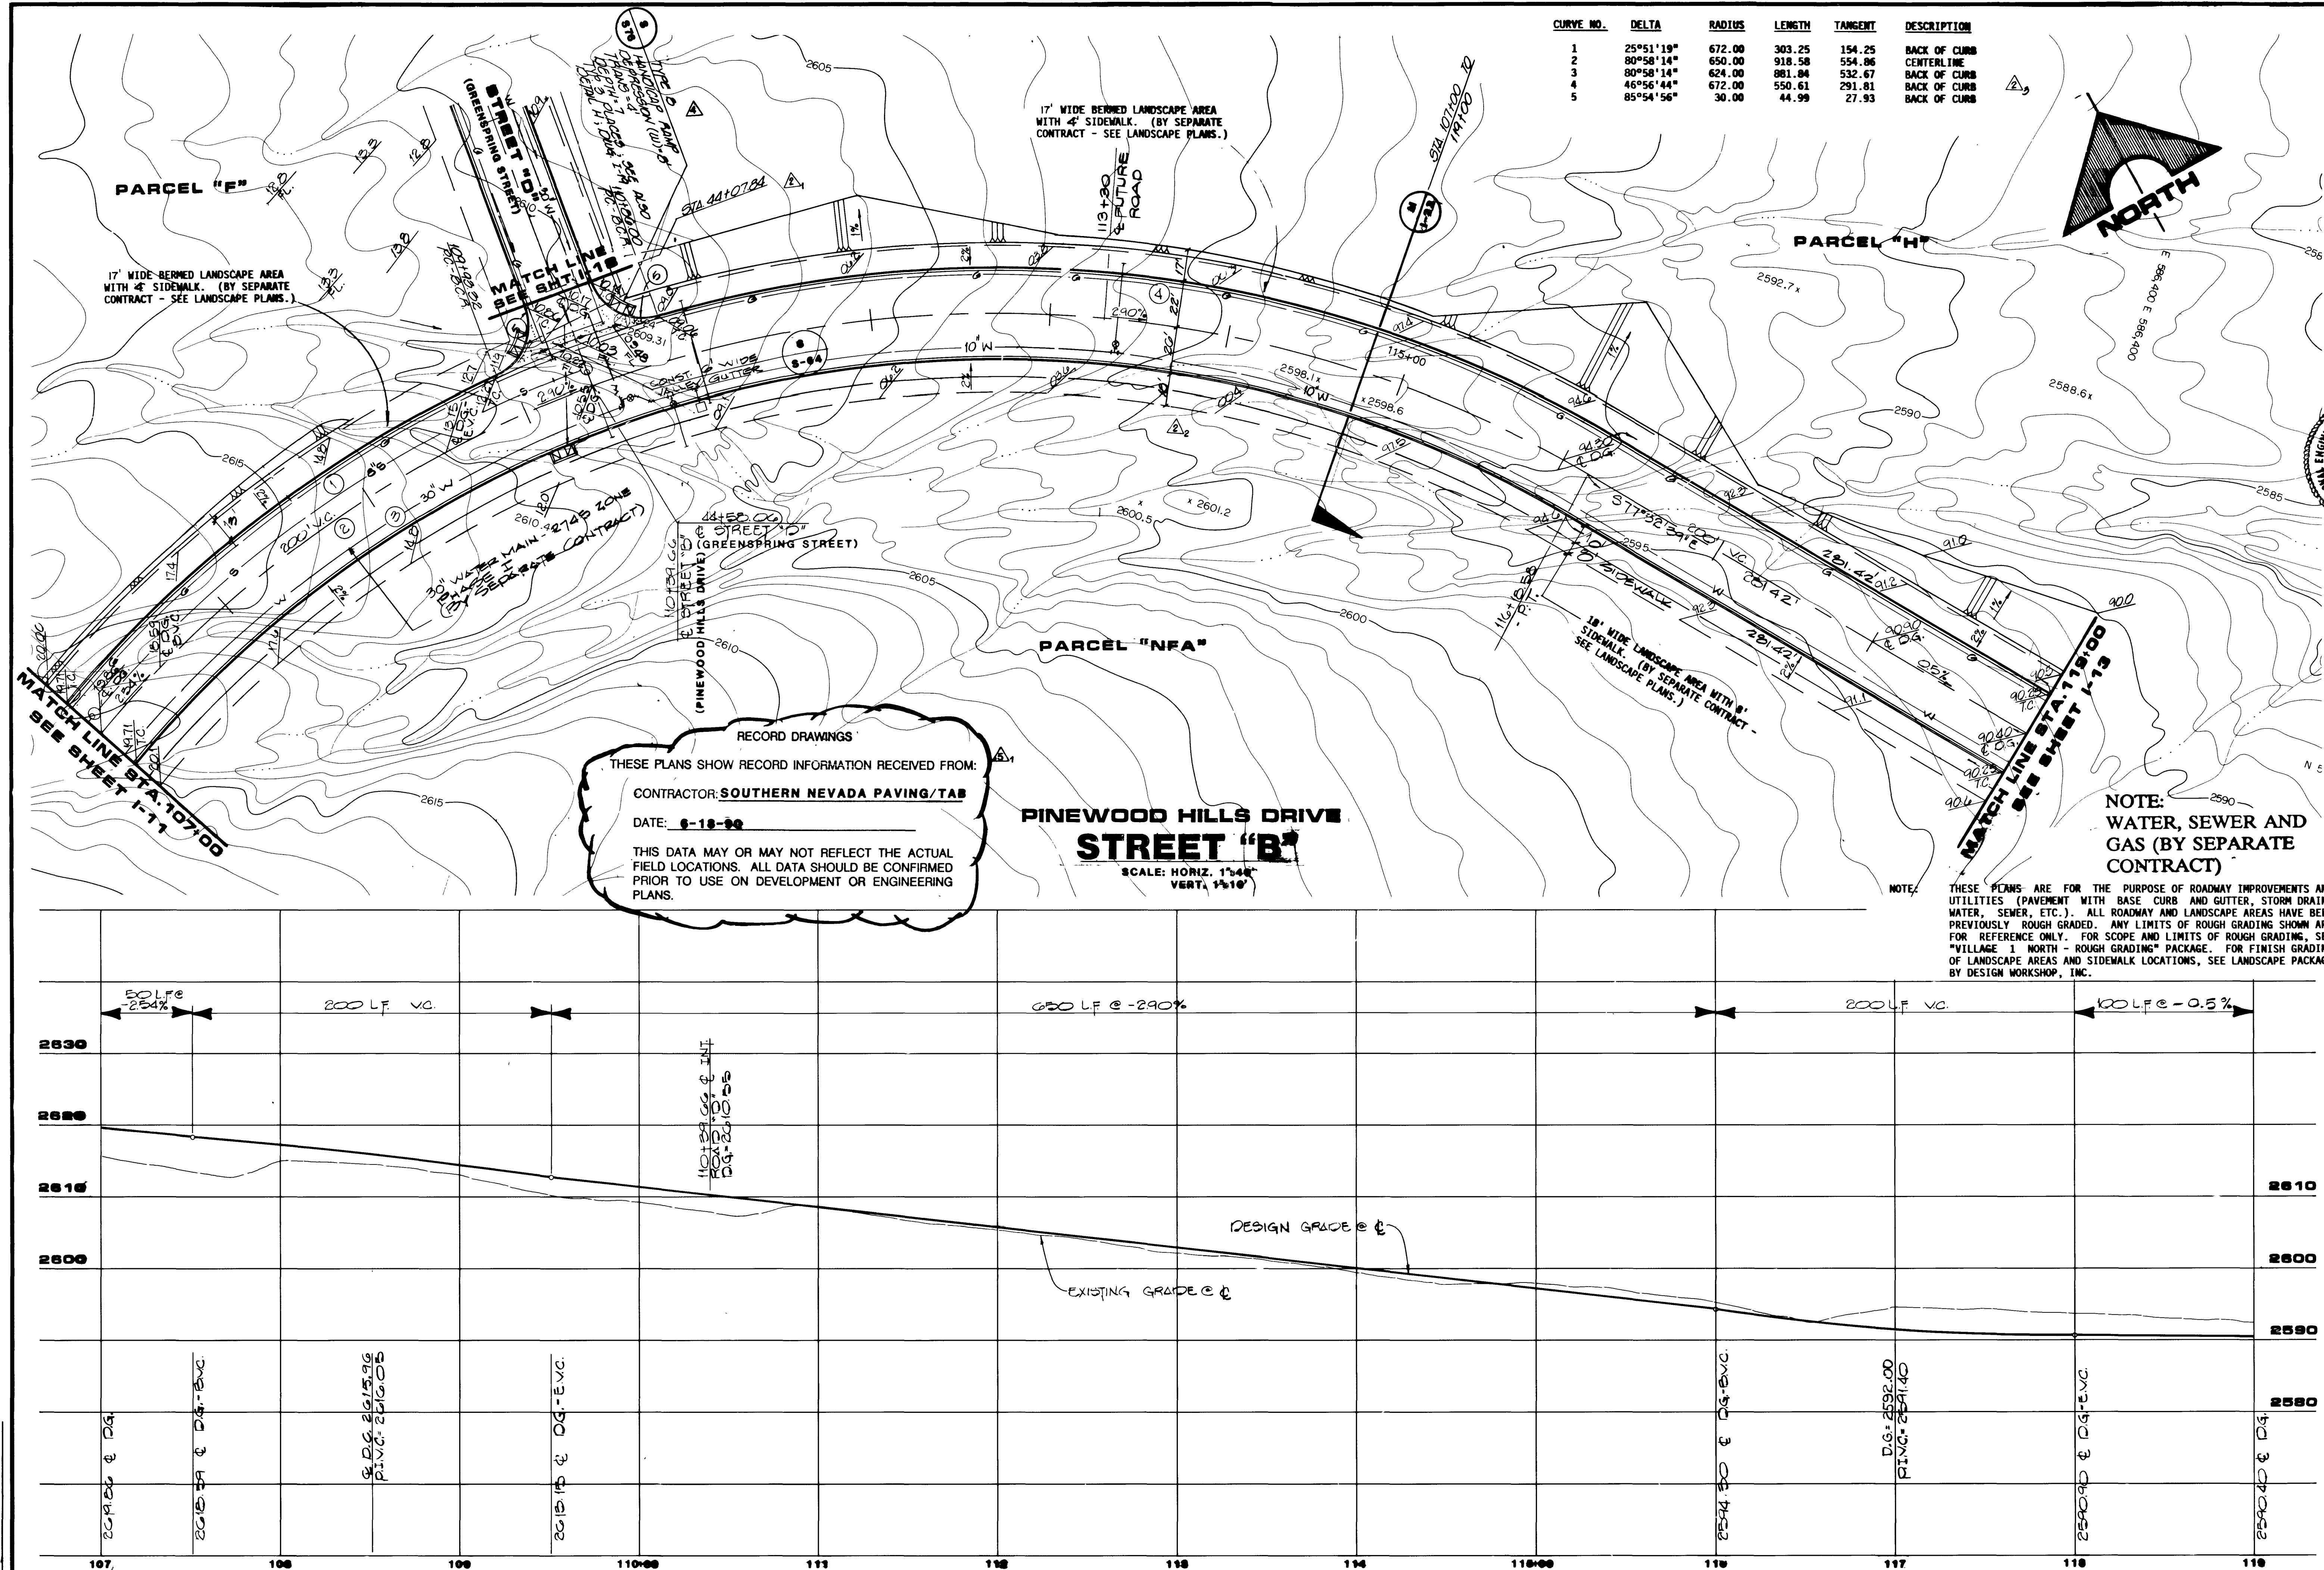

RECORD DRAWINGS
THESE PLANS SHOW RECORD INFORMATION RECEIVED FROM:
CONTRACTOR: SOUTHERN NEVADA PAVING/TAB
DATE: 6-18-99
THIS DATA MAY OR MAY NOT REFLECT THE ACTUAL FIELD LOCATIONS. ALL DATA SHOULD BE CONFIRMED PRIOR TO USE ON DEVELOPMENT OR ENGINEERING PLANS.

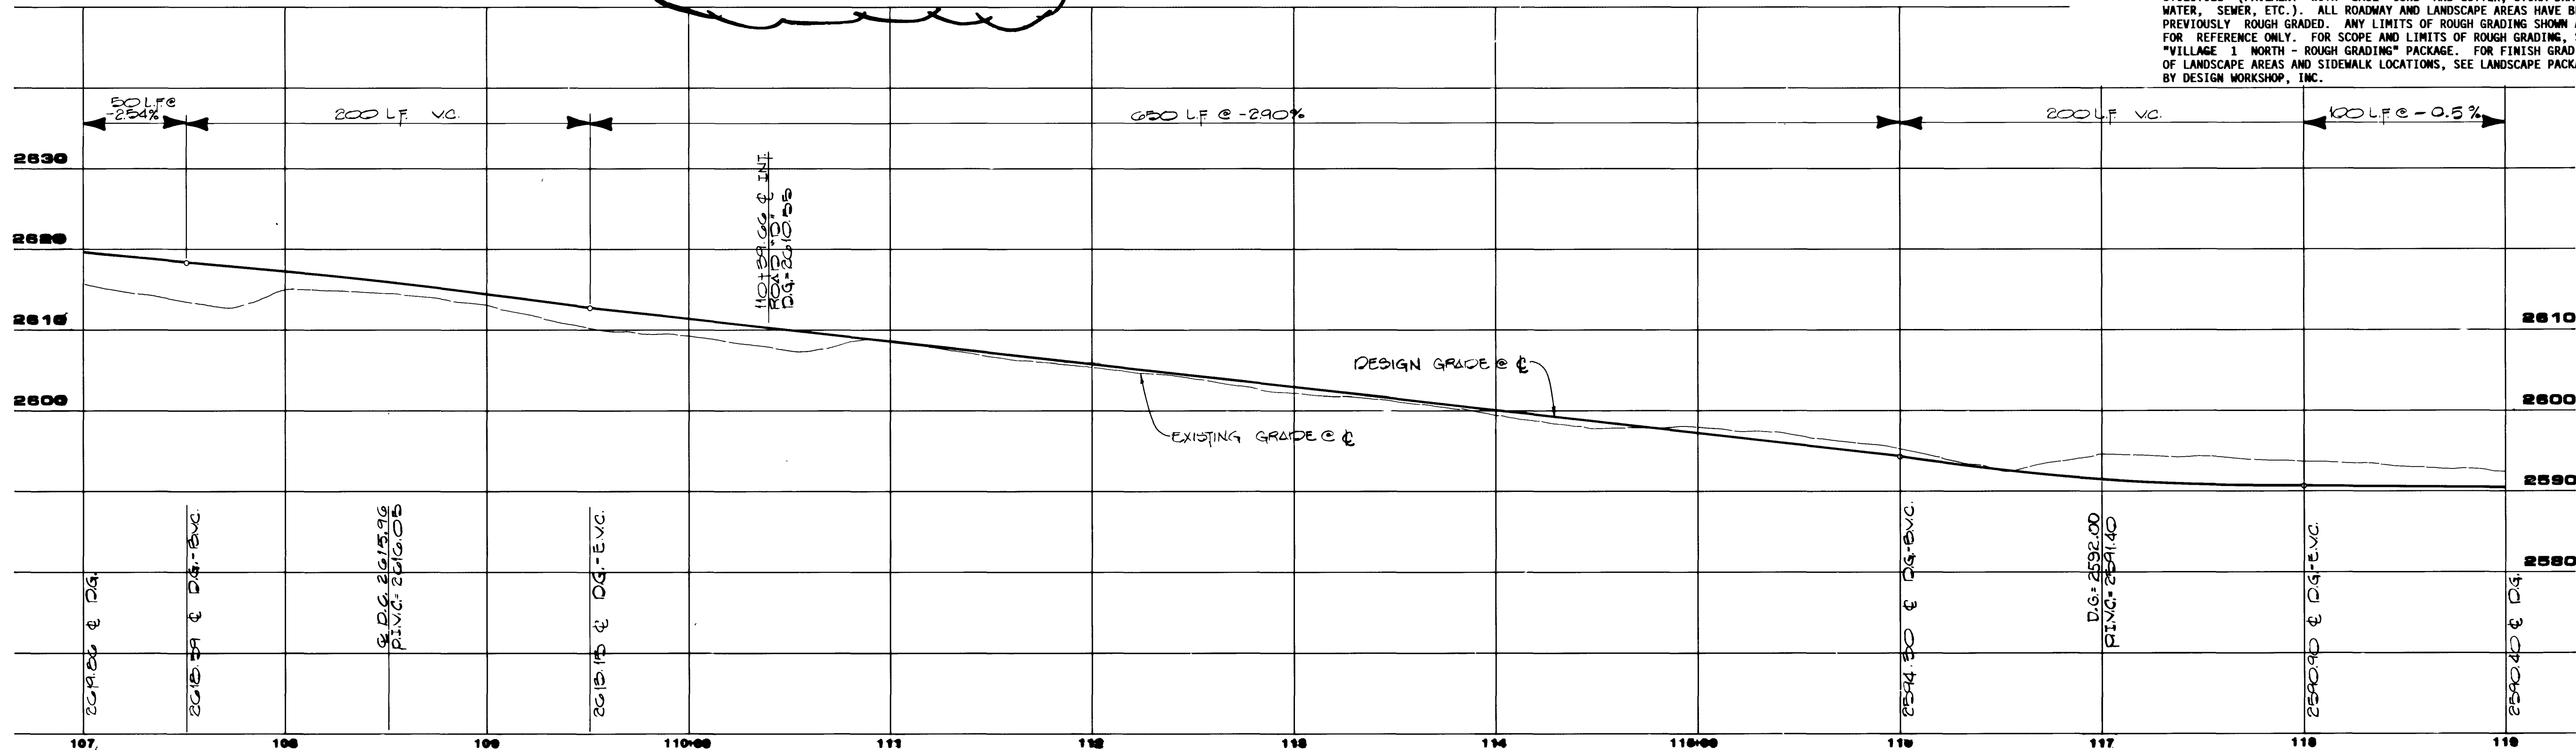

REV	DATE	DESCRIPTION
A	8/7/89	ISSUE TO BD
B	10/28/89	REVISION 10/28/89
C	1/22/90	REVISION 1/22/90
D	1/22/90	REVISION 1/22/90
ENGINEER: G.C. WALLACE, INC.
1555 SOUTH RAINBOW BLVD. LAS VEGAS, NEVADA 89102

PINEWOOD HILLS DRIVE
HOWARD HUGHES PROPERTIES
VILLAGE 1 NORTH IMPROVEMENTS
STREET "B" PLAN & PROFILES
STA. 107+00 TO 118+00

SHEET 15
1-12
OF 20 SHEETS

