


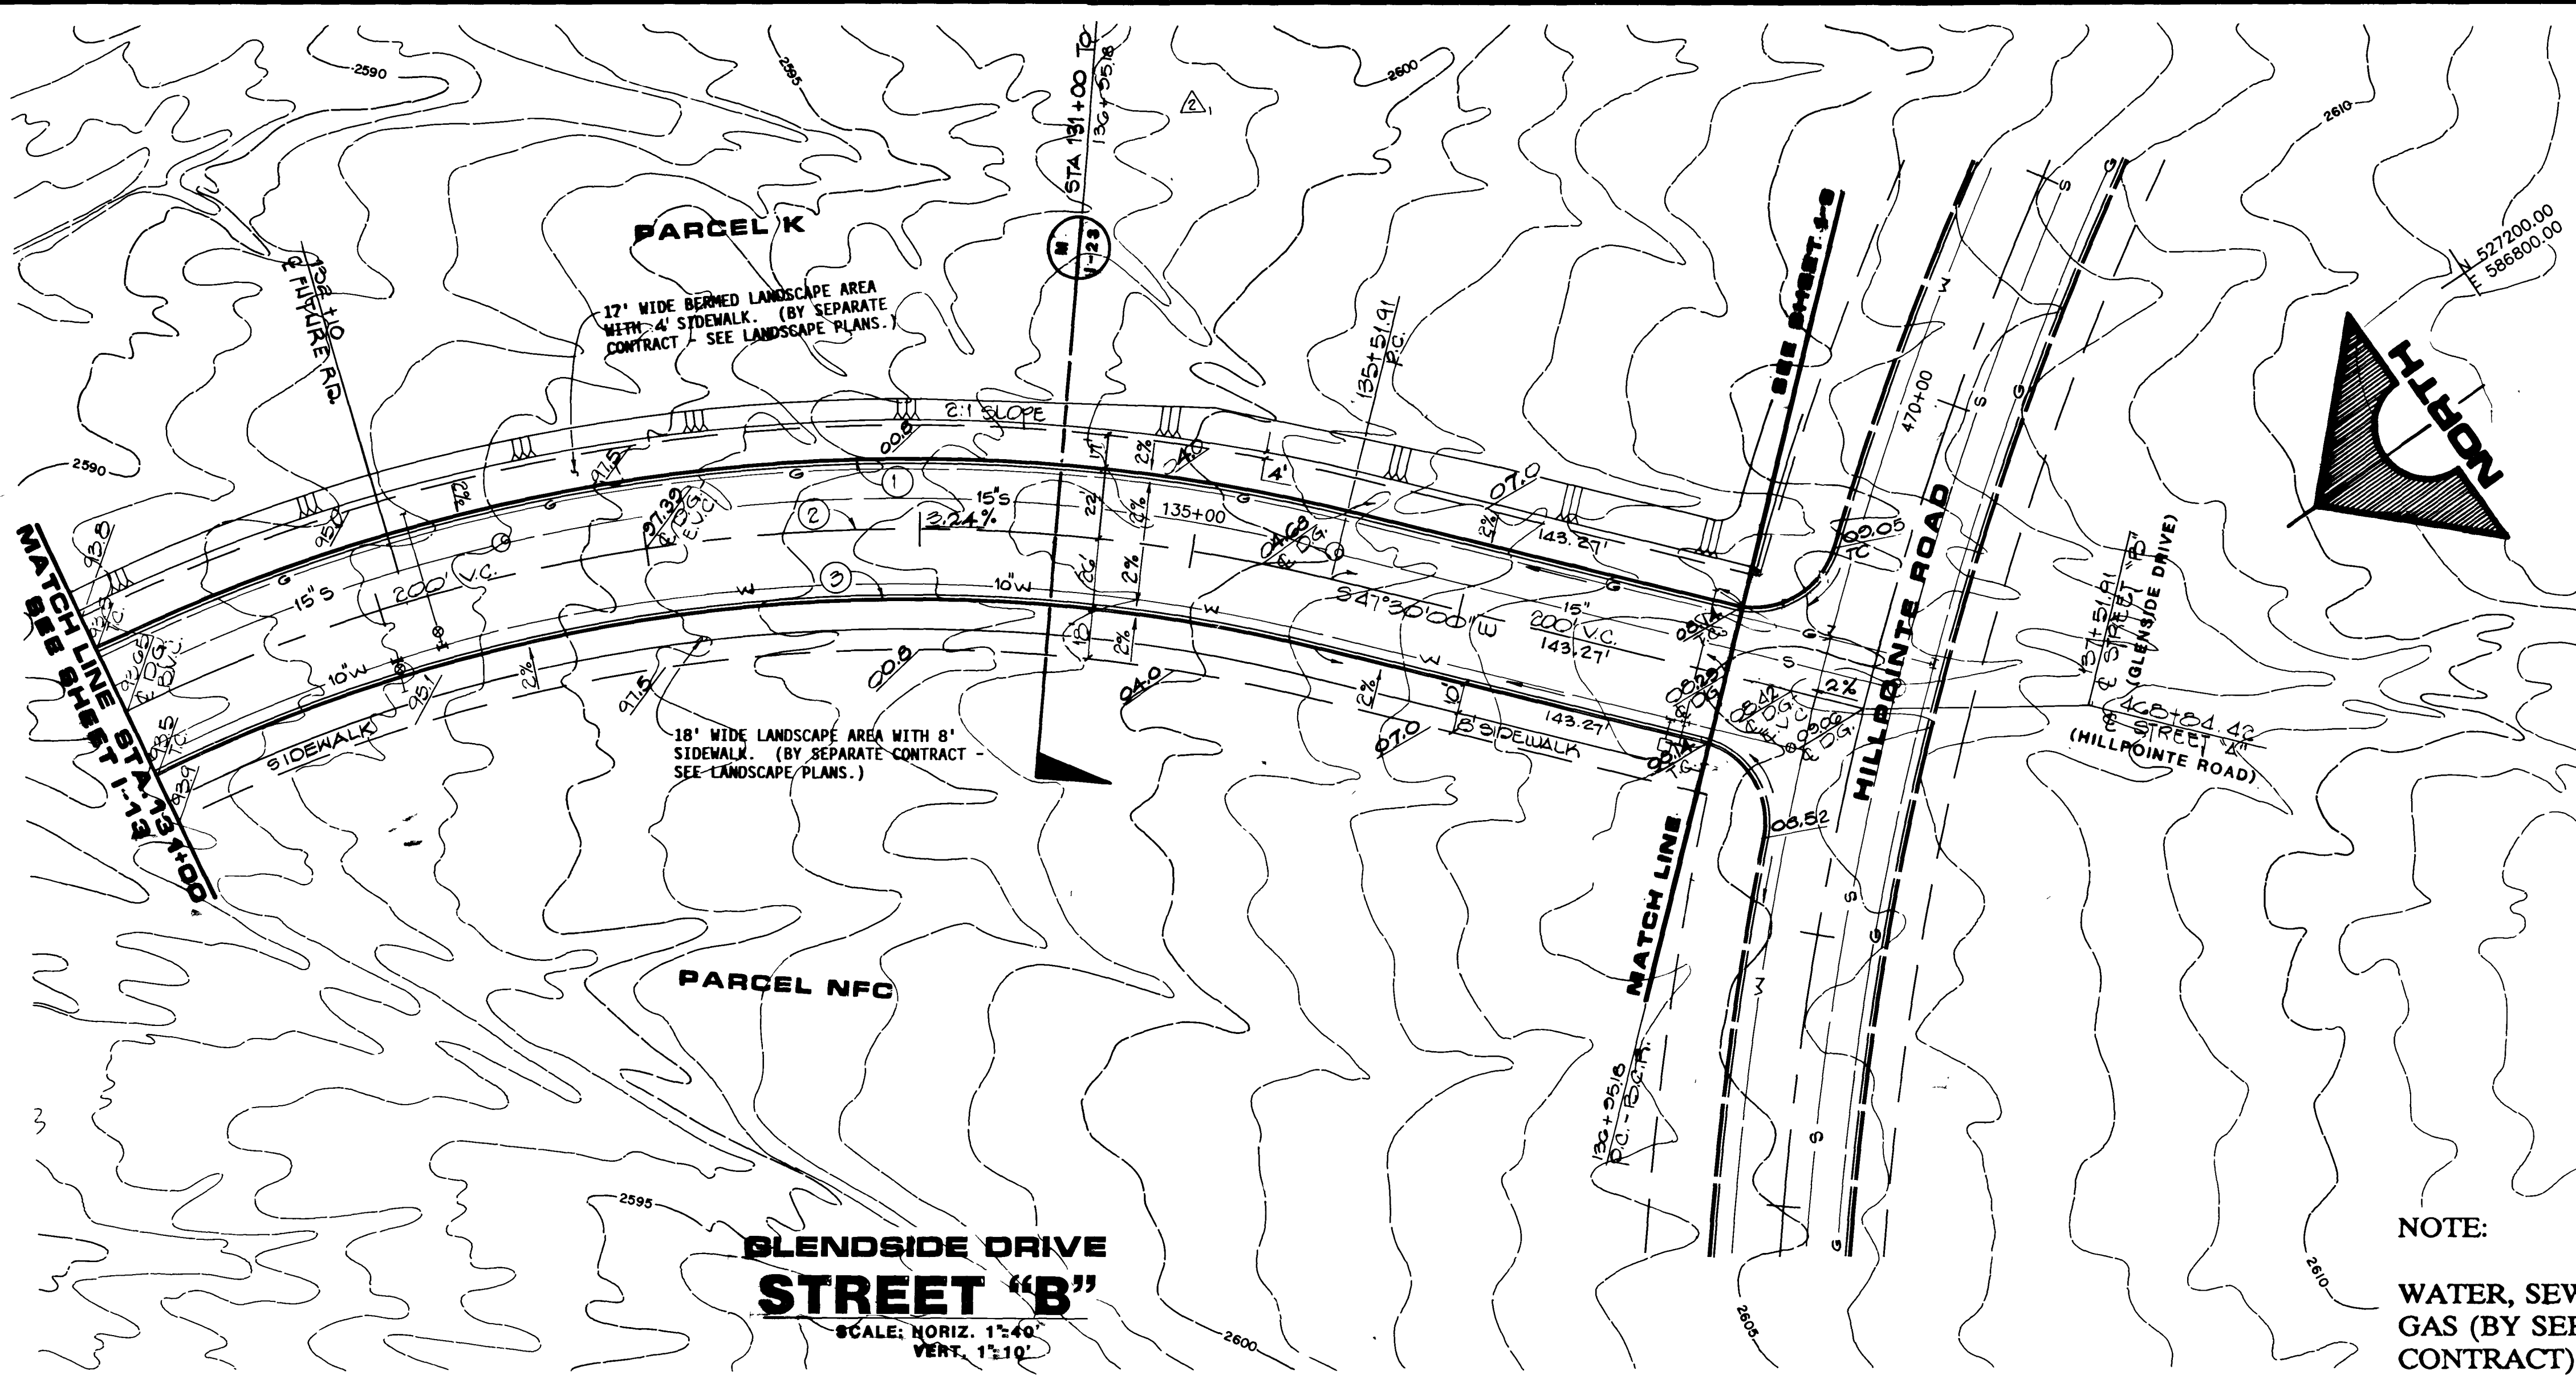


| CURVE NO. | DELTA     | RADIUS  | LENGTH  | TANGENT | DESCRIPTION  |
|-----------|-----------|---------|---------|---------|--------------|
| 1         | 39°50'05" | 672.00' | 467.21' | 243.49' | Back of Curb |
| 2         | 39°50'05" | 650.00' | 451.91' | 235.52' | Centerline   |
| 3         | 39°50'05" | 624.00' | 433.83' | 226.10' | Back of Curb |

NOTE:  
WATER, SEWER AND  
GAS (BY SEPARATE  
CONTRACT)

NOTE:  
THESE PLANS ARE FOR THE PURPOSE OF ROADWAY IMPROVEMENTS AND UTILITIES (PAVEMENT WITH BASE CURB AND GUTTER, STORM DRAIN, WATER, SEWER, ETC.). ALL ROADWAY AND LANDSCAPE AREAS HAVE BEEN PREVIOUSLY ROUGH GRADED. ANY LIMITS OF ROUGH GRADING SHOWN ARE FOR REFERENCE ONLY. FOR SCOPE AND LIMITS OF ROUGH GRADING, SEE "VILLAGE 1 NORTH - ROUGH GRADING" PACKAGE. FOR FINISH GRADING OF LANDSCAPE AREAS AND SIDEWALK LOCATIONS, SEE LANDSCAPE PACKAGE BY DESIGN WORKSHOP, INC.

RECORD DRAWINGS  
THESE PLANS SHOW RECORD INFORMATION RECEIVED FROM:  
CONTRACTOR: SOUTHERN NEVADA PAVING/TAB  
DATE: 6-18-90  
THIS DATA MAY OR MAY NOT REFLECT THE ACTUAL FIELD LOCATIONS. ALL DATA SHOULD BE CONFIRMED PRIOR TO USE ON DEVELOPMENT OR ENGINEERING PLANS.

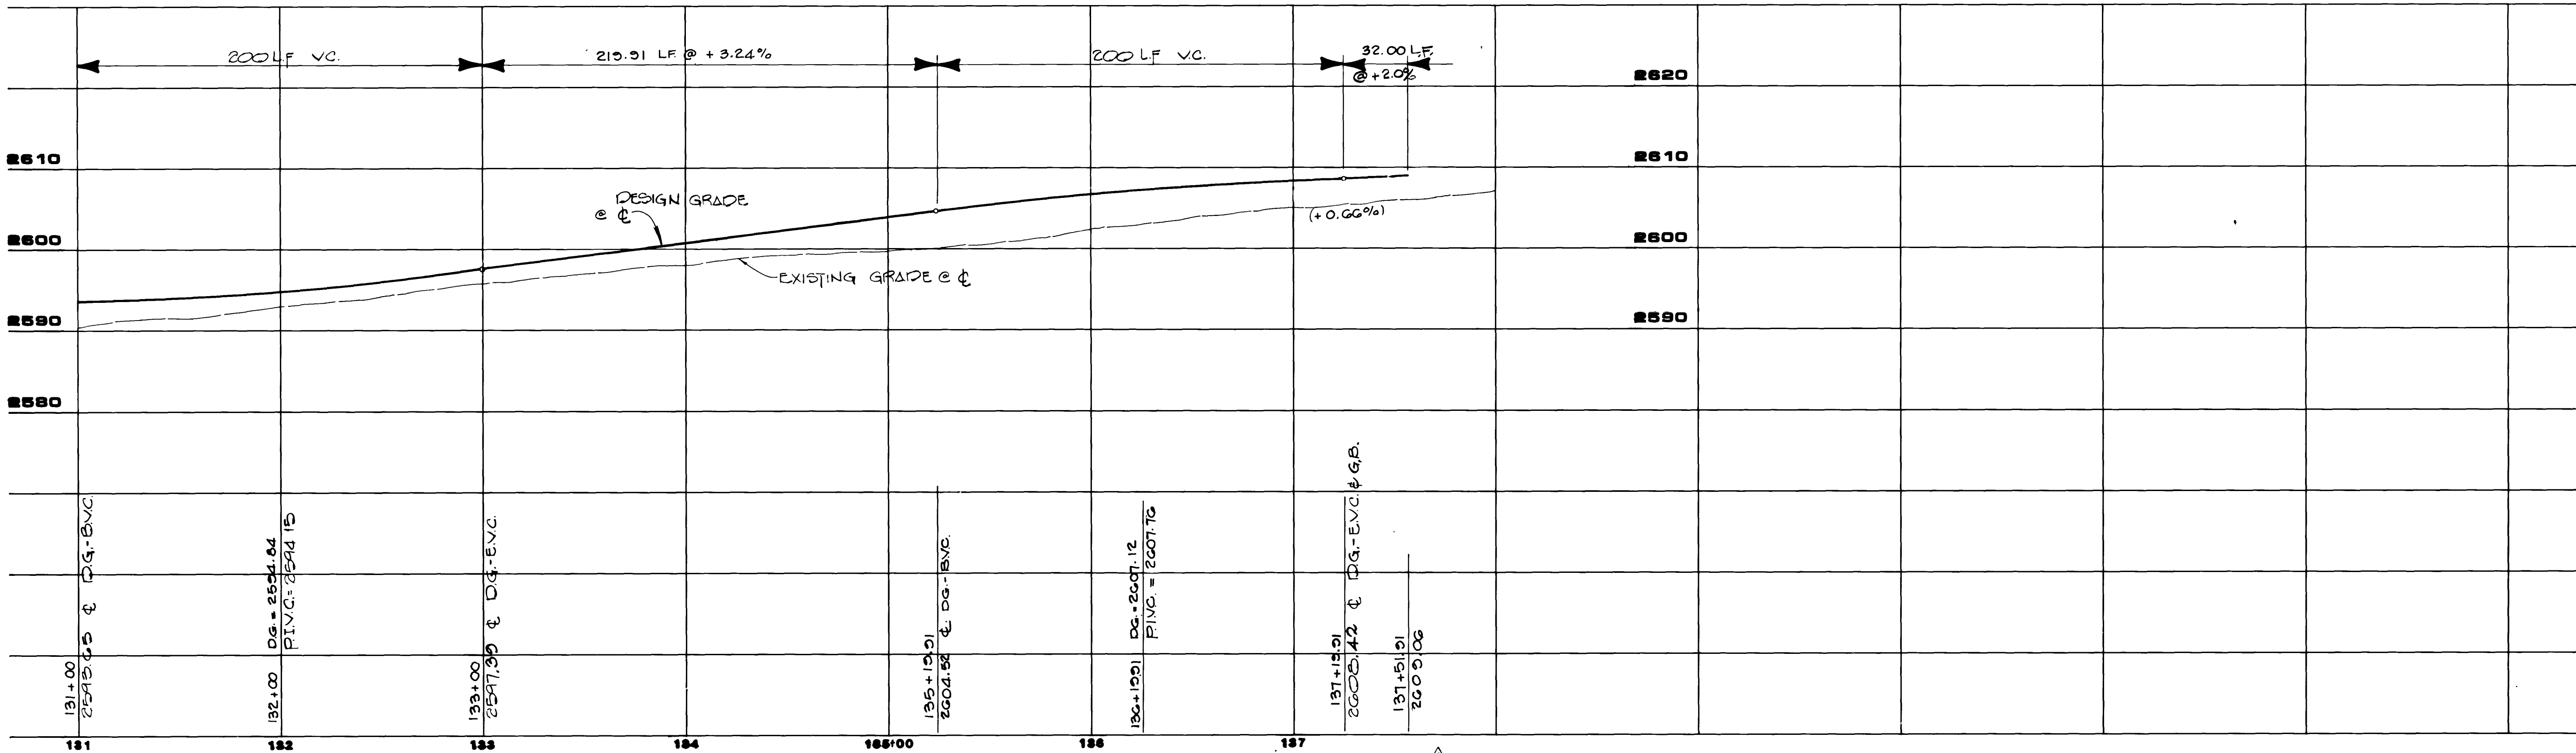

REVISIONS

| REV | DATE     | DESCRIPTION        |
|-----|----------|--------------------|
| A   | 8/7/90   | ISSUE TO NO.       |
| B   | 9/15/91  | ISSUE TO CONSTRUCT |
| C   | 10/28/91 | REVISION 222/226   |
| D   | 8/18/92  | RECORD DRAWING     |

LOCAL ENGINEERING SEAL

DESIGNED BY: [Signature]

CHECKED BY: [Signature]

DATE: 8-7-92

FILE NO. 5071

1555 SOUTH RAINBOW BLVD. LAS VEGAS, NEVADA 89102

G.C. WALLACE, INC.

Engineering/Architecture

HOWARD HUGHES PROPERTIES

VILLAGE 1 NORTH IMPROVEMENTS

STREET "B" PLAN & PROFILE

STA. 131+00 TO 137+51.91

SHEET 7

1-14

7 OF 29 SHEETS

