
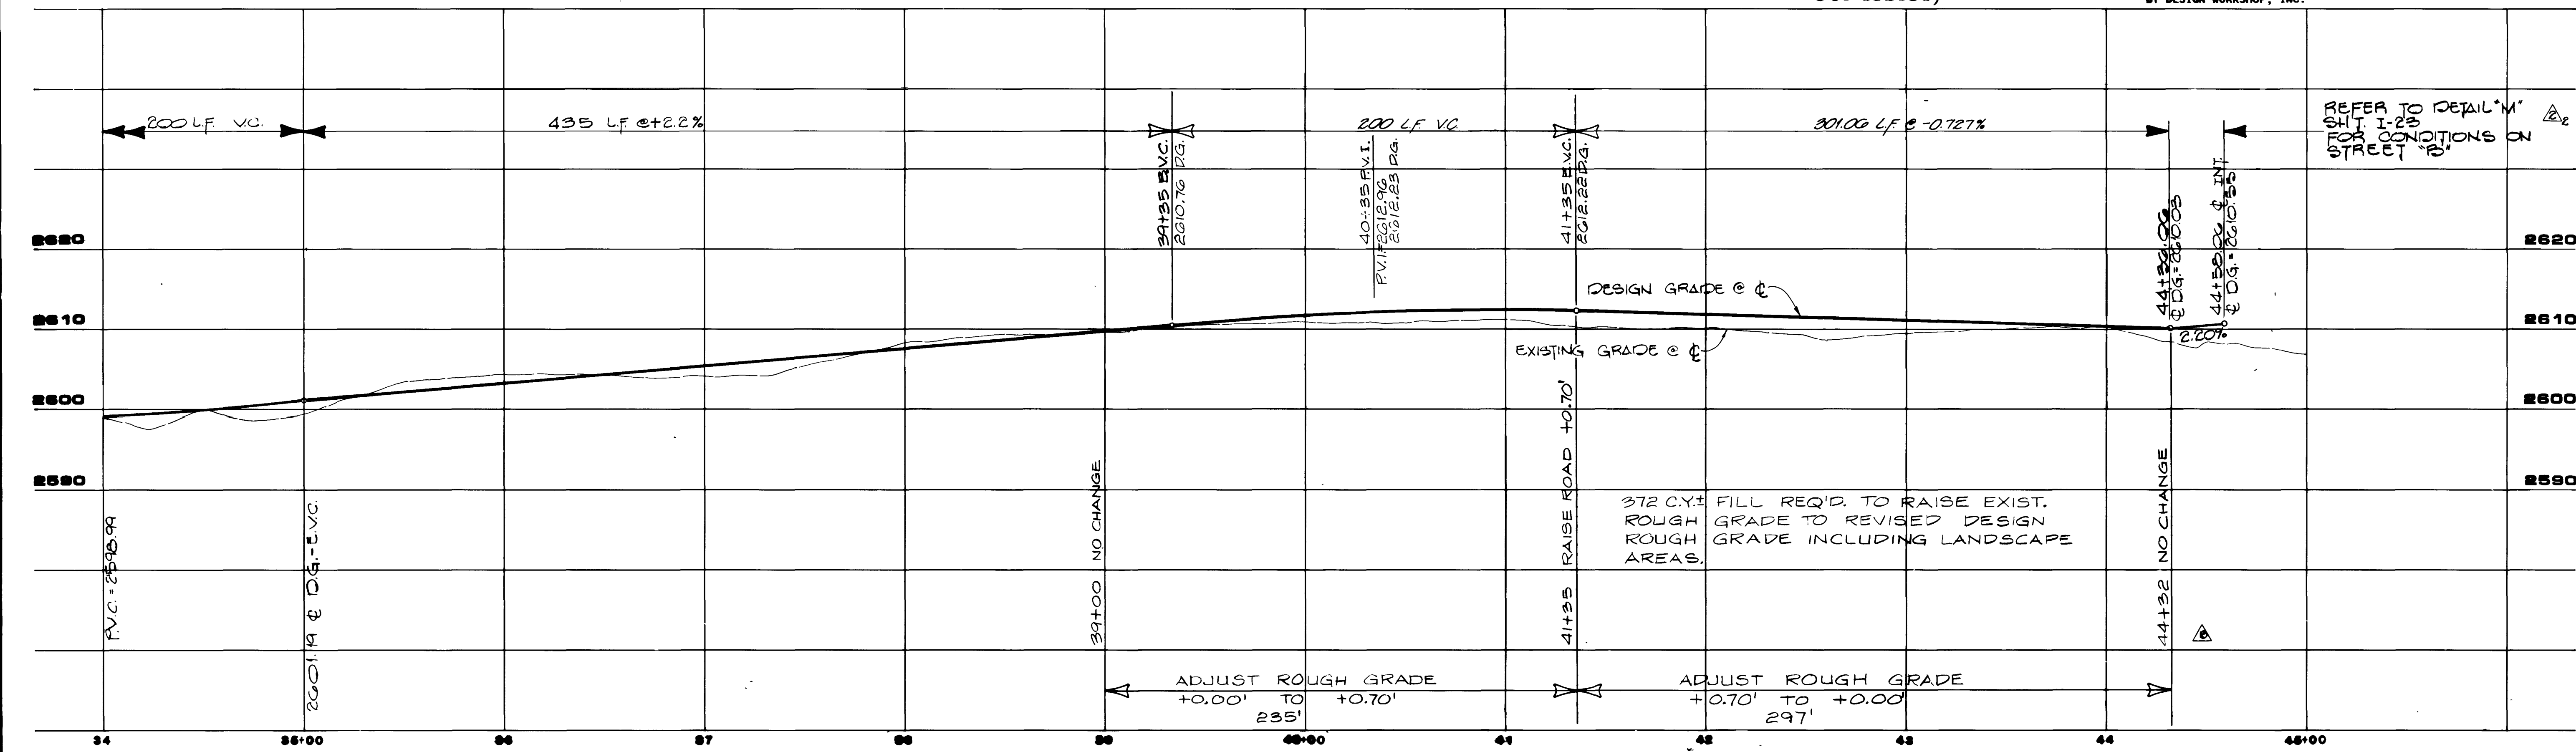


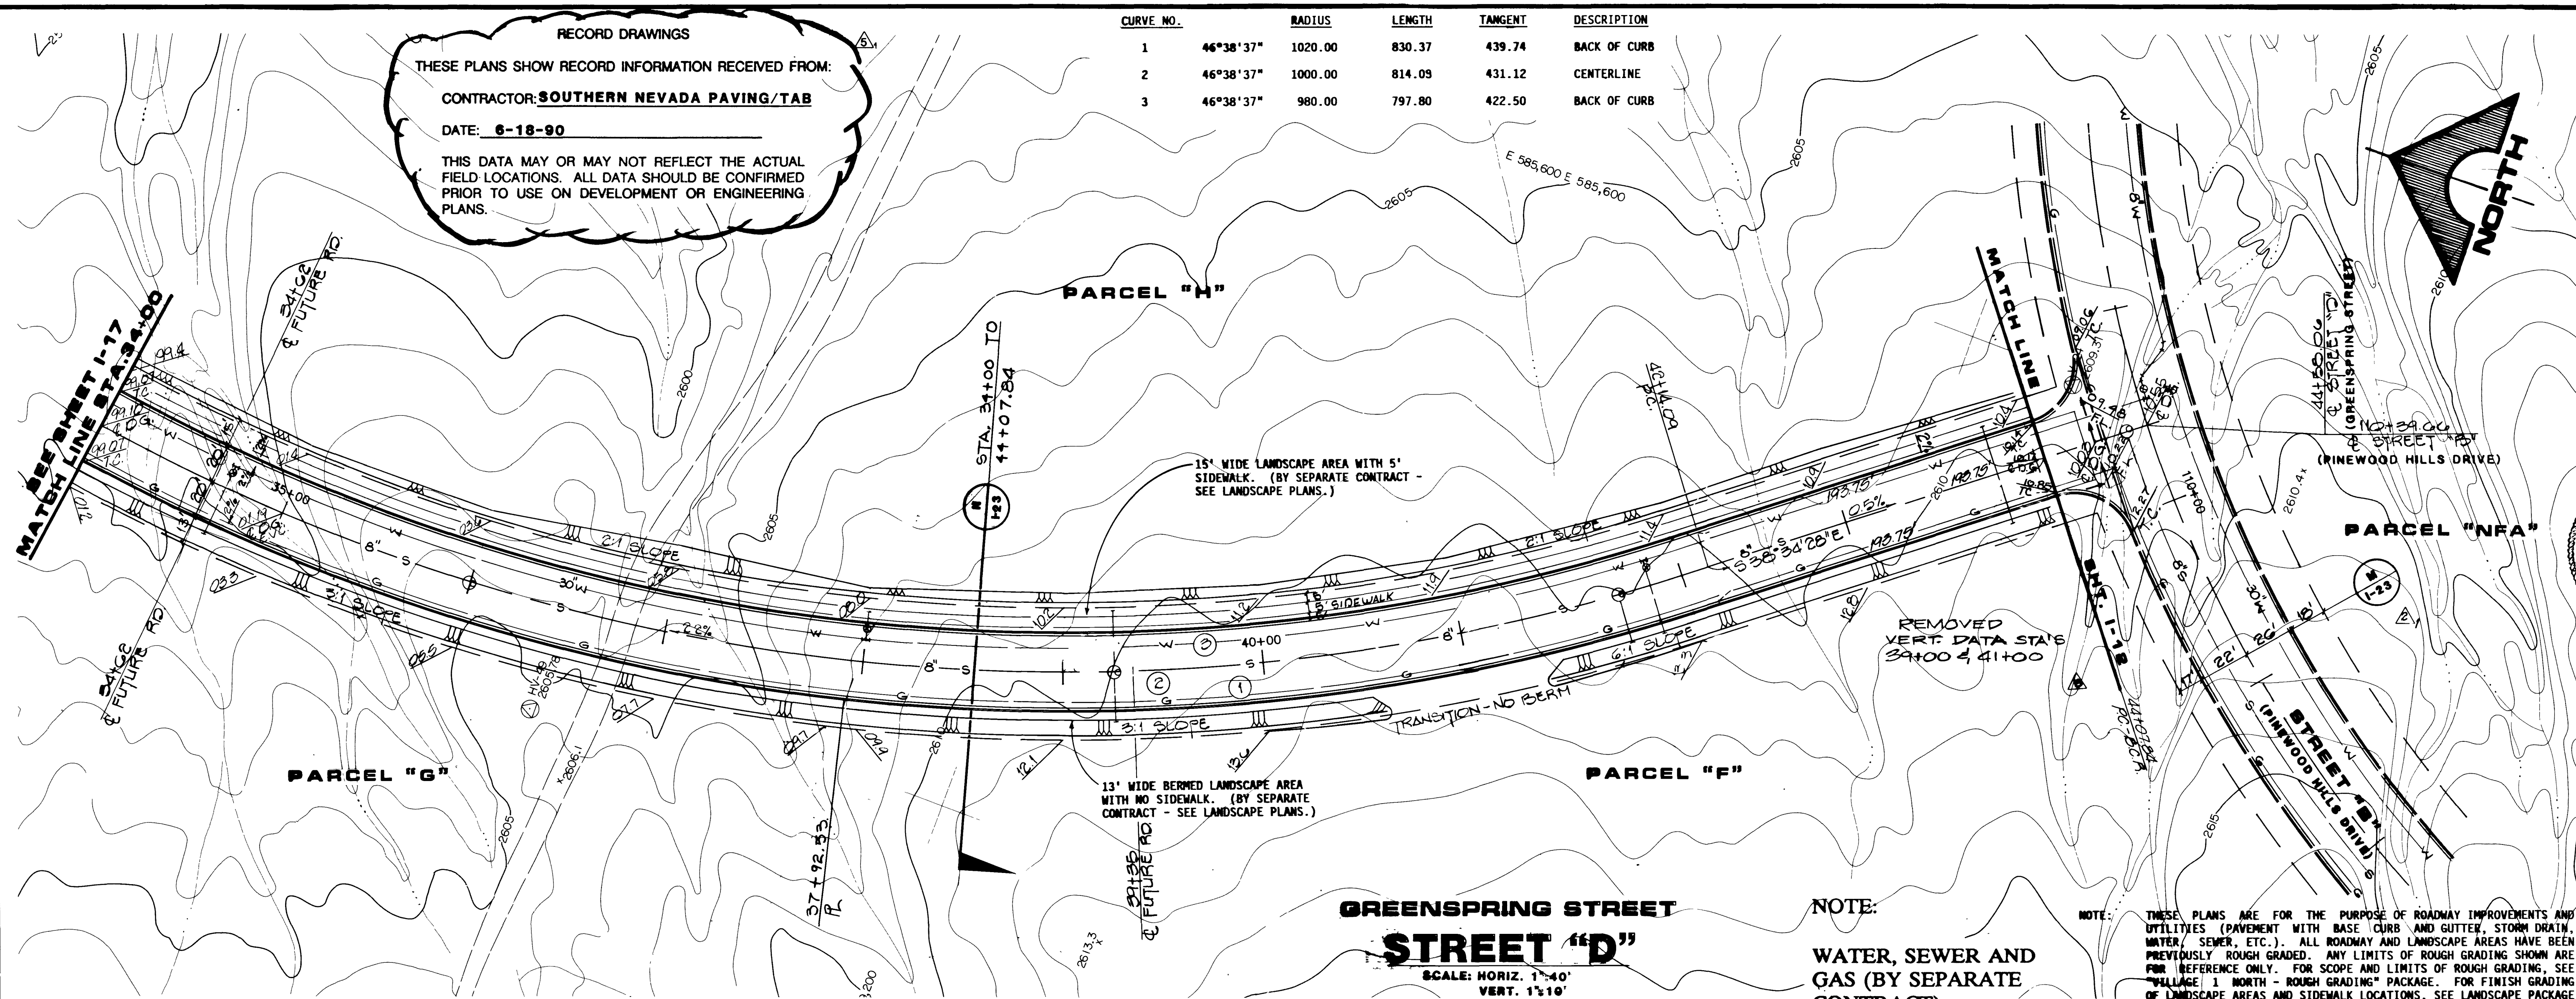

G.C. WALLACE, INC.
Engineering/Architecture

REVISIONS

REV	DATE	DESCRIPTION
1	6/18/90	ISSUE TO CONSTRUCTION
2	6/18/90	REVISION 880.314
3	6/18/90	RECORD DRAWING

SHEET 1-18
1 of 20 SHEETS

