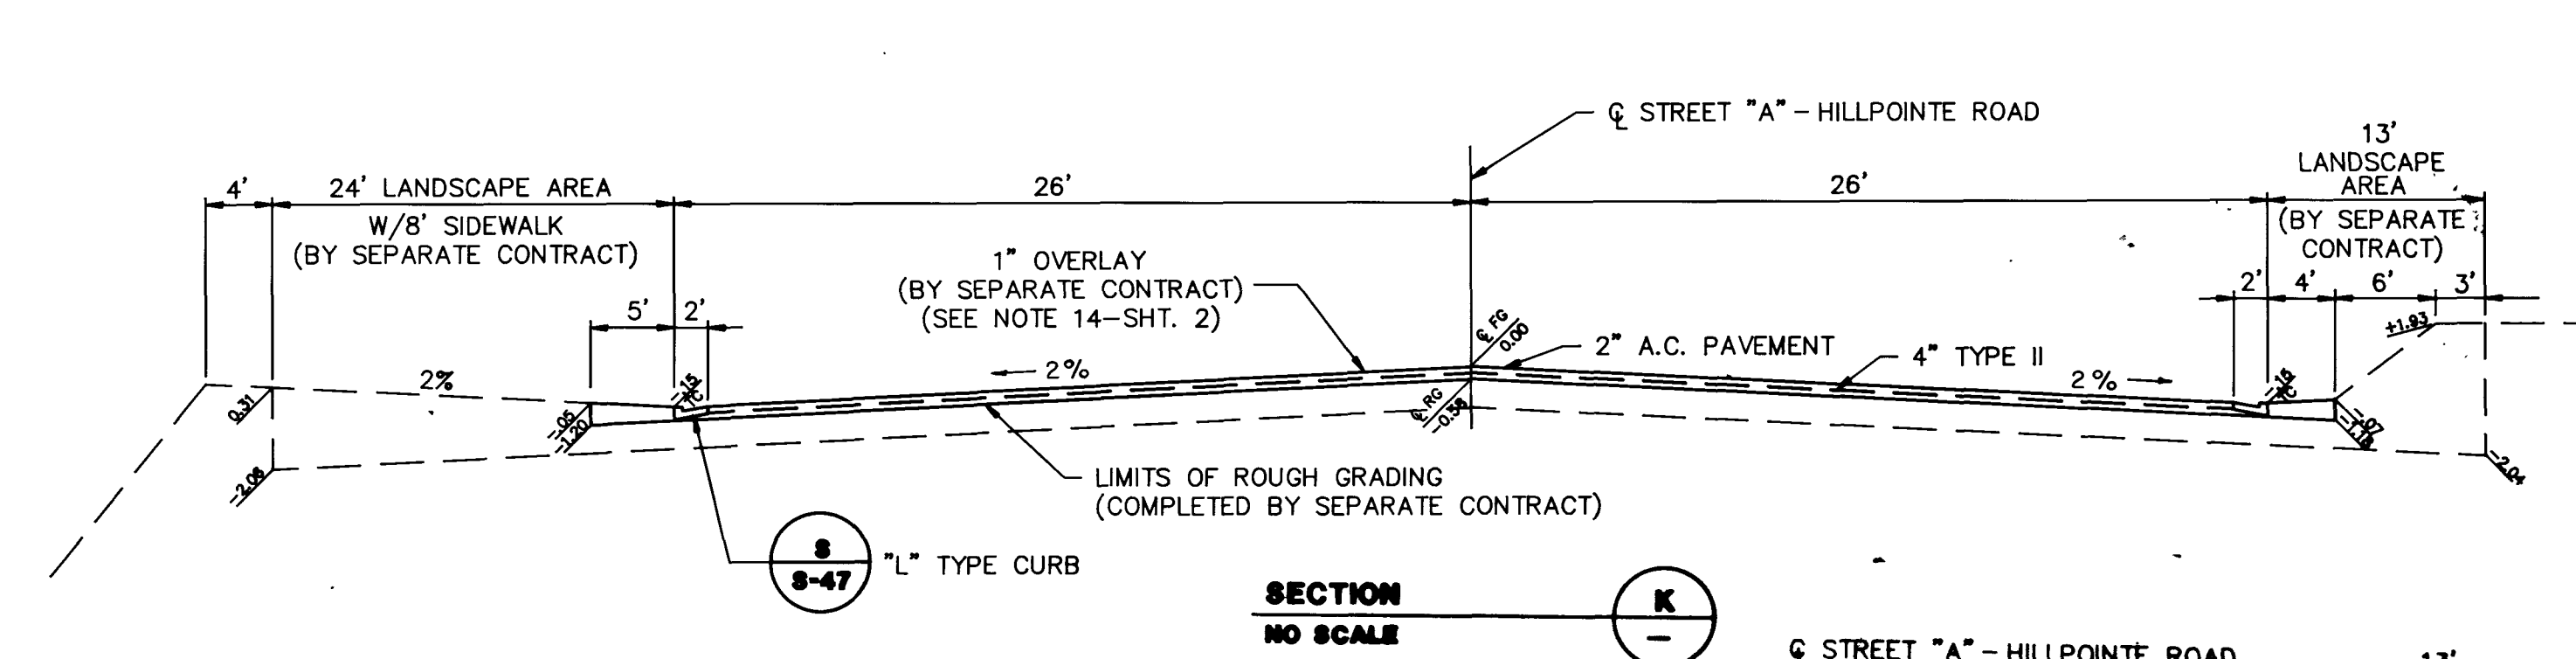
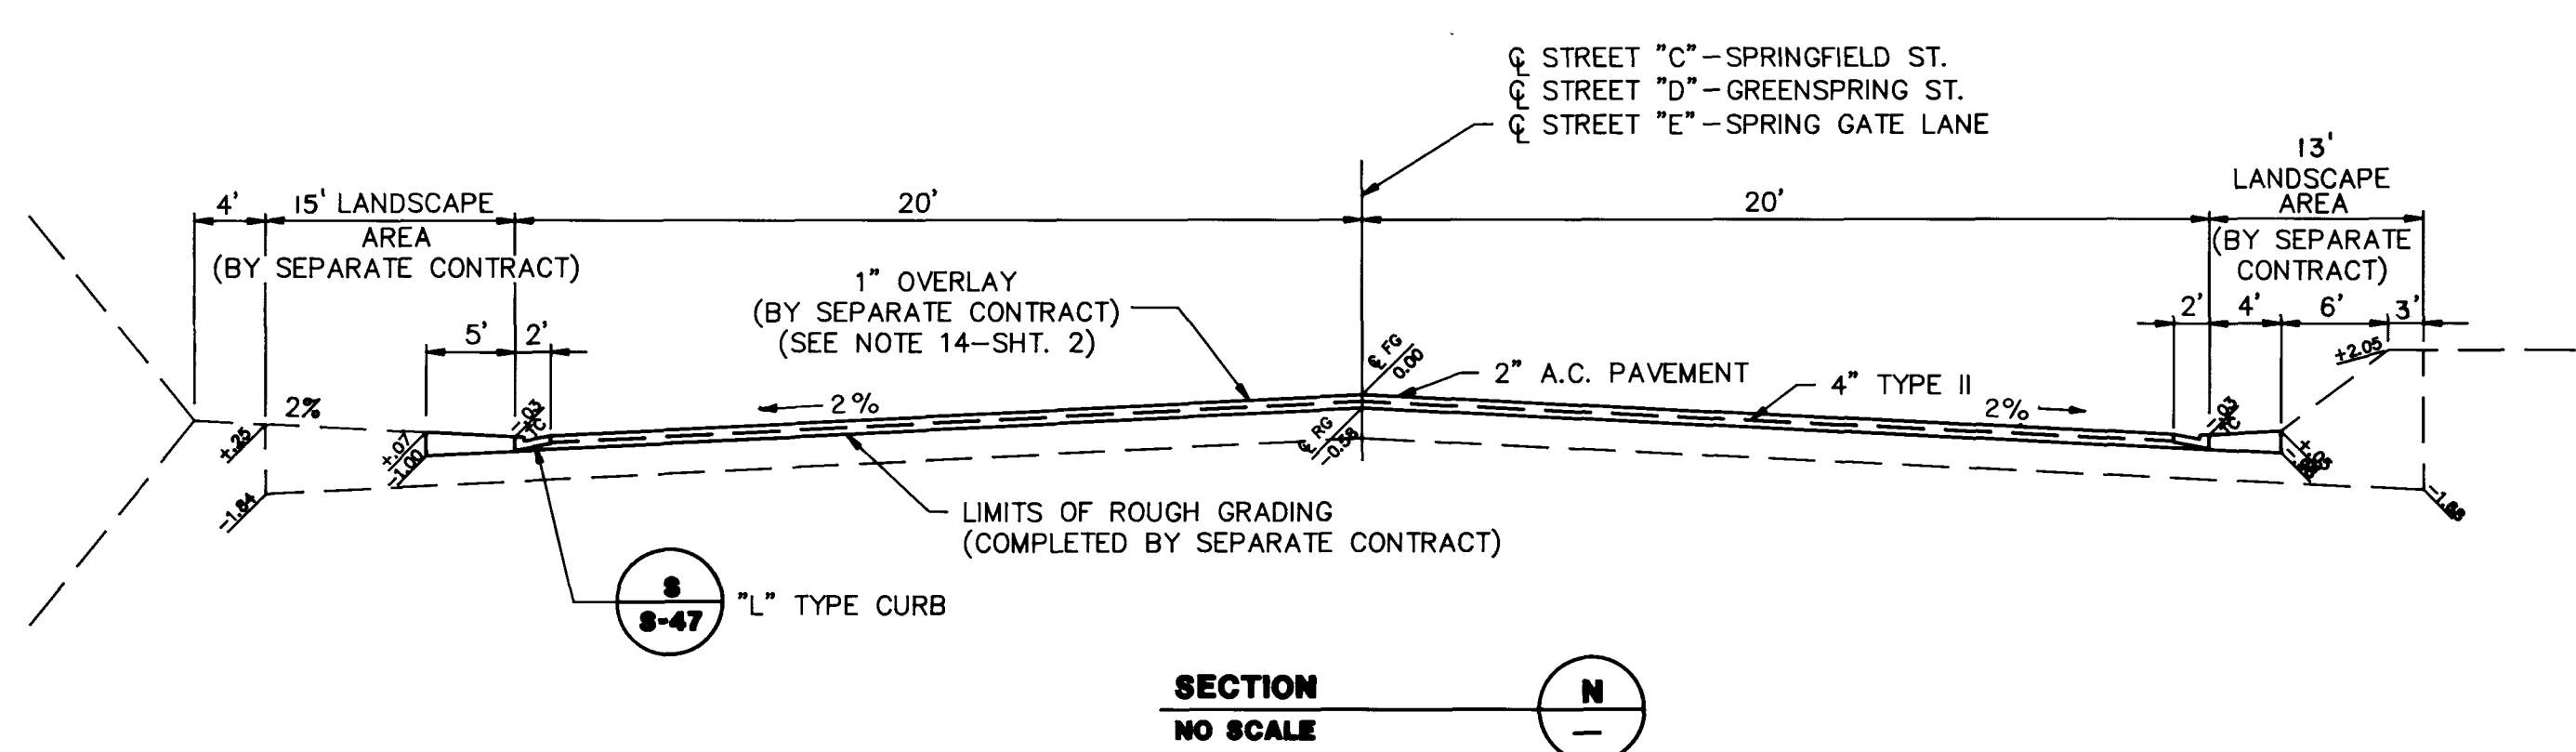
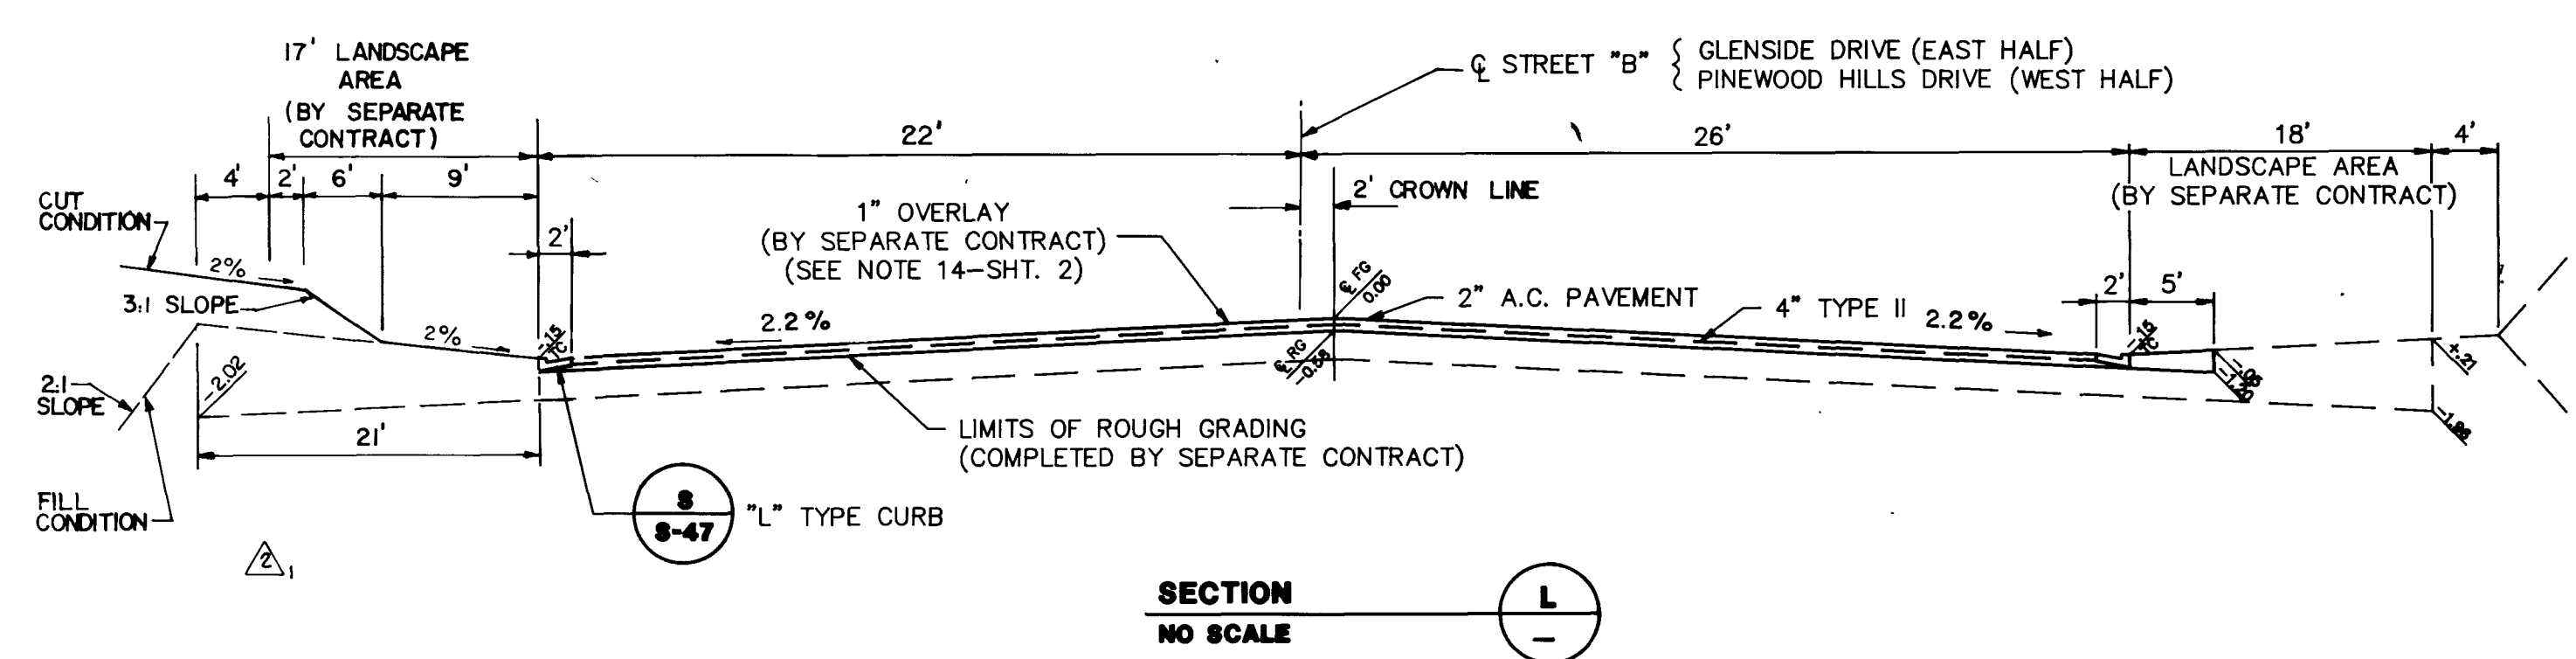
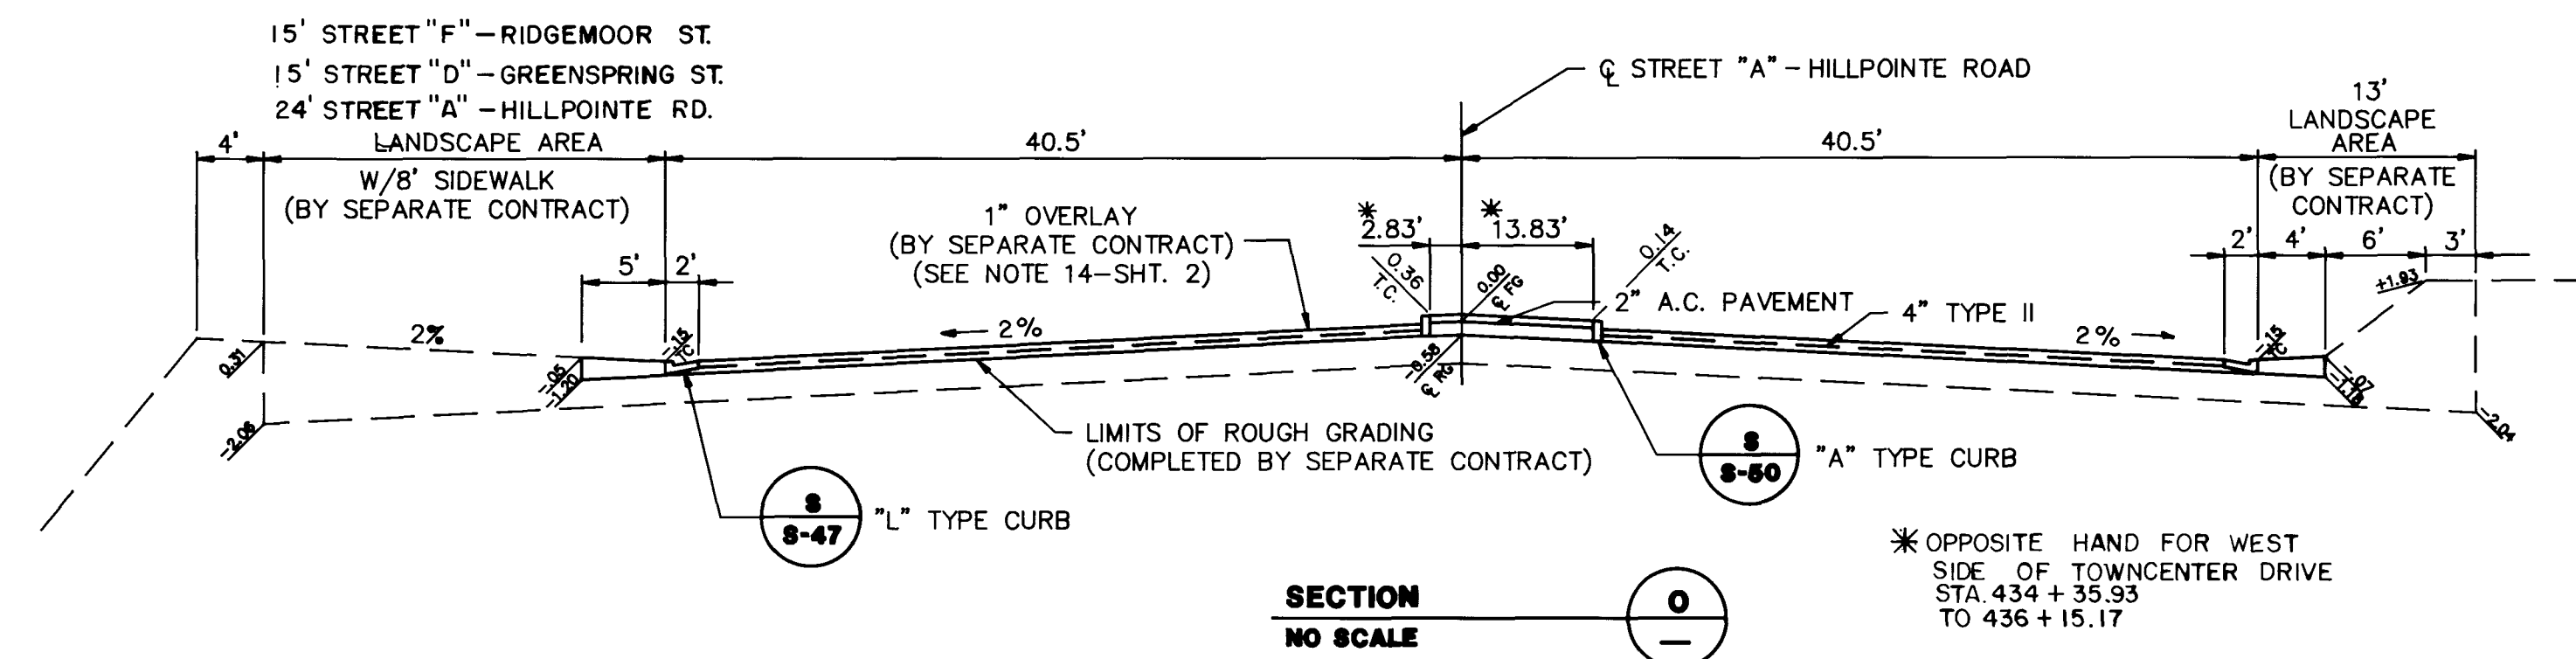
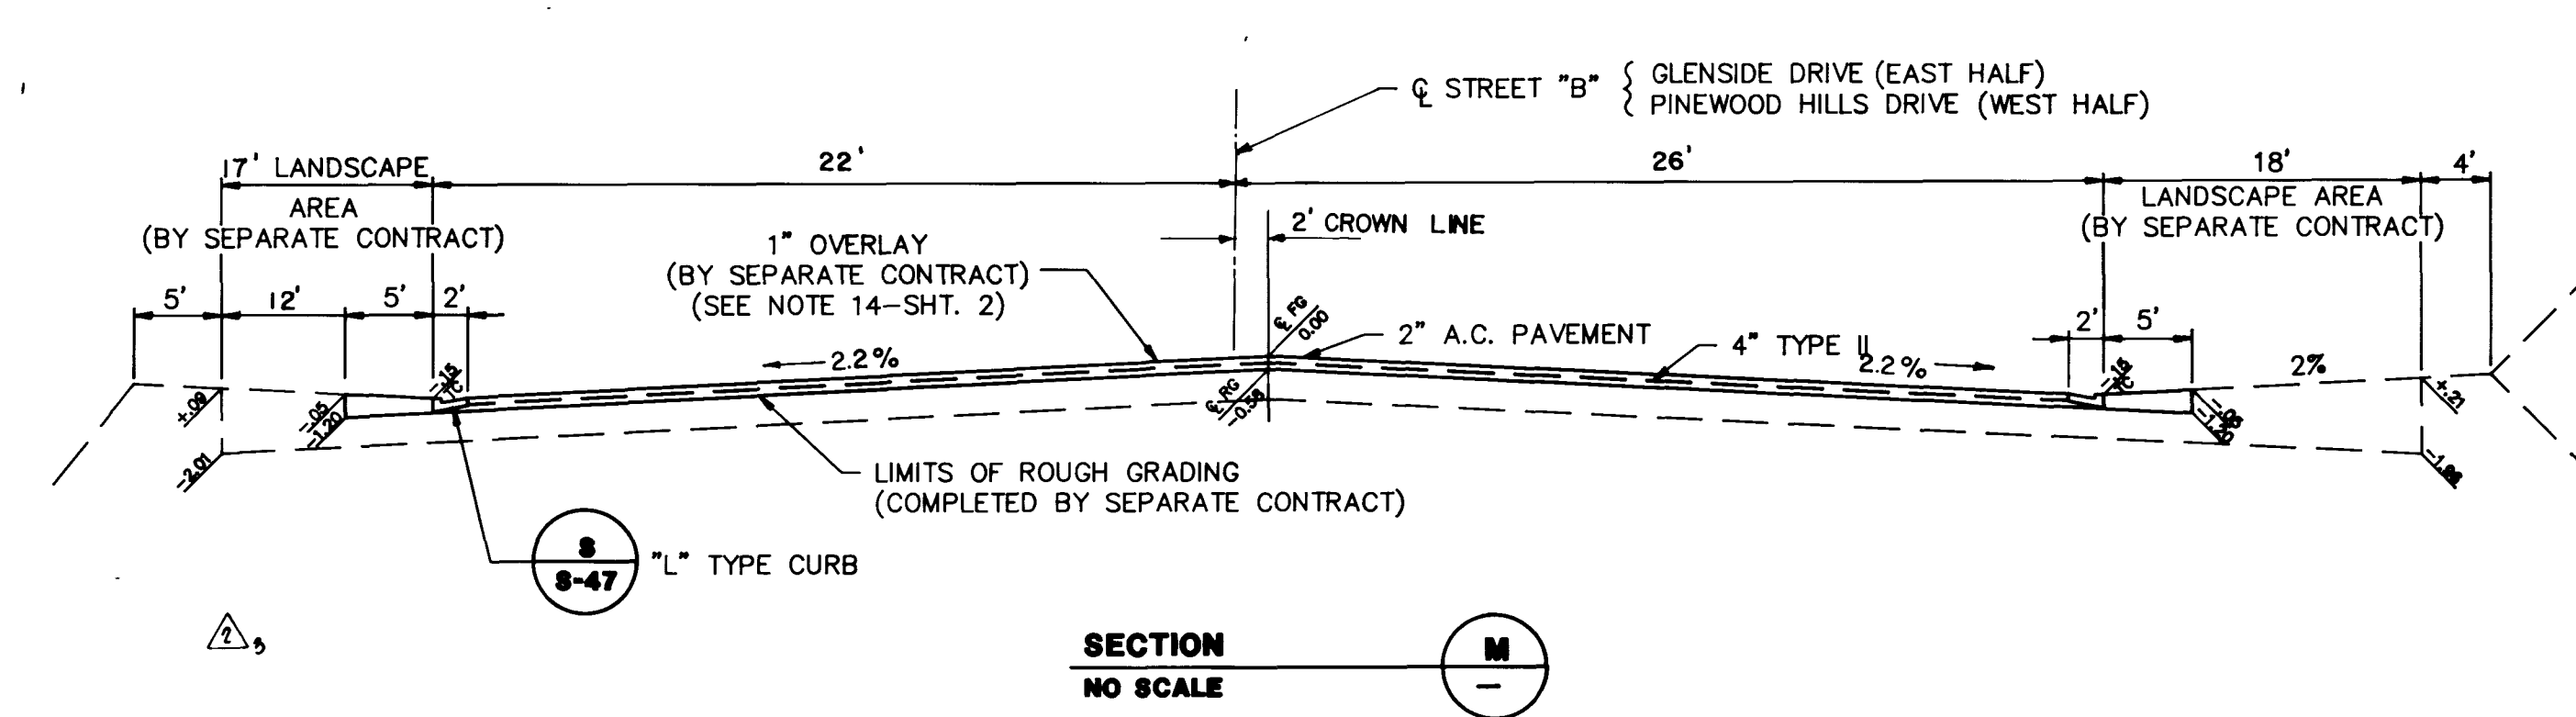
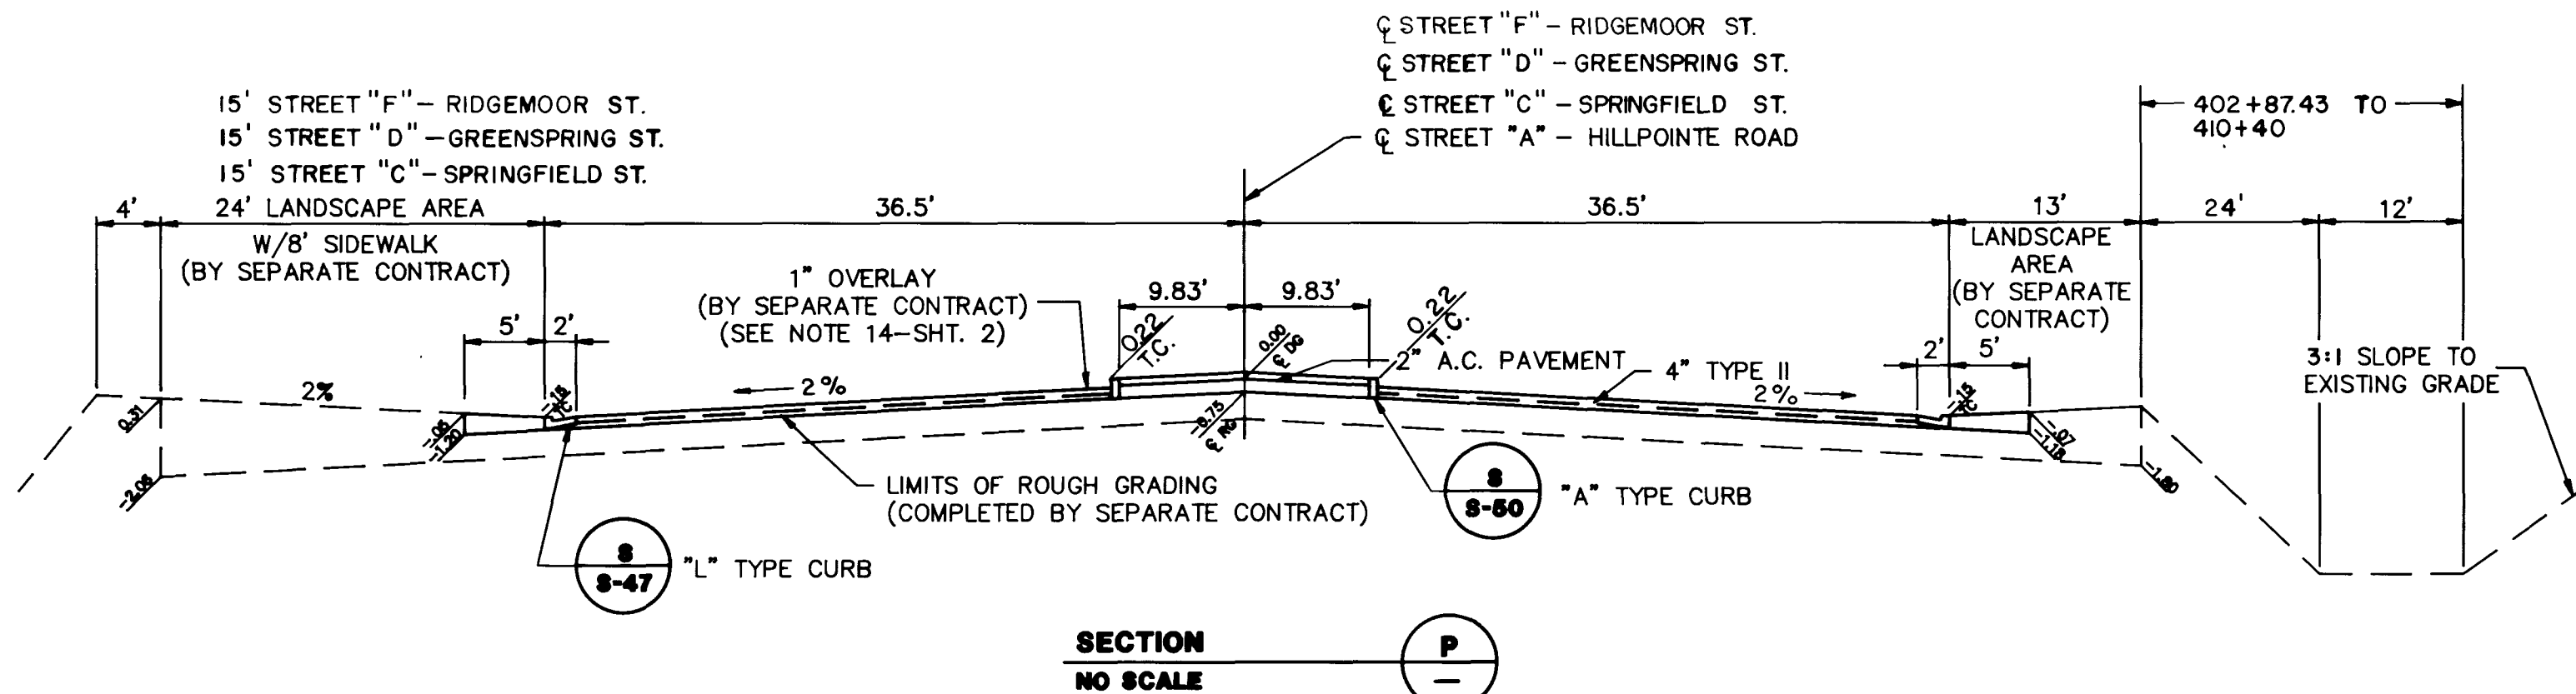


RECORD DRAWINGS
 THESE PLANS SHOW RECORD INFORMATION RECEIVED FROM:
 CONTRACTOR: SOUTHERN NEVADA PAVING/TAB
 DATE: 6-18-99
 THIS DATA MAY OR MAY NOT REFLECT THE ACTUAL FIELD LOCATIONS. ALL DATA SHOULD BE CONFIRMED PRIOR TO USE ON DEVELOPMENT OR ENGINEERING PLANS.

DESCRIPTION	ISSUE TO BID	DATE
REVISION	ISSUE TO CONSULT	DATE
REVISION	REVISION	DATE
REVISION	REVISION	DATE

1555 SOUTH RAINBOW BLVD. LAS VEGAS, NEVADA 89102

G.C. WALLACE, INC.
 Engineering/Architecture

HOWARD HUGHES PROPERTIES
 VILLAGE 1 NORTH IMPROVEMENTS
 TYPICAL STREET SECTIONS

SHEET 26
I-23
 26 OF 29 SHEETS

1860

15-365

107-VI695

