


JOB NO. 62012.215

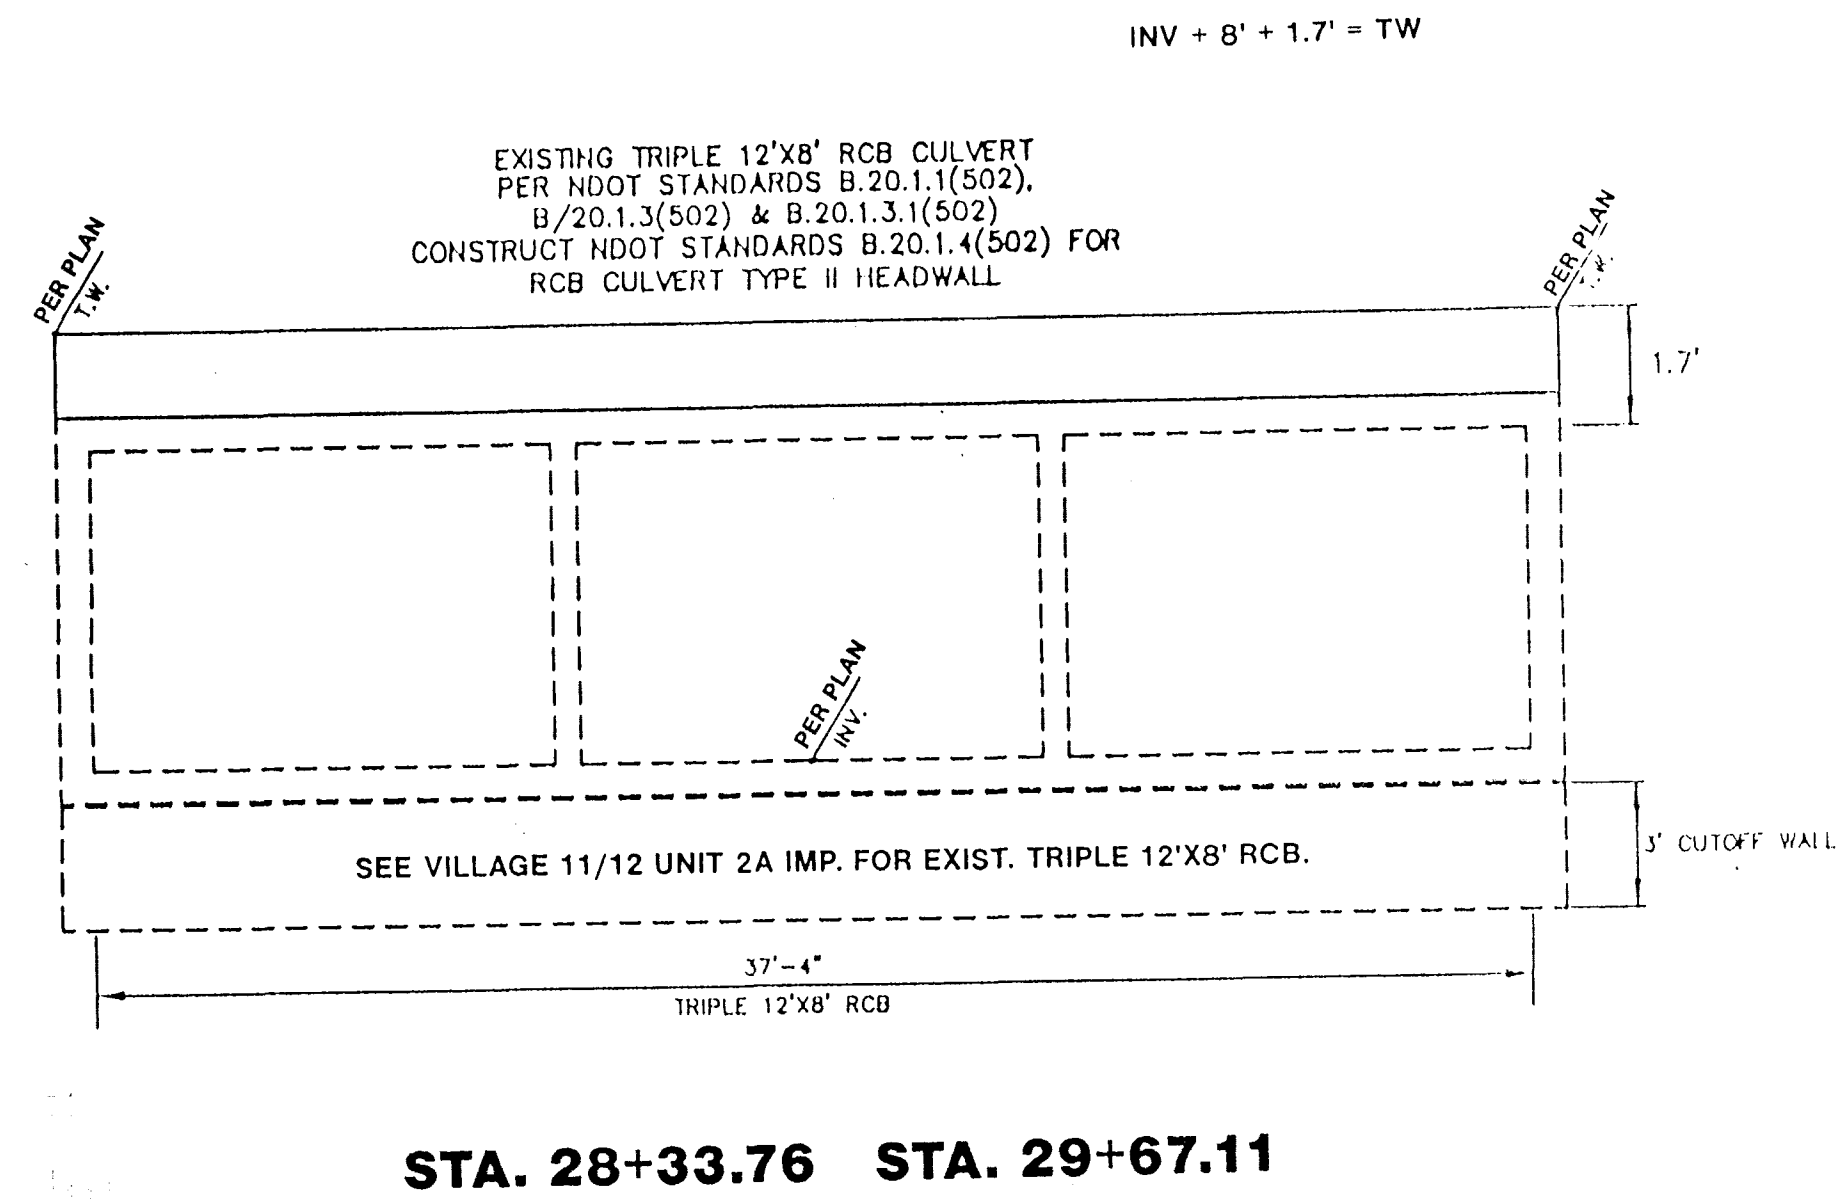

DRAWING CHANGE NOTICE:

PROJECT NAME: VILLAGE 11/12 ALTA DRIVE DRAINAGE CHANNEL

DATE: 07-30-96
JOB NO. 62011.215
DCN NO. ALTACHAN-02
AGENCY NO. 731-62

Christopher W. Anderson 7-30-96
DATE
Thomas Wall 8/1/96
DATE

Christopher W. Anderson 8/1/96
DATE
Thomas Wall 8/1/96
DATE

PLEASE REVIEW AND FORWARD A COPY OF SIGNED NOTICE TO GCW


RECORD DRAWINGS

THESE PLANS SHOW RECORD INFORMATION RECEIVED FROM:

CONTRACTOR: WELLS CARGO

DATE: 5/29/97

THIS DATA MAY OR MAY NOT REFLECT THE ACTUAL
FIELD LOCATIONS. ALL DATA SHOULD BE CONFIRMED
PRIOR TO USE ON DEVELOPMENT OR ENGINEERING
PLANS.

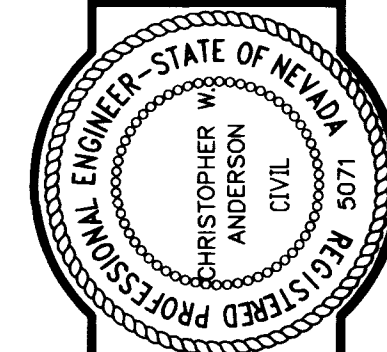

SUMMERLIN
VILLAGE 11/12 ALTA DRIVE
DRAINAGE CHANNEL
D.C.N. REVISION SHEET

SHEET

12

SHT 12 OF

G.C. WALLACE, INC.
Engineering/Architecture
1555 SOUTH HANBURY BLVD LAS VEGAS, NEVADA 89102

DATE

REVISION

DATE

DATE

