

ABBREVIATION LIST

1	And	GA	Gauge
2	Angle	GALV./G.I.	Galvanized Iron
3	At	GB	Grab Bar
4	Centerline	GC	General Contractor
5	Degree	GL	Glass
6	Diameter or Round	GND.	Ground
7	Existing	GR	Grate
8	Perpendicular	GTP.	Gypsum
9	Plate		
10	Found or Number		
ACOUS.	Acoustical	HB	Hose Bibb
ACU.	American Concrete	HIC	Hollow Core
AD.	Area Drain	HQDU.	Hardware
ADJ.	Adjustable	HGT.	Height
AF	Aggregate	HM.	Hollow Metal
AGGR	Aggregate	HORIZ.	Horizontal
AL	Aluminum	H.P.	High Point
ALT.	Alternate	HR	Hour
ANSI	American National Standards Institute	HR	Hand Rail
AP	Access Panel	HVAC	Heating, Ventilating, Air Conditioning
APPROX.	Approximate		
ARCH.	Architectural	ID.	Inside Diameter (Dim.)
ASB.	Asbestos	IN.	Inch
ASHRA	American Society of Heating Refrigerating & Air Conditioning Engineers	INSUL.	Insulation
	Asphalt	INT.	Interior
ASPH.	American Society for Testing & Materials	JAN.	Janitor
ASTM		JT.	Joint
BC.	Bottom of Curb	KIT.	Kitchen
BD.	Board		
BITUM.	Bituminous		
BLDG.	Building		
BLK.	Block	LAB.	Laboratory
BLKG.	Blocking	LAM.	Laminated
BM.	Beam	LAV.	Lavatory
BN.	Bull Nose	LCKR.	Locker
BOCA	Building Officials Code Administrators	LL.	Live Load
		L.P.	Low Point
		LT.	Light
BOT.	Bottom		
BRG.	Bearing	MAX.	Maximum
BTU	British Thermal Unit	MB.	Marker Board
BTUH	BTU/Hour	MC.	Medicine Cabinet
		MECH.	Mechanical
CAB.	Cabinet	MEMB.	Membrane
CB.	Chalkboard	MET.	Metal
CB.	Catch Basin	MEZZ.	Mezzanine
CEM.	Cement		
CER.	Ceramic	MFR.	Manufacturer
CFM.	Cubic Feet/Minute	M.H.	Manhole
CG.	Corner Guard	MIN.	Minimum
CI.	Cast Iron	MIR.	Mirror
C.I.P.	Cast in Place	MISC.	Miscellaneous
CJ.	Control Joint	M.O.	Masonry Opening
CLG.	Celling	MTD.	Mounted
CLKS.	Clauking	MUL.	Mullion
CLO.	Closet		
CLR.	Clear		
CPT.	Carpet	N.	North
CO.	Cleanout	NEC	National Electric Code
COL.	Column	NEMA	National Electric Manufacturers Association
CONC.	Concrete		
CONN.	Connection	N.I.C.	Not in Contract
CONSTR.	Construction	No. or	Number
CONT.	Continuous	NOM.	Nominal
CJ.	Control Joint	Non-comm	Non-combustible
CORR.	Corridor	NPC	National Plumbing Code
CNTR.	Counter	N.T.S.	Not To Scale
CSPE	Chlorosulfonated Polyethylene		
CT.	Ceramic Tile	OA.	Overall
CTR.	Contractor	OBBC	Ohio Basic Building Code
CTSK.	Contractor	OC.	On Center
		OD.	Outside Diameter (Dim.)
DBL.	Double	OFF.	Office
DEPT.	Department	OPNG.	Opening
DET.	Detail	OPP.	Opposite
DF.	Drinking Fountain	OF.	Over
DIA.	Diameter		
DIAG.	Diagonal	P.C.	Point of Curvature
DIM.	Dimension	P.J.	Panel Joint
DISP.	Dispenser	PL.	Plate
D.L.	Dead Load	PLAM.	Plastic Laminate
DN.	Down	PLAS.	Plaster
DO.	Ditto	PLBG.	Plumbing
D.O.	Door Opening	PLYWD.	Plywood
DR.	Drain	PNL.	Panel
DRU.	Drainage	PNT.	Point
D.S.	Dry Standpipe	PNS.	Positive
D.S.P.	Dry Standpipe	PP.	Power Pole
DUG.	Drawing	PR.	Pipe
		PRCST.	Precast
E.	East	PSF.	Pounds/Square Foot
EA.	Each	PSI.	Pounds/Square Inch
EJ.	Expansion Joint	PT.	Point
EL.	Elevation	PT.	Point
ELEC.	Electrical	P.T.	Point of Tangency
ELEV.	Elevator	P.T.D.	Paper Towel Dispenser
EMER.	Emergency	P.T.D/R	Paper Towel Dispenser & Receptacle
ENCL.	Enclosure	PTN.	Paper Towel
ENGR.	Engineer	P.T.R.	Paper Towel Receptacle
EP.	Electrical Panelboard		
EQ.	Equal	Q.T.	Quarry Tile
EQFT.	Equipment		
EUC.	Electric Water Cooler		
EXP.	Expansion		
EXPO.	Exposed		
EXT.	Existing	R.	Riser
EXT.	Exterior	R/RAD.	Radius
		RB.	Reinforced Base
FA.	Fire Alarm	RD.	Roof Drain
FB.	Flat Bar	REF.	Reference
FD.	Floor Drain	REFR.	Refrigerator
FDN.	Foundation	REIN.	Reinforced
FEE.	Fire Extinguisher	RESIL.	Resilient
FEC.	Fire Extinguisher Cab.	REV.	Revision
FHE.	Furnishings, Fixtures & Equip.	RGTR.	Register
FHC.	Fire Hose Cabinet	RM.	Room
FIN.	Finish	RO.	Rough Opening
FIX.	Fixture	R/S	Right of Shelf
FL.	Floor	R/W.	Right of Way
FLASH.	Flashing	RUD.	Reduced
FLUOR.	Fluorescent	RULL.	Rain Water Leader
F.O.C.	Face of Concrete		
F.O.F.	Face of Finish	S.	South
F.O.H.	Face of Mullion	SAN.	Sanitary
F.O.S.	Face of Stud	S.C.	Solid Core
FRF.	Fireproof	S.C.D.	Seal Cover Dispenser
FR.	Frame	SCHED.	Schedule
FS.	Finish Surface	S.D.	Soap Dispenser
FT.	Foot or Feet	SECT.	Section
FTG.	Footings	SH.	Shelf
FURR.	Furring	SHR.	Shower
FUT.	Future	SHT.	Sheet

ABBREVIATION LIST - cont.

SIM.	Similar	T.P.	Top of Pavement
SJ.	Sanitary Joint	TFD.	Toilet Paper Dispenser
SND.	Sanitary Napkin Dispenser	TFC.	Transformer
SNR.	Sanitary Napkin Receptacle	TRID.	Trailer
SPEC.	Specification	T.V.	Television
SPRKL.	Sprinkler	TOM.	Top of Masonry
SQ.	Square	TYP.	Typical
S.S.K.	Service Sink		
SST.	Stainless Steel		
ST.	Storm	U.B.C.	Uniform Building Code
STA.	Station	UNF.	Unfinished
STD.	Standard	UNO.	Unless Noted Otherwise
STL.	Steel	UR.	Urinal
STOR.	Storage		
STR.	Structural		
SUSP.	Suspended		
S.V.	Safety Vestibule	V.C.T.	Vertical Composition Tile
SYM.	Symmetrical	VERT.	Vertical
		VEST.	Vestibule

GENERAL NOTES

GENERAL NOTES AND INSTRUCTIONS

- THE TERM 'ARCHITECT/ENGINEER' REFERS TO THE RESPONSIBLE ENTITY WHOSE NAME APPEARS ON THE CONTRACT DOCUMENTS.
- THE TERM 'CONTRACT DOCUMENTS' REFERS TO THE DRAWINGS, SPECIFICATIONS, AND OTHER DOCUMENTS ISSUED BY THE ARCHITECT/ENGINEER.
- THE DRAWINGS AND SPECIFICATIONS ARE PREPARED TO SHOW THE ARCHITECT'S INTENT IN THE DESIGN AND CONSTRUCTION OF THE PROJECT. IN ALL MATTERS RELATED TO THE USE OR INTERPRETATION OF THESE VARIOUS DRAWINGS AND SPECIFICATIONS, THE ARCHITECT'S WRITTEN STATEMENT IS CONSIDERED FINAL. MAKE NO DEVIATIONS FROM THE DRAWINGS OR SPECIFICATIONS WITHOUT WRITTEN APPROVAL FROM THE ARCHITECT.
- ABSOLUTE ACCURACY OF DATA INDICATED IN THE DRAWINGS AND/OR SPECIFICATIONS IS NOT GUARANTEED. THE DOCUMENTS MAY REPRESENT IMPERFECT DATA AND MAY CONTAIN ERRORS, OMISSIONS, INCONSISTENCIES, CODE VIOLATIONS, AND IMPROPER USE OF MATERIALS. SUCH DEFICIENCIES WILL BE CORRECTED WHEN IDENTIFIED. THE CONTRACTOR IS REQUIRED TO CAREFULLY STUDY AND COMPARE THE DRAWINGS AND SPECIFICATIONS AND IMMEDIATELY REPORT TO THE ARCHITECT ANY DEFICIENCIES DISCOVERED. THE CONTRACTOR MUST REQUIRE EACH SUBCONTRACTOR TO LIKEWISE STUDY THE DOCUMENTS AND REPORT ANY DEFICIENCIES DISCOVERED. THE CONTRACTOR IS REQUIRED TO RESOLVE ALL REPORTED DEFICIENCIES WITH THE ARCHITECT PRIOR TO STARTING THE WORK. ANY WORK PERFORMED PRIOR TO THE RECEIPT OF INSTRUCTIONS FROM THE ARCHITECT WILL BE DONE AT CONTRACTOR'S RISK.
- UPON DISCOVERY OF A DISCREPANCY IN THE DRAWINGS AND/OR SPECIFICATIONS, IT WILL BE DEEMED THAT THE CONTRACTOR ESTIMATED THE MOST EXPENSIVE MATERIALS AND LABOR INVOLVED, UNLESS THE CONTRACTOR REQUESTED AND OBTAINED WRITTEN CLARIFICATION FROM THE ARCHITECT DEFINING WHICH METHODS OR MATERIALS ARE REQUIRED.
- DIMENSIONS FORMAT:
A) USE ONLY WRITTEN DIMENSIONS FOR CONSTRUCTION.
B) DIMENSIONS FOR STUD PARTITIONS ARE TO FACE OF STUD OR MASONRY UNLESS NOTED OTHERWISE ON DRAWINGS.
C) DIMENSIONS ARE TO ROUGH CONSTRUCTION UNLESS NOTED OTHERWISE.

GENERAL REQUIREMENTS OF THE CONTRACTOR

- SUPERVISE AND DIRECT ALL WORK. BE RESPONSIBLE FOR ALL MEANS AND METHODS, TECHNIQUES, SEQUENCES, AND PROCEDURES. COORDINATE ALL PORTIONS OF WORK UNDER THE CONTRACT. USE ADEQUATE NUMBERS OF SKILLED WORKMEN WHO ARE THOROUGHLY TRAINED AND EXPERIENCED IN THEIR TRADES AND WHO ARE COMPLETELY FAMILIAR WITH THE SPECIFIED REQUIREMENTS AND METHODS NECESSARY FOR PROPER PERFORMANCE OF THE WORK.
- PERFORM ALL WORK SHOWN OR NOTED ON THE DRAWINGS IN STRICT ACCORDANCE WITH OR EXCEEDING ALL LOCAL, STATE, AND FEDERAL MINIMUM STANDARDS OF AGENCIES HAVING JURISDICTION OVER THE PROJECT, AND THE CURRENT AND APPLICABLE EDITIONS OF THE UNIFORM BUILDING CODE, UNIFORM MECHANICAL CODE, UNIFORM PLUMBING CODE, AND NATIONAL ELECTRICAL CODE.
- BE FAMILIAR WITH ALL DRAWINGS AND SPECIFICATIONS OF THE VARIOUS BUILDING SYSTEMS. INFORMATION SHOWN ON ONE DOCUMENT MAY REPRESENT INFORMATION RELATIVE TO OTHER DOCUMENTS.
- BECOME FAMILIAR WITH THE EXISTING JOB SITE AND EXISTING CONDITIONS AND ACCEPT THE CONDITIONS AS THEY ARE FOUND.
- INVESTIGATE, VERIFY, AND BE RESPONSIBLE FOR ALL CONDITIONS OF THE JOB SITE AND NOTIFY THE ARCHITECT OF ANY CONDITIONS WHICH CONFLICT WITH THE CONSTRUCTION DOCUMENTS PRIOR TO PROCEEDING.
- VERIFY ALL DIMENSIONS IN THE FIELD AND NOTIFY THE ARCHITECT OF ANY ERRORS, OMISSIONS, OR DISCREPANCIES PRIOR TO PROCEEDING WITH THE WORK.
- BE RESPONSIBLE FOR THE ACCURACY OF THE BUILDING LINES AND LEVELS AND FOR THE CAREFUL COMPARISON OF THE LINES AND LEVELS SHOWN ON THE DRAWINGS WITH THE EXISTING SITE CONDITIONS, AND CALL ANY DISCREPANCIES TO THE ATTENTION OF THE ARCHITECT PRIOR TO PROCEEDING WITH THE WORK.
- REQUEST A CLARIFICATION FROM THE ARCHITECT IF UNCERTAIN OF EXACT REQUIREMENTS OF THE DRAWINGS AND SPECIFICATIONS. CONTRACTOR SHALL BE RESPONSIBLE TO CORRECT THE CONDITIONS CONSTRUCTED IN ERROR AT CONTRACTOR'S OWN EXPENSE AND SHALL BE RESPONSIBLE FOR THE EXPENSE AND REPAIR OF ANY RESULTING DAMAGE OR DEFECT TO THE WORK OR PROPERTY OF OTHERS.
- OBTAIN ALL PERMITS, AND PAY ALL RELATED COSTS AND FEES.
- PERFORM NO PORTION OF WORK REQUIRING A SHOP DRAWING OR SAMPLE SUBMITTAL UNTIL THE SUBMITTAL HAS BEEN REVIEWED BY THE ARCHITECT. THE AUTHOR OF, OR PARTY RESPONSIBLE FOR, EACH SHOP DRAWING IS REQUIRED TO INSURE THAT SUCH DOCUMENTS ACCURATELY CONFORM WITH THE DESIGN CONCEPT AND COMPLY WITH THE INFORMATION GIVEN IN THE CONTRACT DOCUMENTS. SEE THE 'SHOP DRAWING SUBMITTAL' SECTION OF THE SPECIFICATIONS.

GENERAL NOTES - cont.

GENERAL REQUIREMENTS OF THE CONTRACTOR CONT.

- CONFINE THE OPERATIONS AT THE SITE TO AREAS LIMITED BY LAWS, ORDINANCES, PERMITS, AND THE CONTRACT DOCUMENTS. DO NOT UNREASONABLY ENCUMBER THE SITE WITH MATERIALS OR EQUIPMENT.
- MAINTAIN THE JOB SITE IN A CLEAN, ORDERLY CONDITION, FREE OF DEBRIS AND LITTER. UPON COMPLETION OF EACH SEGMENT OR PHASE OF WORK, REMOVE ALL TRASH AND DEBRIS RESULTING FROM THE WORK.
- PROPERLY STACK AND PROTECT ALL MATERIALS STORED ON THE SITE TO PREVENT DAMAGE AND DETERIORATION. FAILURE TO PROTECT MATERIALS MAY BE CAUSE FOR REJECTION OF THE WORK.
- PERFORM CUTTING, FITTING, OR PATCHING IN A MANNER REQUIRED TO PROPERLY JOIN THE PARTS OF THE WORK TOGETHER. AVOID UNNECESSARILY ENDANGERING ANY WORK BY CUTTING, EXCAVATING, OR OTHERWISE ALTERING ANY PART OF IT.
- PERFORM ALL PATCHING, REPAIRING, AND REPLACING OF MATERIALS AND SURFACES CUT OR DAMAGED IN THE EXECUTION OF THE WORK WITH APPROPRIATE MATERIALS SO THAT UPON COMPLETION, THE SURROUNDING SURFACES BLEND TOGETHER AND MATCH.
- PROVIDE PUBLIC PROTECTION AND MAINTENANCE TO ALL AREAS AFFECTED BY THE WORK AS NECESSARY AND AS REQUIRED BY LOCAL, STATE, AND FEDERAL CODES.
- PROVIDE TEMPORARY TOILET FACILITIES FOR ALL CONSTRUCTION PERSONNEL THROUGHOUT COMPLETION OF THE WORK.
- USE ONLY NEW MATERIALS OF GRADES AND TYPES SPECIFIED UNLESS NOTED OTHERWISE. GUARANTEE ALL WORK AND MATERIALS FOR A MINIMUM OF ONE YEAR.
- PROTECT EXISTING AND NEW CONSTRUCTION, EQUIPMENT, AND FINISHED SURFACES AND MAINTAIN THEM CLEAN, UNHARMED, AND SUITABLY PROTECTED UNTIL ACCEPTED BY THE OWNER. IN THE EVENT OF DAMAGE, PROMPTLY MAKE REPLACEMENTS AND REPAIRS TO THE SATISFACTION OF THE ARCHITECT AND ASSUME ALL COSTS.
- PROVIDE 'AS-BUILT' DOCUMENTATION FOR ANY WORK VARYING FROM OR NOT IDENTIFIED IN THE CONTRACT DOCUMENTS.
- BE RESPONSIBLE FOR INITIATING, MAINTAINING, AND SUPERVISING ALL SAFETY PRECAUTIONS AND PROGRAMS IN CONNECTION WITH THE WORK AND PROVIDE SAFE ACCESS TO AND FROM ALL LOCATIONS.
- SCHEDULE THE WORK IN A MANNER WHICH MINIMIZES DISRUPTION TO THE OWNER'S OPERATIONS.
- NOTIFY THE ARCHITECT AND/OR OWNER, IN WRITING, A MINIMUM OF FORTY-EIGHT HOURS PRIOR TO THE DISRUPTION OF ANY UTILITY SERVICES.
- SECURE ALL AREAS OF THE WORK SITE EACH DAY UPON LEAVING THE PREMISES.


WORKING DRAWING SYMBOLS

WORKING DRAWING SYMBOL	LOCATION	USE
SECTION NUMBER SHEET NUMBER	PLANS & ELEVATIONS	FULL BUILDING SECTION
DETAIL LETTER SHEET NUMBER	PLANS & SECTIONS	WALL SECTIONS
ELEVATION LETTER SHEET NUMBER	PLANS	EXTERIOR ELEVATIONS
DOOR NUMBER HARDWARE SET INTERLOCK NUMBER	PLANS	ALL DOORS
ELEVATION TARGET	AT TOP OF SLAB OR HEIGHT	VERTICAL HEIGHTS
EXTERIOR WINDOW TYPE	AT EXTERIOR ELEVATIONS & PLANS	EXTERIOR WINDOWS
INTERIOR WINDOW TYPE	AT INTERIOR ELEVATIONS & PLANS	INTERIOR WINDOWS
HANDICAP ACCESS SYMBOL	PLANS	HANDICAP SPECIFIC AREAS
CONSTRUCTION NOTE	PLANS & ELEVATIONS	KEYNOTES
INTERIOR ELEVATION SYMBOL	PLANS	
EXISTING STRUCTURAL GRID BUBBLE	SECTIONS PLANS & ELEVATIONS	
STRUCTURAL GRID BUBBLE	SECTIONS PLANS & ELEVATIONS	
EQUIPMENT NOTE	PLANS & ELEVATIONS	
REVISION NOTE	SECTIONS PLANS & ELEVATIONS	
ROOM NAME ROOM NUMBERS	PLANS SECTIONS	

PROJECT DIRECTORY

CLIENT The Howard Hughes Corporation Summerlin 10,000 West Charleston, Suite 1200 Las Vegas, NV 89135 (TEL) (702) 791-4388 (FAX) (702) 791-4453 Gerald M. Robbins CLIENT REPRESENTATIVE	MECHANICAL PLUMBING & ELECTRICAL CONSULTANT Harris Consulting Engineers 731 Pilot Road, Suite L Las Vegas, NV 89119 (TEL) (702) 263-1515 (FAX) (702) 263-1514 ARCHITECT LUCCHESI, GALATI ARCHITECTS 500 PILOT ROAD SUITE A LAS VEGAS, NEVADA 89119 (TEL) (702) 263-1111 (FAX) (702) 263-8111 (E-MAIL) LGAL@LGAINC.COM Craig S. Galati PRINCIPAL-IN-CHARGE Scott Carter PROJECT MANAGER Dave Truman PROJECT ARCHITECT	CIVIL ENGINEER CONSULTANT G. C. Wallace, Inc. 1555 South Rainbow Blvd. Las Vegas, NV 89102 (TEL) (702) 363-1000 (FAX) (702) 363-8979 Burt Hughes PROJECT MANAGER LANDSCAPE CONSULTANT IDEA, Inc. 815 North First Avenue Suite 6 Phoenix, AZ 85003 (TEL) (602) 258-4332 (FAX) (602) 258-0448 Ryan Tietz PROJECT MANAGER STRUCTURAL CONSULTANT Barnett & Jimenez, Inc. 2481 N. Decatur Blvd. Suite B Las Vegas, NV 89208 (TEL) (702) 631-0200 (FAX) (702) 631-0206 (E-MAIL) brj@barnett.com Harry Weidman PROJECT ENGINEER SWIMMING POOL CONSULTANT Aquatic Design Group 1550 Kellogg Avenue Carlsbad, CA 92008 (TEL) (760) 438-8400 (FAX) (760) 438-5251 Scott Ferrell PROJECT ENGINEER
--	---	--

VICINITY MAP

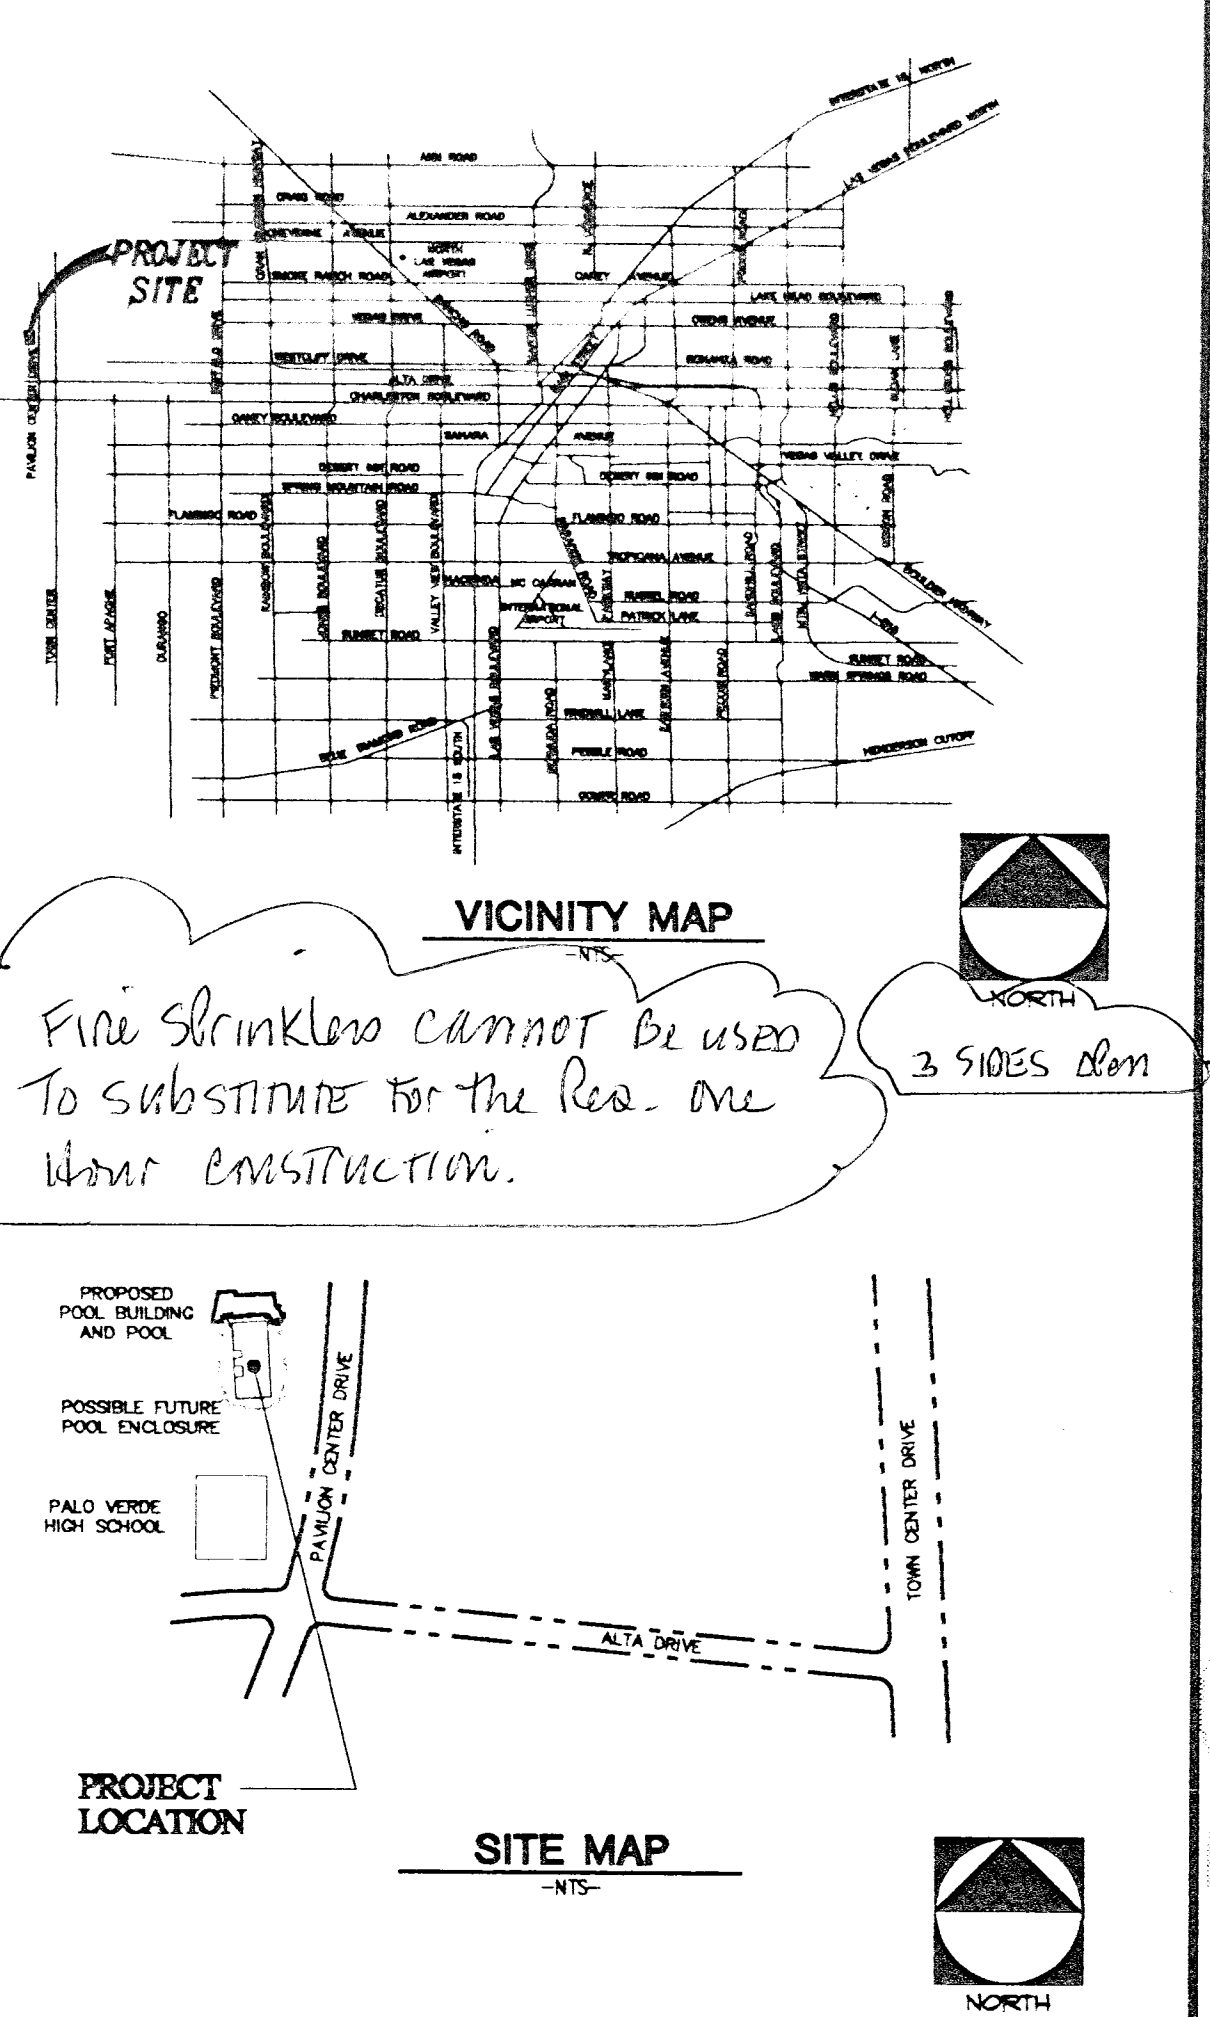

INDEX OF SHEETS

SHEET	DESCRIPTION
G1.01	COVER SHEET GENERAL NOTES, SHEET INDEX, PROJECT DIRECTORY, VICINITY MAP, ABBREVIATION LIST AND WORKING DRAWING SYMBOLS EXISTING FLOOR PLAN
G1.02	CIVIL DRAWINGS COVER SHEET PROJECT DATA SHEET HORIZONTAL CONTROL PLAN 1 HORIZONTAL CONTROL PLAN 2 GRADING PLAN 1 GRADING PLAN 2 UTILITY PLAN 1 UTILITY PLAN 2 PLAN & PROFILE DETAILS SECTIONS & DETAILS SECTIONS & DETAILS CITY OF LAS VEGAS FIRE ACCESS AGREEMENTS GRADING PLAN 3
G1.03	LANDSCAPE DRAWINGS COVER SHEET GENERAL NOTES KEY PLAN HARDSCAPE LAYOUT PLAN HARDSCAPE DETAILS PLANTING PLAN POOL HOUSE IRRIGATION PLAN IRRIGATION DETAILS RAMADA FLOOR PLAN RAMADA ELEVATIONS, SECTIONS, AND DETAILS RAMADA GENERAL STRUCTURAL NOTES RAMADA TYPICAL DETAILS RAMADA FOUNDATION AND FRAMING PLAN RAMADA FOUNDATION AND FRAMING DETAILS
G1.04	STRUCTURAL GENERAL NOTES FOUNDATION PLAN ROOF FRAMING PLAN SECTIONS & DETAILS SECTIONS & DETAILS SECTIONS & DETAILS
G1.05	ARCHITECTURAL ARCHITECTURAL SITE PLAN OVERALL ARCHITECTURAL SITE PLAN SITE DETAILS FLOOR PLAN ENLARGED FLOOR PLANS, TOILET ACCESSORY SCHEDULE & NOTES FINISH FLOOR PLAN, ROOM FINISH AND MATERIAL SCHEDULES INTERIOR ELEVATIONS DOOR SCHEDULES & TYPES, WINDOW TYPES WINDOW & DOOR DETAILS REFLECTED CEILING PLAN ROOF PLAN ROOF DETAILS EXTERIOR ELEVATIONS BUILDING SECTIONS WALL SECTIONS
G1.06	MECHANICAL HVAC LEGEND & SCHEDULES HVAC PLAN
G1.07	PLUMBING PLUMBING LEGEND, FIXTURE AND EQUIPMENT SPECIFICATIONS WASTE AND VENT PIPING PLAN HOT AND COLD WATER SUPPLY PIPING PLAN GAS, CONDENSATE AND ROOF DRAINAGE PIPING PLAN PLUMBING RISER DIAGRAM PLUMBING RISER DIAGRAM PLUMBING/ELECTRICAL SITE PLAN
G1.08	ELECTRICAL ELECTRICAL LEGEND, ABBREVIATIONS AND LIGHT FIXTURE SCHEDULE LIGHTING PLAN POWER AND AUXILIARY PLAN SINGLE LINE DIAGRAM AND SCHEDULES ELECTRICAL DETAILS
G1.09	SWIMMING POOL SWIMMING POOL LAYOUT PLAN SWIMMING POOL PIPING PLAN SWIMMING POOL UNDERWATER LIGHT/TIMING SYSTEM PLAN SWIMMING POOL SECTIONS DETAILS DETAILS DETAILS DETAILS DETAILS MECHANICAL ROOM PLAN MECHANICAL ROOM SECTION
G1.10	CODE ANALYSIS 1. OCCUPANCY CLASSIFICATION (TABLE 3A) - A2 2. TYPE OF CONSTRUCTION (TABLE 5B) - V-ONE HOUR 3. FIRE SPRINKLERS (SBCA 904.2.3) - APPROVED FIRE ALARM SYSTEM (303.9) REQUIRED 4. HEIGHT (506) - ALLOWED - 65' ACTUAL - 35' 5. STORIES (TABLE 5-B) - ALLOWED - 3 ACTUAL - 1 6. AREA (504) - BASIC ALLOWABLE AREA (TABLE 5-B) 10500 SQ. FT. ALLOWABLE INCREASES: SEPARATION ON ALL SIDES (505.1.3) 100% (10500) = 21000 SQ. FT. APPROVED FIRE ALARM SYSTEM (303.9) X 3 = 63,000 SQ. FT. ALLOWED ACTUAL = 1135 SQ. FT. 7. OCCUPANT LOAD (TABLE 10-A) TOTAL = 103 (TOTAL SQ. FT. / 60 FT. PER OCCUPANT) TOTAL OCCUPANT LOAD: SPACE OFFICE 16 100 LOBBY 4025 100 VENDING 291 15 HALLWAYS 114 100 TOILET ROOMS 130 100 LOCKER ROOMS 152 100 VESTIBULE 284 100 8. EXITS (1004) BATH HOUSE - REQUIRED - 1 PROVIDED - 1 BATH AREA - REQUIRED - 1 PROVIDED - 1 9. REQUIRED FIRE RESISTANCE (TABLE 6-A) ONE HOUR COMBUSTIBLE 10. FIRE RESISTIVE CONSTRUCTION REQUIREMENTS (TABLE 5-A & 6-A) BEARING WALLS/EXTERIOR 1-HOUR BEARING WALLS/INTERIOR 1-HOUR NON-BEARING WALLS/EXTERIOR 1-HOUR STRUCTURAL FRAME PARTITIONS/PERMANENT 1-HOUR 11. SPECIAL INSPECTIONS REFER TO SHEET 50.01 12. CODE YEAR/TYPE 1991 EDITION OF THE UNIFORM BUILDING CODE

GENERAL NOTES, SHEET INDEX, PROJECT DIRECTORY, VICINITY MAP, ABBREVIATION LIST AND WORKING DRAWING SYMBOLS

SUMMERLIN ARBORS PARK
POOL AND POOL BUILDING

RECEIVED
JUL 26 2000
CITY OF LAS VEGAS
CENTRAL PERMITS

Sheet Number: 102202 Date: October 22, 1999 Project No. 9803500 Scale: NO SCALE Drawn By: DDT

G1.01

LUCCHESI, GALATI ARCHITECTS
500 PILOT ROAD, SUITE A • LAS VEGAS, NEVADA 89119 • PHONE (702) 263-1111 FAX (702) 263-8111