
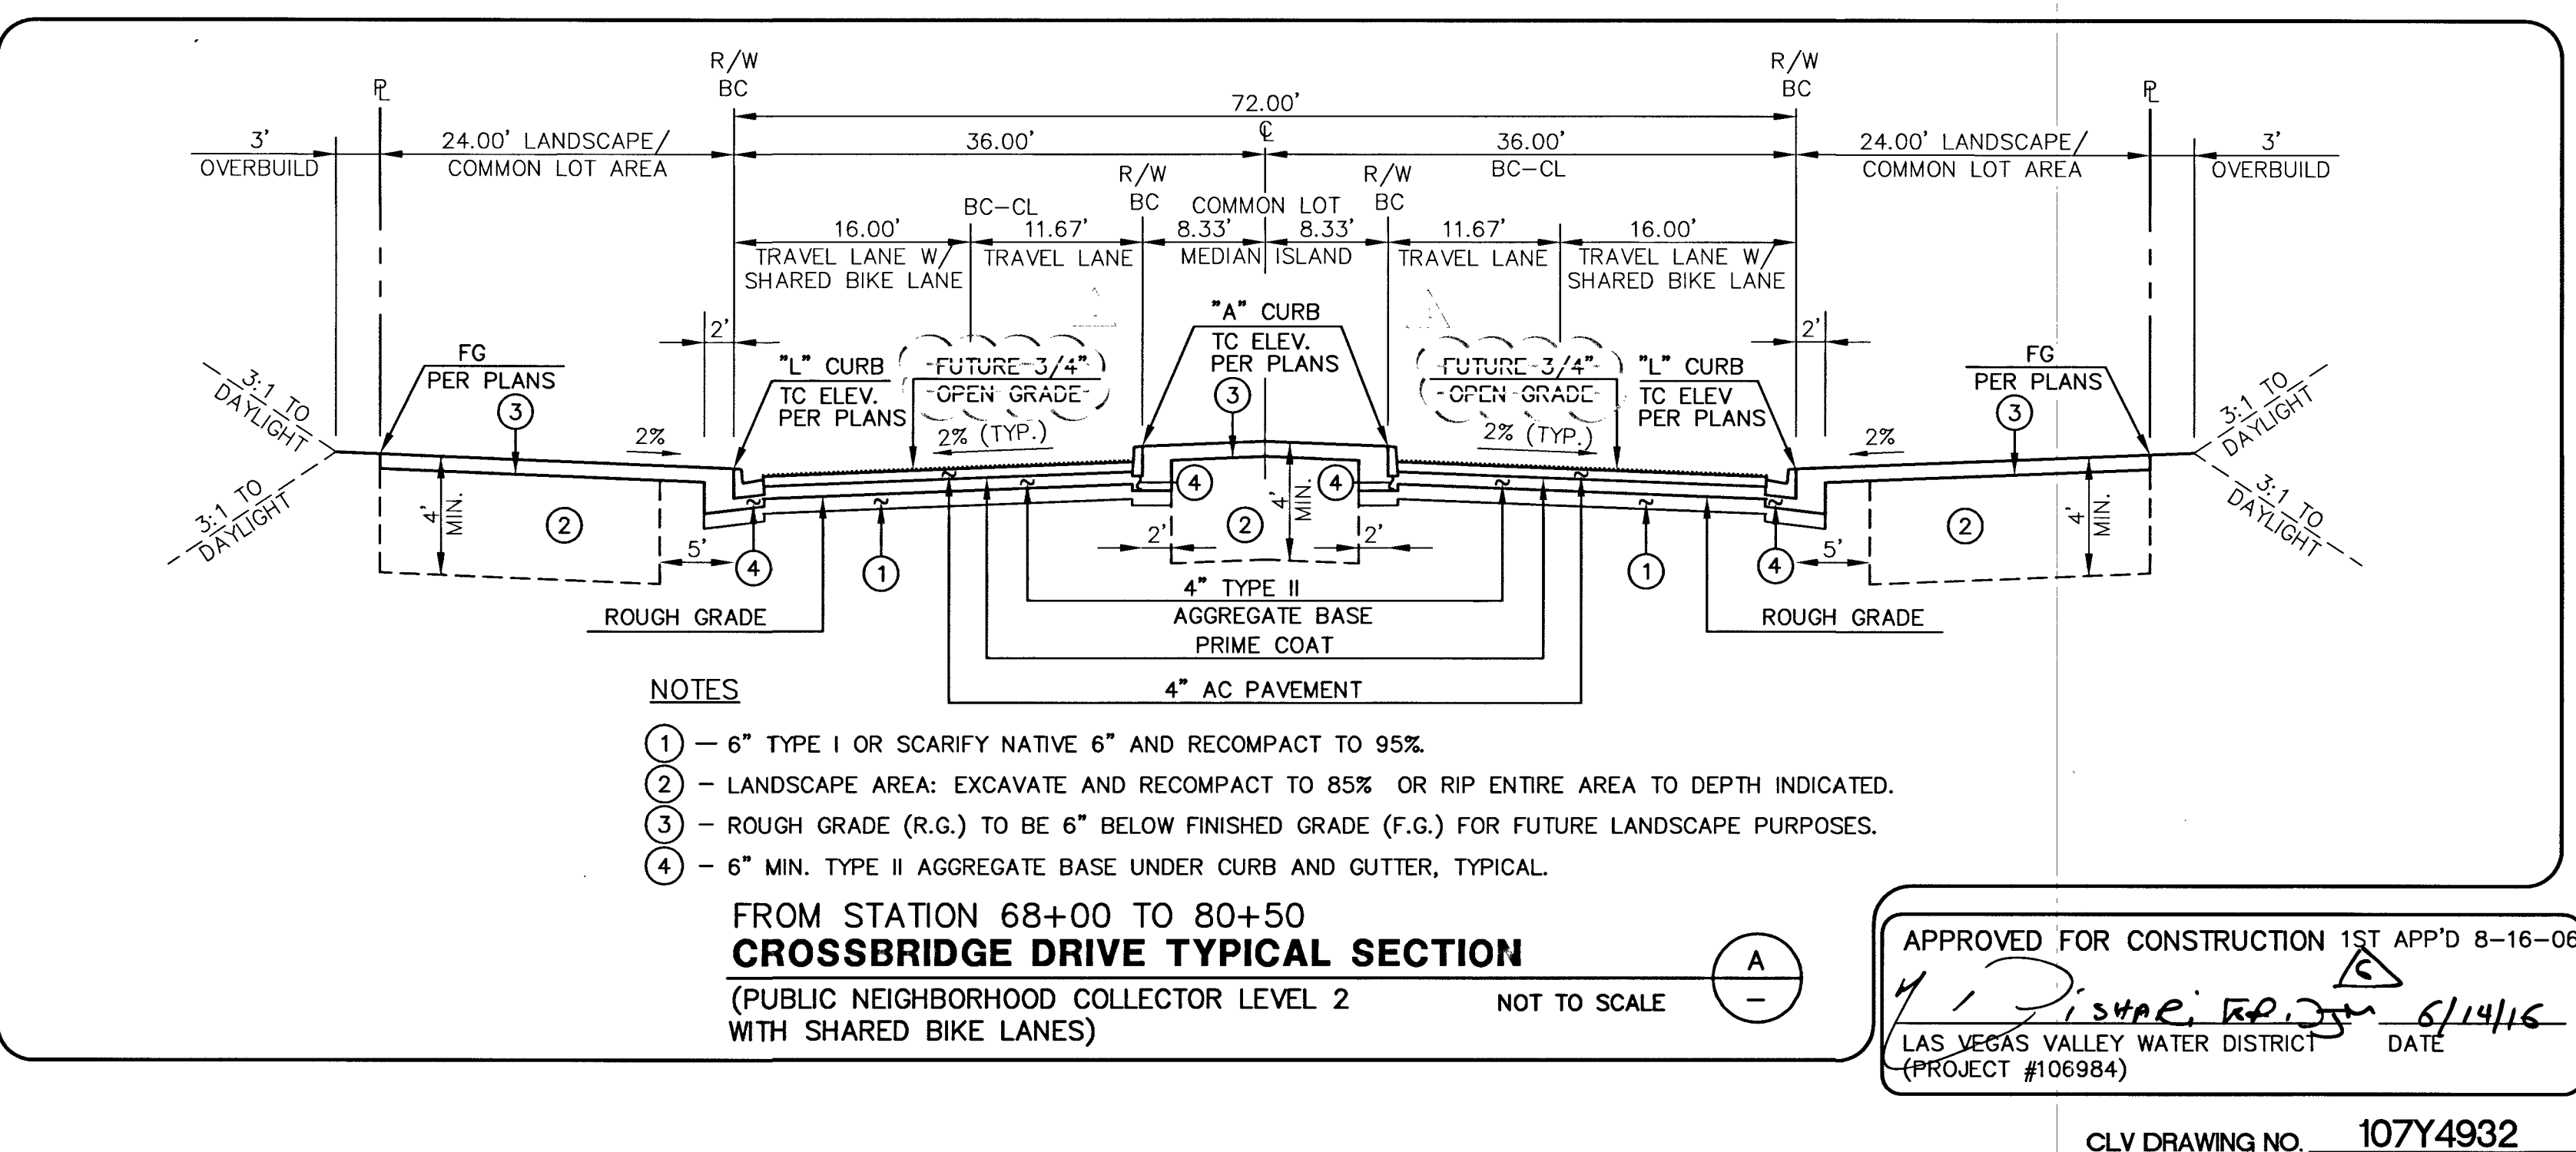
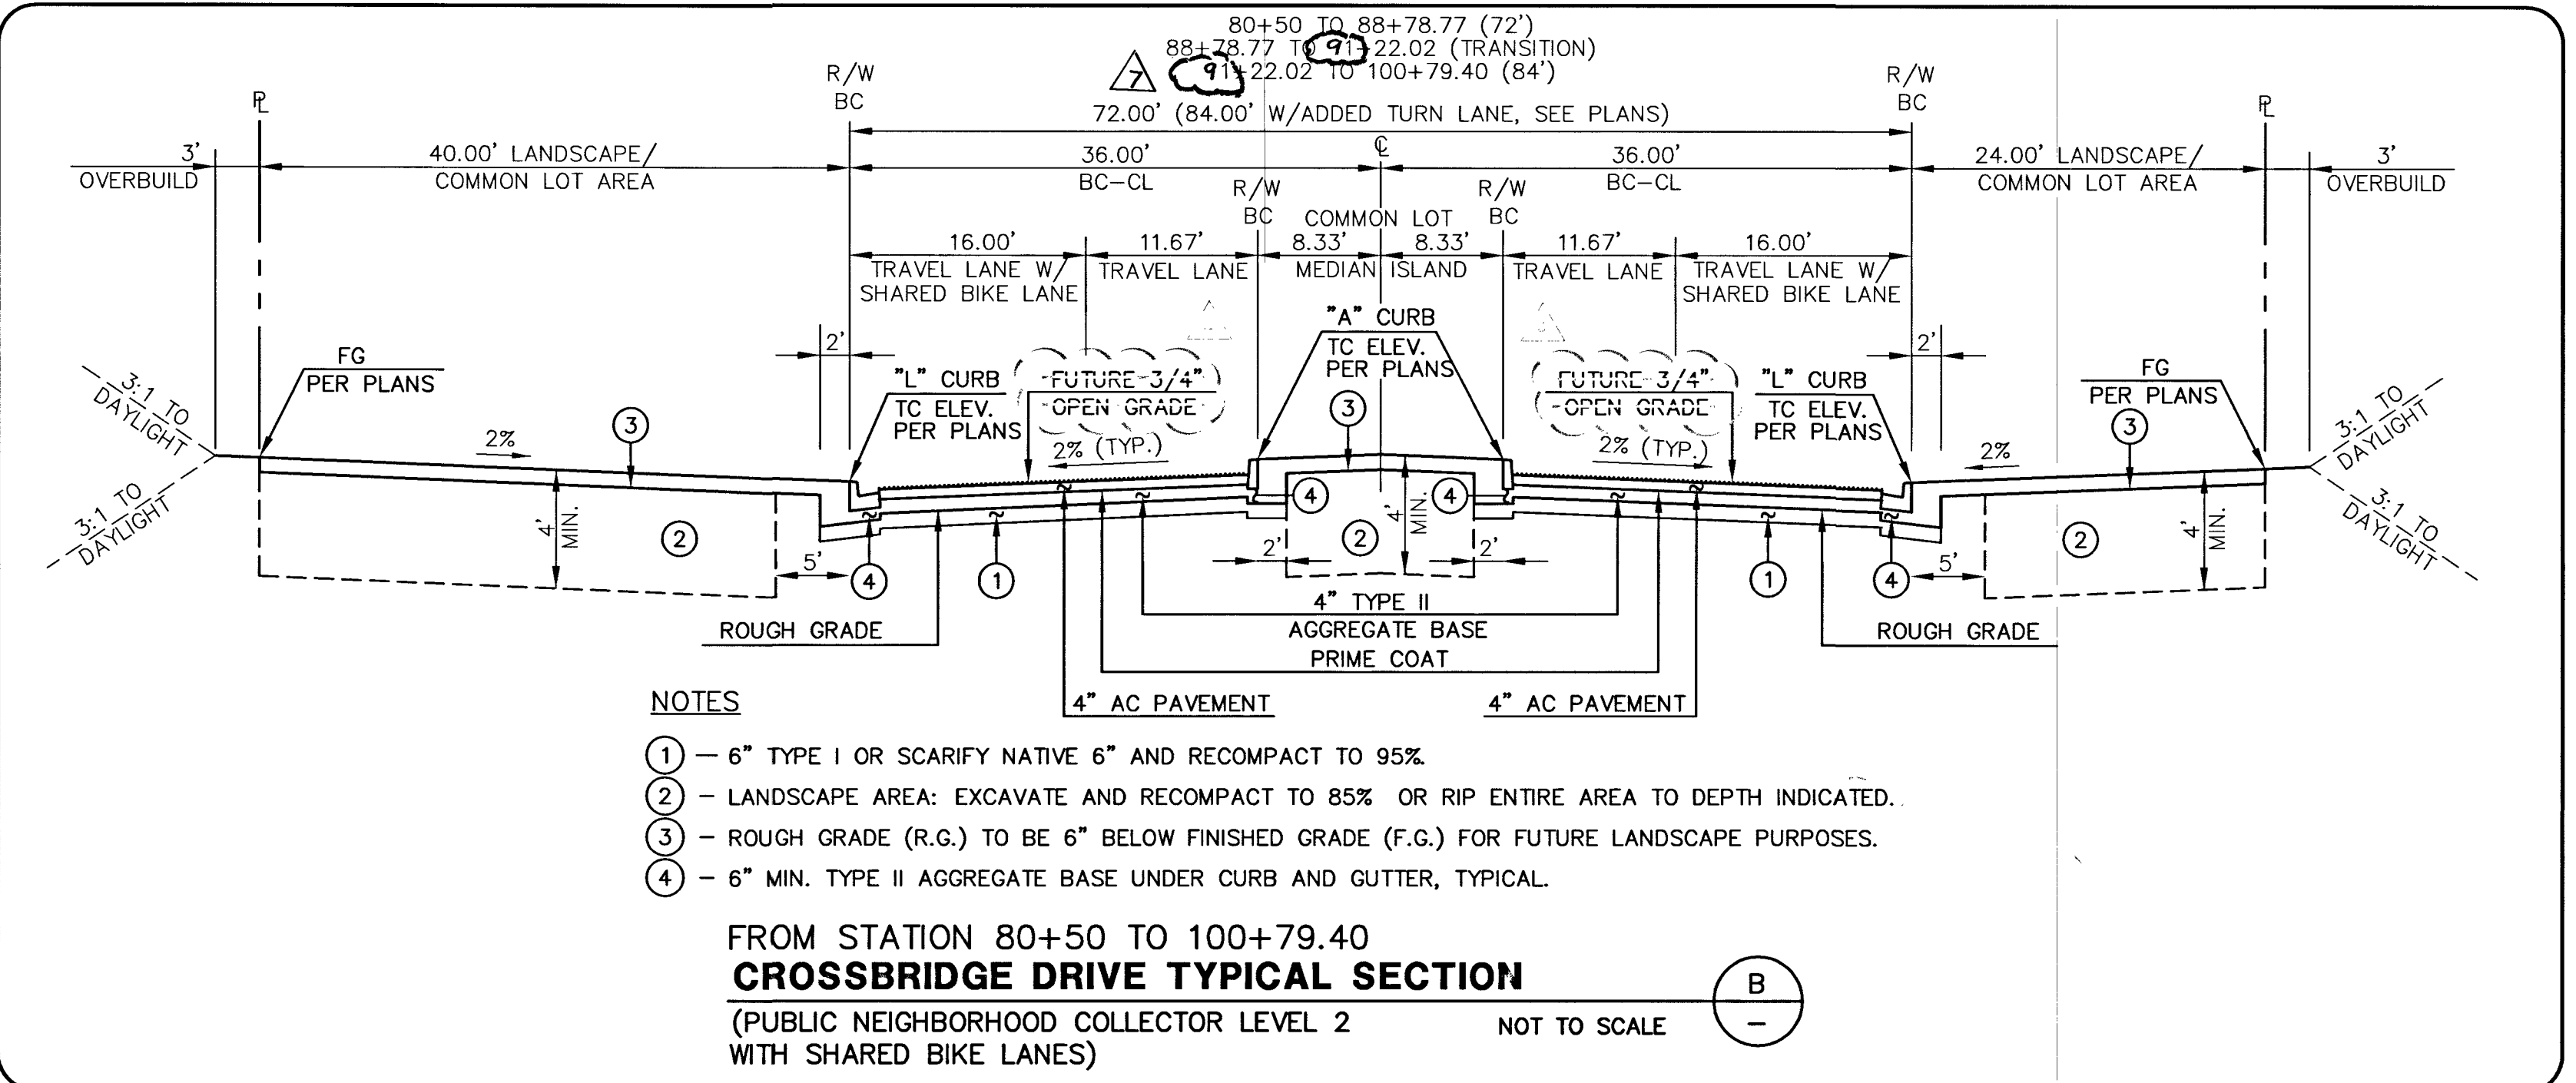
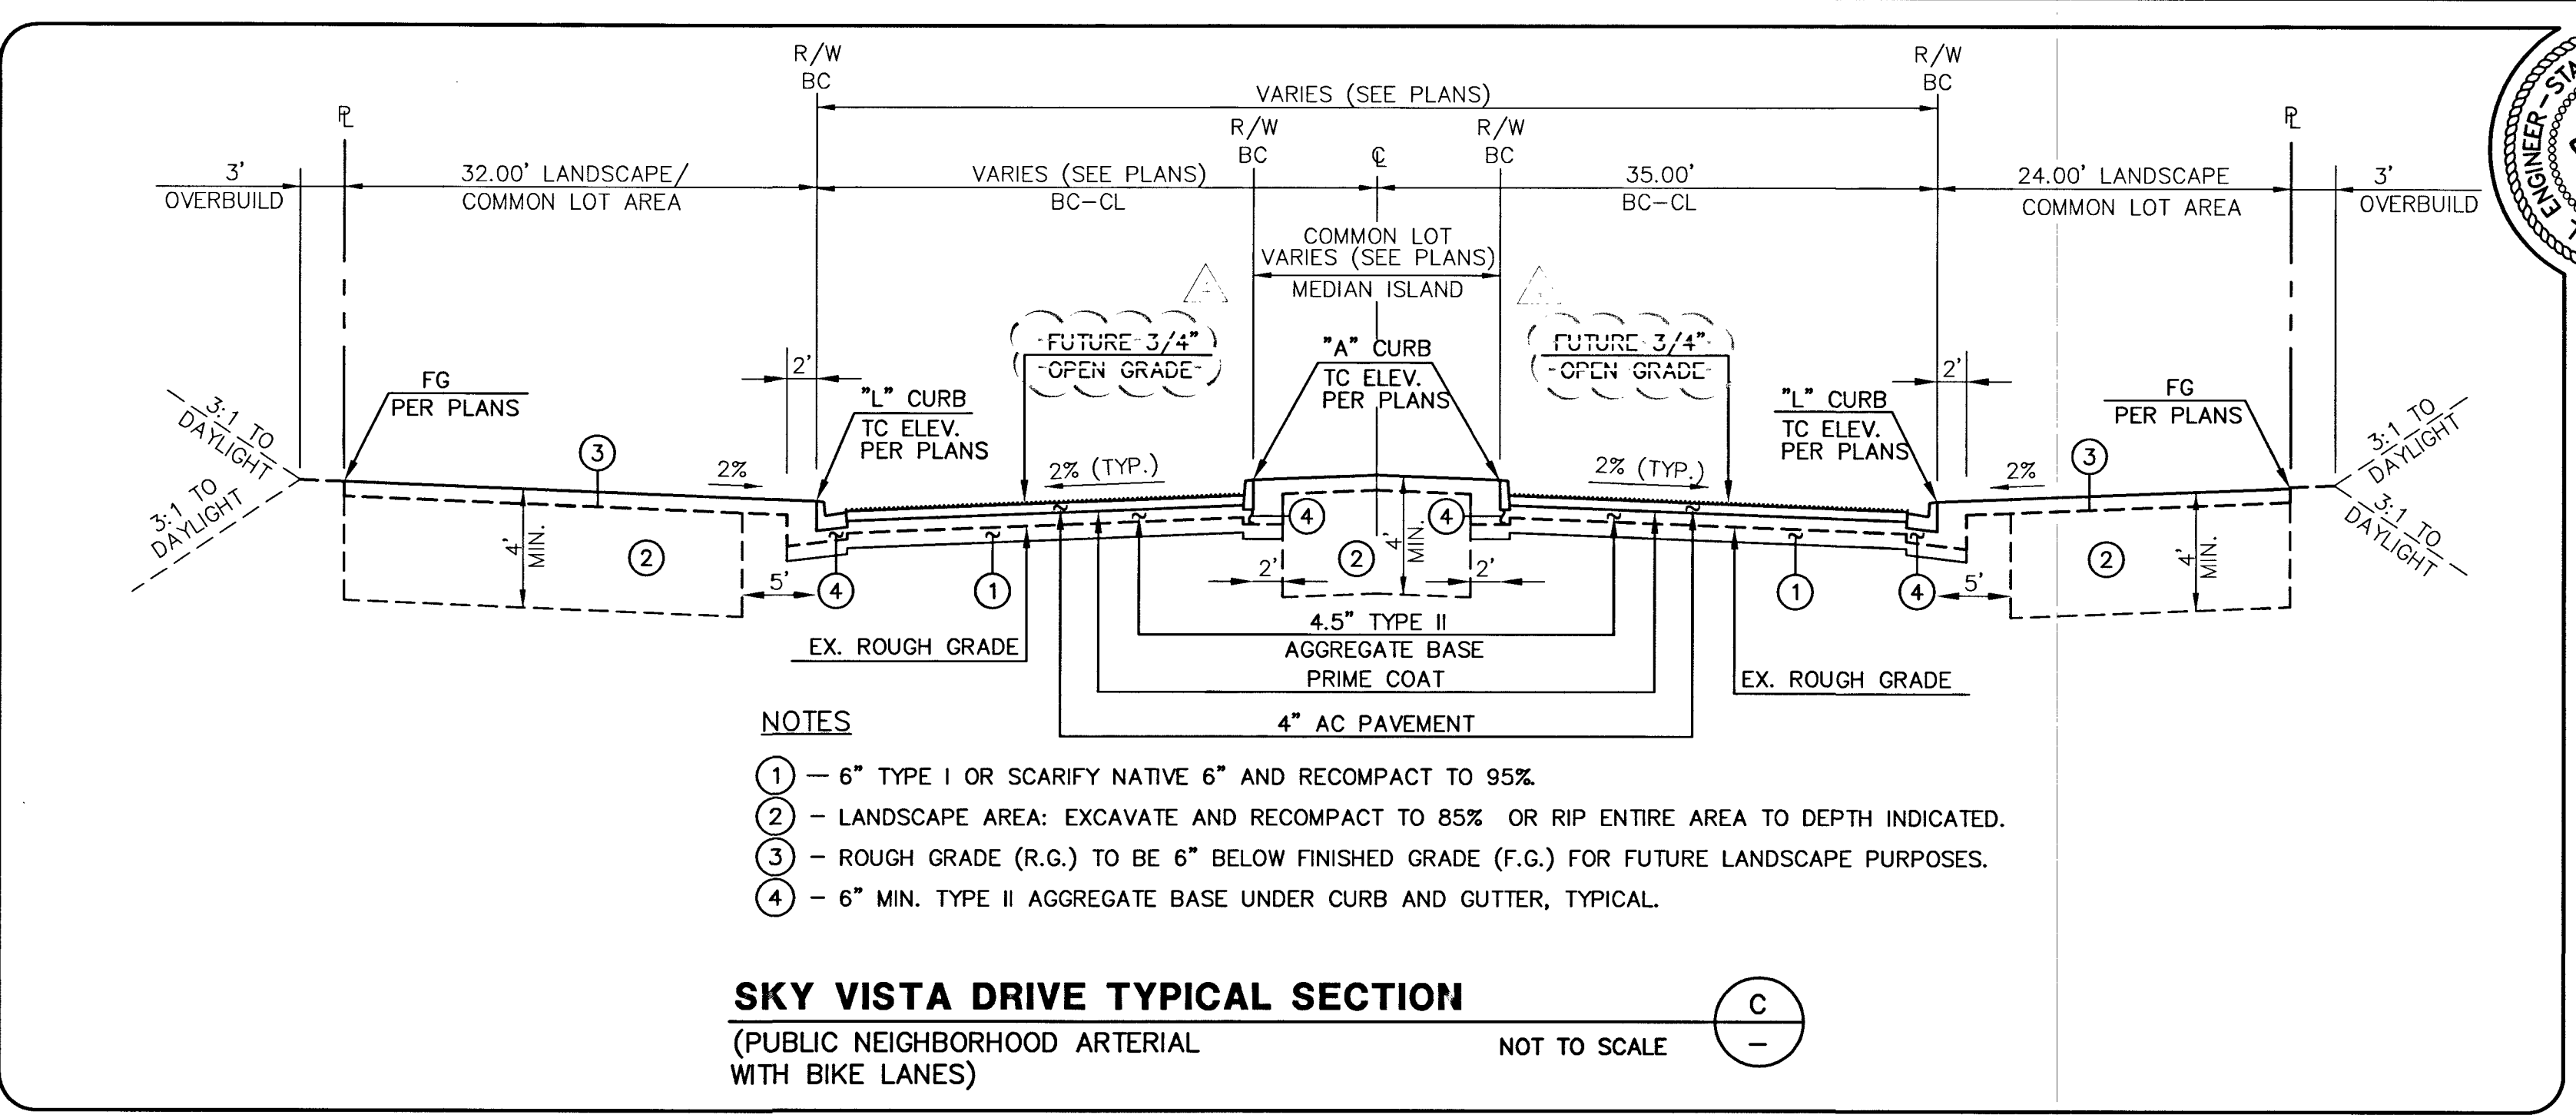
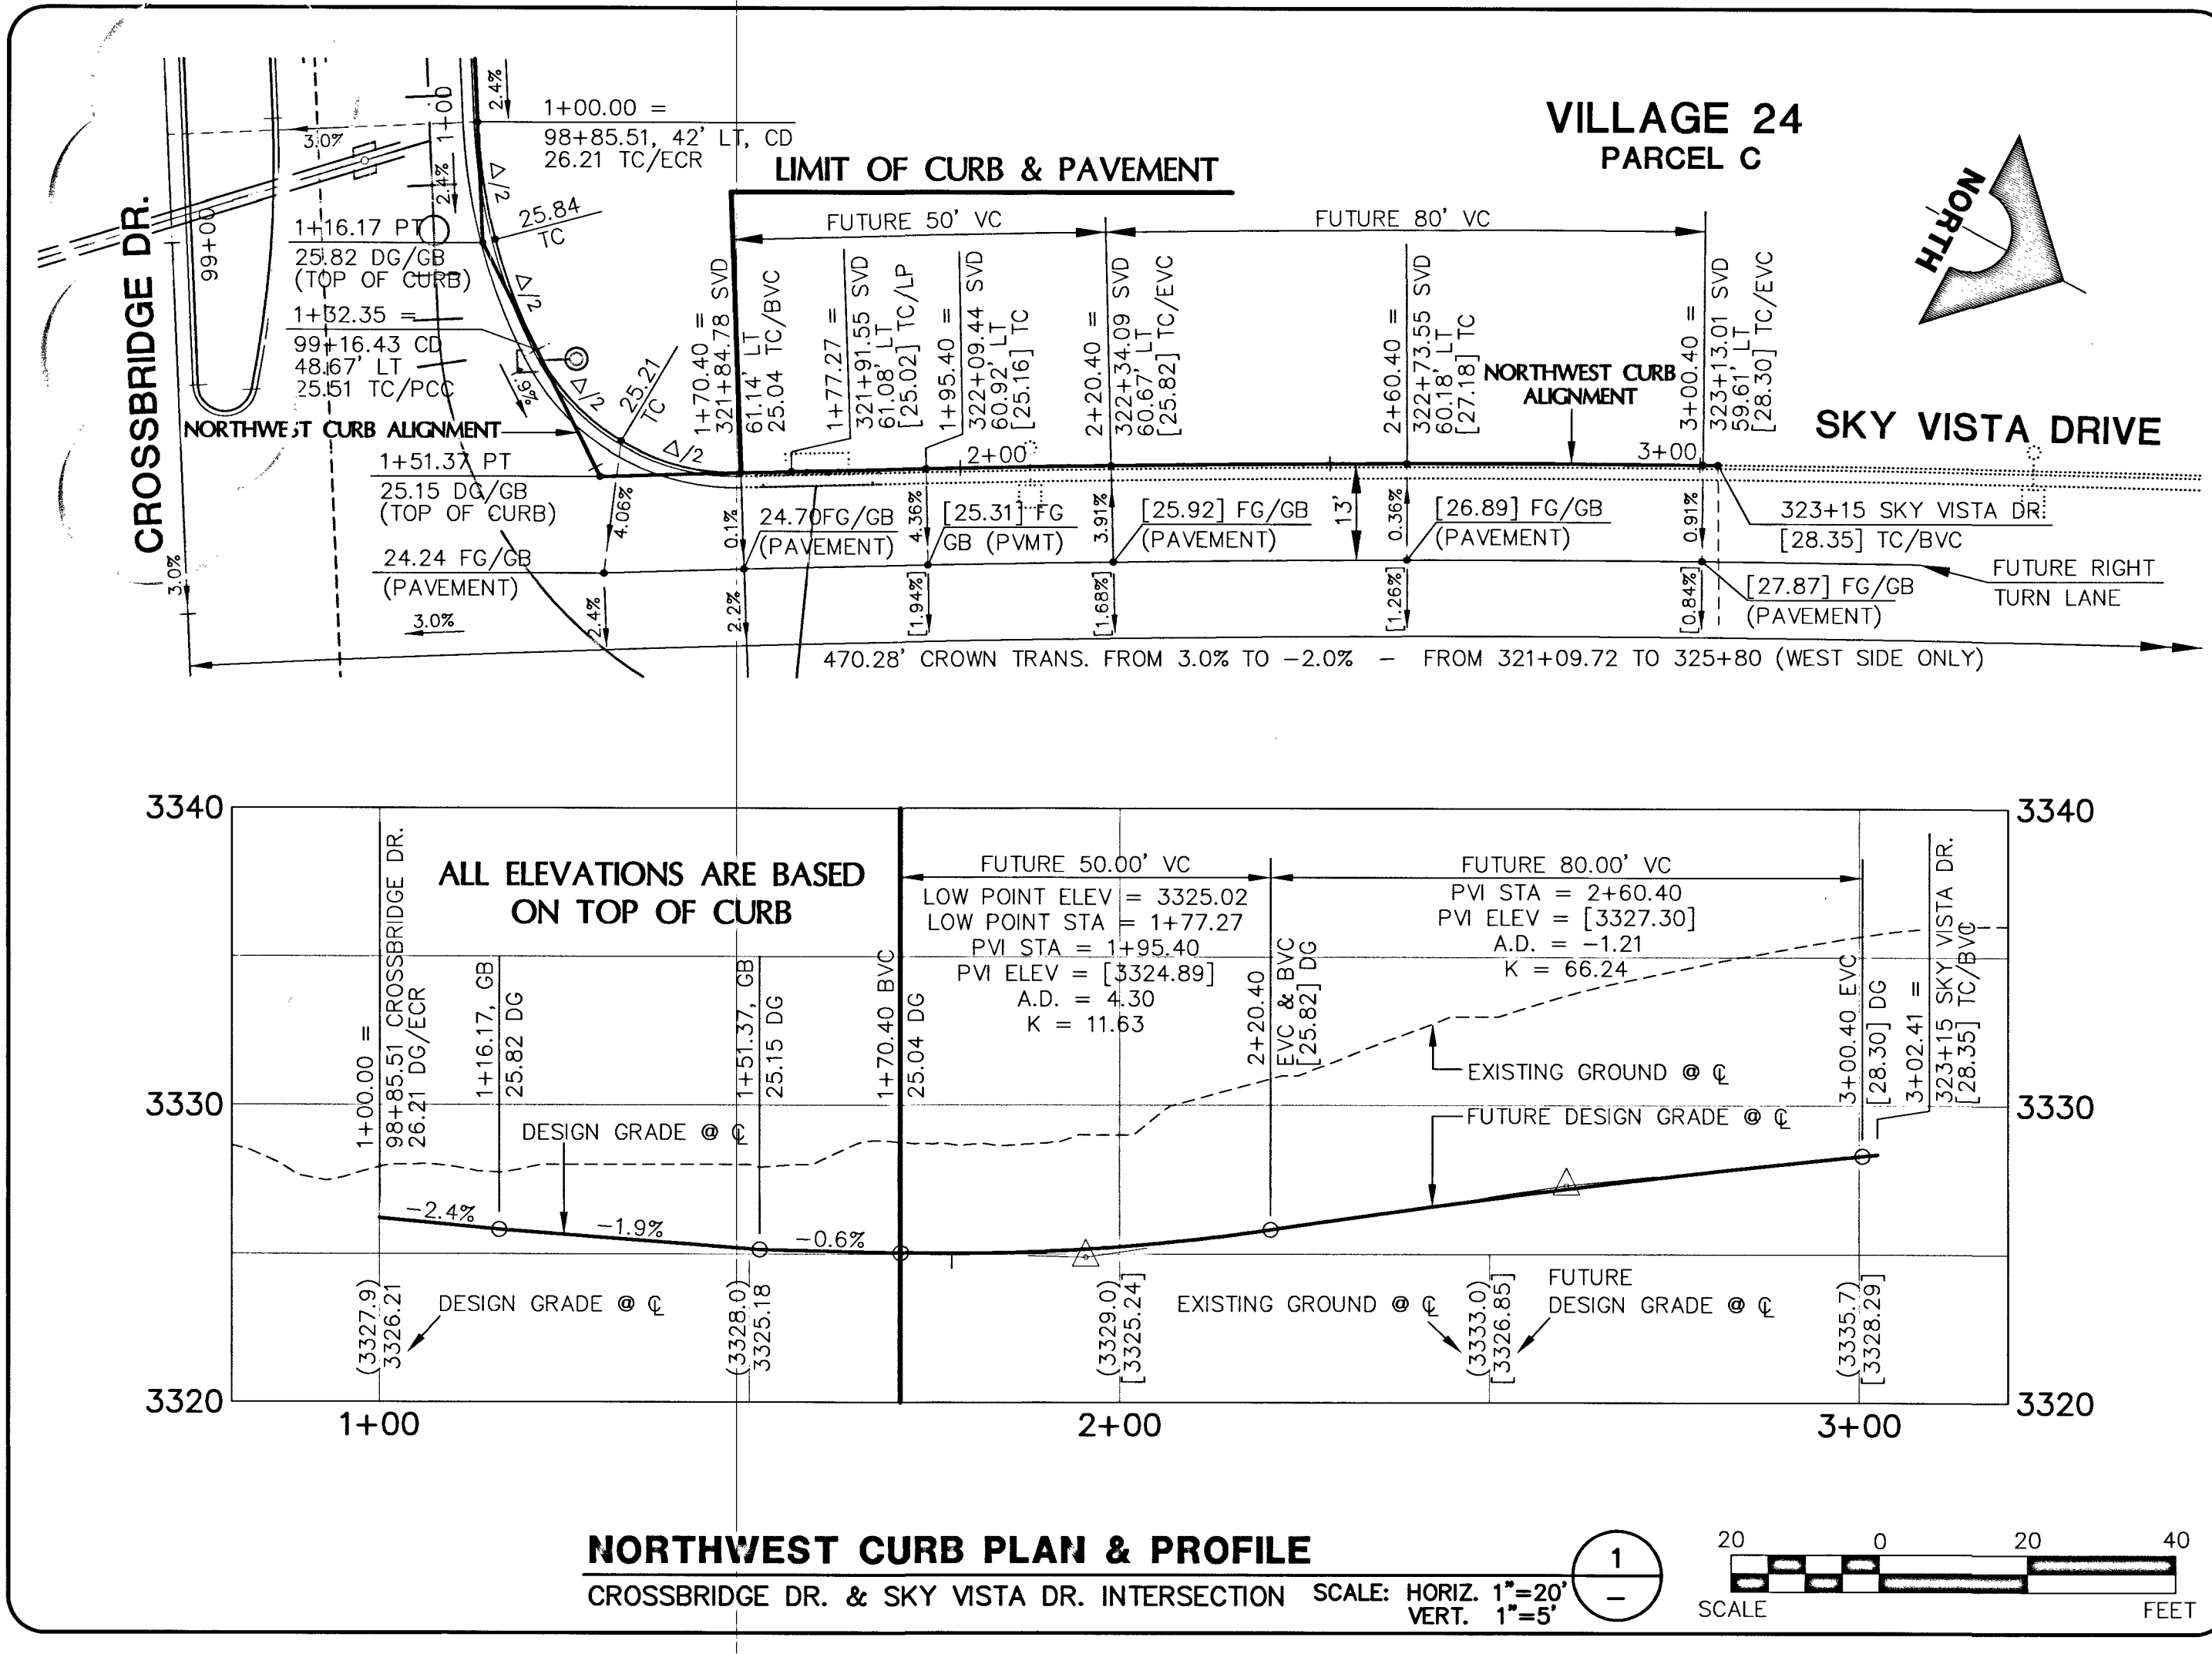


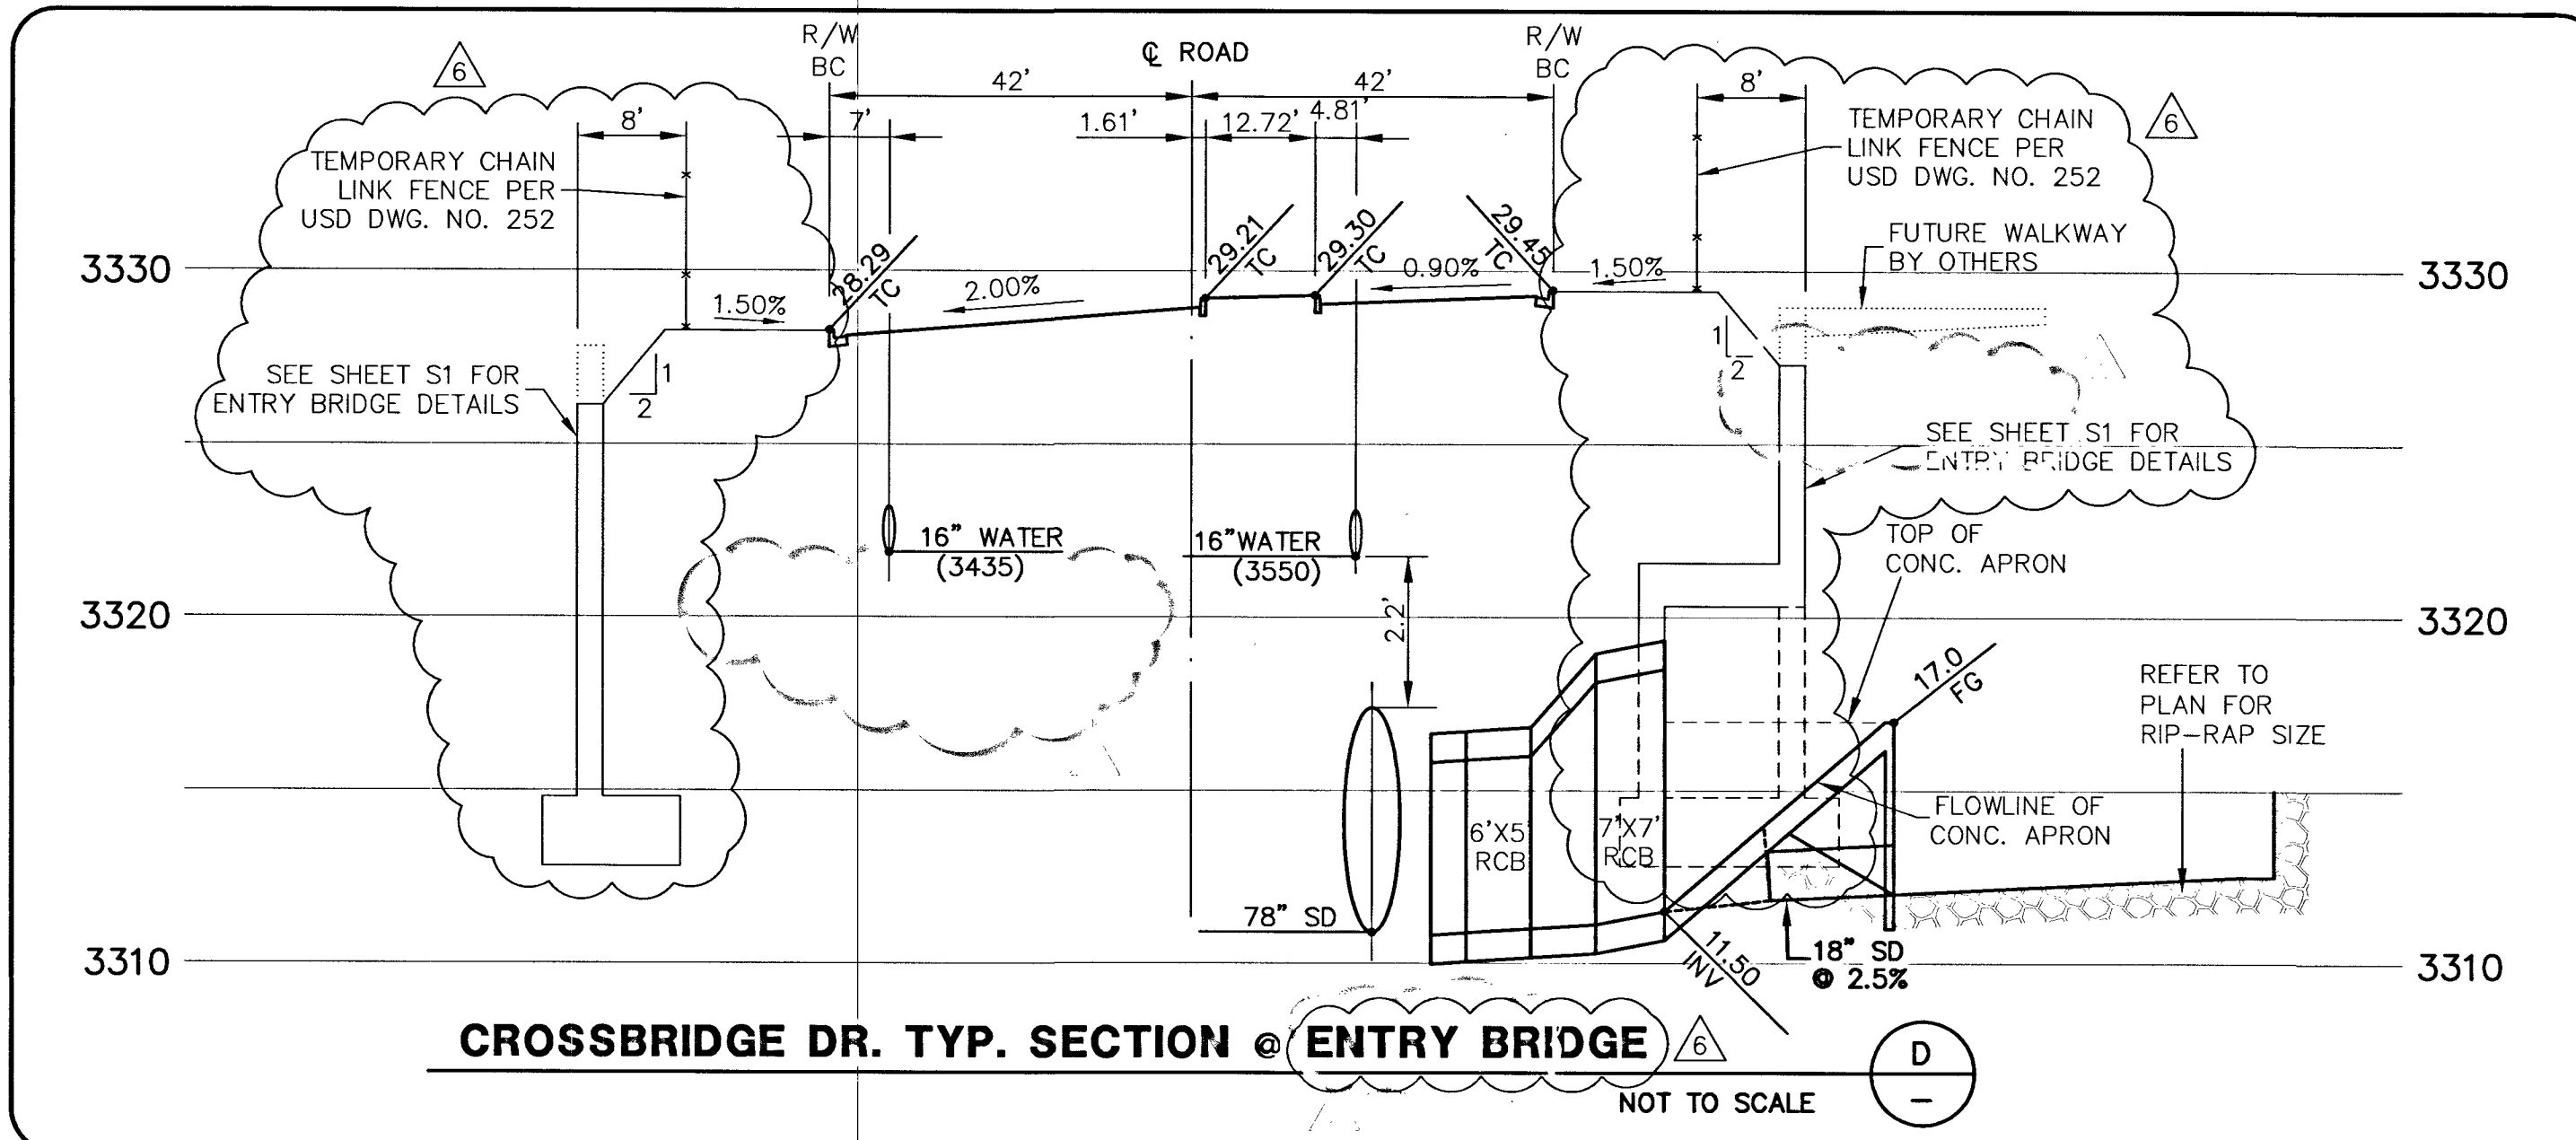

DESIGN: 06/20/16, REVISED MEDIAN, STRIPING, & STREETLIGHTS
 CHECK: 07/17/16, ADDED WATER METER & IRRIGATION SLEEVES
 07/17/16, ADDED SHT 258, BEAVED FUTURE SEWER TO PROPOSED, REMOVED OPEN GRADE

DATE: 06/08/2016

PROJECT: 62A.24.21T
 VILLAGE 24 UNIT 1 IMPROVEMENTS
 TYPICAL SECTIONS AND MISCELLANEOUS DETAILS

CLV DRAWING NO. 107Y4932

APPROVED FOR CONSTRUCTION 1ST APP'D 8-16-06

[Signature] 6/14/16

LAS VEGAS VALLEY WATER DISTRICT DATE

(PROJECT #106984)

SHEET 20

20 OF 47 SHTS