

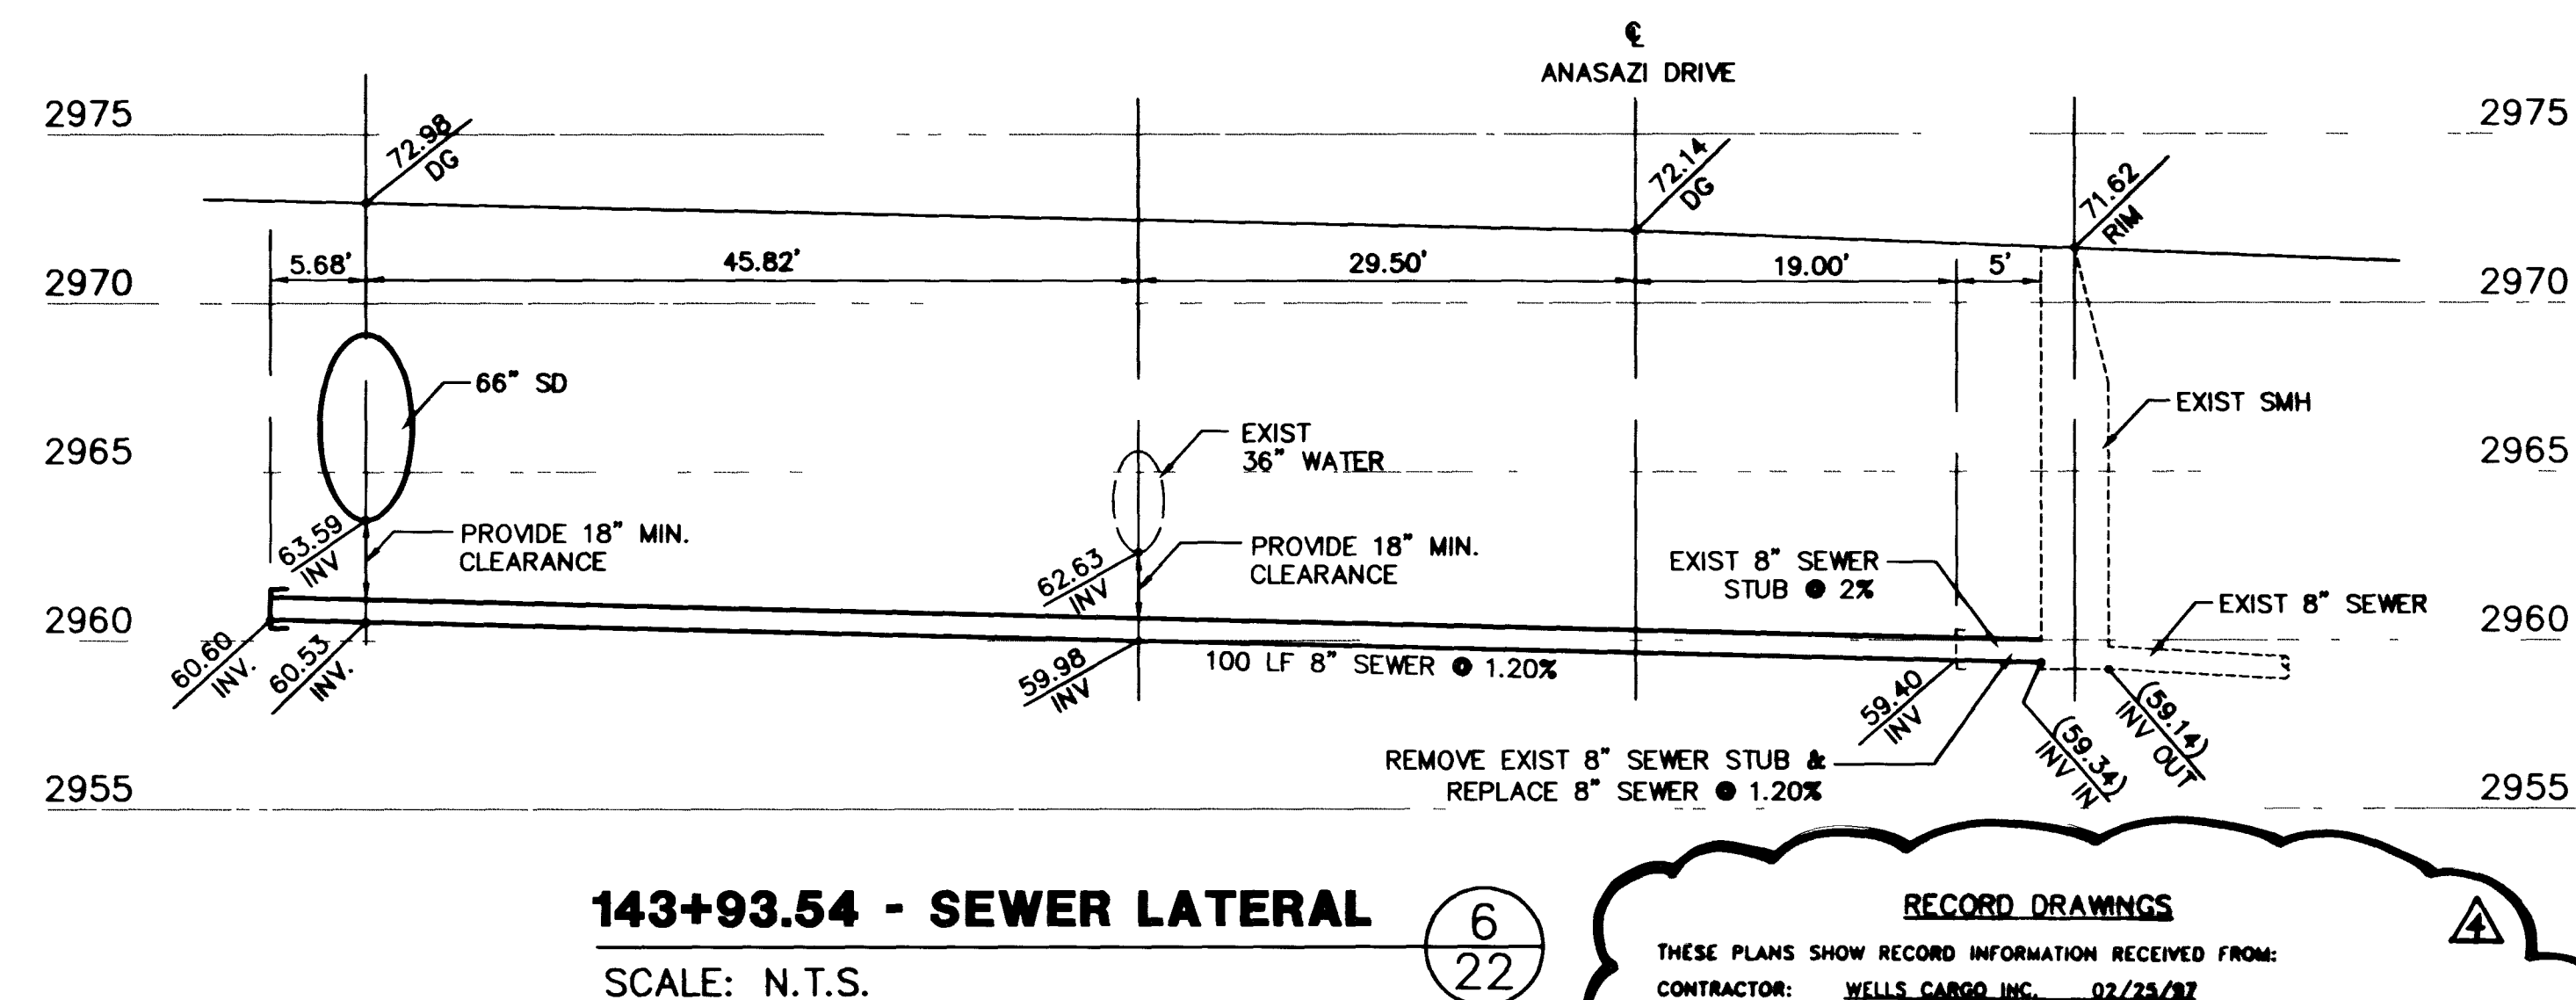
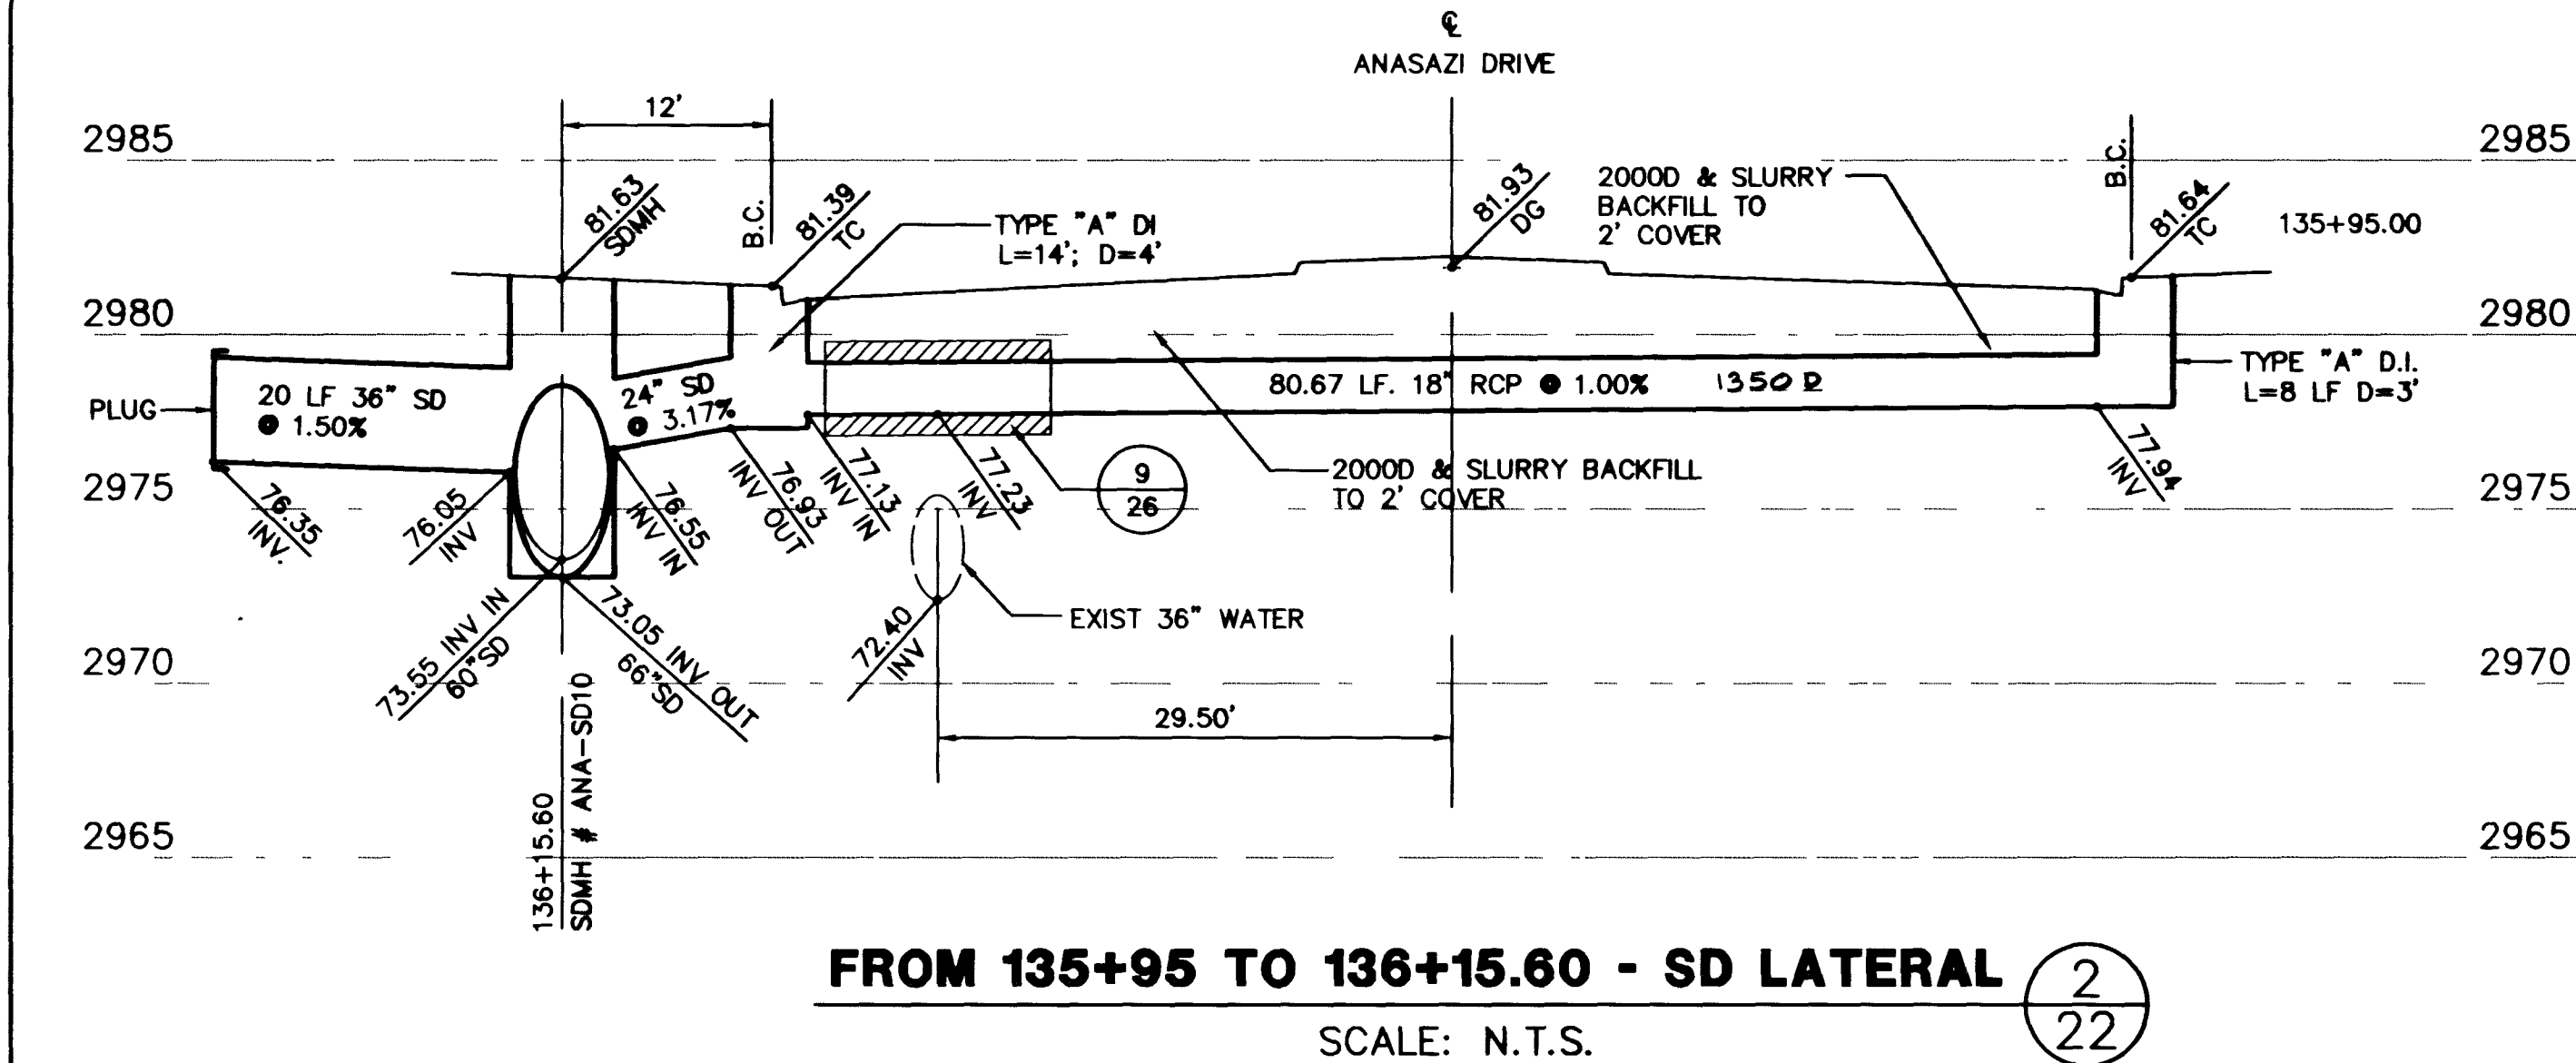
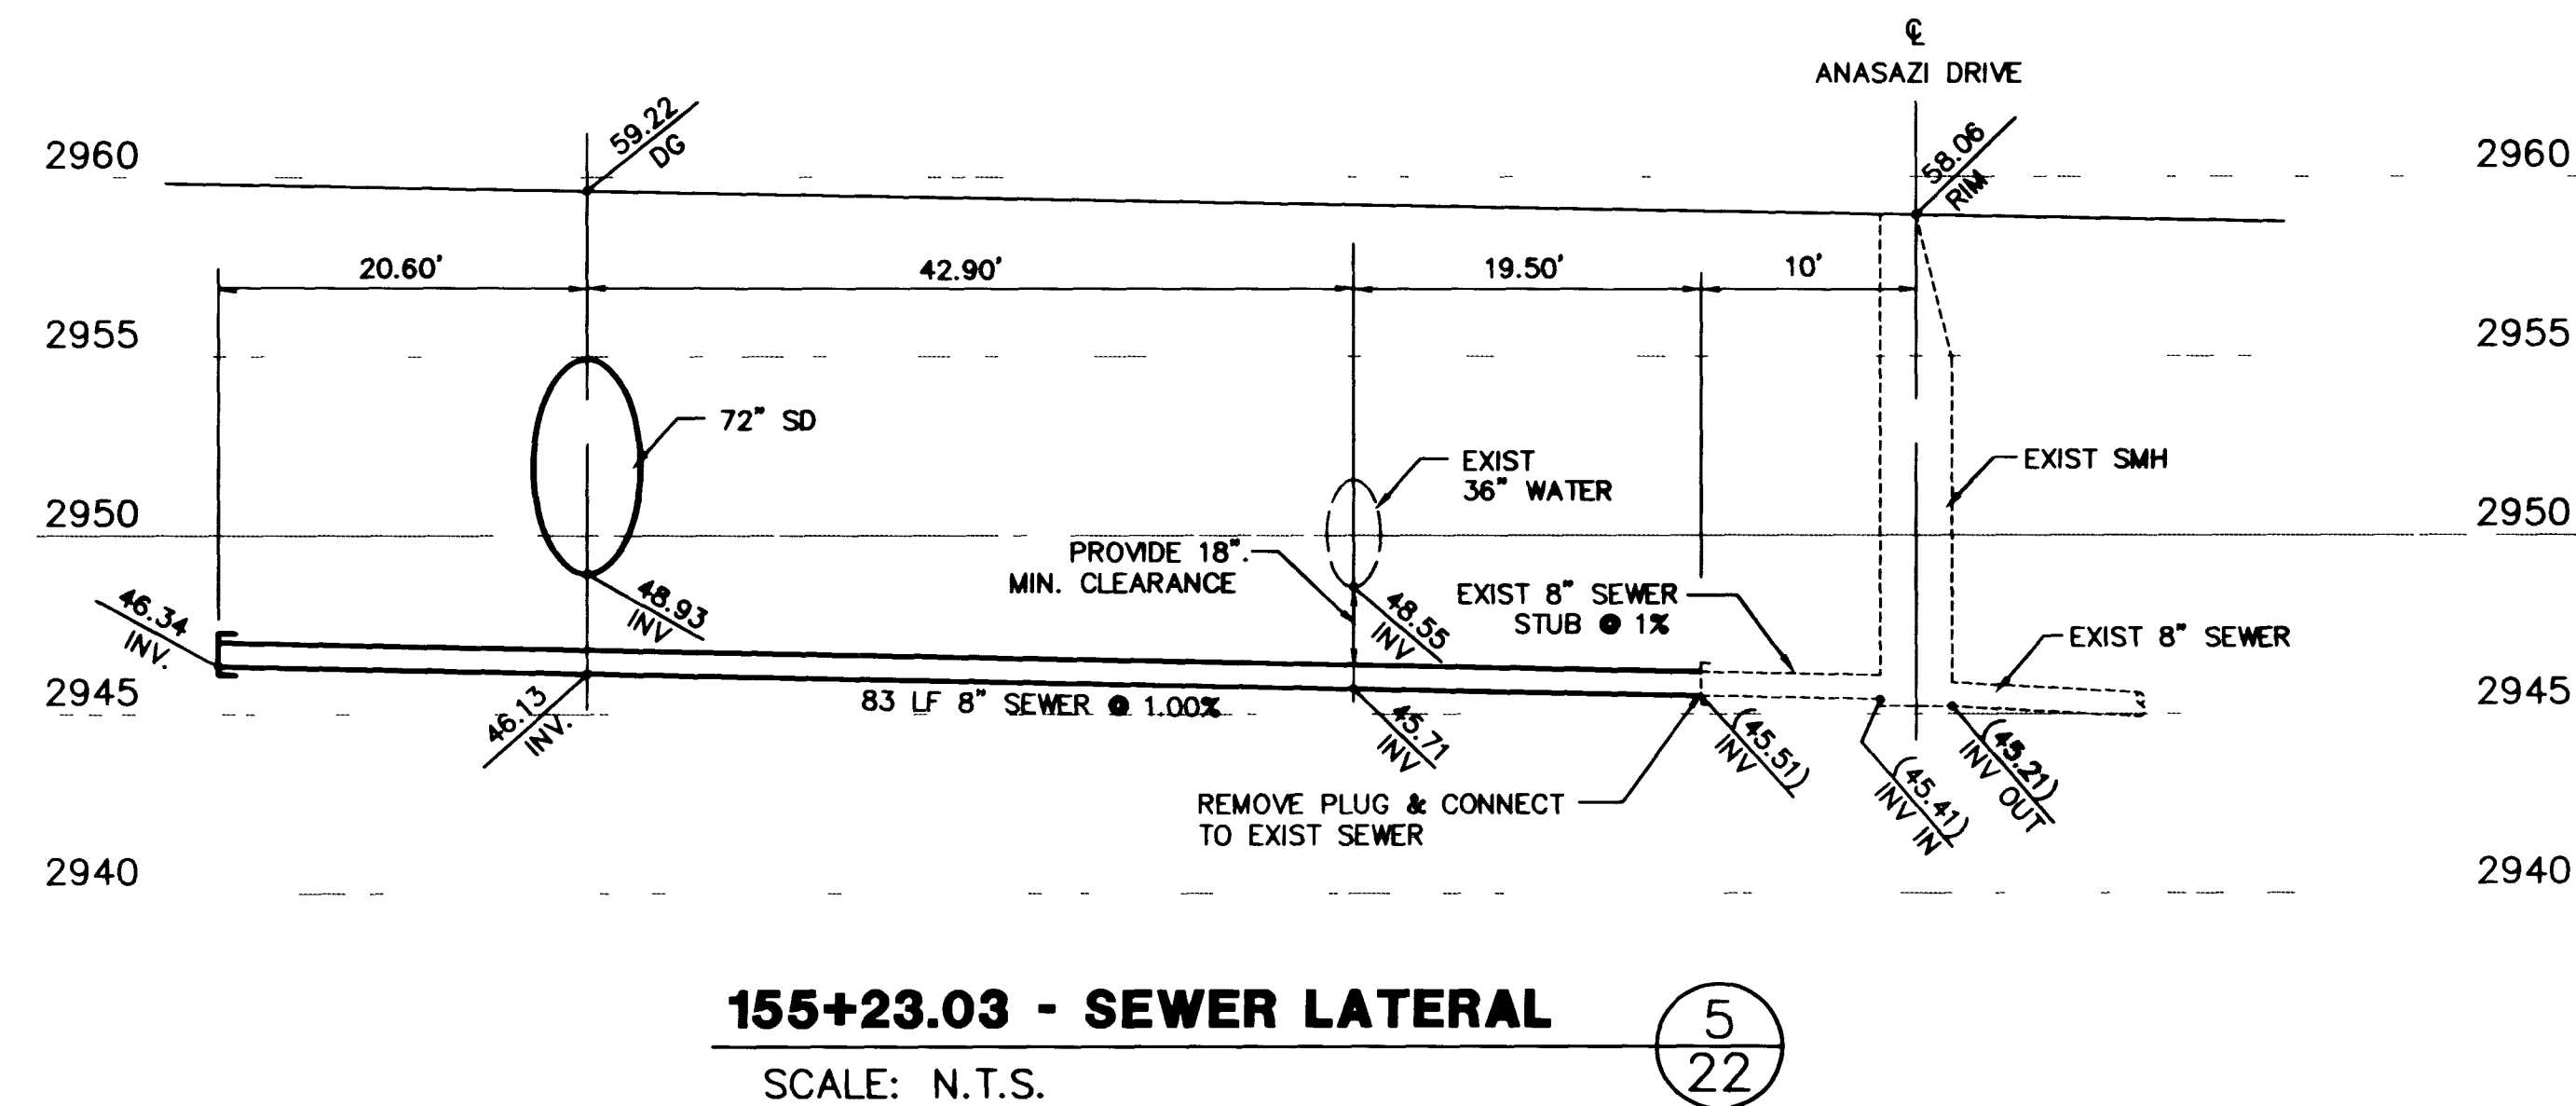
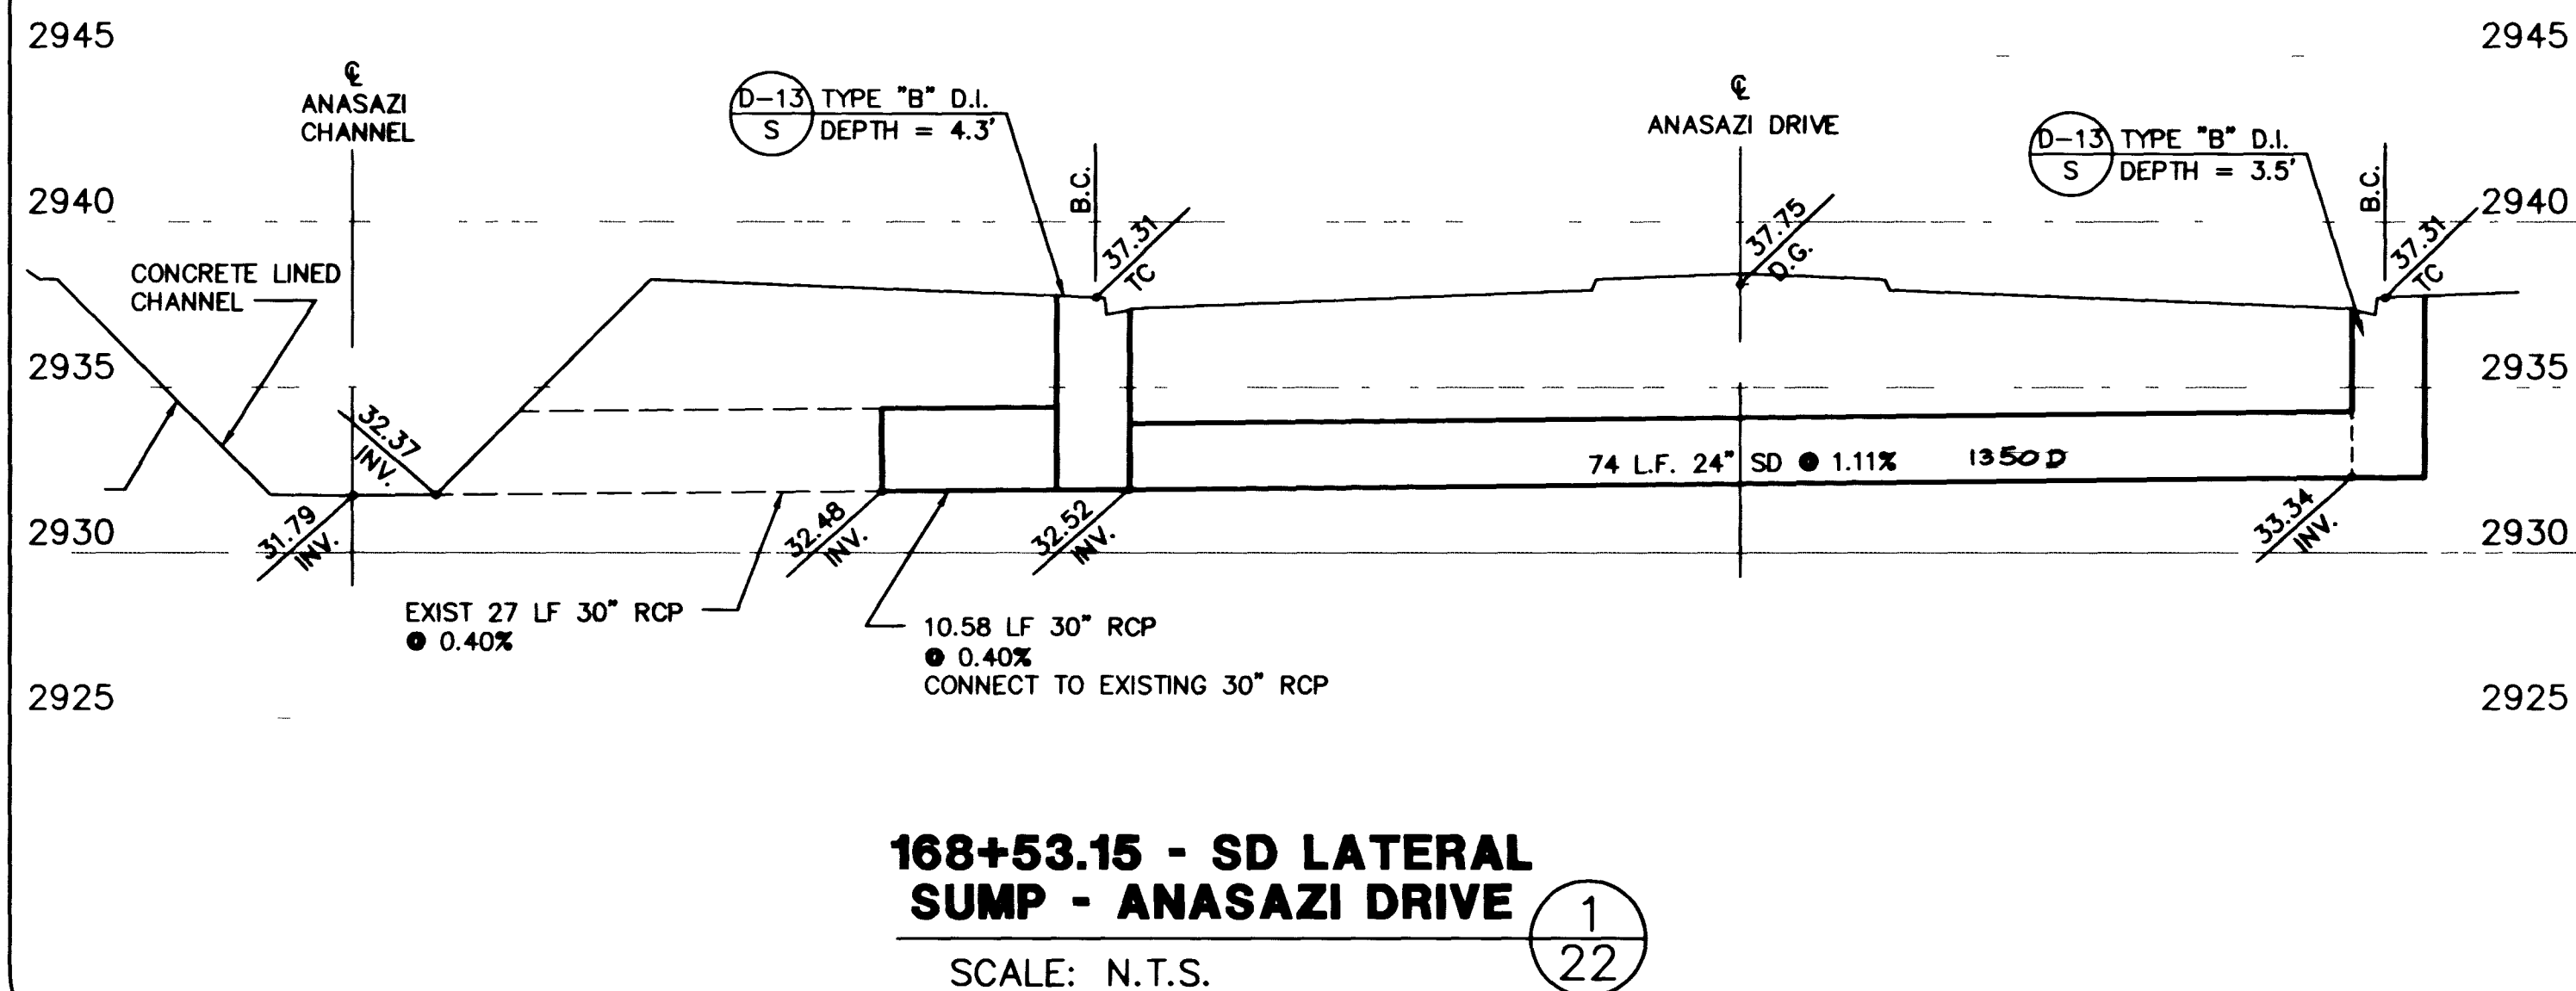


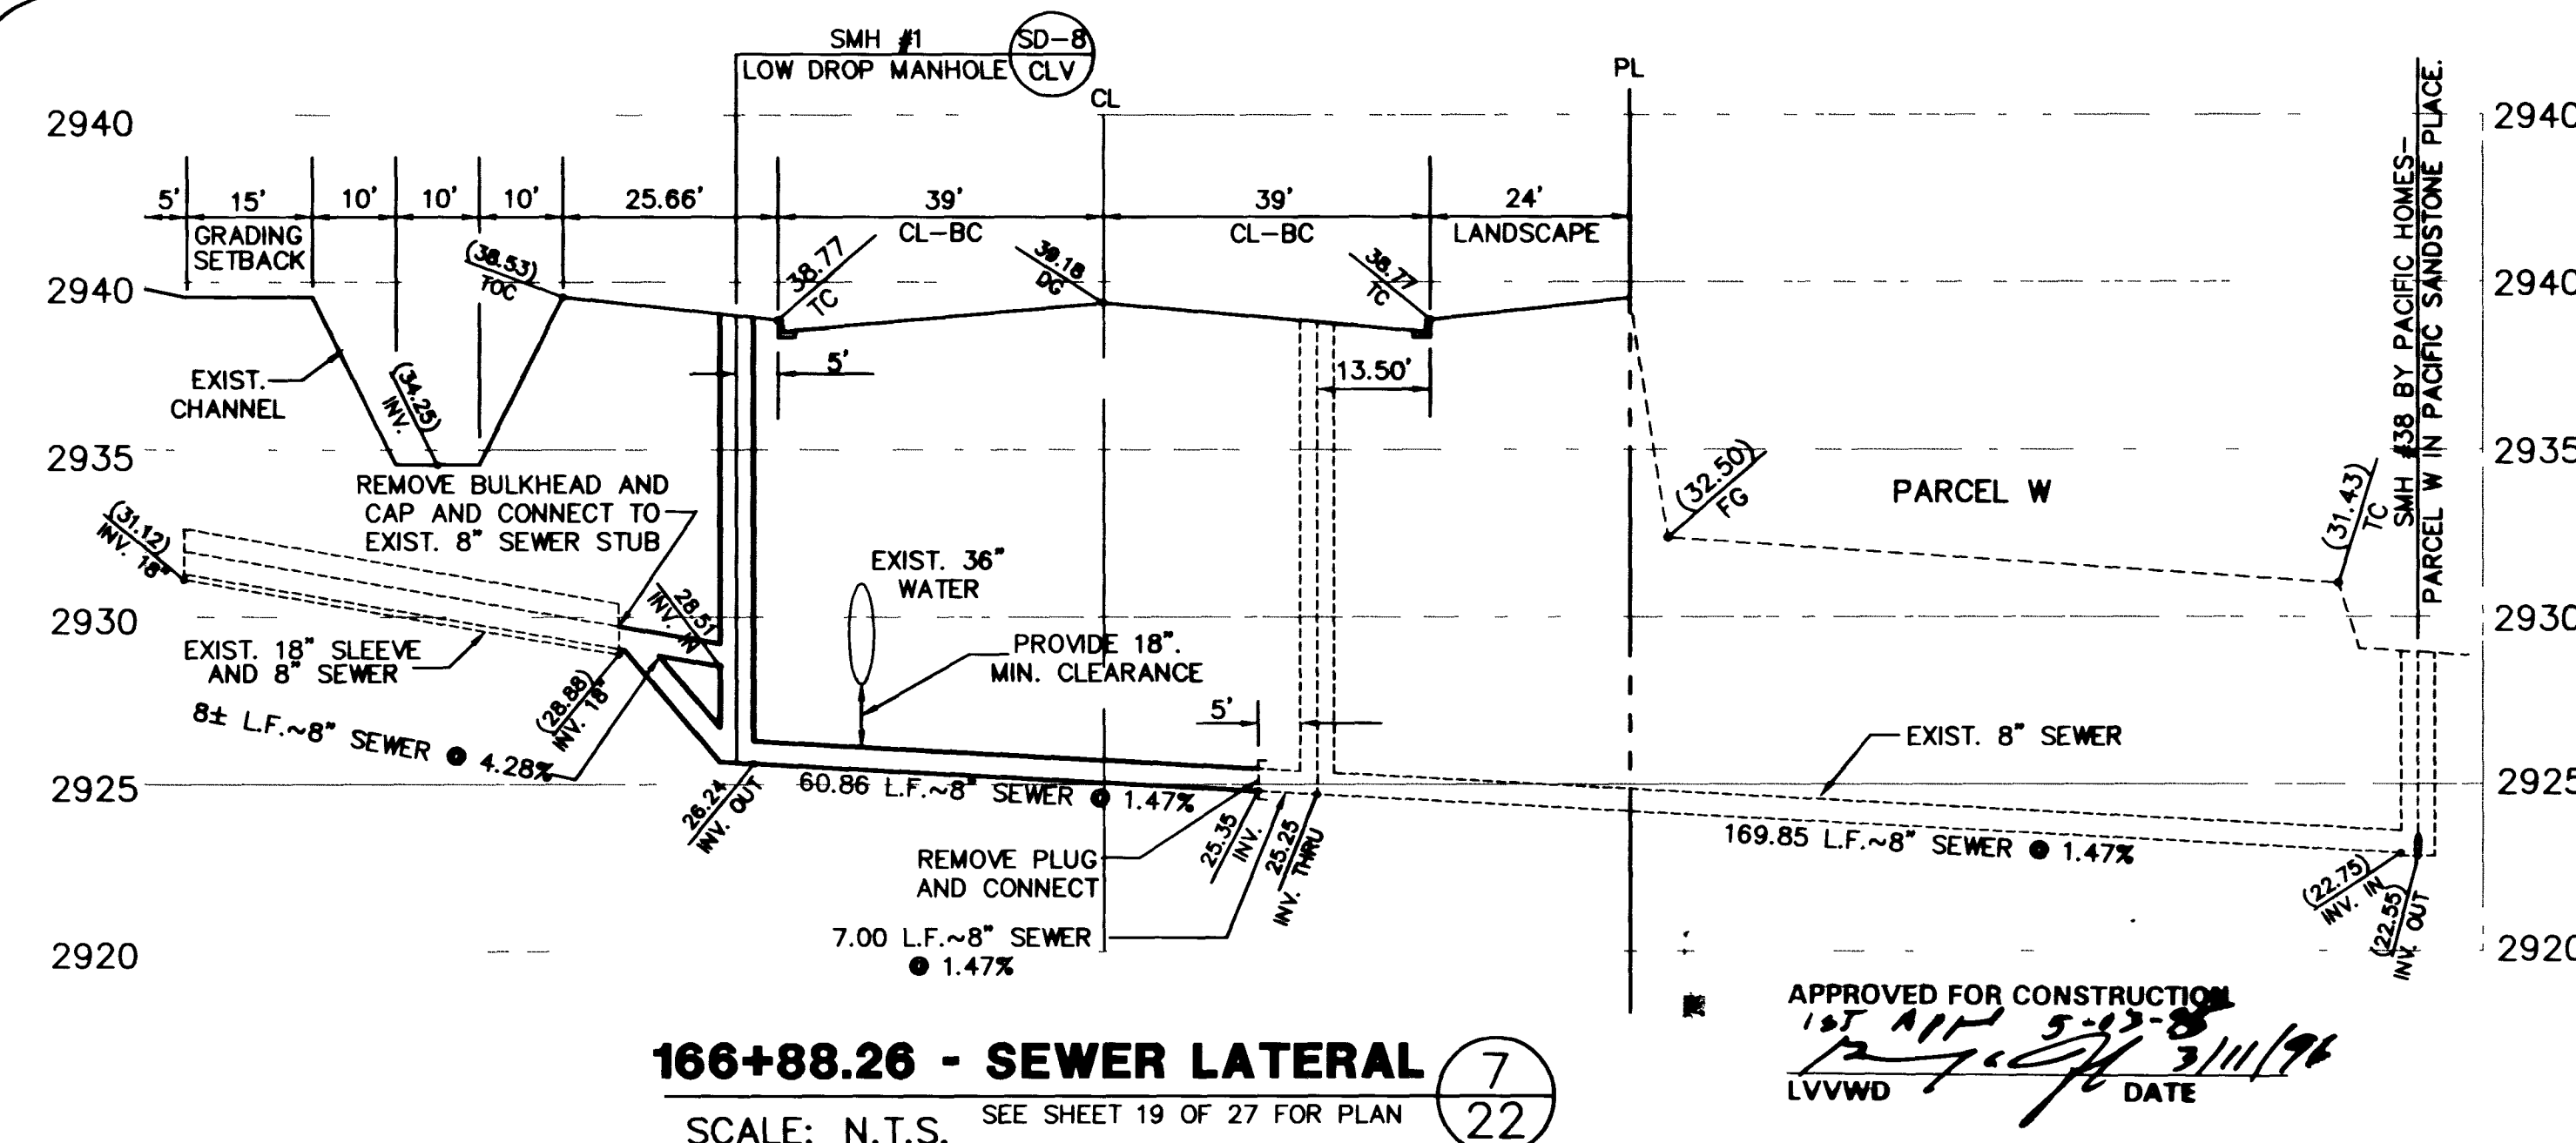

**RECORD DRAWINGS**

THESE PLANS SHOW RECORD INFORMATION RECEIVED FROM:  
CONTRACTOR: **WELLS CARGO INC.** 02/23/97

THIS DATA MAY OR MAY NOT REFLECT THE ACTUAL FIELD LOCATIONS. ALL DATA SHOULD BE CONFIRMED PRIOR TO USE ON DEVELOPMENT OR ENGINEERING PLANS.

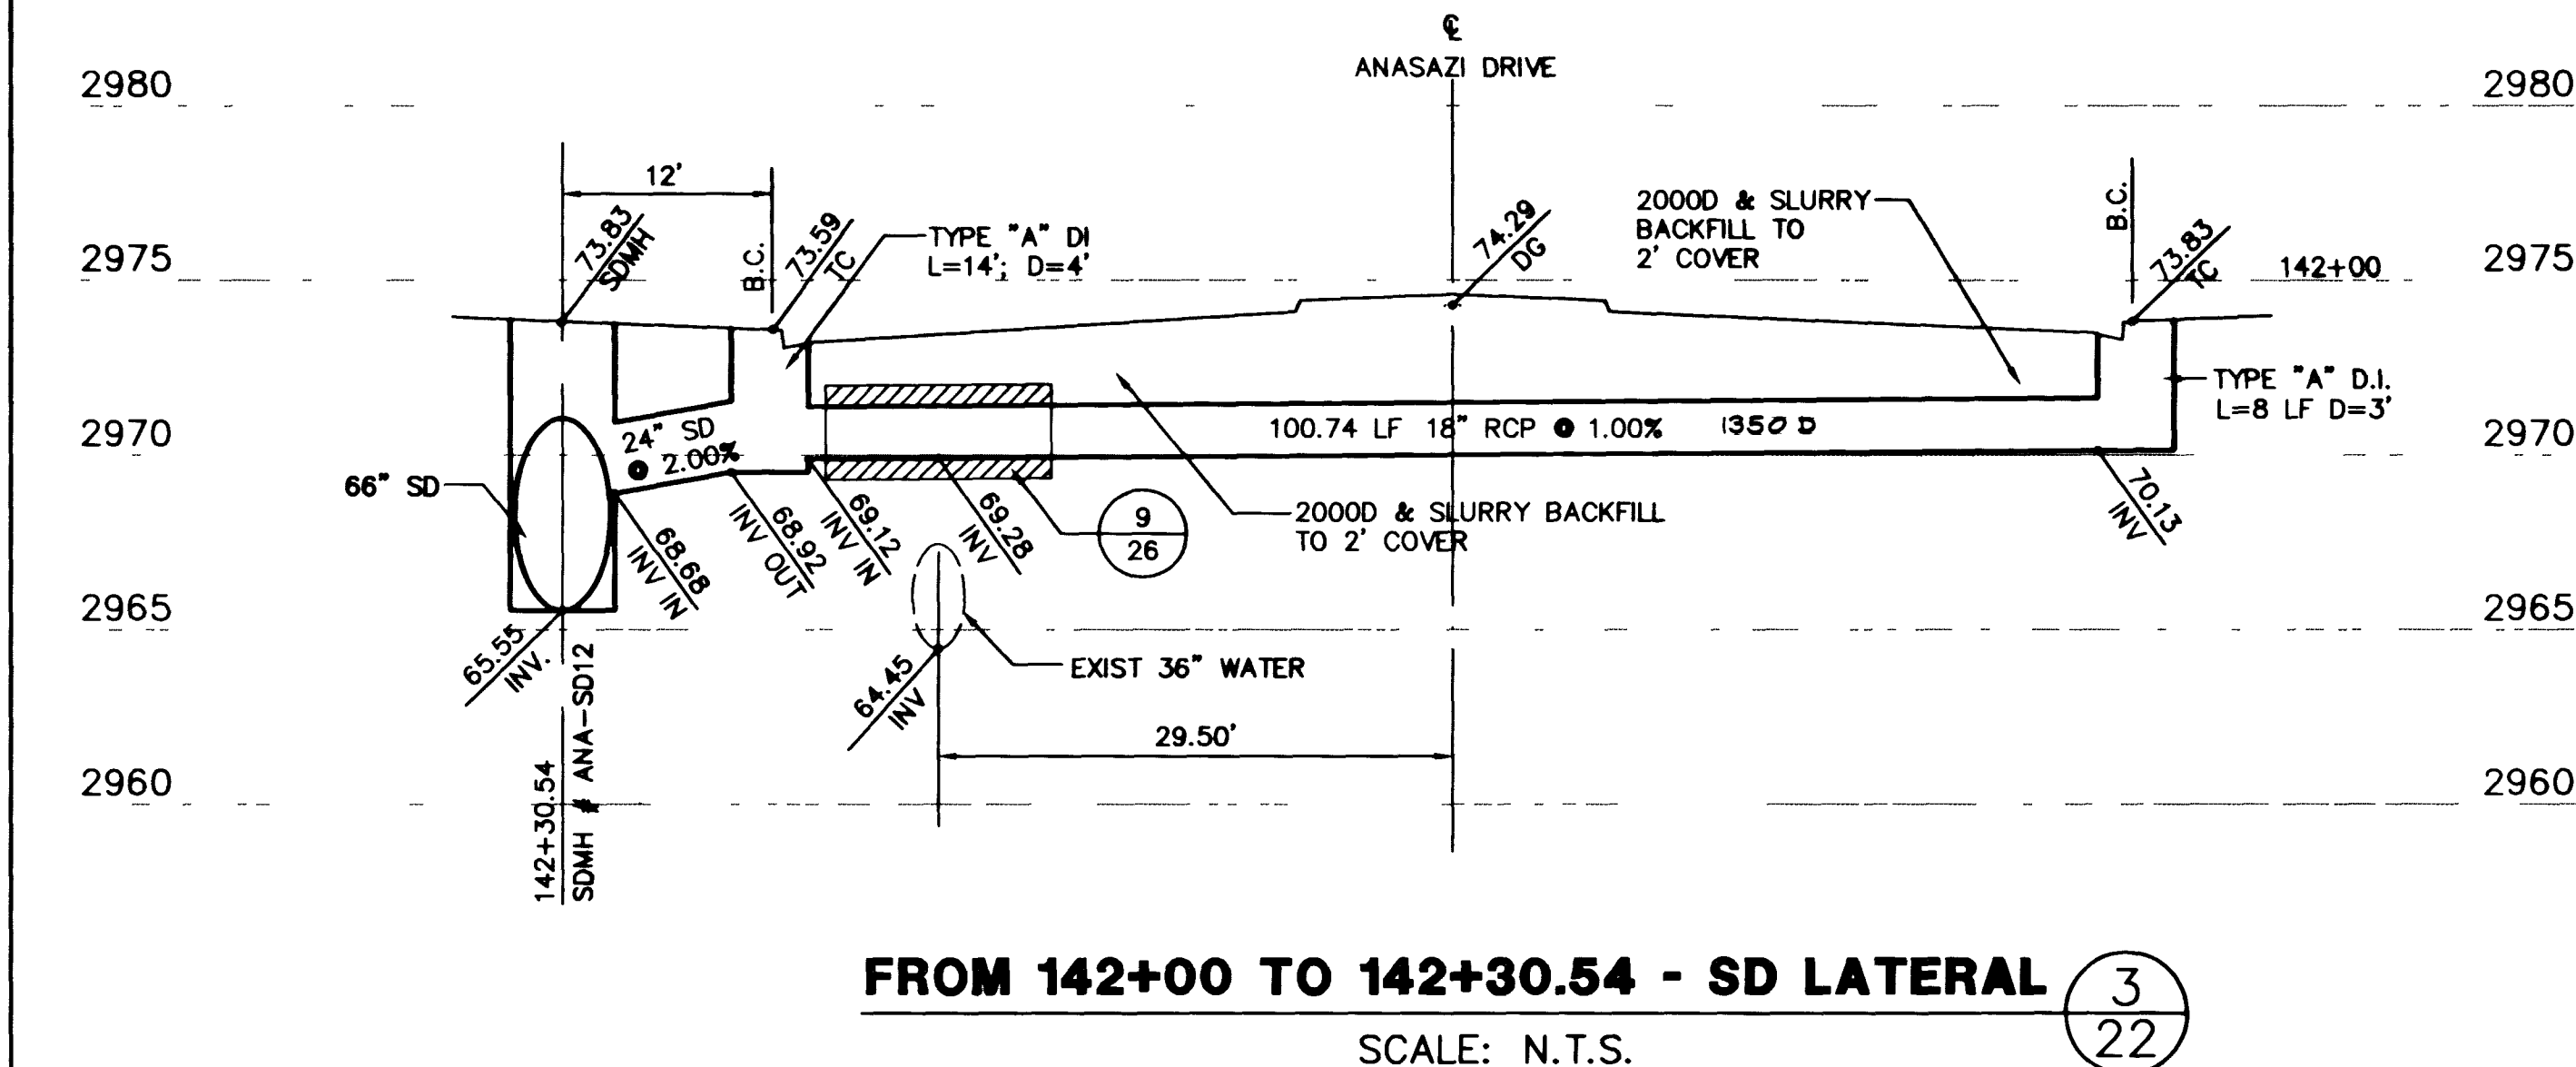

APPROVED FOR CONSTRUCTION  
DATE 3/11/96  
LVVWD

|                                                                                                                                           |         |          |
|-------------------------------------------------------------------------------------------------------------------------------------------|---------|----------|
| RECOMMENDED BY                                                                                                                            | DATE    | APPROVAL |
| BERT A. HUGHES                                                                                                                            | 3/11/96 |          |
| RECORD DRAWING INFORMATION                                                                                                                | DATE    | APPROVAL |
| BERT A. HUGHES                                                                                                                            | 3/11/96 |          |
| <p><b>G.C. WALLACE, INC.</b><br/>Engineering/Architecture 1585 SOUTH RAINBOW BLVD., LAS VEGAS, NEVADA 89106</p>                           |         |          |
| <p><b>SUMMERLIN</b><br/><b>ANASAZI DRIVE IMPROVEMENTS</b><br/><b>ANASAZI DRIVE</b><br/><b>STORM DRAIN &amp; SEWER LATERAL DETAILS</b></p> |         |          |
| <p>SHEET<br/><b>22</b><br/>SHT 22 OF 29</p>                                                                                               |         |          |

JOB NO. 92008.205

February 29, 1996 3:59:11 p.m. C:\QTDrawing\G\ANASAZI\SH\ELLS\ANA-C22R.DWG

8670

24-0-40

107-V2493

