


SUMMERLIN

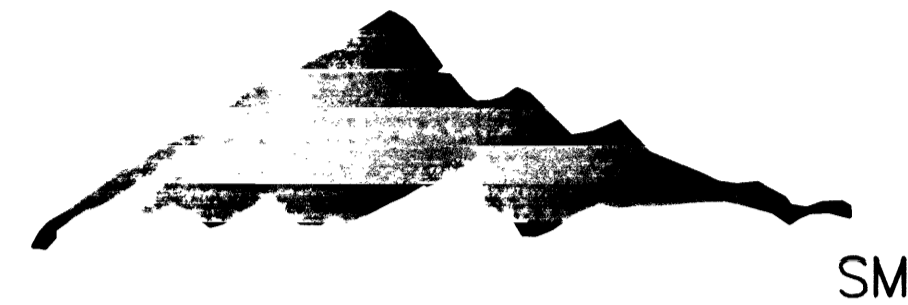

VILLAGE 8

UNIT I PHASE 3 IMPROVEMENT PLANS 1994

RECORD DRAWINGS
G.C. WALLACE, INC.

THESE PLANS SHOW RECORD INFORMATION RECEIVED FROM:
CONTRACTOR WELLS CARGO, INC.
DATE: 9/13/1995

THIS DATA MAY OR MAY NOT REFLECT THE ACTUAL FIELD LOCATIONS. ALL DATA SHOULD BE CONFIRMED PRIOR TO USE ON DEVELOPMENT OR ENGINEERING PLANS.

PROJECT MANAGER REVIEW
BY: [Signature] DATE: 10/10/95

**ISSUE TO CONSTRUCT
FINAL CITY APPROVAL**

DEVELOPER

HOWARD HUGHES PROPERTIES,
LIMITED PARTNERSHIP, a DELAWARE
limited partnership.

BY: SUMMERLIN, a division of
SUMMA CORPORATION, a
DELAWARE corporation, its sole
general partner.

ENGINEER



G.C. WALLACE, INC.
Engineering/Architecture

1555 SOUTH RAINBOW BLVD./LAS VEGAS, NEVADA 89102

[Handwritten signature]

7/14/94

SHEET 1 OF 35

11-7-82

107Y-4294-1-3

JOB NO. 62008.201

S.T.S. V8PH3COV.DWG. 08/26/94

2654

2. 3/23/95 REV. SHEET 35
1/25/95 REV. SHEETS 3 & 12