
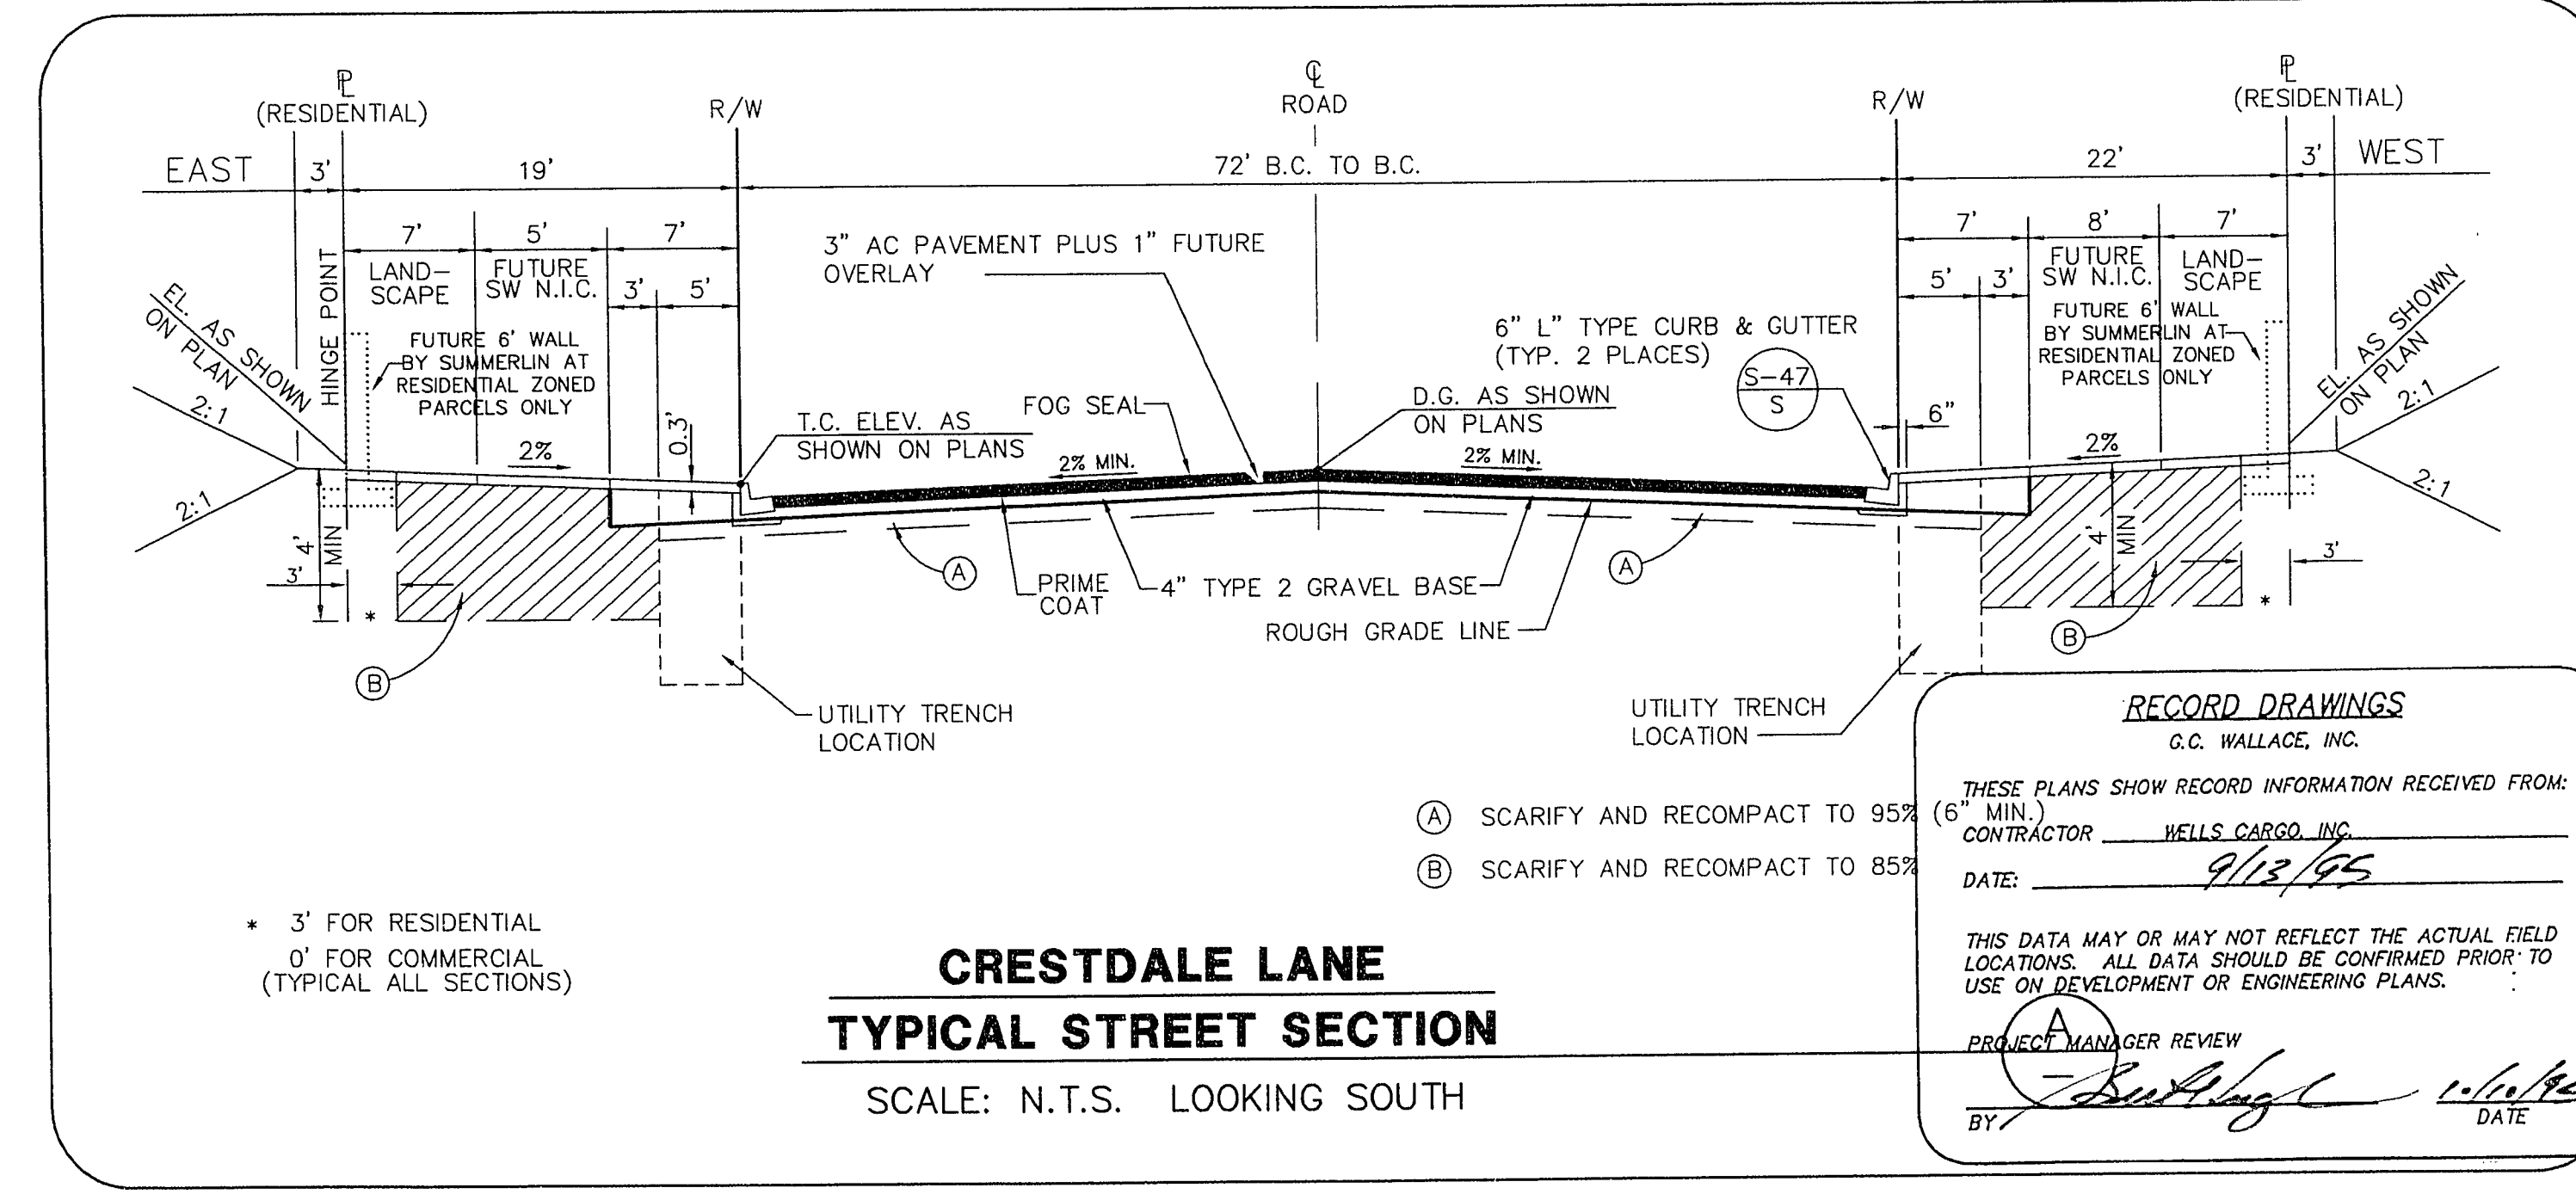
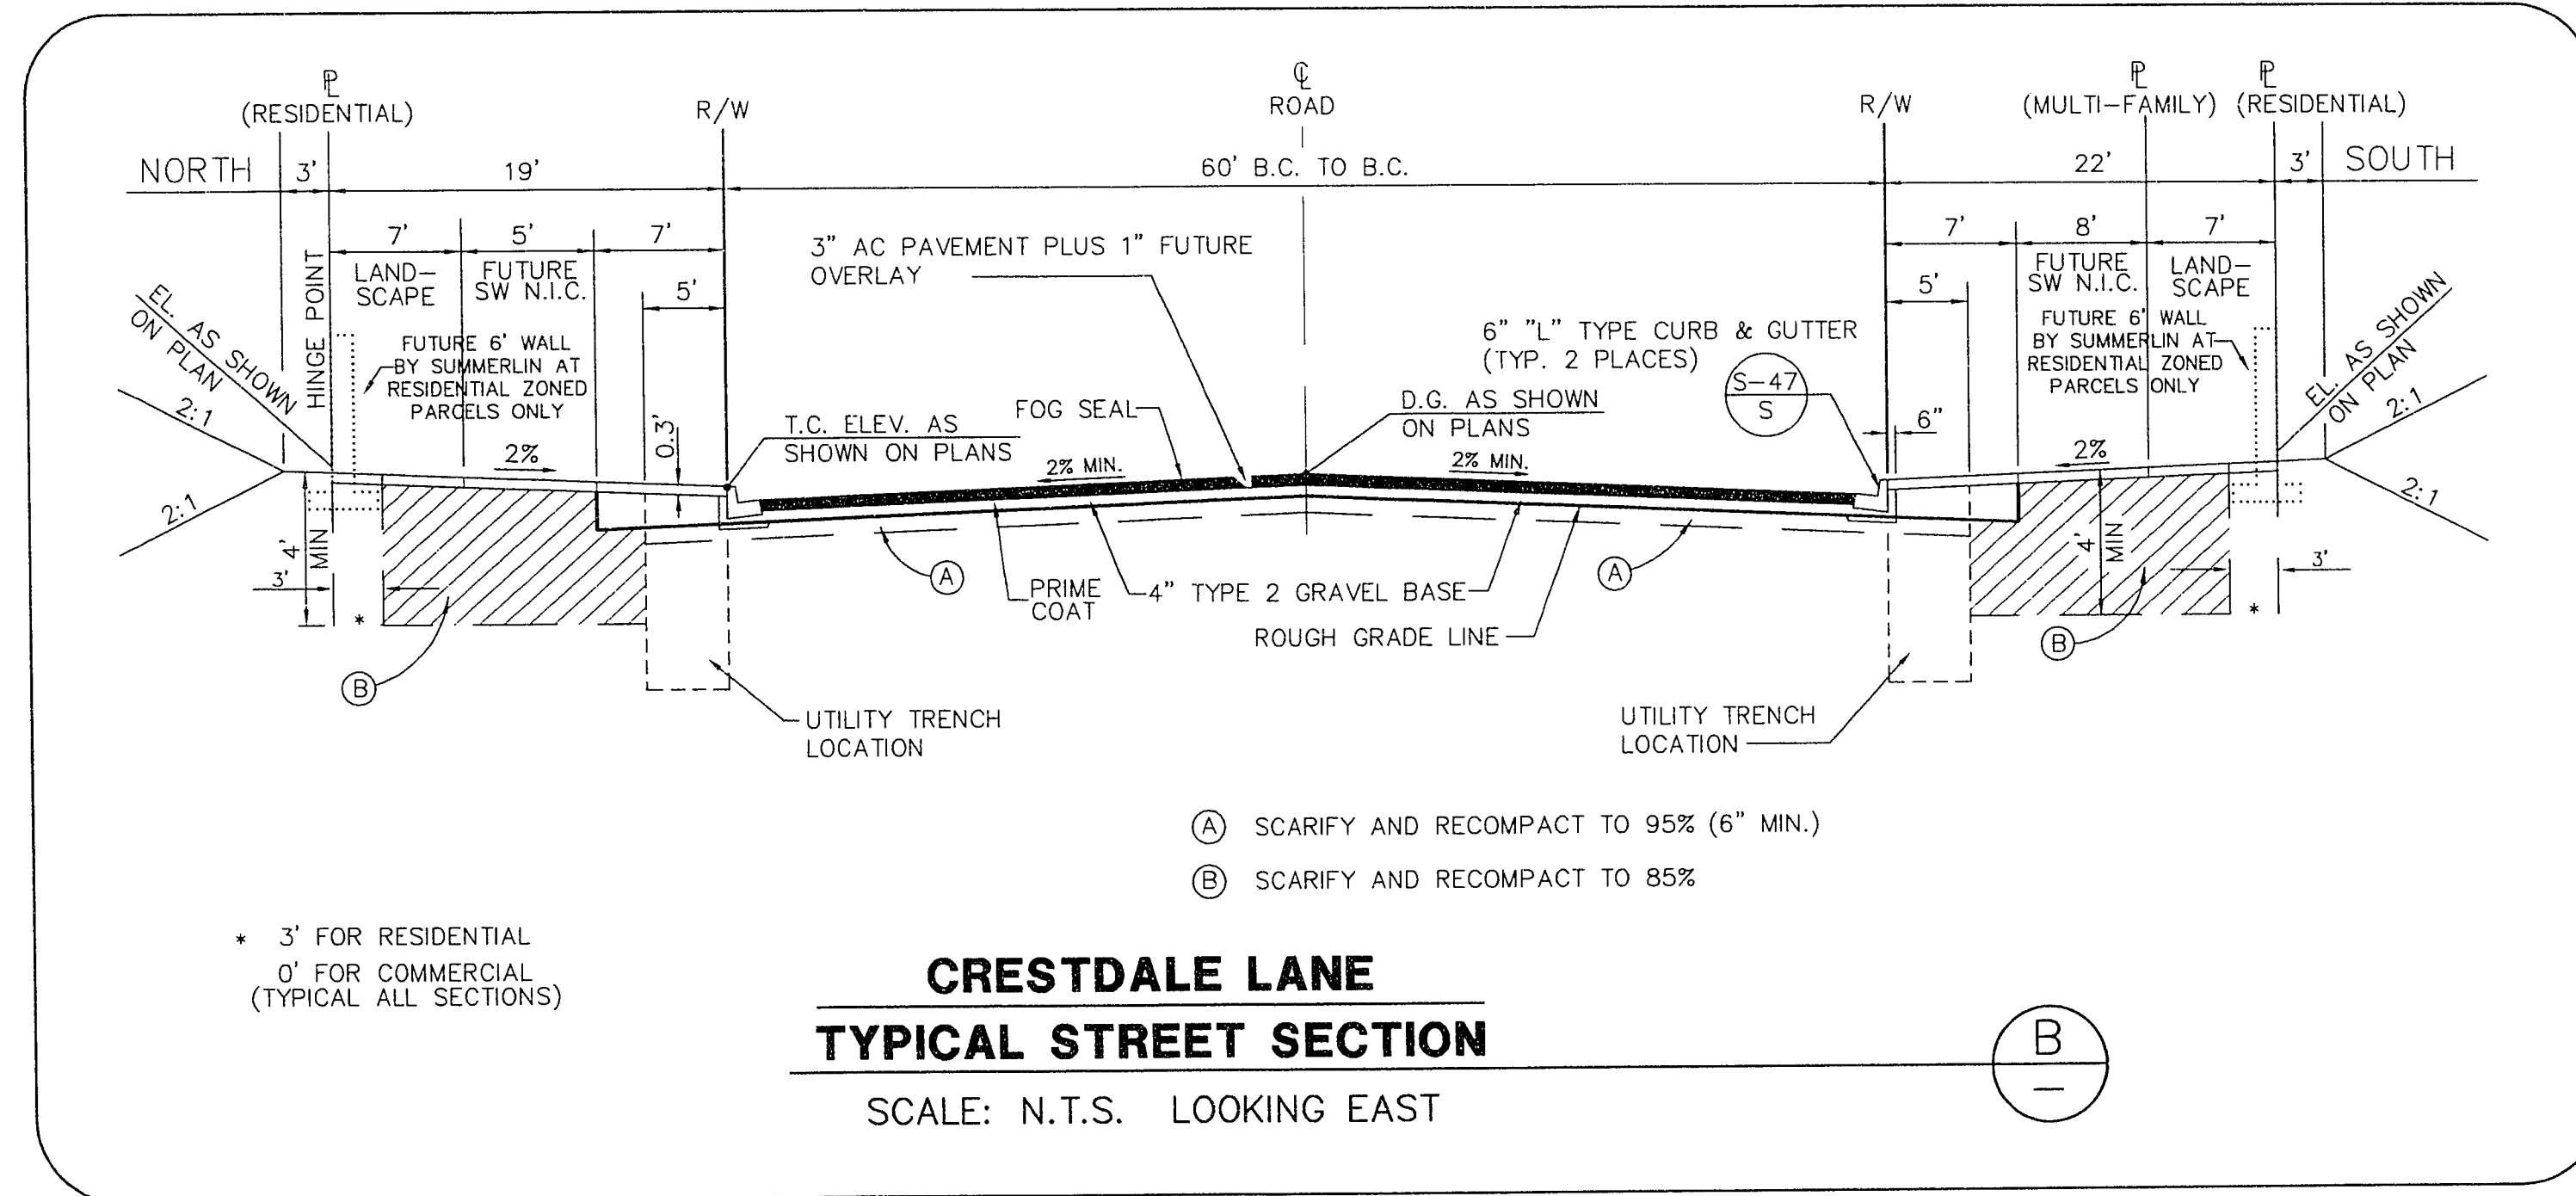


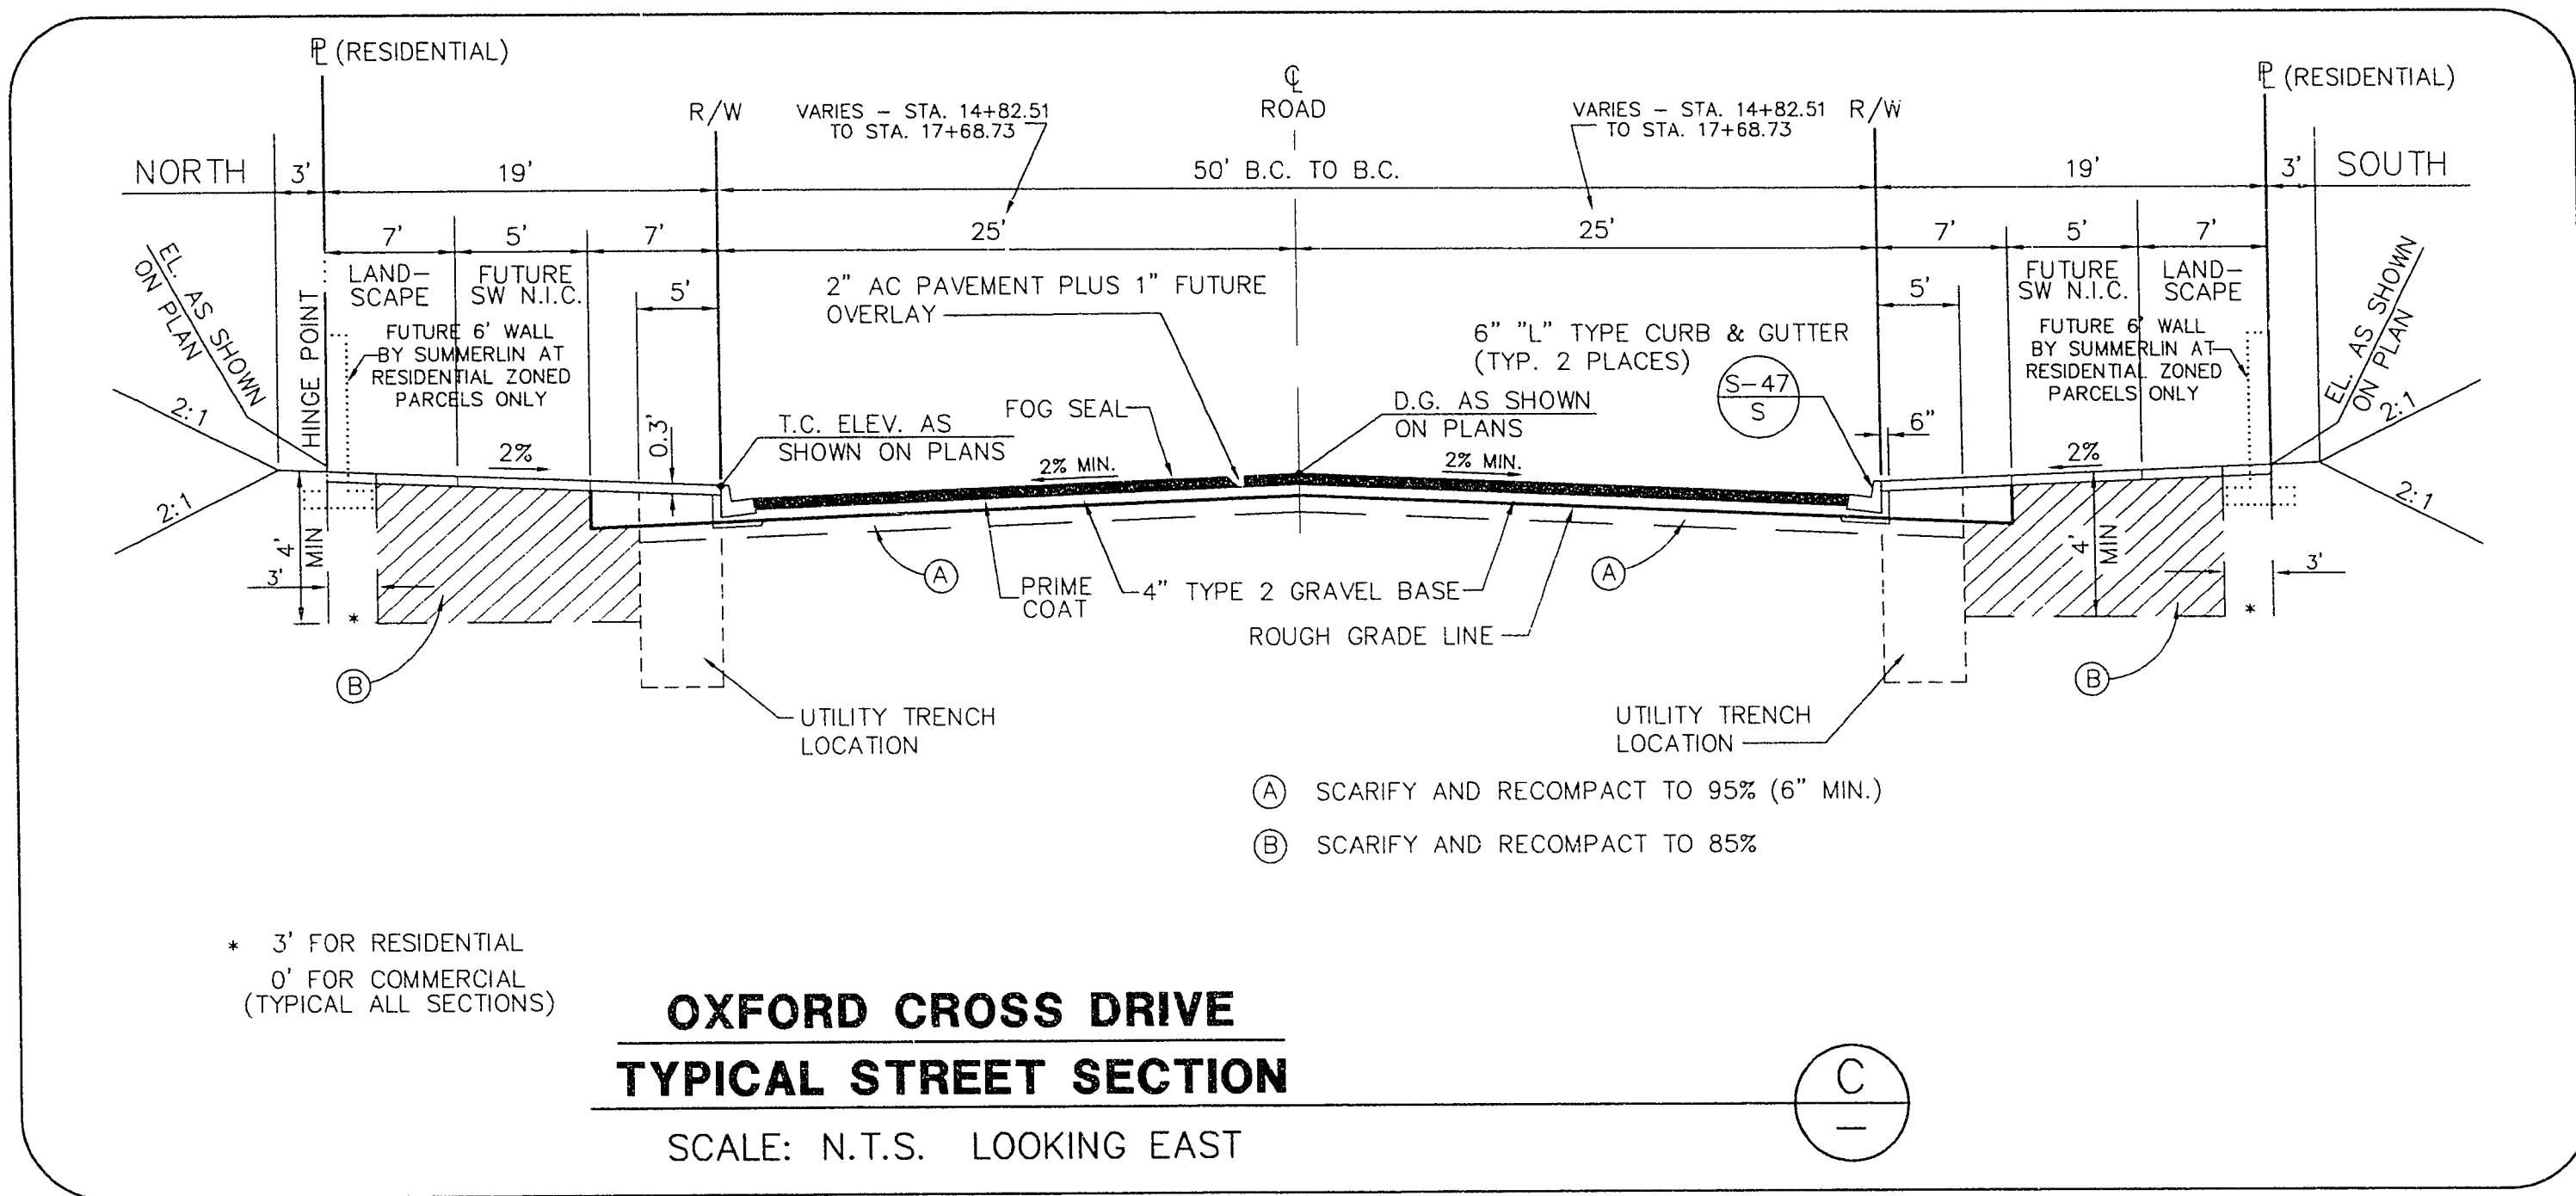

RECORD DRAWINGS
 G.C. WALLACE, INC.

THESE PLANS SHOW RECORD INFORMATION RECEIVED FROM:
 CONTRACTOR WELLS CARGO, INC.
 DATE: 9/12/95

THIS DATA MAY OR MAY NOT REFLECT THE ACTUAL FIELD LOCATIONS. ALL DATA SHOULD BE CONFIRMED PRIOR TO USE ON DEVELOPMENT OR ENGINEERING PLANS.

PROJECT MANAGER REVIEW
 BY: [Signature] DATE: 11/18/94

RECOMMENDED	BERT A. HUGHES	10259	R.P.E. NO.	DATE	DESCRIPTION	DATE	APPROVAL
G.C. WALLACE, INC. Engineering/Architecture 1555 SOUTH RAINBOW BLVD./LAS VEGAS, NEVADA 89102							
VILLAGE 8 UNIT 3 IMPROVEMENTS TYPICAL STREET SECTIONS							
SHEET 18 SHT 18 OF 20							

21.0-117 107-V22 89