


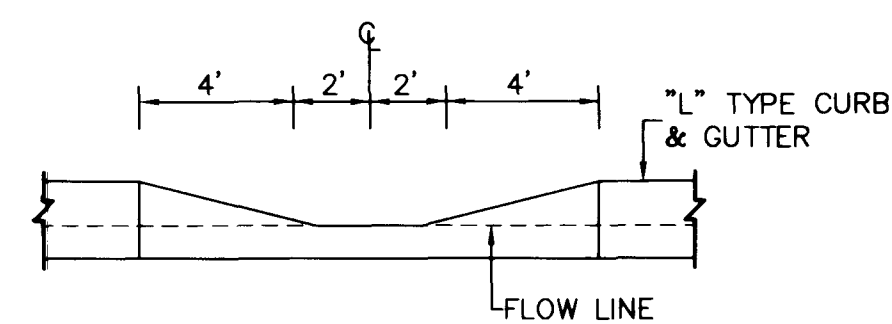


SEE S-75 S

DEPRESSED CURB DETAIL

SCALE: N.T.S.


8

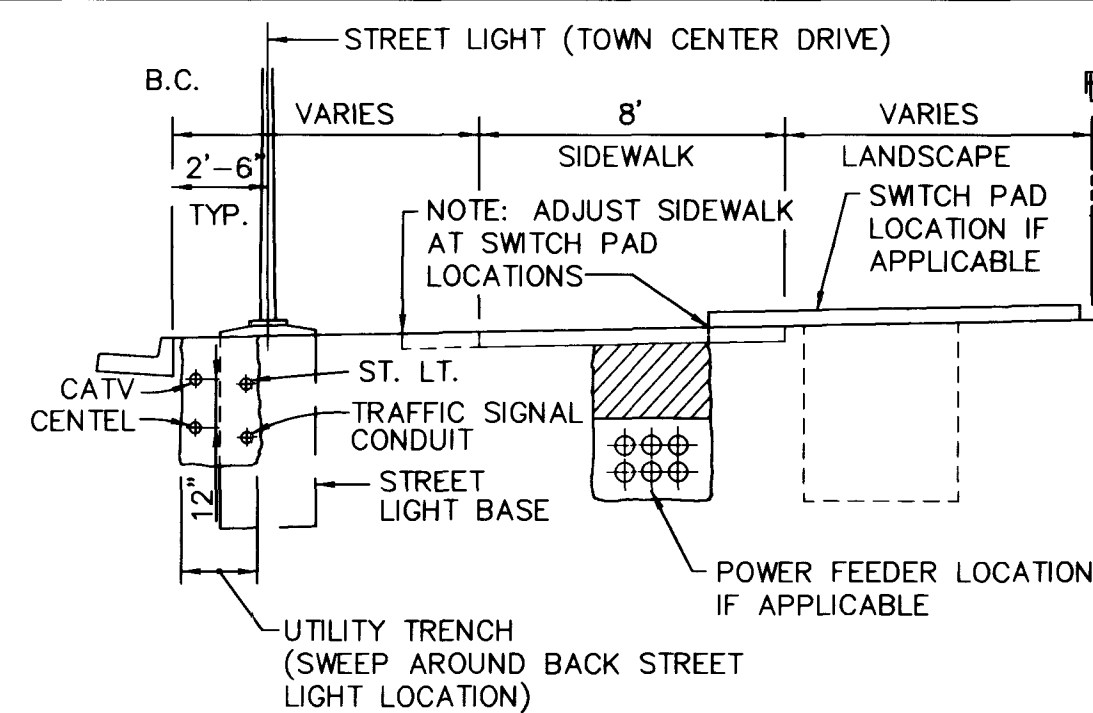

TYPICAL UTILITY LOCATION DETAIL

SCALE: N.T.S.


7

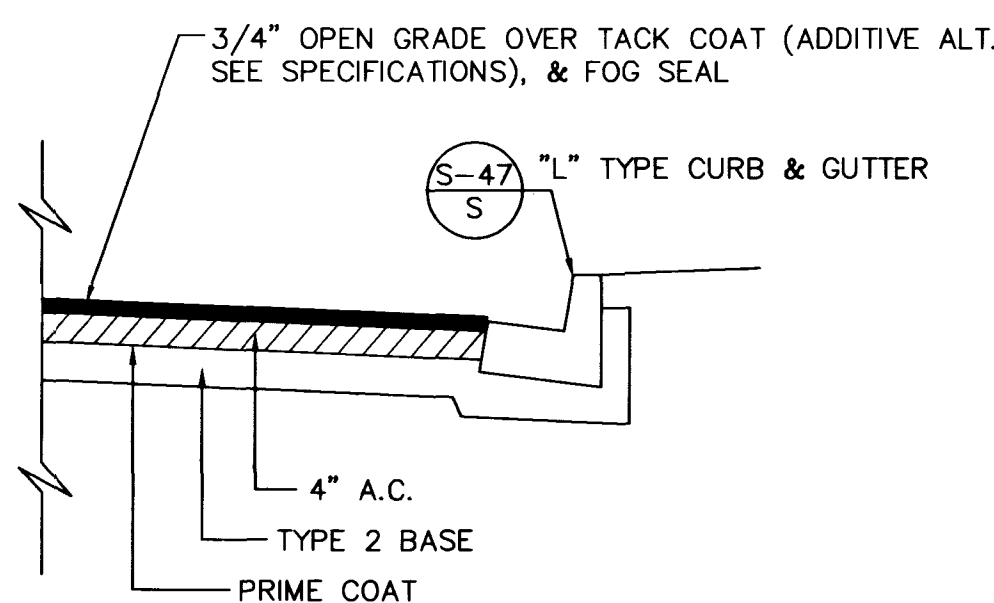

A.C. OVERLAY DETAIL

SCALE: N.T.S.


6

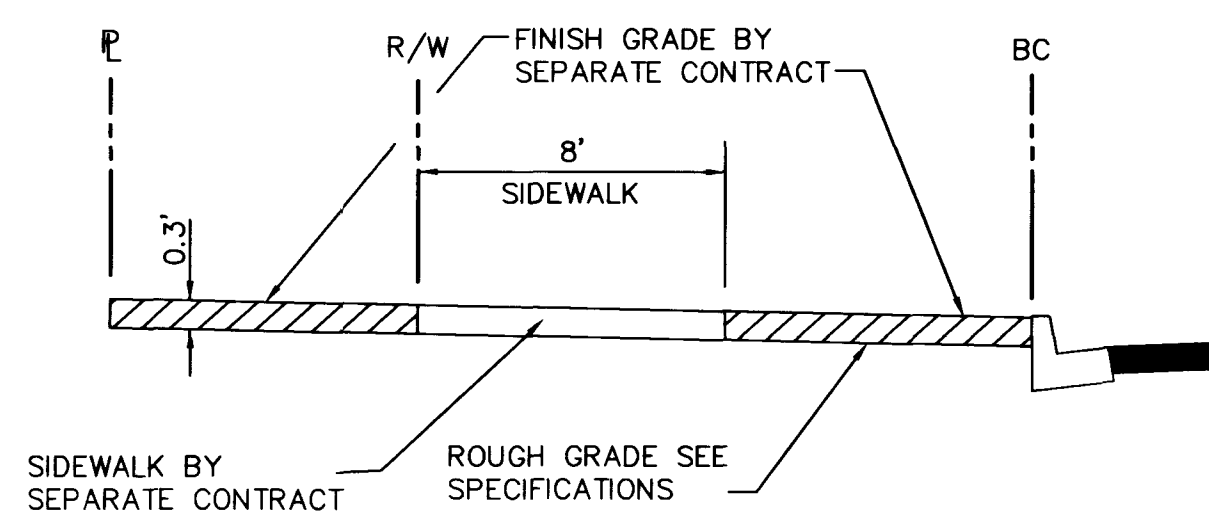

FINE GRADING DETAIL


SCALE: N.T.S.

5

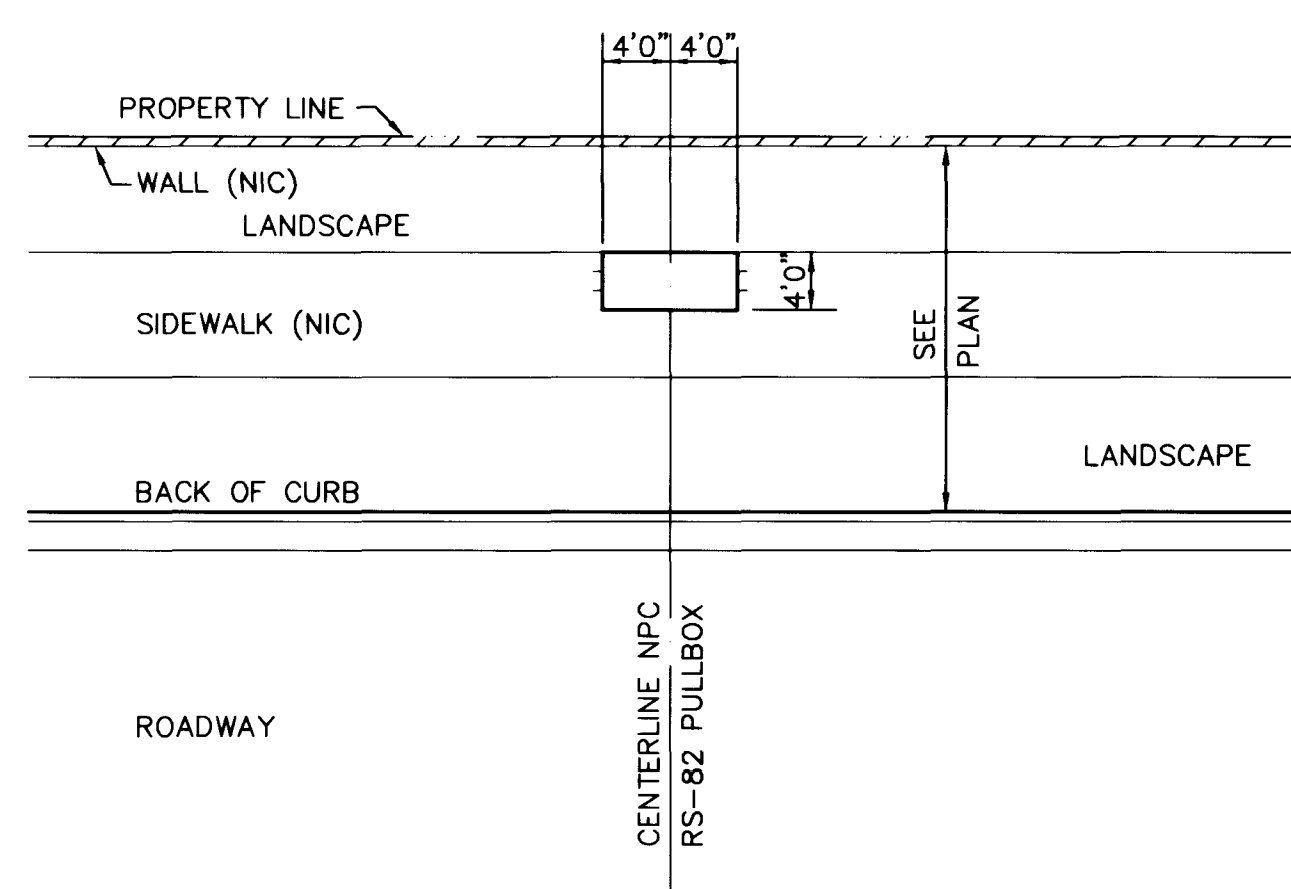


TYPICAL NPC PULL BOX LOCATION

3

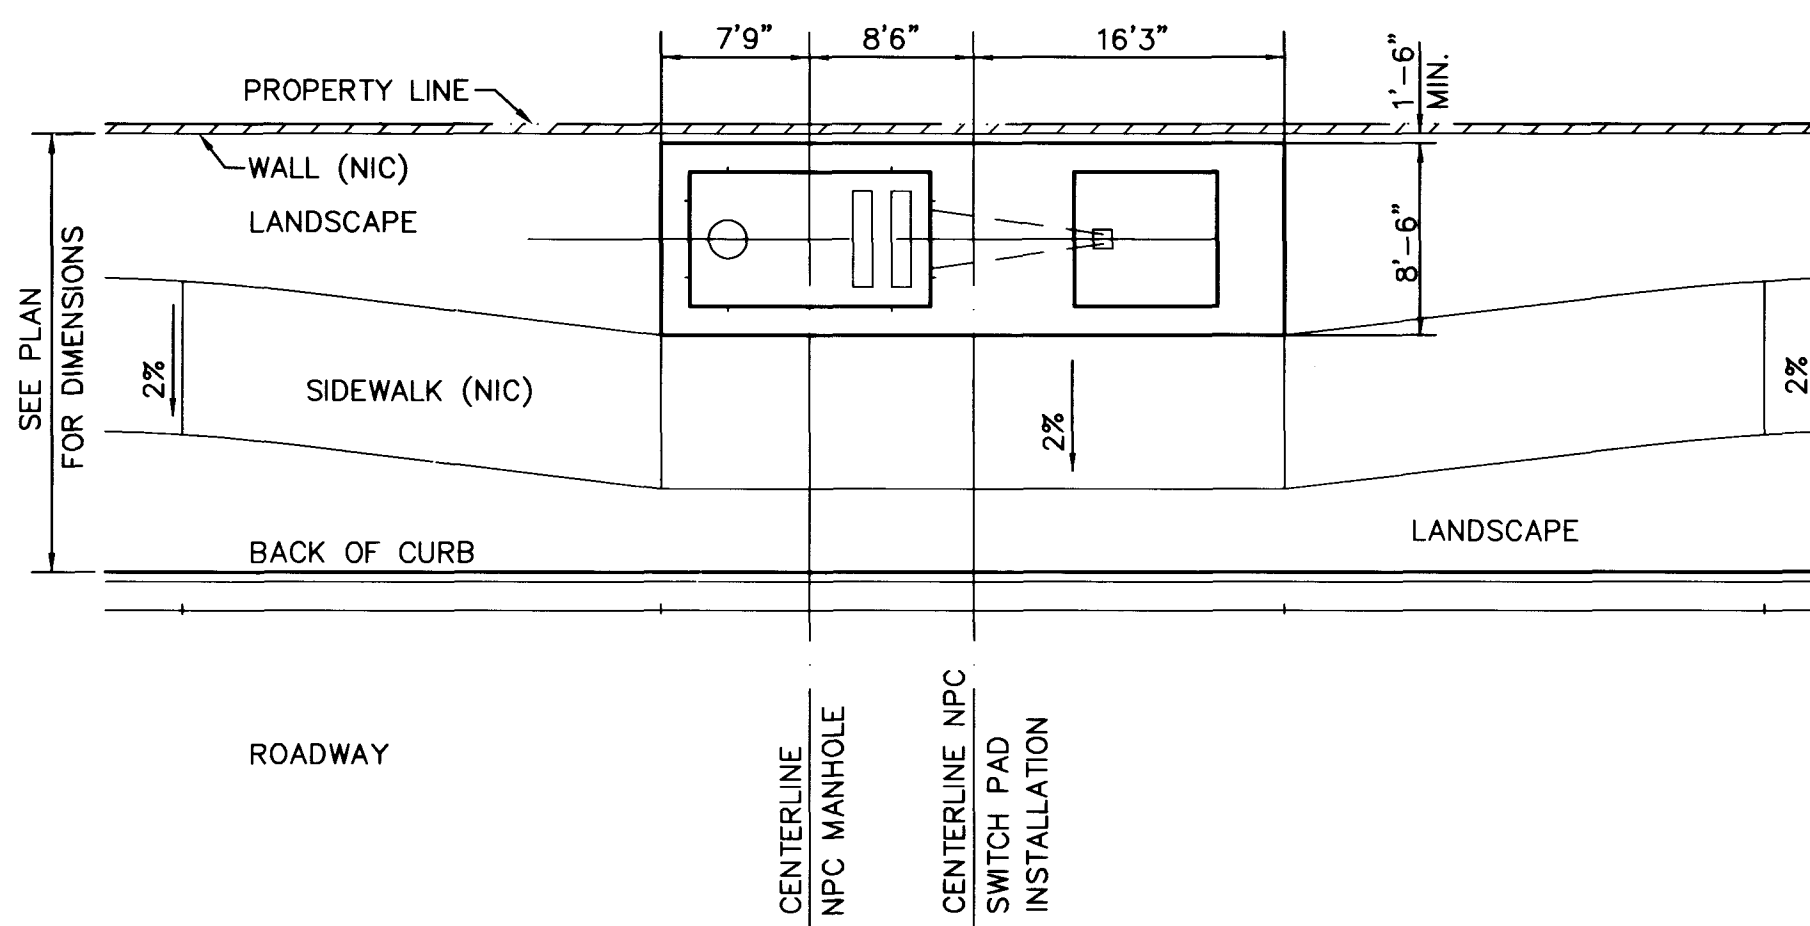

TYPICAL SIDEWALK LAYOUT AT SWITCH PADS


2

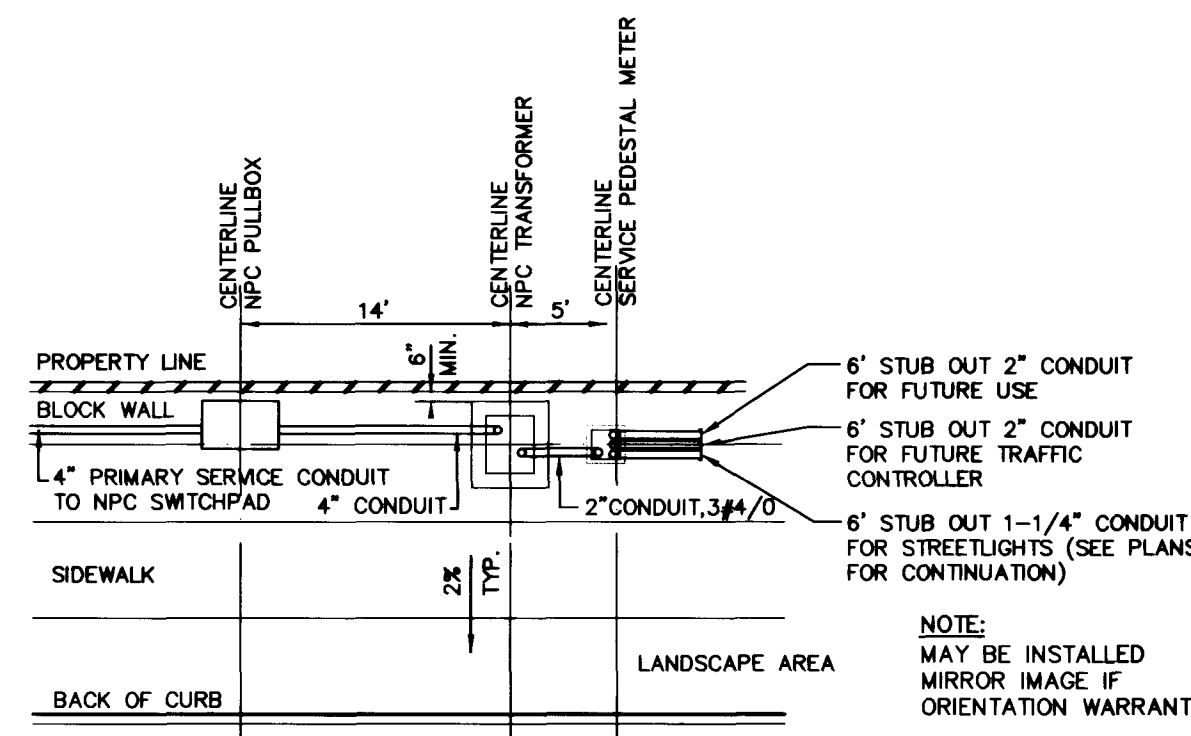

TYPICAL SERVICE PEDESTAL INSTALLATION

1

TYPICAL N.P.C. DETAILS SCALE: N.T.S. (FOR REFERENCE ONLY)

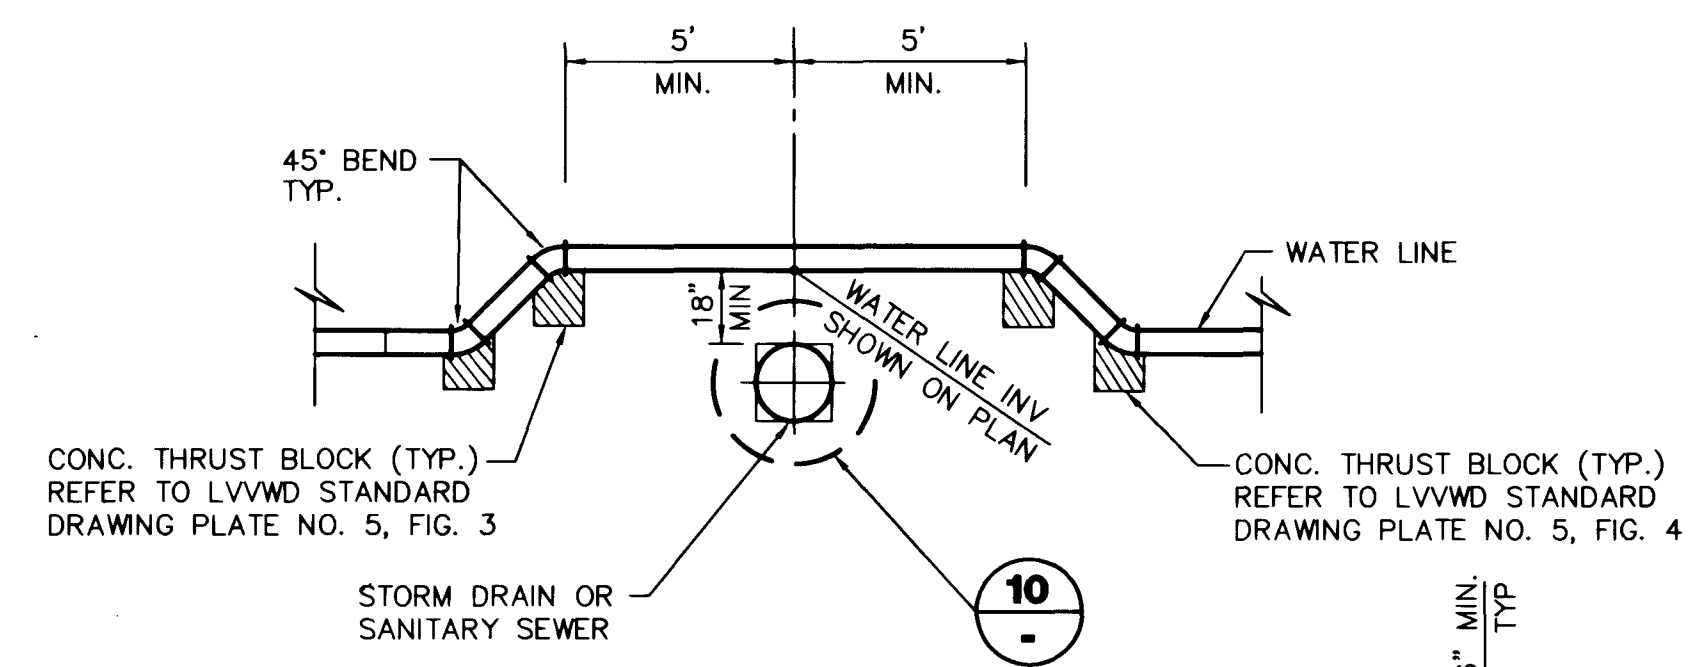

CONC. ENCASEMENT DETAIL


SCALE: N.T.S.

10

WATER - STORM DRAIN CROSS OVER DETAIL

9
20

RECORD DRAWINGS
THESE PLANS SHOW RECORD INFORMATION RECEIVED FROM:
CONTRACTOR: **WELLS CARGO/ACME ELECTRIC**
DATE: **OCTOBER 15, 1996**
THIS DATA MAY OR MAY NOT REFLECT THE ACTUAL FIELD LOCATIONS. ALL DATA SHOULD BE CONFIRMED PRIOR TO USE ON DEVELOPMENT OR ENGINEERING PLANS.

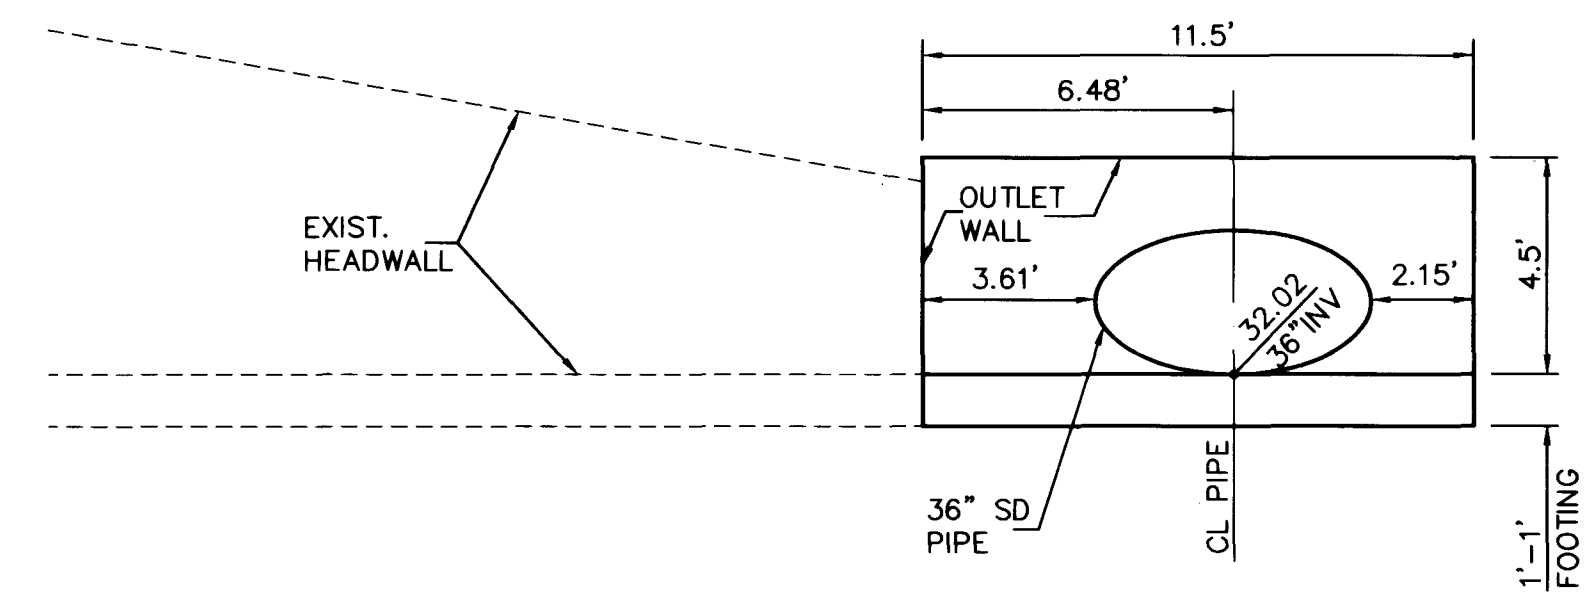

STORM DRAIN OUTLET DETAIL

A
20

APPROVAL:

LAS VEGAS VALLEY WATER DISTRICT

DATE

RECOMMENDED
CHRISTOPHER W.
ANDERSON
CIVIL ENGINEER
STATE OF NEVADA
PROFESSIONAL ENGINEER
NO. 5071
G.C. WALLACE, INC.
Engineering/Architecture
1535 SOUTH RAINBOW BLVD./LAS VEGAS, NEVADA 89102

SHEET
20
SHT 20 OF 21

SUMMERLIN
TOWN CENTER DRIVE
TOWN WIDE ARTERIAL
MISC. DETAILS

10/15/96 RECORD DRAWINGS
DATE
DESCRIPTION
REVAL
DATE
APPROVAL

