

JOB NO. 701.156 PLOTTED: 04/14/92 3:41 pm DRAWING: D359-5




MATCH LINE - SEE SHEET 4

MATCH LINE - SEE SHEET 7

AS-BUILT NOTE:

THE AS-BUILT ELEVATIONS AND LATERAL LOCATION DISTANCES ADDED TO THIS MAP WERE THE RESULTS OF A FIELD SURVEY MADE UNDER MY DIRECTION.


SAM LONG, PLS
NEVADA CERTIFICATE NO. 9047

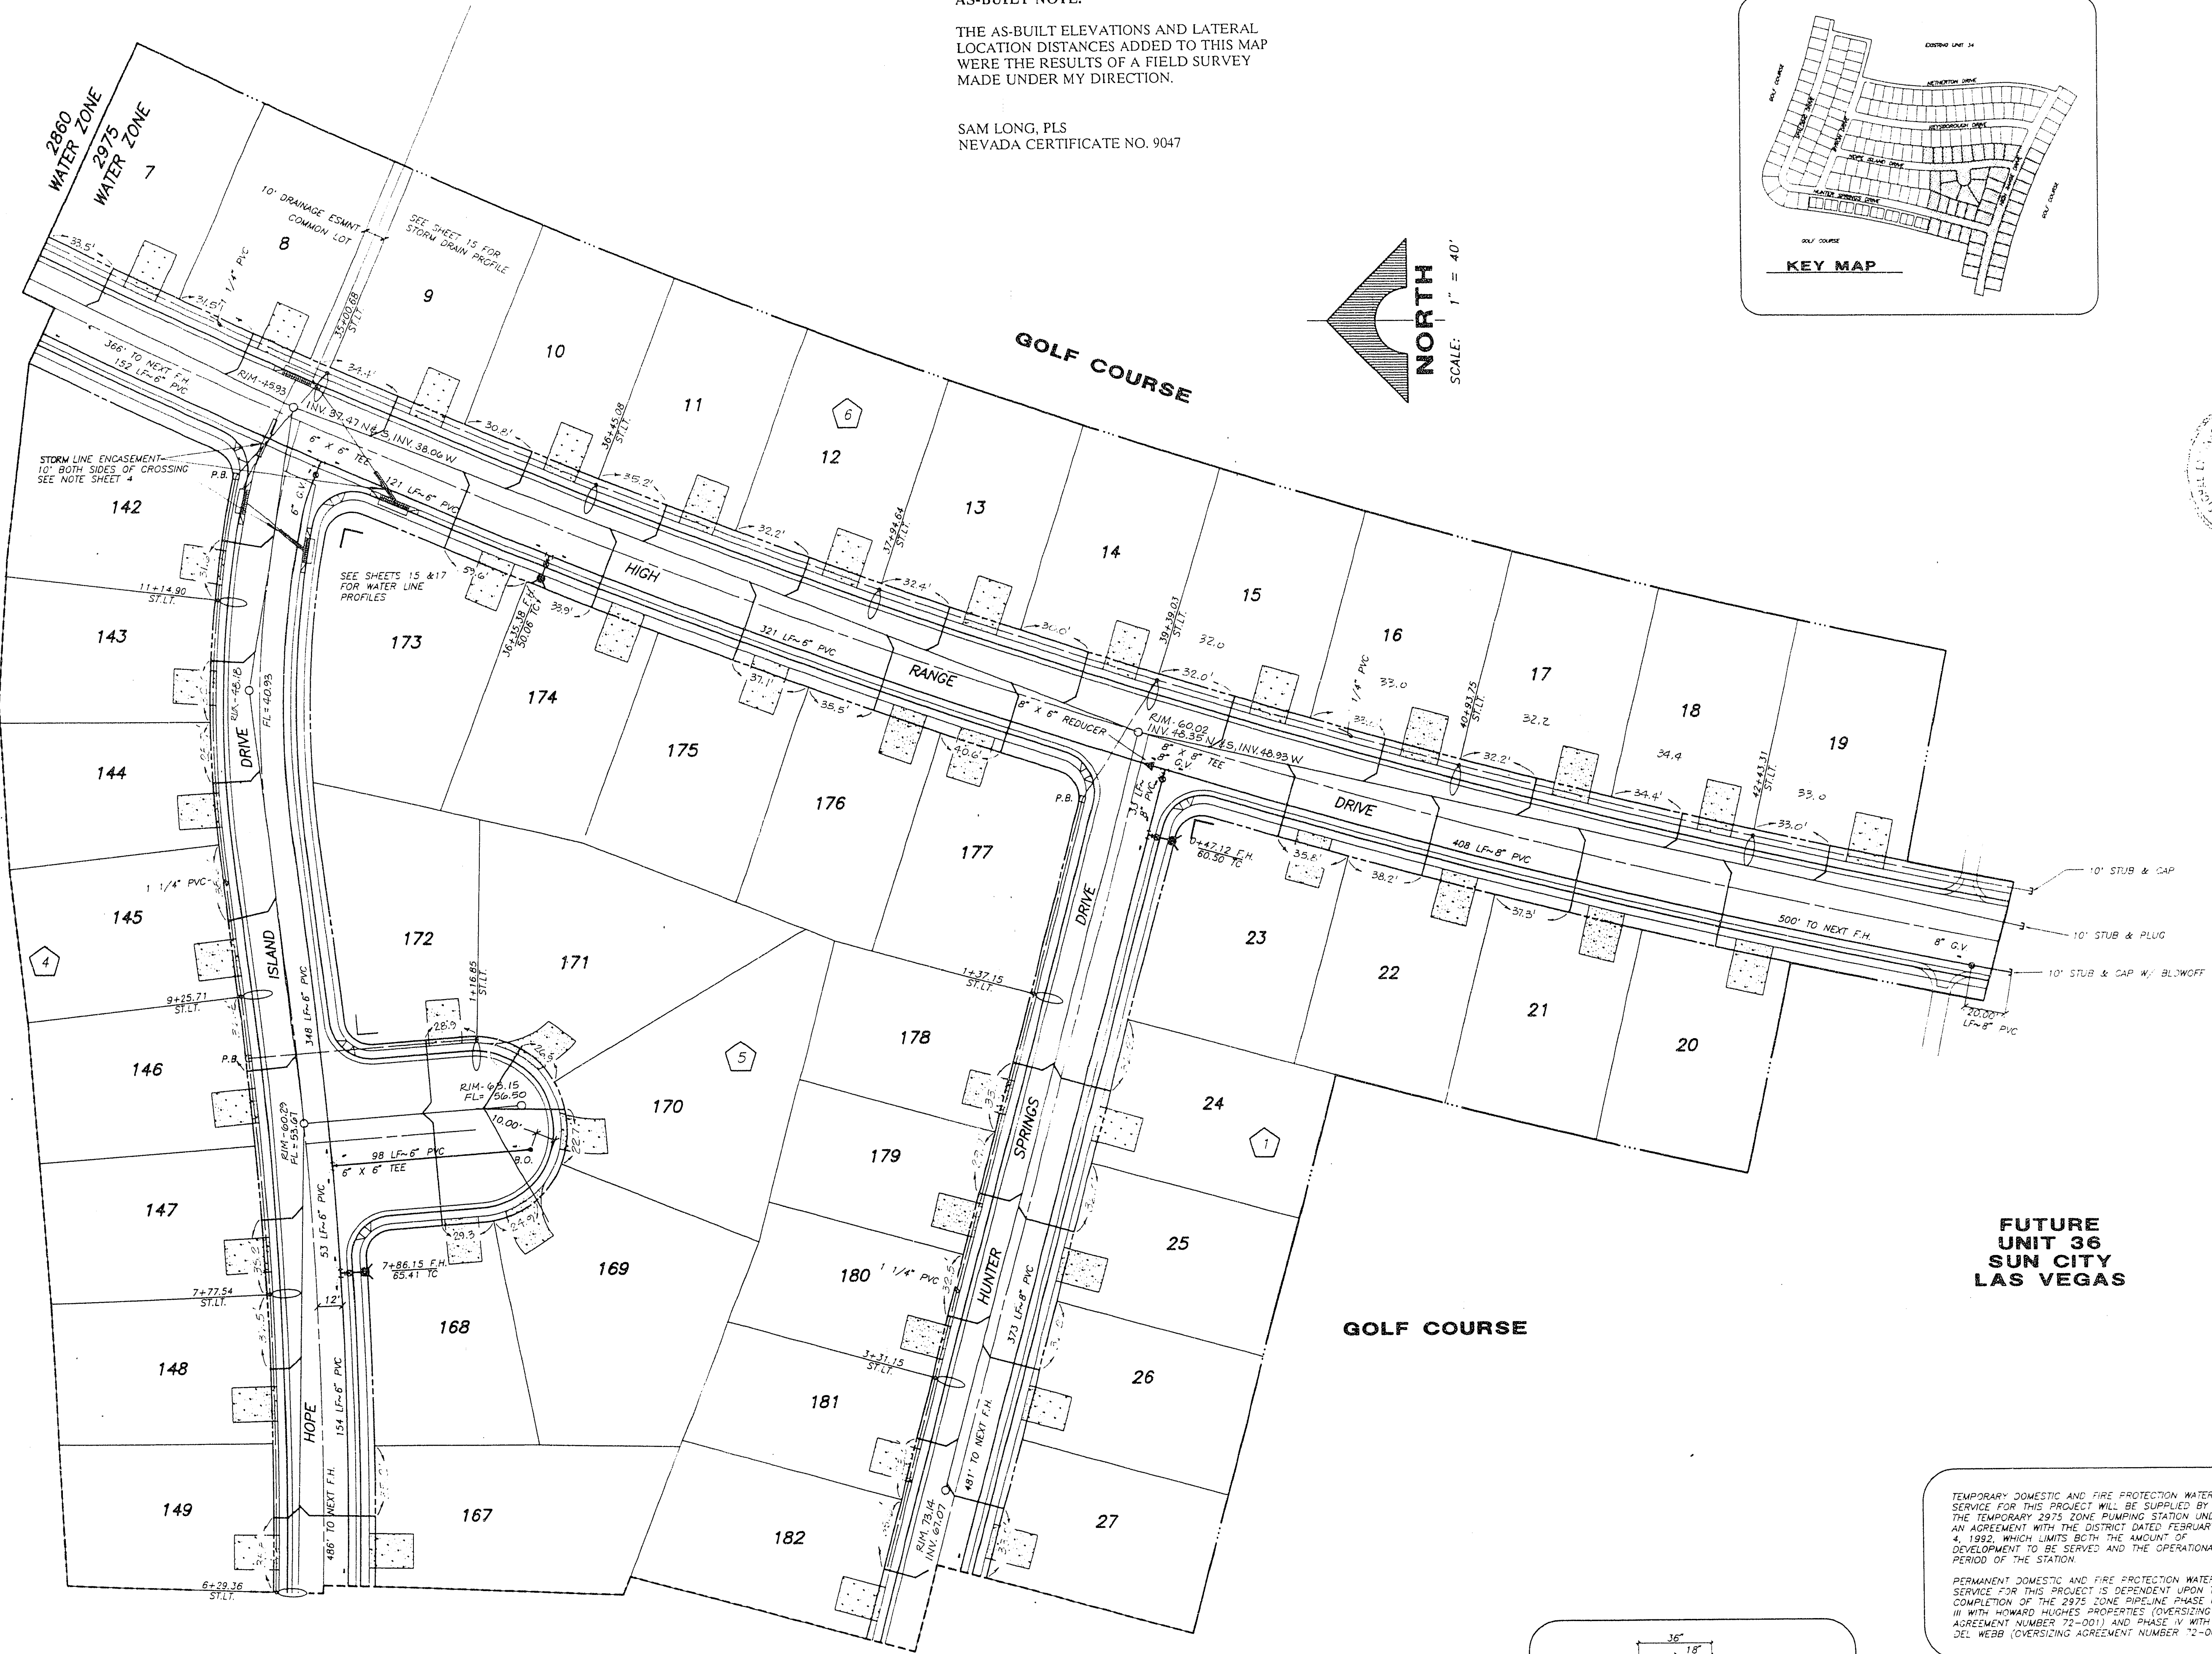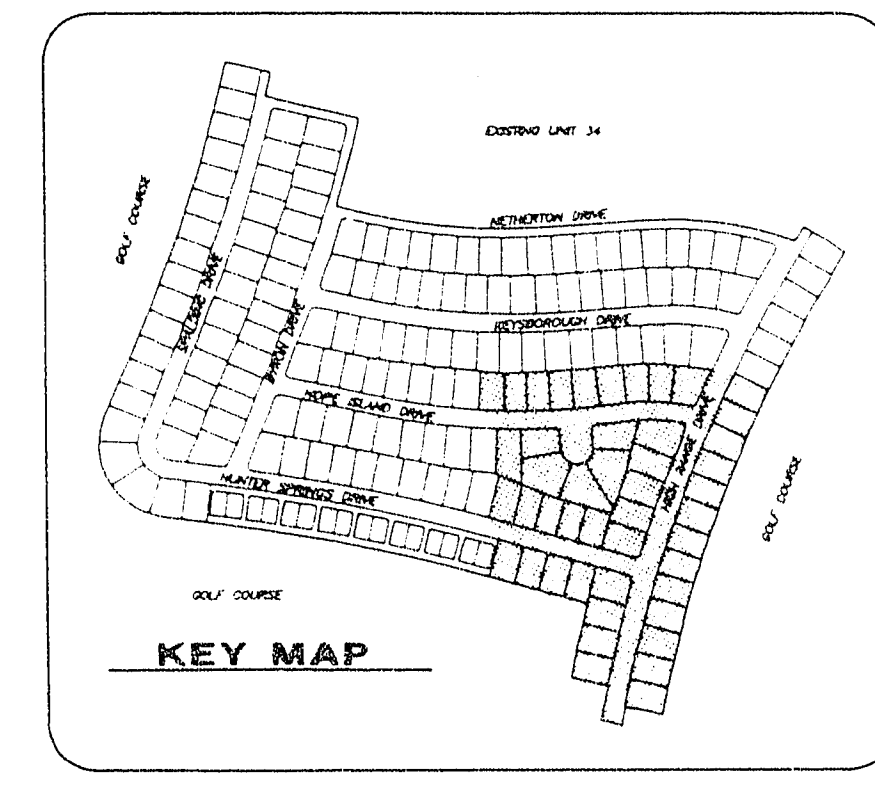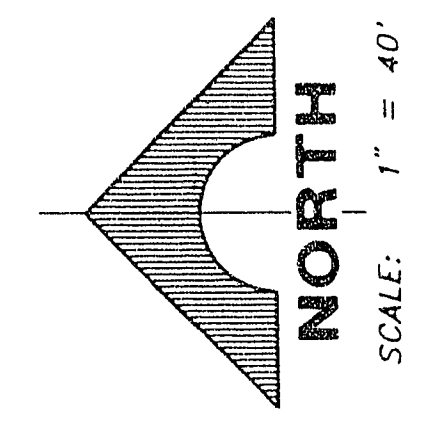

**FUTURE UNIT 36
SUN CITY
LAS VEGAS**

TEMPORARY DOMESTIC AND FIRE PROTECTION WATER SERVICE FOR THIS PROJECT WILL BE SUPPLIED BY THE TEMPORARY 2975 ZONE PUMPING STATION UNDER AN AGREEMENT WITH THE DISTRICT DATED FEBRUARY 4, 1992, WHICH LIMITS BOTH THE AMOUNT OF DEVELOPMENT TO BE SERVED AND THE OPERATIONAL PERIOD OF THE STATION.

PERMANENT DOMESTIC AND FIRE PROTECTION WATER SERVICE FOR THIS PROJECT IS DEPENDENT UPON THE COMPLETION OF THE 2975 ZONE PIPELINE PHASE II & III WITH HOWARD HUGHES PROPERTIES (OVERSIZING AGREEMENT NUMBER 72-001) AND PHASE IV WITH DEL WEBB (OVERSIZING AGREEMENT NUMBER 72-002).

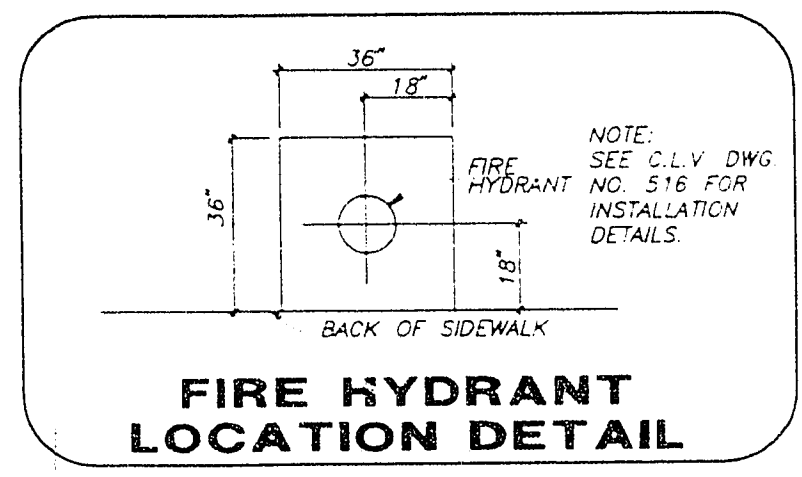

APPROVED FOR CONSTRUCTION

[Signature] 4/20/92

LAS VEGAS WATER DISTRICT DATE

"AS-BUILTS"

REV.	DATE	DESCRIPTION	C.L.V.	DATE

RECOMMENDED UNIT
PROJECTED UNIT
MICHAEL D. ROSS
P.E. NO. 10102
1555 SOUTH RAINBOW BLVD., LAS VEGAS, NEVADA 89102

DEL WEBB COMMUNITIES, INC.
SUN CITY LAS VEGAS UNIT NO. 36
UTILITY PLAN II

SHEET
5
OF 24 SHEETS

10-3-6 "As Built" 3074-4141-35