



PROFILE
 SCALE: HORIZ. 1" = 40'
 VERT. 1" = 4'

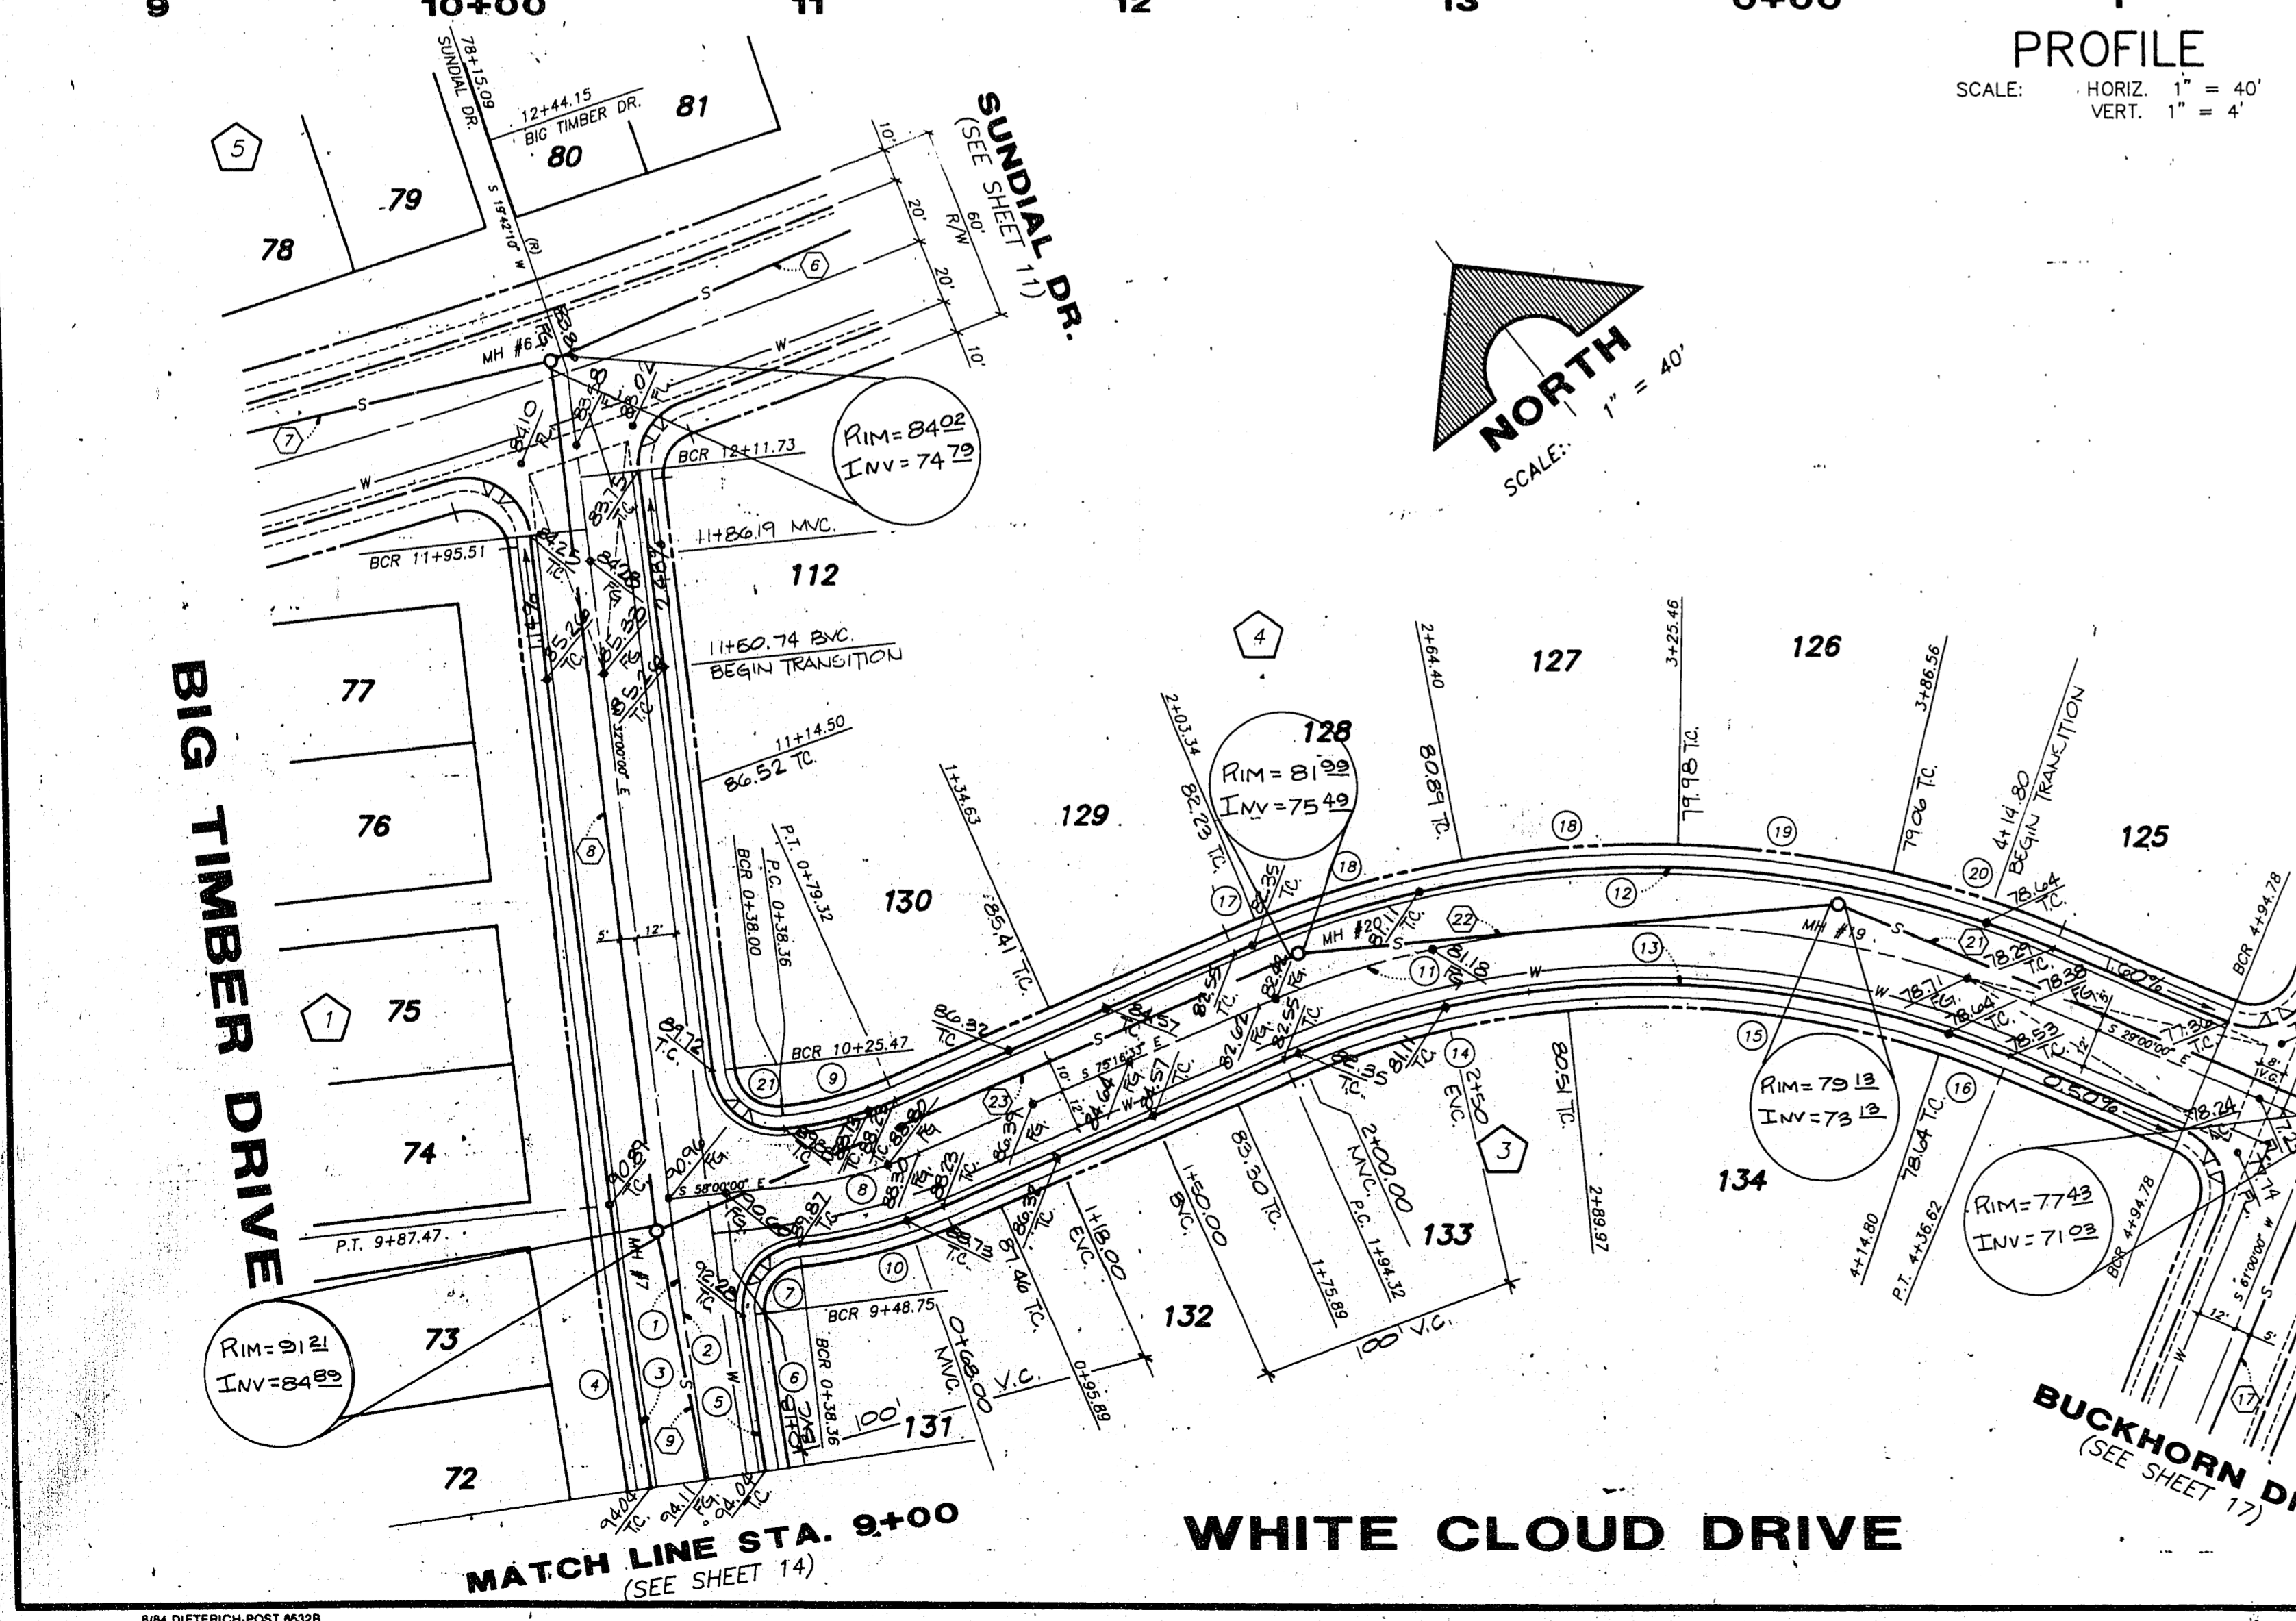

SEWER LINE TABLE


LINE	BEARING	DISTANCE
5	N 75°09'24" W	335.00'
6	N 64°59'04" W	136.01'
7	S 32°00'00" W	270.14'
8	S 27°44'31" W	268.16'
9	S 82°21'56" W	200.34'
10	S 61°00'00" W	277.00'
11	N 29°00'00" W	166.88'
12	N 37°06'08" W	165.74'
13	N 75°16'13" W	217.08'

APPROVED FOR CONSTRUCTION
 DEL WEBB COMMUNITIES, INC. DATE _____

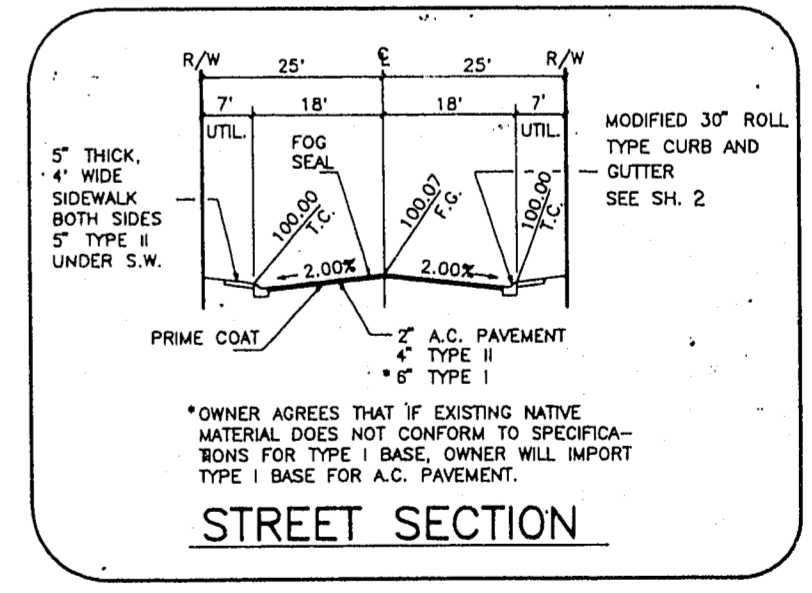

CURVE DATA

CURVE	DELTA	RADIUS	LENGTH	TANGENT
1	21°12'21"	2060.00'	762.43'	365.63'
2	17°15'09"	2060.00'	620.29'	312.51'
3	21°12'21"	2078.00'	768.10'	369.00'
4	13°39'31"	2078.00'	495.37'	248.86'
5	14°54'11"	2042.00'	531.14'	267.08'
6	02°52'02"	2042.00'	102.19'	51.11'
7	21°04'37"	2078.00'	768.10'	369.00'
8	17°16'33"	135.84'	49.96'	20.64'
9	17°16'33"	117.84'	35.53'	17.90'
10	17°16'33"	153.84'	46.39'	23.37'
11	46°16'33"	300.00'	242.30'	128.20'
12	46°16'33"	318.00'	256.84'	135.89'
13	46°16'33"	282.00'	227.78'	120.50'
14	18°18'03"	282.00'	89.91'	45.34'
15	23°50'28"	282.00'	117.34'	59.53'
16	04°10'02"	282.00'	20.51'	10.26'
17	01°43'23"	318.00'	9.58'	4.78'
18	11°39'42"	318.00'	64.72'	32.47'
19	11°40'06"	318.00'	64.76'	32.49'
20	08°33'40"	318.00'	53.07'	26.59'
21	07°00'00"	282.00'	31.42'	20.00'

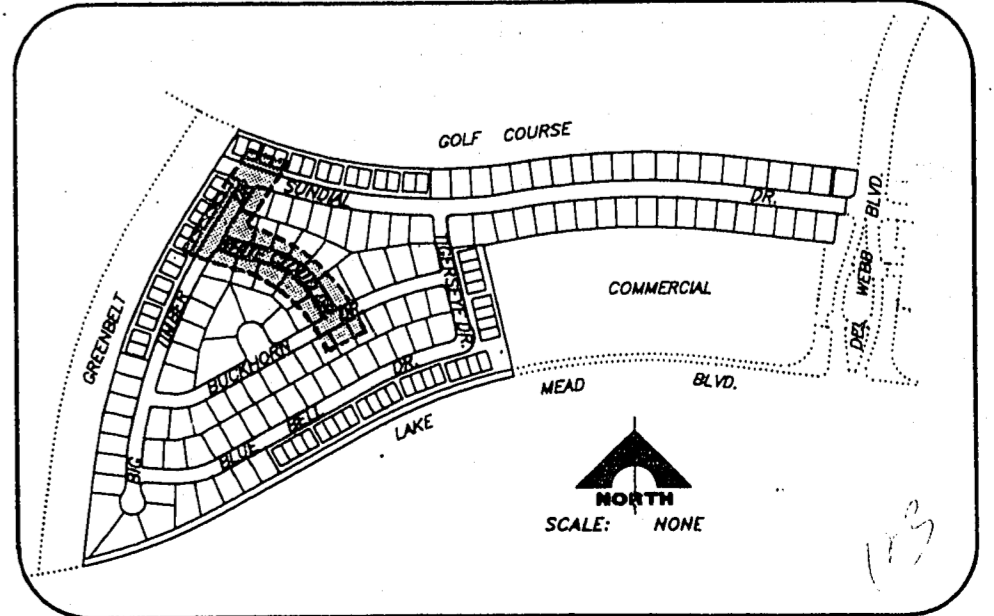

RECOMMENDED
 MICHAEL D. ROSS
 ENGINEER
 STATE OF NEVADA
 CIVIL
 1555 SOUTH RAINBOW BLVD. LAS VEGAS, NEVADA 89102

G.C. WALLACE, INC.
 Engineering/Architecture

DEL E. WEBB COMMUNITIES, INC.
 SUN CITY LAS VEGAS UNIT NO. 23
 WHITE CLOUD DRIVE
 & BIG TIMBER DRIVE

SHEET
18
 OF 26 SHEETS

JOB NO. 701.093

As Built 307Y-4141-23