



PROFILE  
SCALE: HORIZ. 1" = 40'  
VERT. 1" = 4'

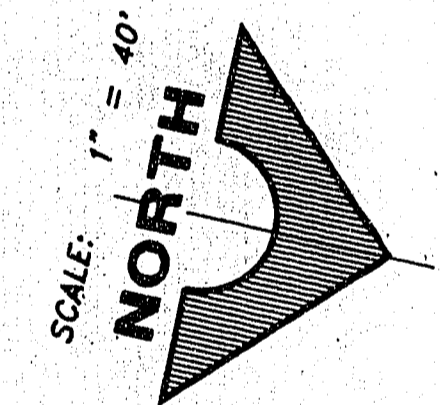

**SEWER LINE TABLE**


LINE	BEARING	DISTANCE
4	S 84°18'37" W	299.78'
5	N 85°12'27" W	341.26'
13	S 0°00'52" E	92.08'
14	S 12°57'55" E	170.42'
15	S 77°02'05" W	244.24'
16	S 62°21'56" W	200.34'
24	S 12°57'55" E	238.79'
25	S 70°16'36" W	310.20'

APPROVED FOR CONSTRUCTION  
DEL WEBB COMMUNITIES, INC. DATE

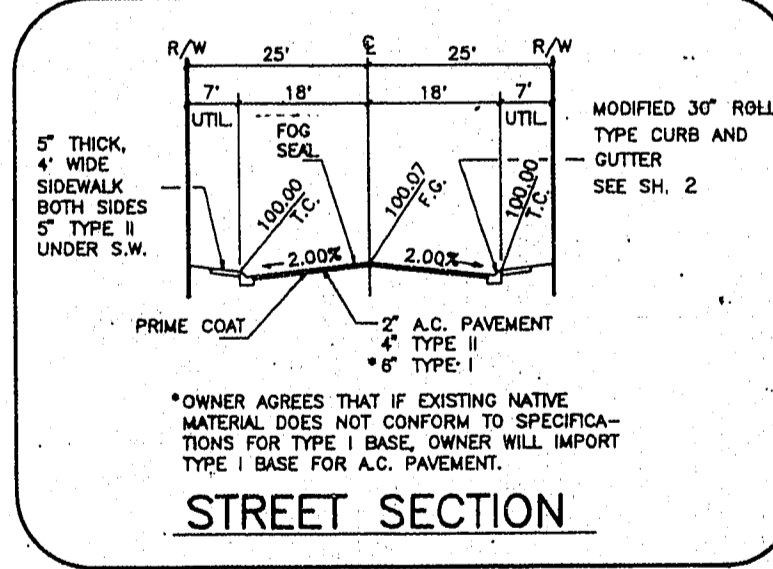

**CURVE DATA**

CURVE	DELTA	RADIUS	LENGTH	TANGENT
1	15°19'54"	1175.00'	314.41'	158.15'
2	15°19'54"	1193.00'	319.23'	160.57'
3	16°02'05"	1157.00'	323.80'	162.96'
4	03°17'32"	1193.00'	68.55'	34.28'
5	02°49'56"	1193.00'	58.97'	29.49'
6	11°43'12"	53.00'	106.03'	52.59'
7	89°17'48"	53.00'	85.72'	54.33'
8	89°17'48"	37.00'	57.67'	36.55'
9	24°37'12"	57.00'	24.49'	12.44'
10	30°00'00"	20.00'	31.42'	20.00'
11	16°02'05"	1000.00'	278.86'	140.85'
12	16°02'05"	982.00'	274.82'	139.32'
13	16°02'05"	1018.00'	284.90'	143.39'
14	04°30'17"	982.00'	72.21'	38.62'
15	00°00'54"	982.00'	0.26'	0.13'
16	04°23'35"	1018.00'	78.05'	39.05'
17	04°23'37"	1018.00'	78.08'	39.05'
18	02°58'29"	1018.00'	16.72'	8.36'
19	12°50'02"	400.00'	89.60'	44.99'
20	12°50'02"	382.00'	85.57'	42.99'
21	12°50'02"	418.00'	93.63'	47.01'
22	06°53'24"	418.00'	6.49'	3.25'
23	11°56'39"	418.00'	87.14'	43.73'

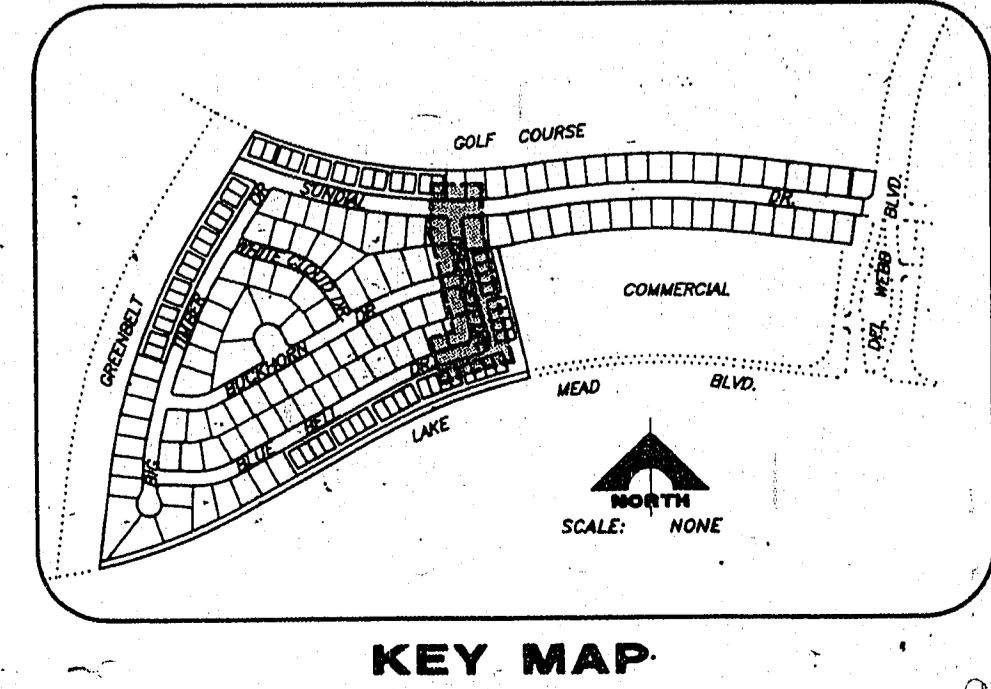

METER CHARGES AND CAPACITY CONNECTION CHARGES FOR LOTS 27 AND 28, BLOCK 1 AND LOTS 27 AND 28, BLOCK 5 WILL NOT BE COLLECTED. LATERALS OR METERS ALLOWED TO BE INSTALLED UNTIL THE TEMPORARY WATER LINE BETWEEN THESE LOTS ARE CUT AND CAPPED AS SHOWN ON SHEETS 6 AND 10 OF 26 SUN CITY SUMMERLIN UNIT 23.

NOTE:  
UNITS 26, 27 & 28 WILL NOT BE CONSTRUCTED UNTIL 2880 ZONE PIPELINE IS IN PLACE, OPERATIONAL AND THIS LINE IS ABANDONED.

RECOMMENDED BY: MICHAEL D. ROSS, P.E., CIVIL ENGINEER  
DATE: 3/17/14  
SHEET 16 OF 26 SHEETS

DEL E. WEBB COMMUNITIES, INC.  
SUN CITY LAS VEGAS UNIT NO. 23  
TIGERSEYE DR., BLUE BELL DR. & BUCKHORN DR.

G.C. WALLACE, INC.  
Engineering/Architecture  
1555 SOUTH RAINBOW BLVD. LAS VEGAS, NEVADA 89102

JOB NO. 701.093

As Built 3071-4/4/-23