

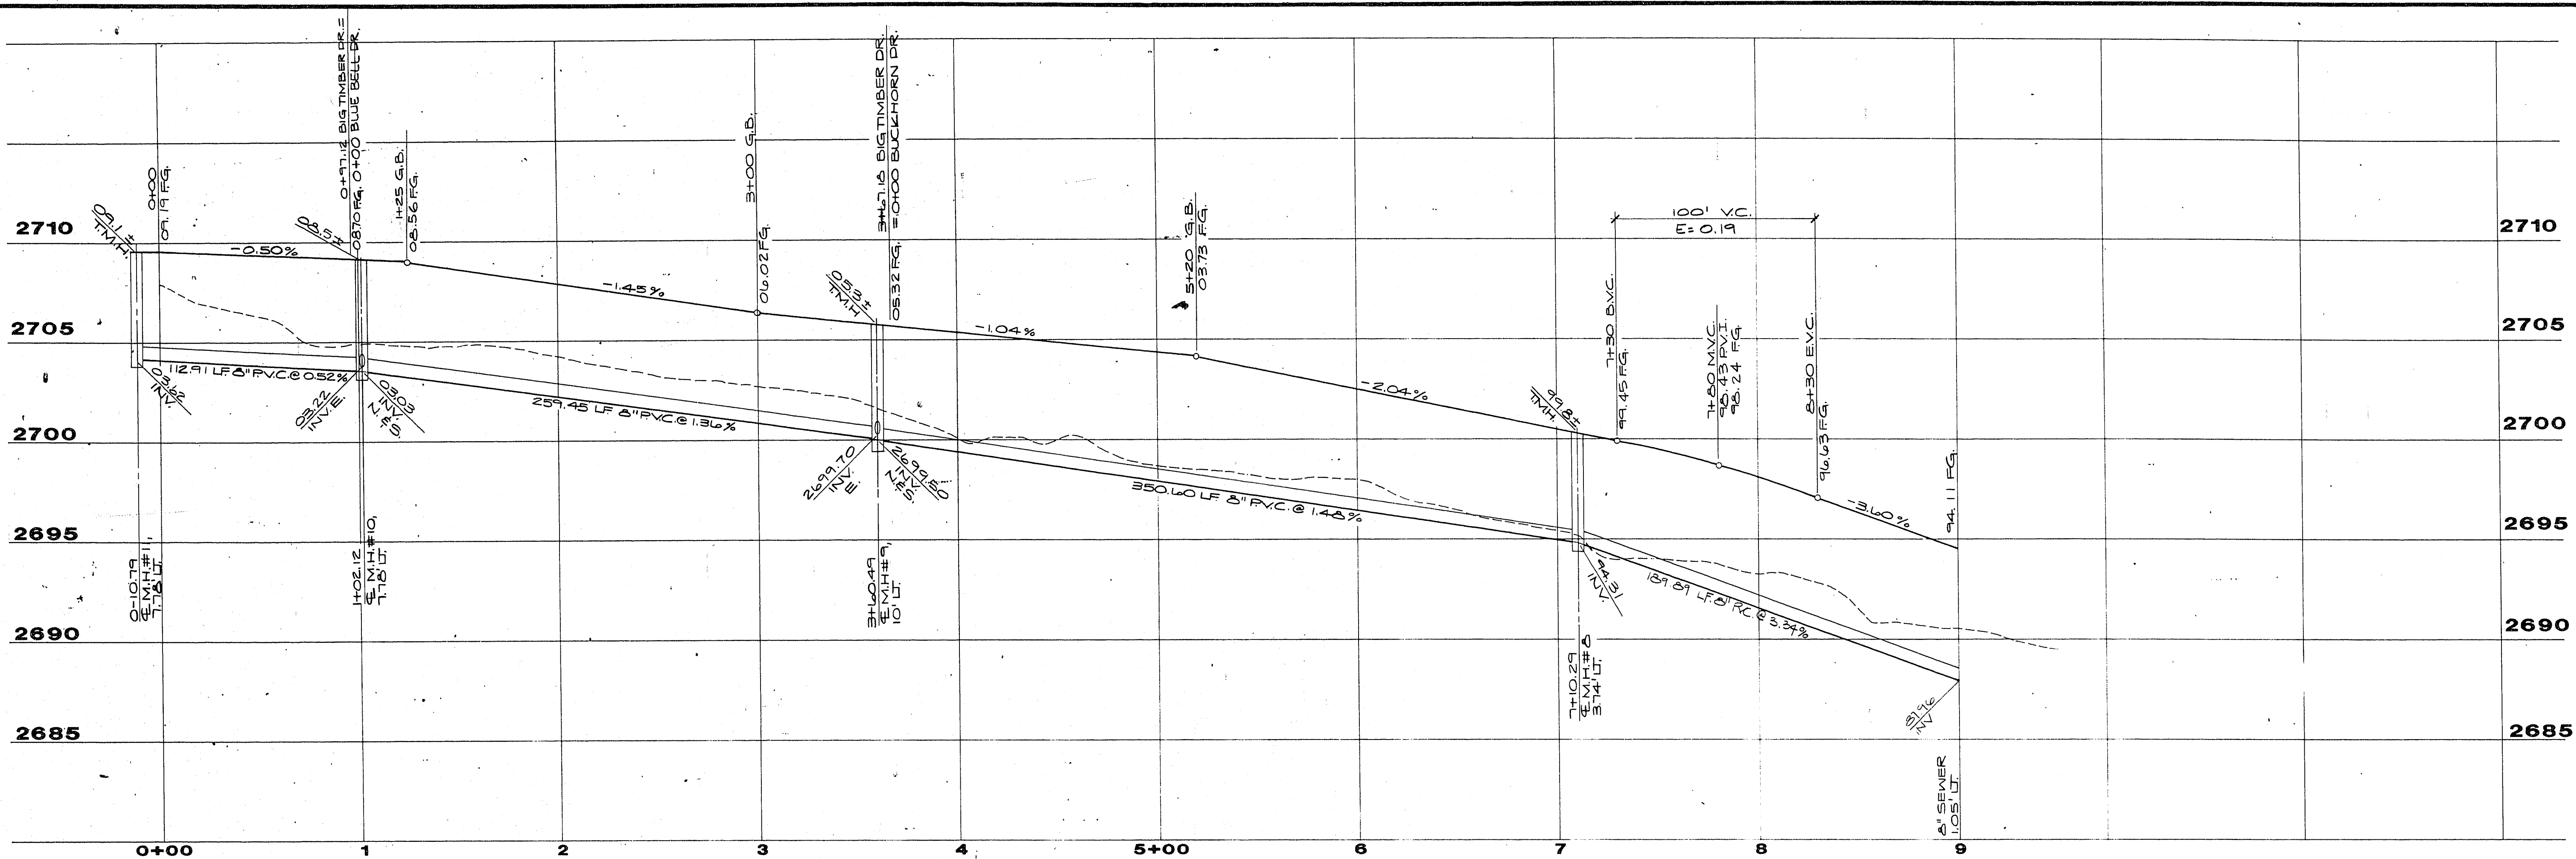


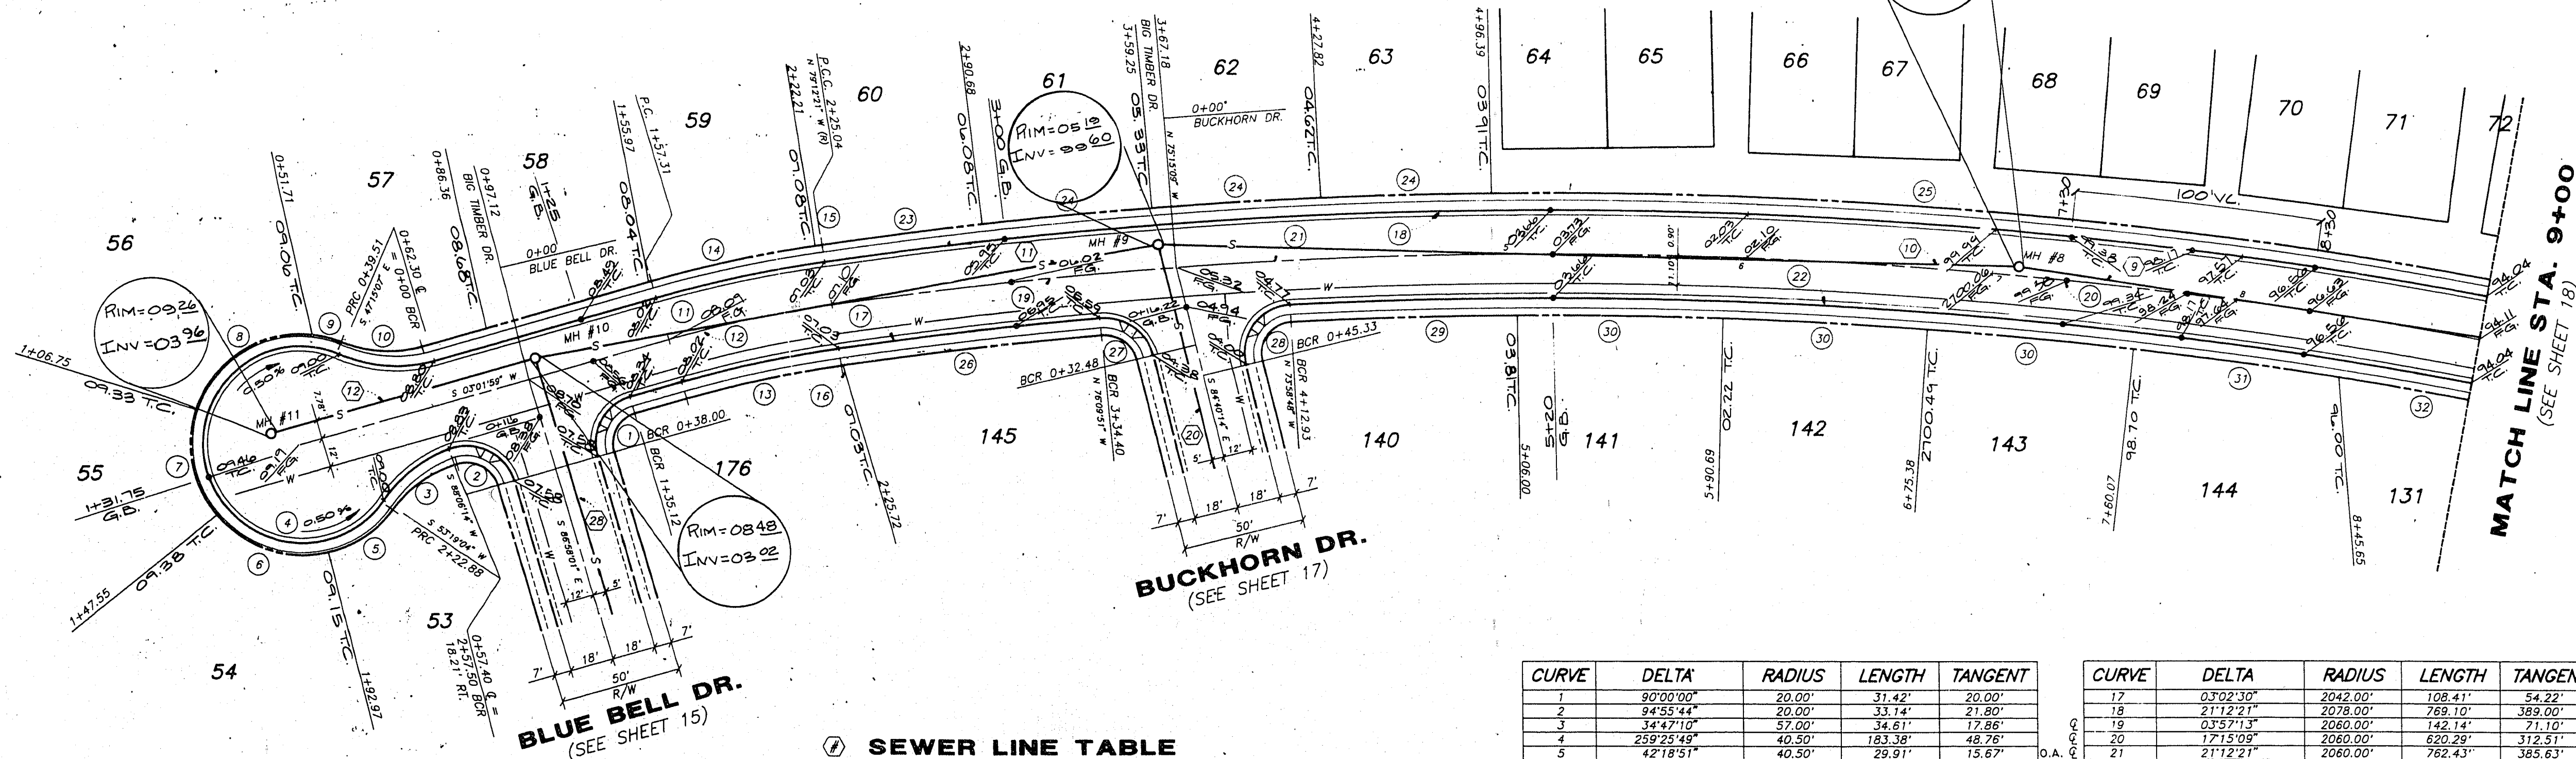

PROFILE

SCALE: HORIZ. 1" = 40'
VERT. 1" = 4'

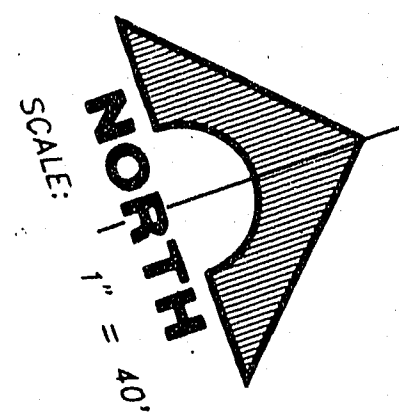



SEWER LINE TABLE

LINE	BEARING	DISTANCE
9	S 27°44'31" W	268.16'
10	S 20°26'42" W	350.60'
11	S 08°37'08" W	259.45'
12	S 03°01'59" W	112.91'
20	N 84°40'14" W	156.21'
28	N 86°58'01" W	249.97'

CURVE	DELTA	RADIUS	LENGTH	TANGENT
1	90°00'00"	20.00'	31.42'	20.00'
2	94°55'44"	20.00'	33.14'	21.80'
3	34°47'10"	57.00'	34.61'	17.86'
4	259°25'49"	40.50'	183.38'	46.76'
5	42°18'51"	40.50'	29.91'	15.67'
6	64°15'41"	40.50'	45.42'	25.44'
7	97°43'32"	40.50'	40.80'	22.32'
8	77°51'51"	40.50'	55.04'	32.72'
9	17°15'55"	40.50'	12.20'	6.15'
10	39°42'54"	57.00'	39.51'	20.59'
11	07°45'40"	518.00'	70.17'	35.14'
12	07°45'40"	500.00'	67.73'	33.92'
13	07°45'40"	482.00'	65.29'	32.70'
14	07°28'14"	518.00'	67.24'	33.67'
15	00°19'25"	518.00'	2.53'	1.46'
16	00°01'08"	2042.00'	0.68'	0.34'

CURVE	DELTA	RADIUS	LENGTH	TANGENT
17	03°02'30"	2042.00'	108.41'	54.22'
18	21°12'21"	2078.00'	769.10'	389.00'
19	03°57'13"	2080.00'	142.14'	71.10'
20	17°15'09"	2080.00'	620.29'	312.51'
21	21°12'21"	2080.00'	762.43'	385.63'
22	14°54'11"	2042.00'	531.14'	267.08'
23	01°49'12"	2078.00'	66.21'	33.11'
24	01°54'25"	2078.00'	69.17'	34.59'
25	13°39'31"	2085.00'	497.04'	249.70'
26	03°01'22"	2042.00'	107.21'	53.88'
27	81°28'16"	2080.00'	28.45'	12.23'
28	100°41'27"	20.00'	35.15'	24.13'
29	02°35'19"	2042.00'	92.26'	46.14'
30	02°21'20"	2042.00'	83.95'	41.98'
31	02°22'49"	2042.00'	84.83'	42.82'
32	02°52'03"	2042.00'	102.19'	51.11'

APPROVED FOR CONSTRUCTION
DEL WEBB COMMUNITIES, INC. DATE

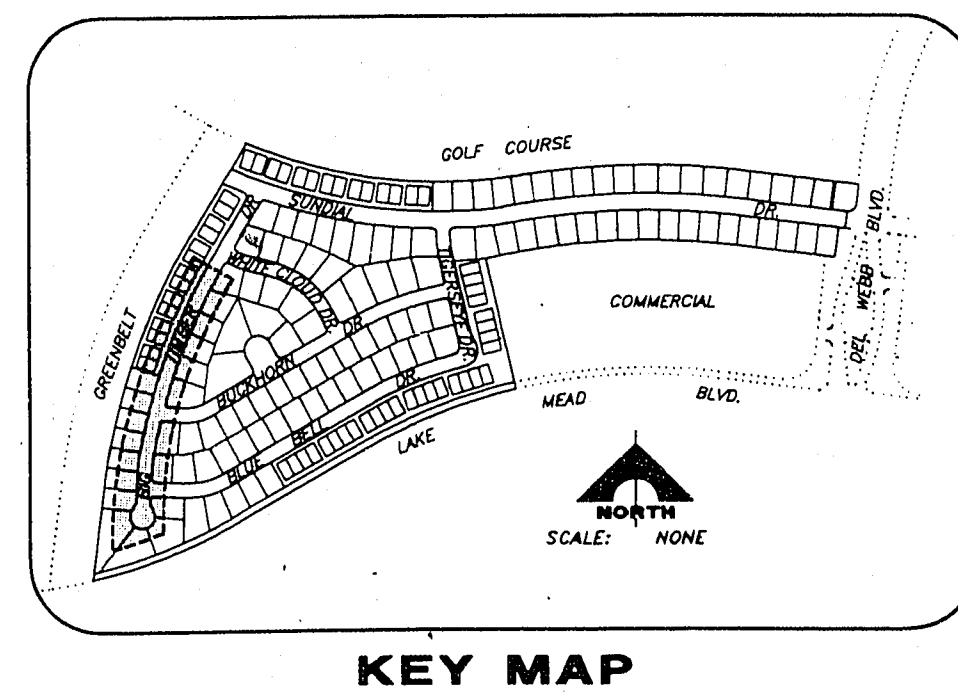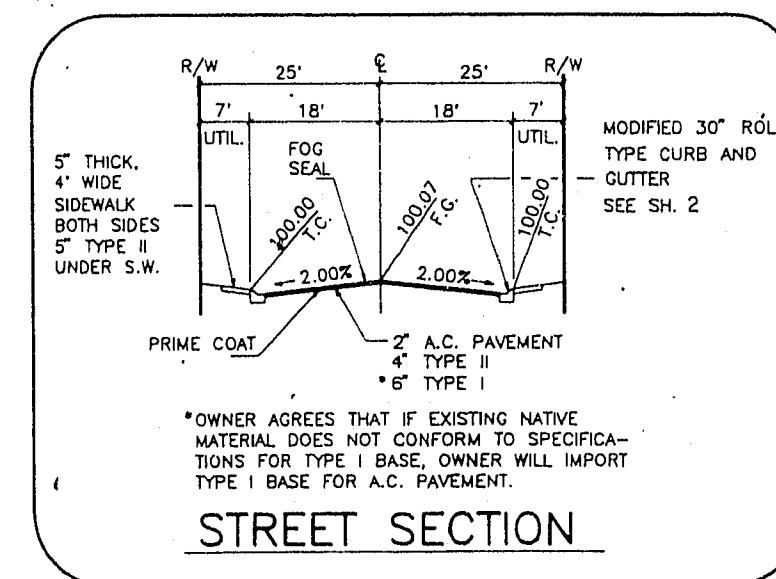

RECOMMENDED BY: [Signature] DATE: 08/18/2024
MICHAEL D. PROSSER, P.E.
G.C. WALLACE, INC.
Engineering/Architecture
1555 SOUTH RAINBOW BLVD / LAS VEGAS, NEVADA 89102

DEL E. WEBB COMMUNITIES, INC.
SUN CITY LAS VEGAS UNIT NO. 23
BIG TIMBER DRIVE

SHEET
14
OF 26 SHEETS

As Built 3094-4/41-23