
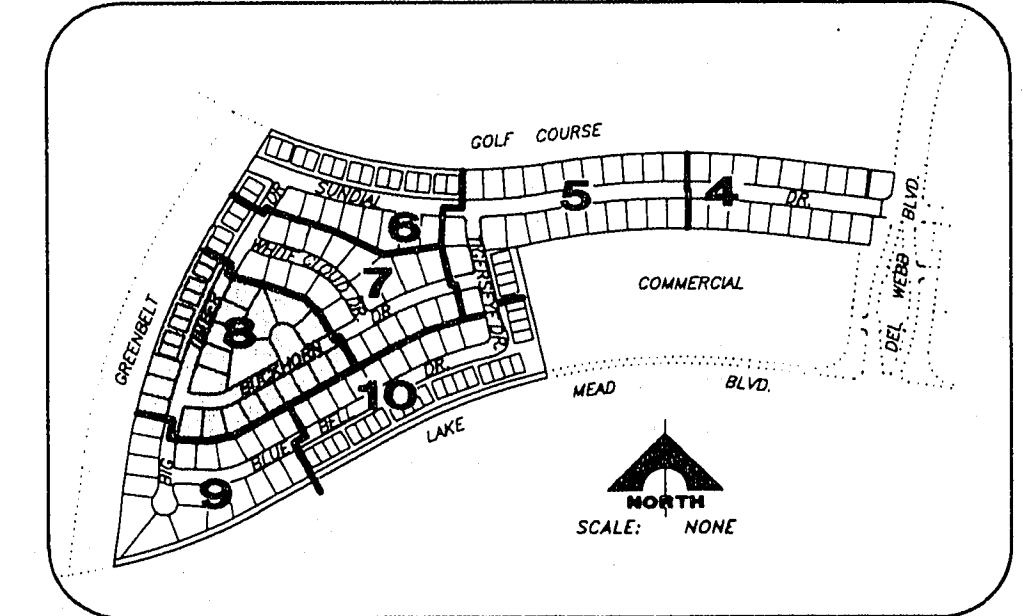
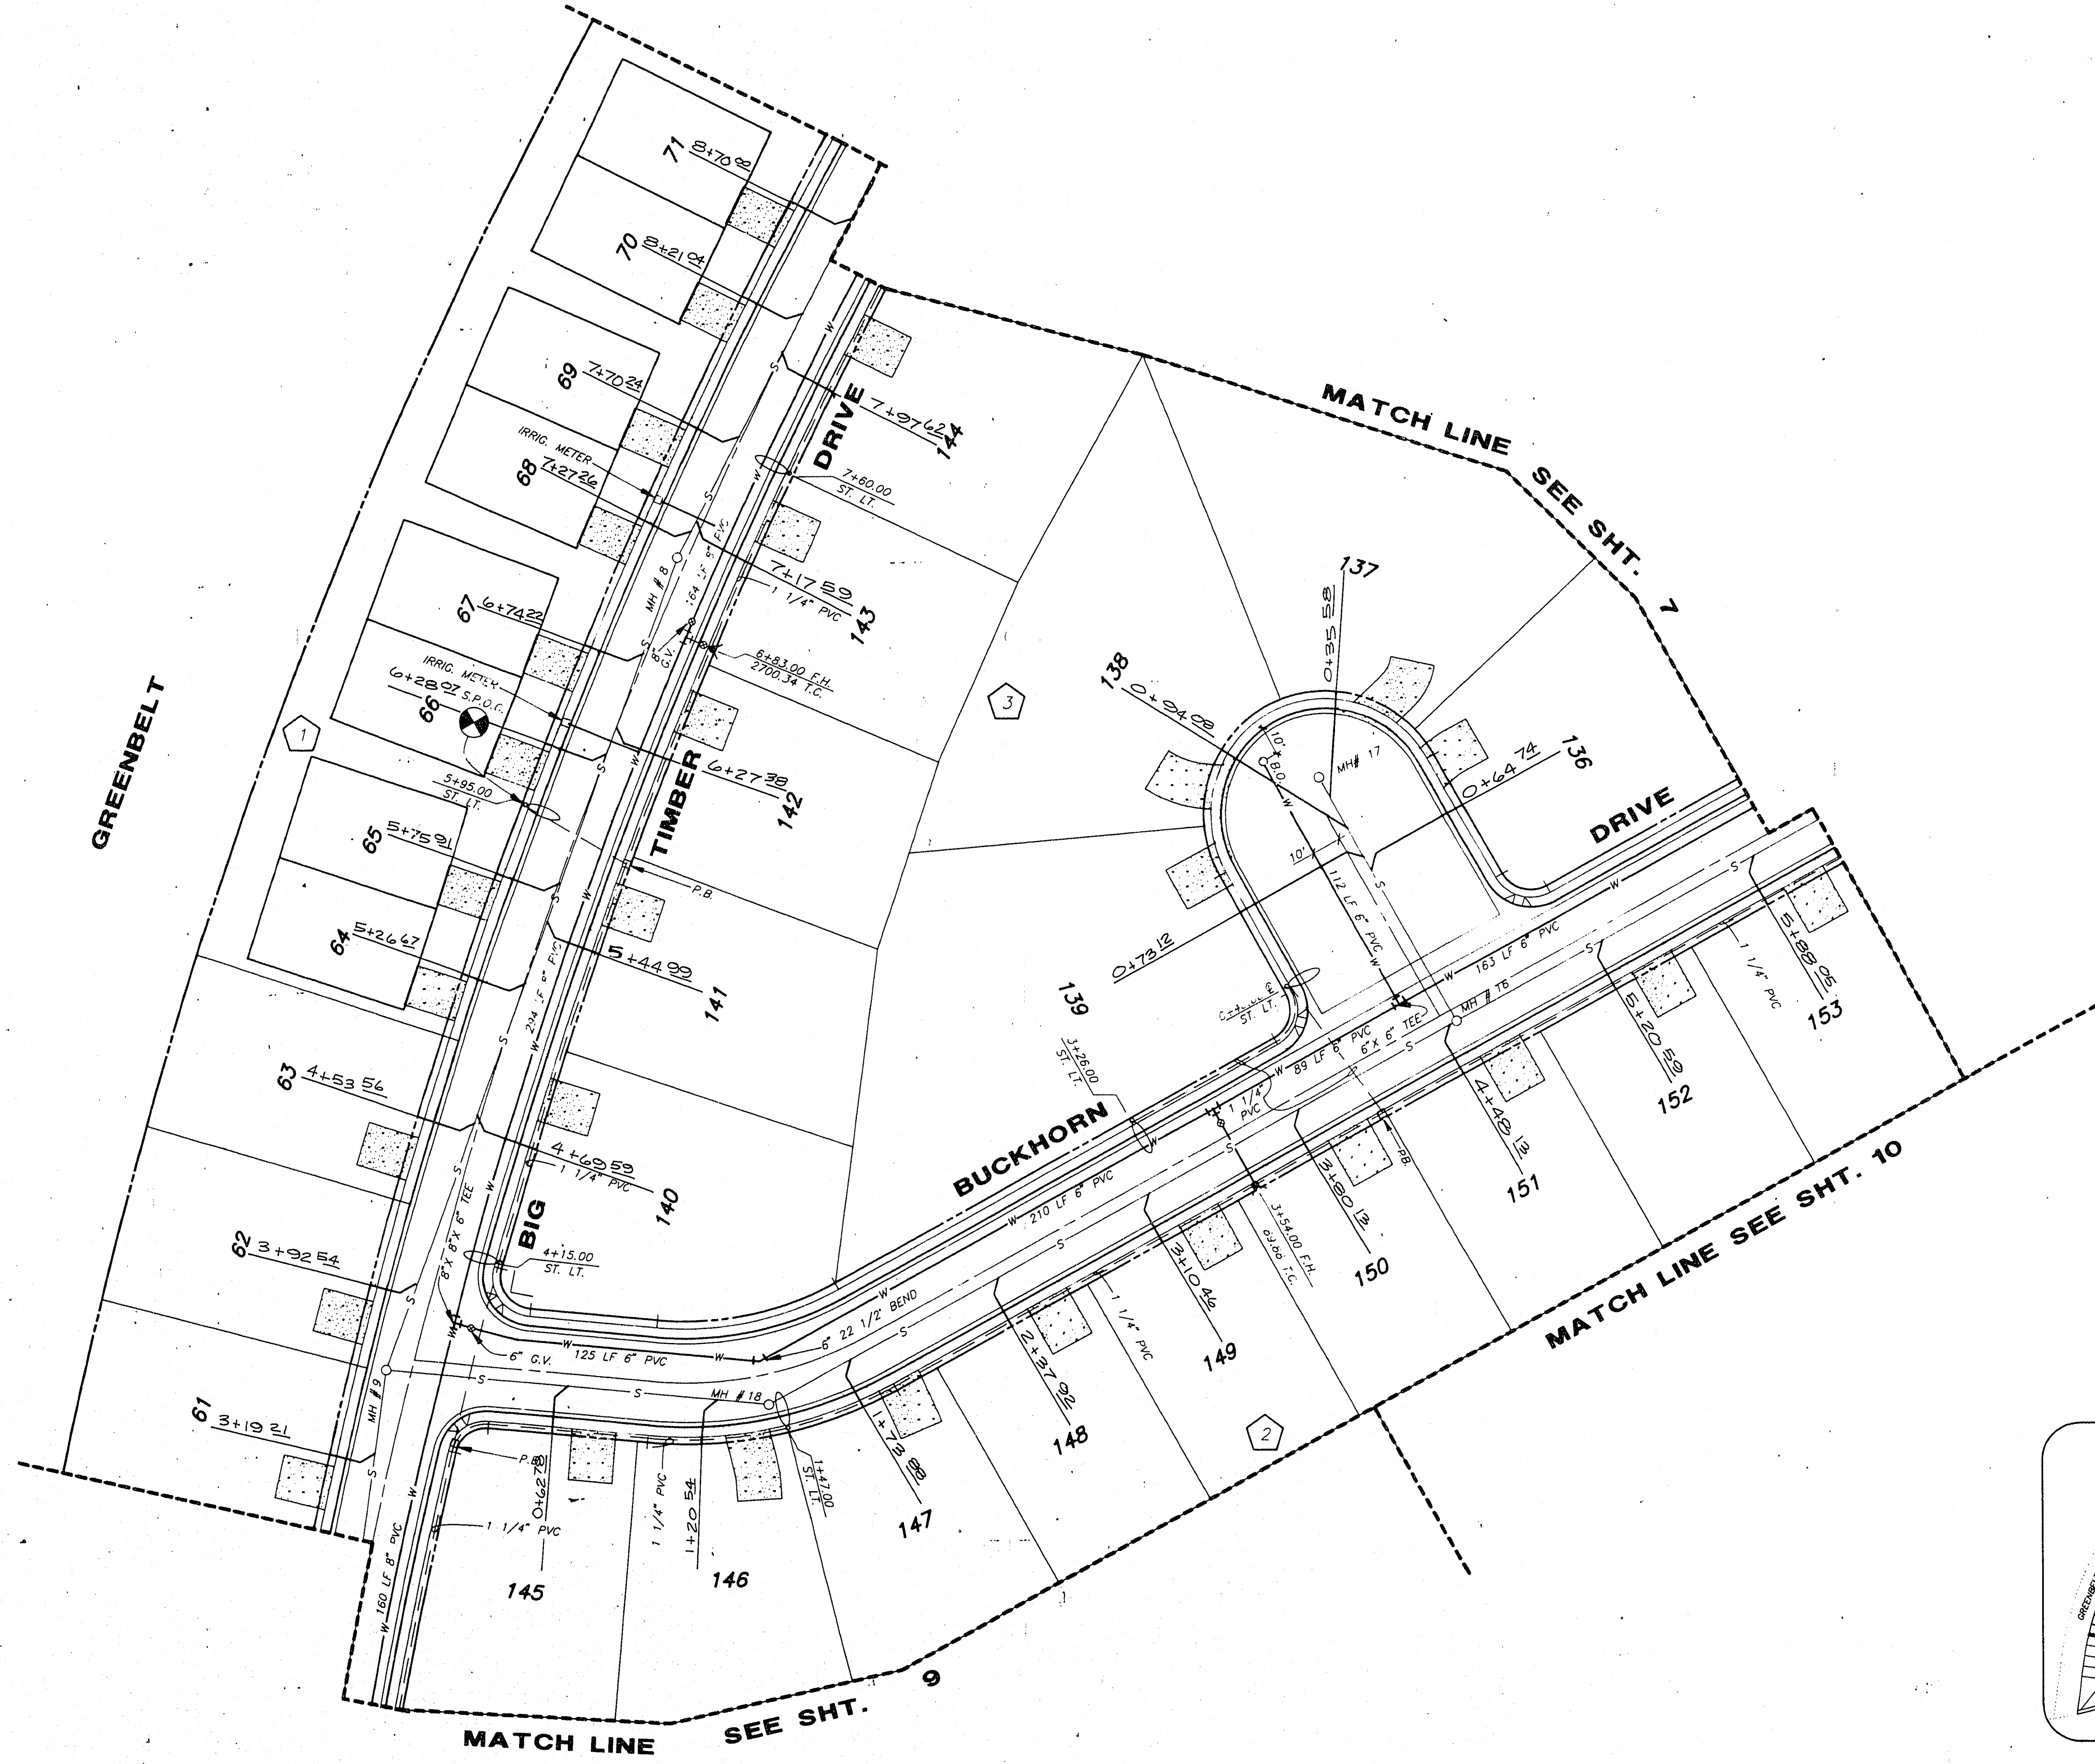


JOB NO. 701.093

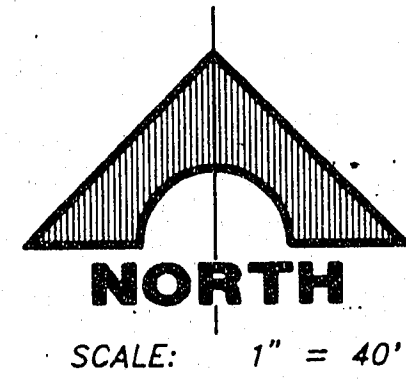

KEY MAP

APPROVED FOR CONSTRUCTION
DEL WEBB COMMUNITIES, INC. DATE

APPROVED FOR CONSTRUCTION
11-15-90
LAS VEGAS WATER DISTRICT DATE

DESCRIPTION	
RECOMMENDED	DATE
MICHAEL D. ROSE	DATE
G.C. WALLACE, INC. Engineering/Architecture 1555 SOUTH RAINBOW BLVD. LAS VEGAS, NEVADA 89102	
DEL E. WEBB COMMUNITIES, INC. SUN CITY LAS VEGAS UNIT NO. 23	
UTILITY PLAN V	
SHEET 8 OF 28 SHEETS	

As Built 3074-4/4-23