

ALL VALVES TO BE ABANDONED SHALL BE ABANDONED IN THE CLOSED POSITION, UNLESS SHOWN OTHERWISE BY REMOVING A MINIMUM OF THE TOP 12 INCHES OF THE VALVE BOX AND THEN FILLING THE REMAINING PORTION OF THE VALVE BOX WITH CONCRETE HAVING A COMPRESSIVE STRENGTH OF AT LEAST 2000 PSI. THE CONTRACTOR SHALL THEN BACKFILL AND REPAVE THE AREA DISTURBED DURING ABANDONMENT OF THE VALVE IN ACCORDANCE WITH THE MOST CURRENT DRAFT OR EDITION OF THE UNIFORM STANDARD SPECIFICATIONS FOR PUBLIC WORKS CONSTRUCTION OFFSITE IMPROVEMENTS CLARK COUNTY AREA.

THE CONTRACTOR SHALL CUT THE EXISTING PIPE 3' + BEYOND THE ABANDONED VALVE AND INSTALL A CAP, WHERE A JOINT OR COUPLING IN THE EXISTING PIPE IS UNCOVERED AT THE CUT AND CAP LOCATION. THE INSTALLATION OF A PLUG MAY BE PERMITTED, WITH DISTRICT APPROVAL. THE CONTRACTOR SHALL INSTALL A CONCRETE THRUST BLOCK IN ACCORDANCE WITH THE PROVISIONS OF THE DISTRICT'S STANDARD PLATE NO. 5 AT ALL CAP OR PLUG LOCATIONS.

NOTE:
LOTS 26, 27 & 28 WILL NOT BE CONSTRUCTED UNTIL 2860 ZONE PIPELINE IS IN PLACE, OPERATIONAL AND THIS LINE IS ABANDONED.

30' TEMPORARY UTILITY EASEMENT
TEMPORARY EXIST. 8" WATERLINE INSTALLED WITH UNIT 22, LINE MUST BE ABANDONED PRIOR TO CONSTRUCTION OF LOTS 26, 27 & 28

SEE SHT. 2 OF 2 UNIT 22 OFFSITE WATER PLANS.


METER CHARGES AND CAPACITY CONNECTION CHARGES FOR LOTS 27 AND 28, BLOCK 1 AND LOTS 87 AND 88, BLOCK 5 WILL NOT BE COLLECTED. MATERIALS OR METERS ALLOWED NOT TO BE INSTALLED UNTIL THE LATERALS ARE ABANDONED AND SHOWN ON THE SUBSEQUENT SHEET.

NOTE A:
REMOVE EXISTING A.C. PAVEMENT IN ITS ENTIRETY AND REPLACE WITH NEW 2" THICK A.C. PAVEMENT AND 4" COMPACTED TYPE II BASE COURSE, IF EXISTING SERVICE LATERALS HAVE TO BE RELOCATED.

NOTE A:
REMOVE EXISTING A.C. PAVEMENT IN ITS ENTIRETY AND REPLACE WITH NEW 2" THICK A.C. PAVEMENT AND 4" COMPACTED TYPE II BASE COURSE, IF EXISTING SERVICE LATERALS HAVE TO BE RELOCATED.

NOTE:
THESE UNITS WILL NOT BE CONSTRUCTED UNTIL 2860 ZONE PIPELINE IS IN PLACE, OPERATIONAL AND THIS LINE IS ABANDONED.

ABANDONMENT OF EXISTING SERVICE(S) 2" AND SMALLER
The Contractor shall notify the Inspection Division at the LVVWD (phone: 702/258-3227) 48 hours prior to the requested removal time to allow the District to take the final meter reading and remove the meter. The contractor shall then begin removal procedures for the affected service as follows:
Existing service laterals that are to be abandoned from existing water main shall have the corporation stops turned off at the main, the lateral cut 4" downstream from the corporation stop and again cut 6" downstream from the first cut so that a 6" piece of the existing service lateral is removed. If the corporation stop is damaged beyond repair or pulled from the existing water main, the main shall be repaired at the Contractor's expense, in a manner approved by the LVVWD. If the corporation stop is not water tight, the Contractor shall notify LVVWD Customer Service (phone: 870-4194) for further direction.

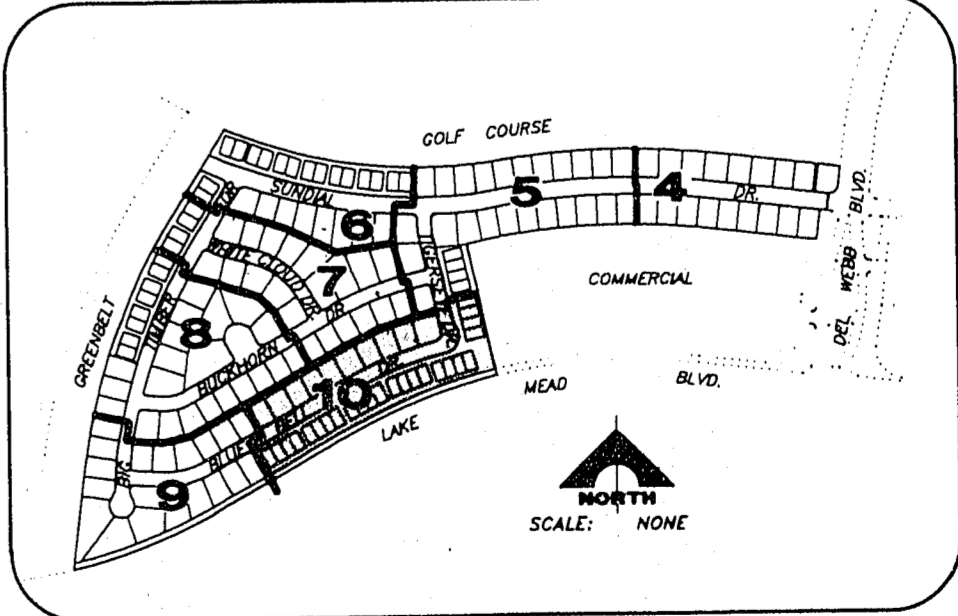

- LEGEND**
- (A) ABANDON EXISTING SEWER LATERAL.
 - (B) ABANDON EXISTING IRRIG. METER.

APPROVED FOR CONSTRUCTION
DEL WEBB COMMUNITIES, INC. DATE

APPROVED FOR CONSTRUCTION
REVISOR: [Signature] DATE: 5-14-91
REVISOR: [Signature] DATE: 11-05-90
LAS VEGAS WATER DISTRICT DATE

DESCRIPTION	REVISION	DATE
CHANGE TABLE TO SHEETS		
RECOMMENDED	DATE	
MICHAEL D. ROSS		
G.C. WALLACE, INC. Engineering/Architecture		
DEL E. WEBB COMMUNITIES, INC. SUN CITY LAS VEGAS UNIT NO. 23		
UTILITY PLAN VII		
SHEET 10		
OF 26 SHEETS		

JOB NO. 701.093

As Built 307Y-4141-23