


SUNSET ESTATES SEWER AS-BUILT MAP

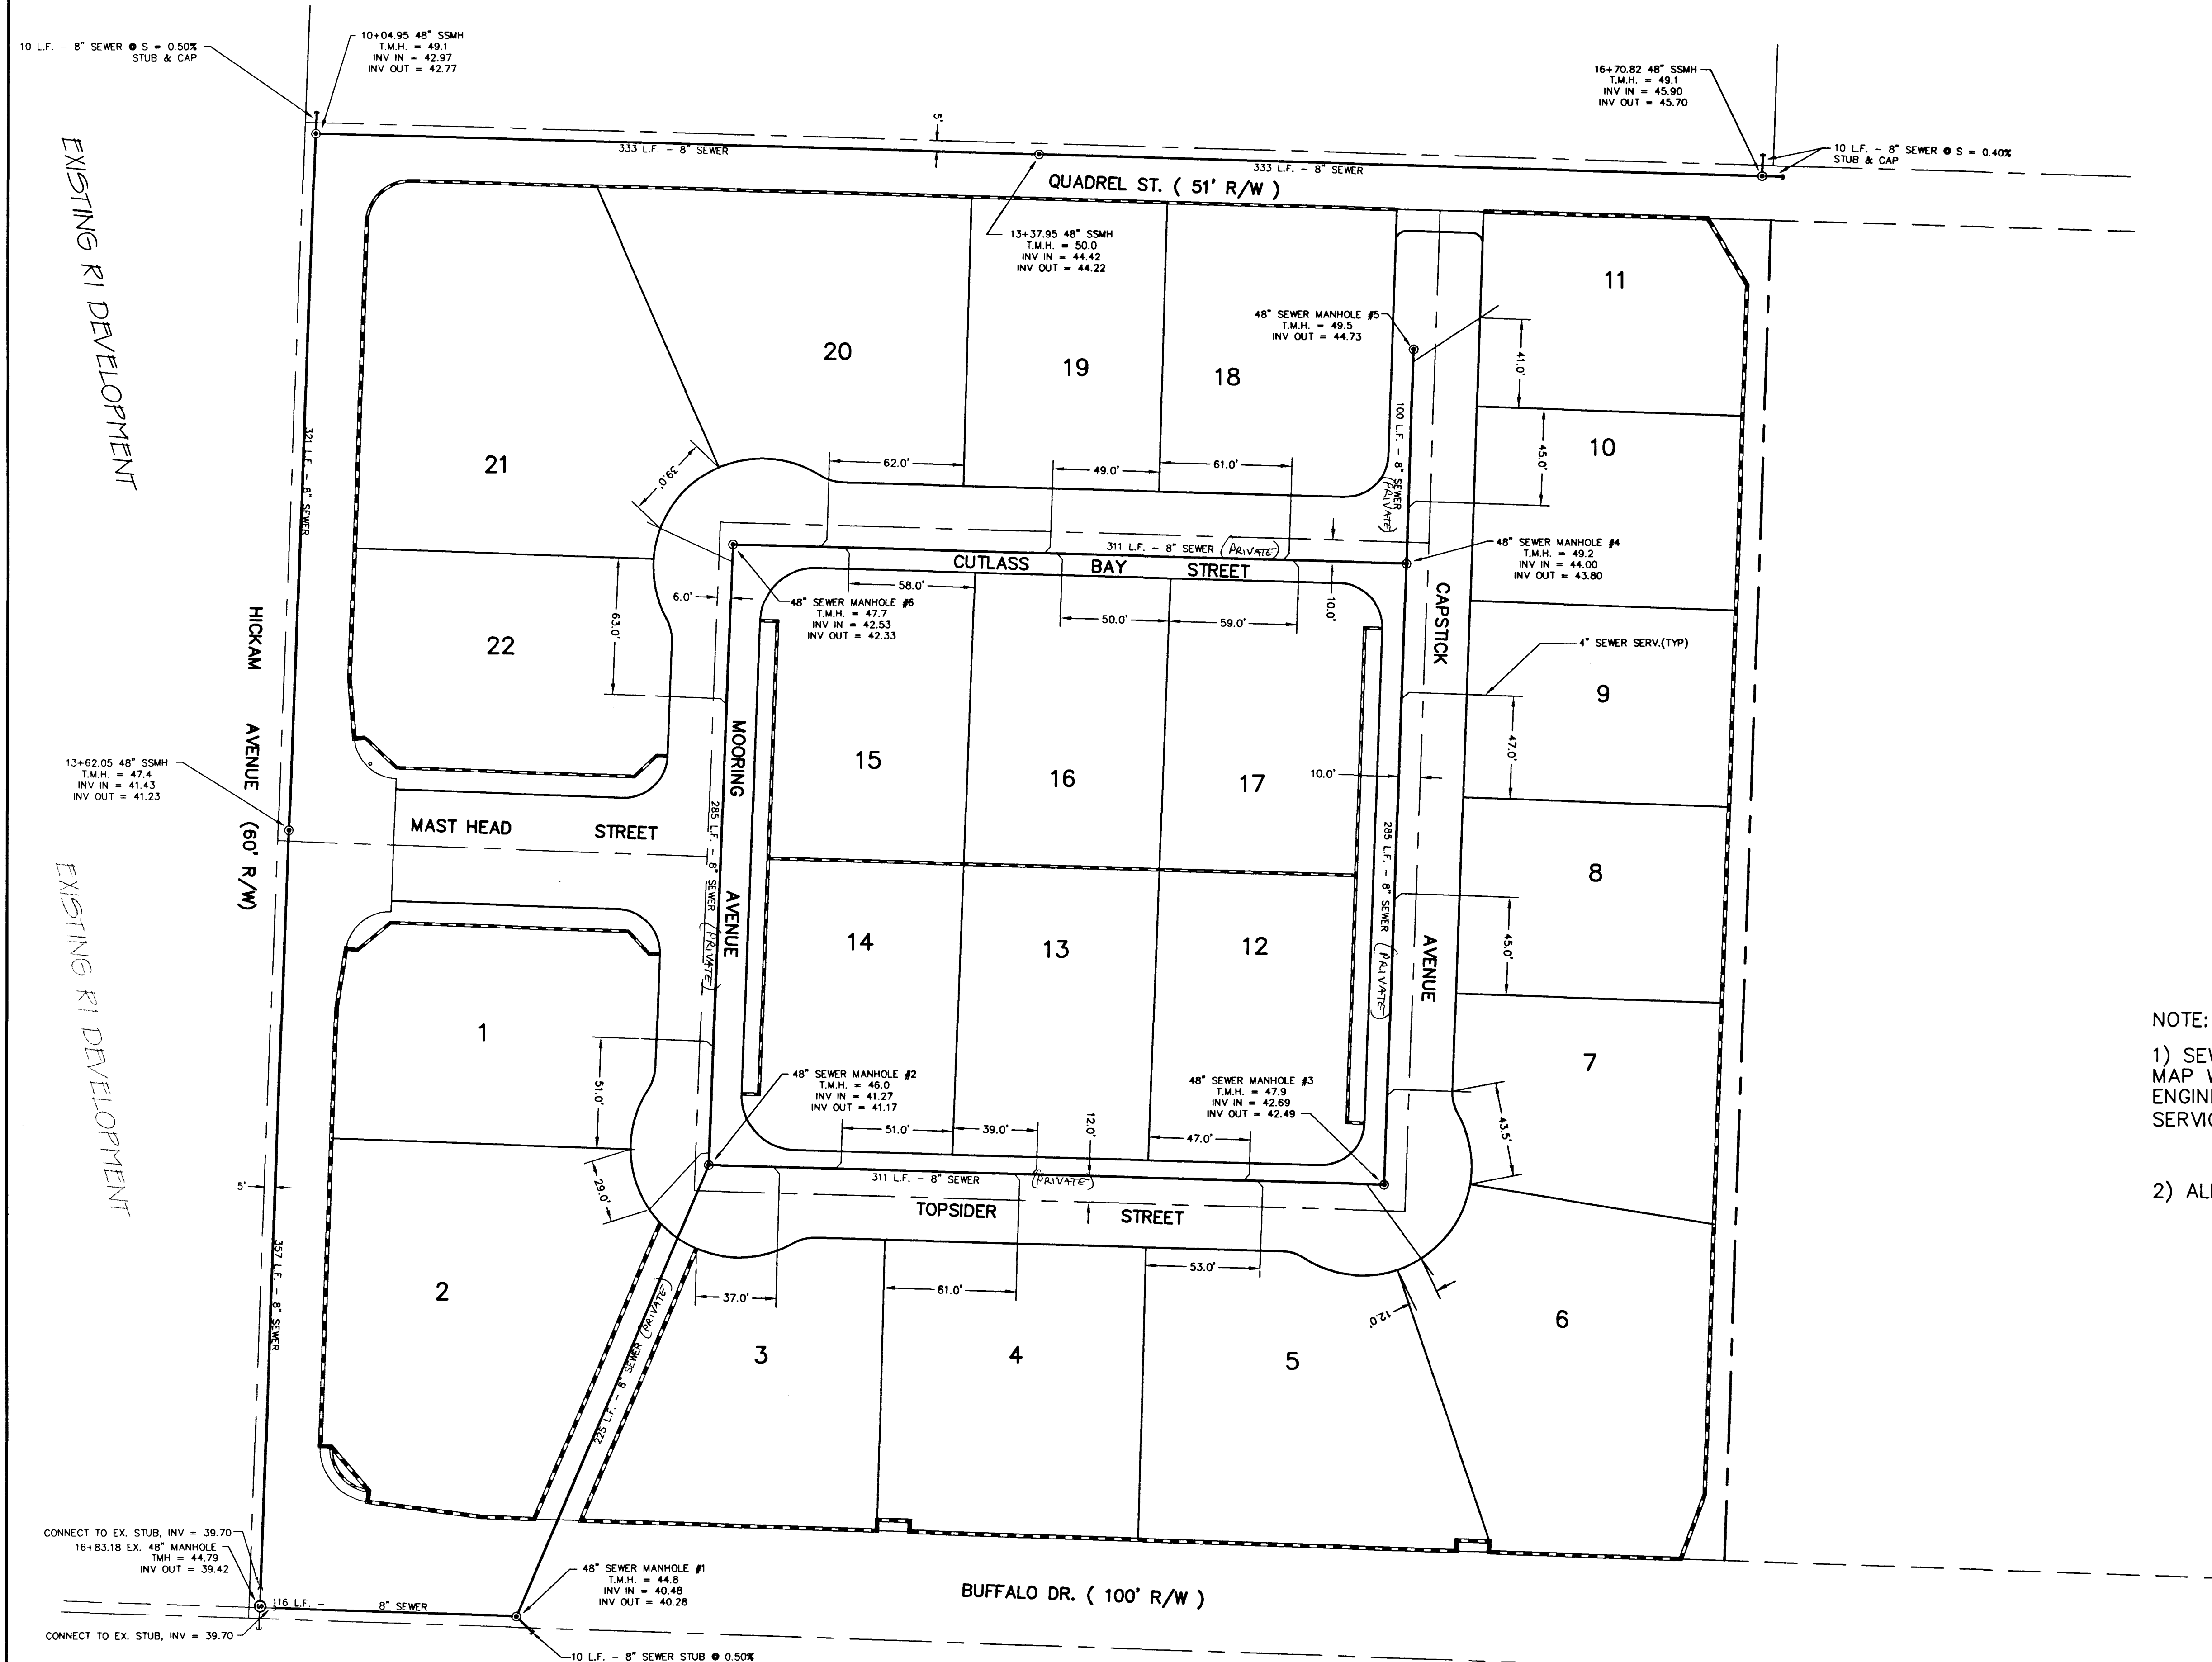

NOTE:

1) SEWER SERVICE LOCATIONS AS SHOWN ON THIS MAP WERE PROVIDED BY THE CONTRACTOR, ALPHA ENGINEERING ASSUMES NO LIABILITY FOR MISPLACED SERVICES REPRESENTED ON THIS MAP.

2) ALL SEWER MAIN MATERIALS SDR - 35.




ALPHA
ENGINEERING
COMPANY
5050 JAMES STREET, LOS ANGELES, CA 90007
TELEPHONE: (213) 877-1200

SEWER AS-BUILT MAP
SUNSET ESTATES

JOB # NS-86-05
NAME SMD
DATE 9-03-99
SCALE 1"=40'

PAGE
1

SUNSET ESTATES SEWER AS-BUILT MAP

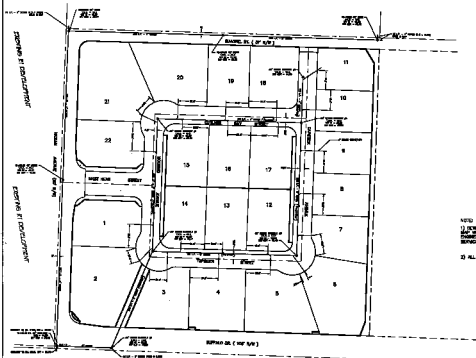

NOTE

1) SEWER SERVICE LOCATIONS AS SHOWN ON THIS MAP WERE PROVIDED BY THE CONVEYOR. ALPHA ENGINEERING ASSUMES NO LIABILITY FOR UNPLACED SERVICES REPRESENTED ON THIS MAP.

2) ALL SEWER MAIN MATERIALS 30" - 36".

SEWER AS-BUILT MAP

SUNSET ESTATES

1	2	3	4	5	6	7	8	9	10	11	12	13	14	15	16	17	18	19	20	21	22

