

**ALPHA & ENGINEERING COMPANY**  
 95 St. James Road, Little Ferry, N.J. 07643  
 Telephone: (201) 871-1300


PROJECT: **SUNSET ESTATES**  
 TITLE: **AS-BUILT (FLOWLINES) MIRAGE HOMES**

JOB NO: N5-86-05  
 NAME: NJ  
 DATE: 02-25-97  
 SCALE: SCALE: 1"=30'

PAGE: **1** of 1

APP 2/10/97

5026

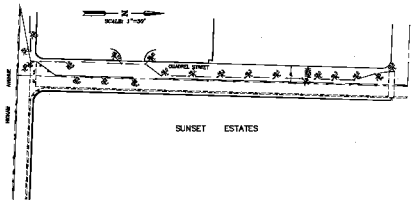

APP 7 (REV)

SUNSET ESTATES  
AS-BUILT (PLUMBING)  
MIRAGE HOMES

DATE	BY
DATE	BY
DATE	BY
DATE	BY

1