


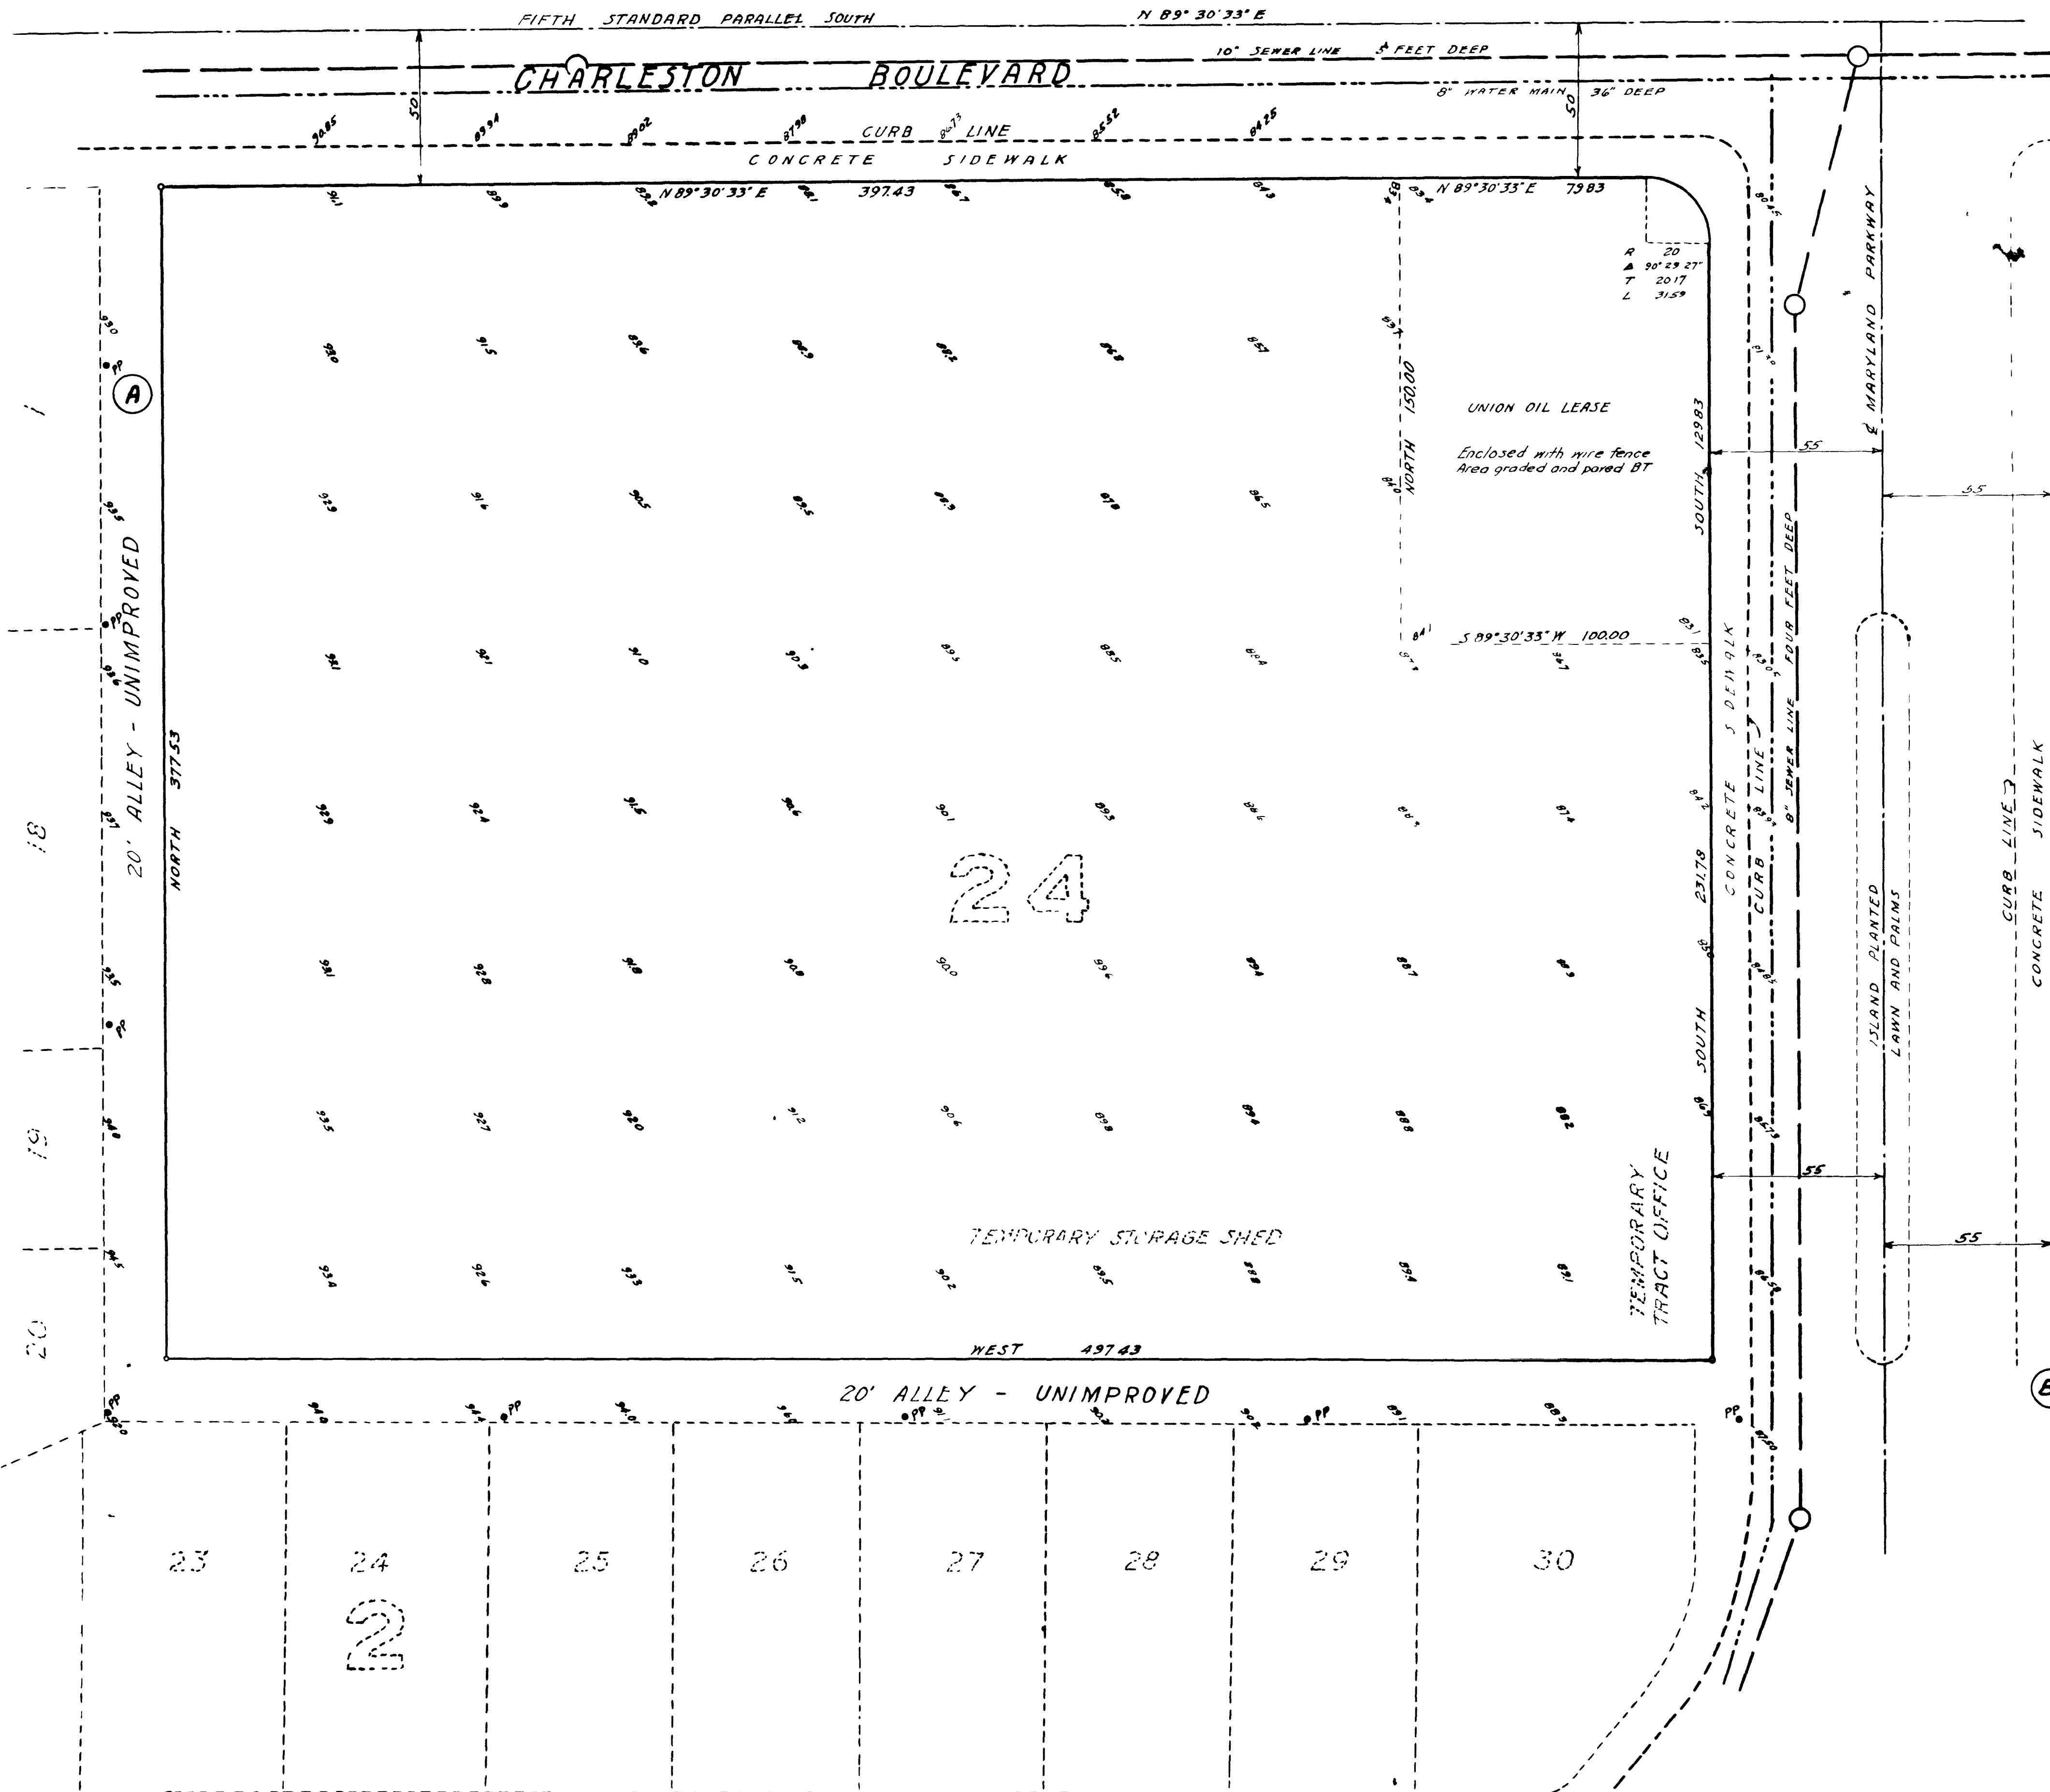

ENGINEER'S CERTIFICATE

I, F.M. Eaton, a duly Registered Civil Engineer and Land Surveyor in the State of Nevada, do hereby certify that this map truly and correctly represents the results of a survey made by me of Block 24, Huntridge Subdivision in the City of Las Vegas, Clark County, Nevada, at the instance of Thomas A. Hunt, Jr., owner of the property. The survey was made on the 25th day of October, 1959. It is not intended as a subdivision.

F.M. Eaton

REGISTERED CIVIL ENGINEER & LAND SURVEYOR - NEVADA 287

UTILITIES

WATER and SEWER - Location of each shown on Maryland Parkway and on Charleston Blvd.

ELECTRIC POWER - Southern Nevada Power Co. A line of poles along the south side and the west side of the alley on the south and west boundaries of Block 24. Poles marked "PP" - carries two circuits; a 30,000V 0-0 7200V 0-ground, and a secondary 220-110 suitable for services. Sufficient capacity for your needs.

TELEPHONE - Southern Nevada Telephone Co. Cables carried on same line of poles as noted for electric power. While service connections may be made anywhere along this line, it is preferred to take service near point A, where the lines emerge from an underground conduit.

GAS - Southwest Gas Corporation. Natural gas is available at residential pressure in 2" line ending at the SW corner Block 25 point B. Should your estimated requirement exceed the capacity of that line, a high pressure line on Charleston Boulevard may be tapped to supply any amount desired.

BUILDINGS - With the exception of the Service Station of the Union Oil Company, no buildings of a permanent nature are on the block. Others, as noted, are temporary structures subject to removal.

BASIS OF BEARINGS - Fifth Standard Parallel South accepted by City of Las Vegas. N 89° 30' 33" E.

RECORDERS' STAMPS

1450-20	1436-20
Dr. M. Eaton	Dr. M. Eaton
10-27-59 3:31pm	10-27-59 3:31pm
176	176
CLERK	CLERK
RECORDED	RECORDED
259	259

**RECORD SURVEY OF
BLOCK 24
HUNTRIDGE SUBDIVISION
LAS VEGAS - NEVADA**

SCALE 1" = 30' 055-155