


RAINBOW WEST - UNIT 1

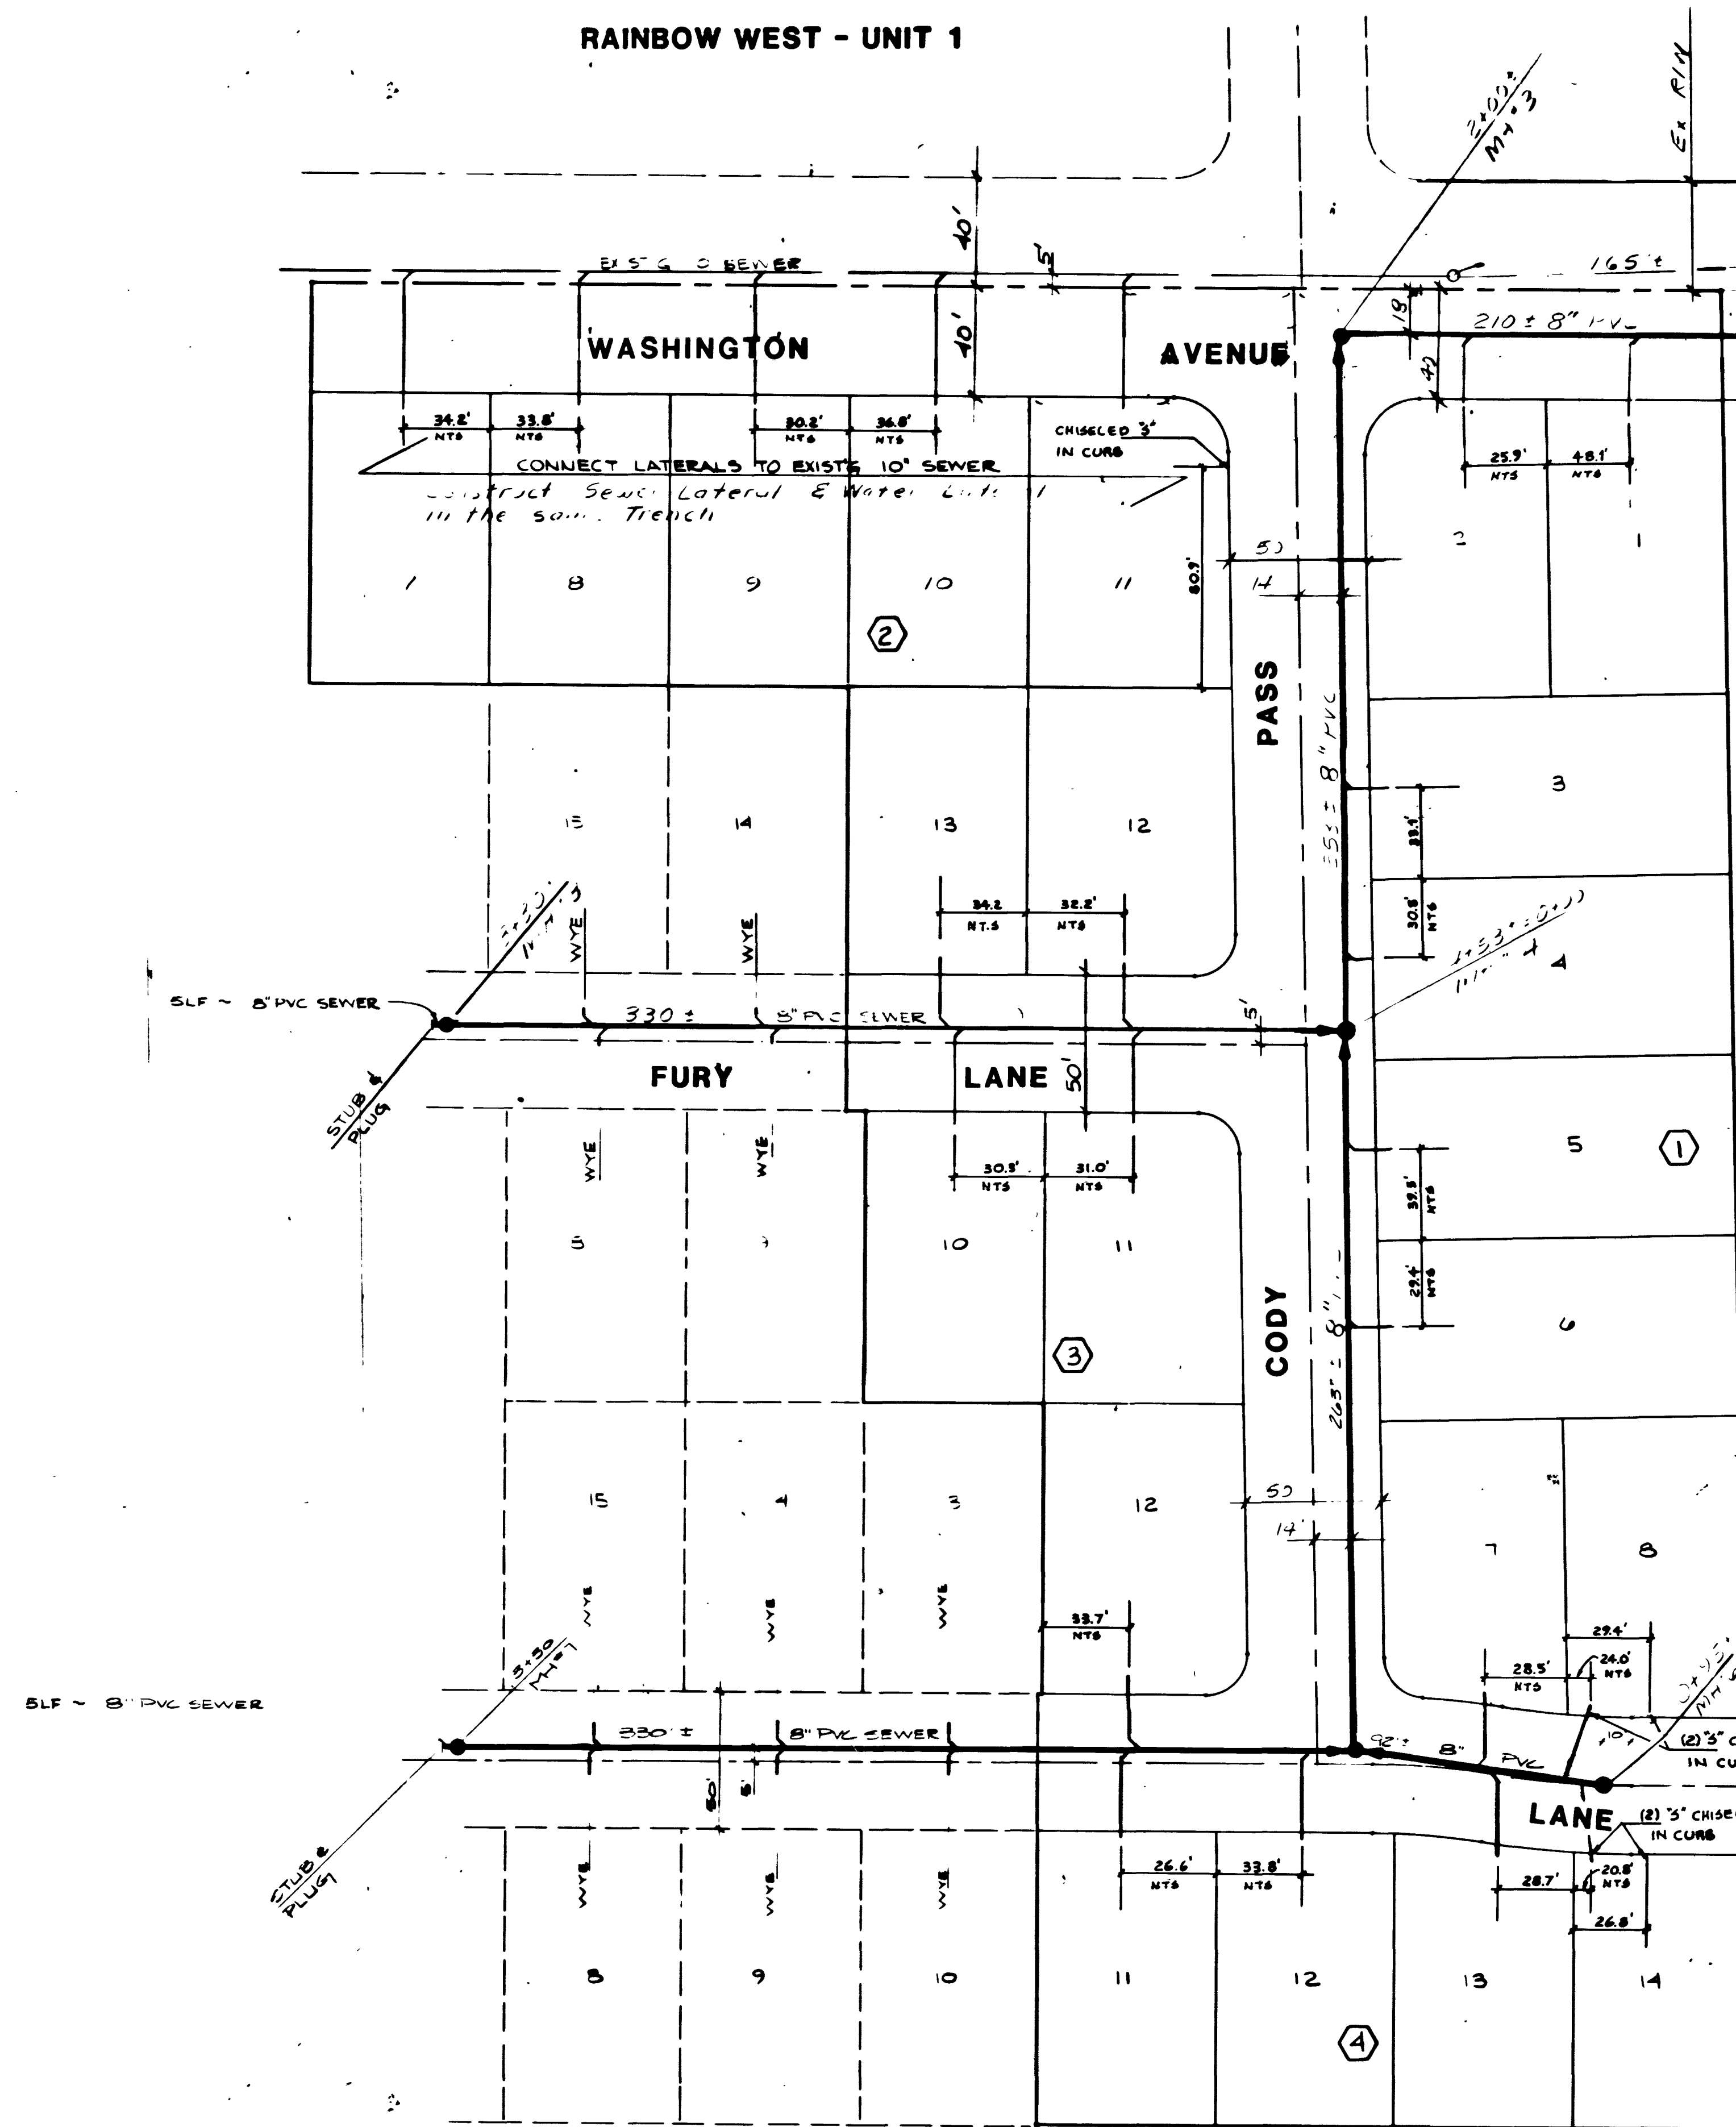

CLV GENERAL NOTES

1. HOUSE SERVICES SHALL COMPLY WITH BEST PRACTICES AS AN TO SEPARATION DISTANCE.
2. ALL HOUSES TO BE SERVED INDIVIDUALLY AS PER SECTION 13 OF THE UNIFORM PLUMBING CODE.
3. CONTRACTOR SHALL FURNISH THE ENGINEER WITH AS-BUILT DRAWINGS SHOWING THE EXACT LOCATIONS OF ALL HOUSE CONNECTIONS AND CONCRETE COLLARS TO BE CONSTRUCTED AROUND ALL MAINS AND WATER VALVES.
5. CHISEL S OR C WHEREVER SPACER OR COLLARS PASS OVER DRIVE

UNDEVELOPED

QUANTITY ESTIMATE

8" PVC SEWER MAIN 1508 LF
 4" PVC SEWER LATERAL 775 LF
 WYES 32 EA
 (INSTALL WYES ONLY FOR FUTURE LOTS 14, 15, BLK 2, LOTS 8, 9, 13, 14 & 15, BLK 3, LOTS 8, 9 & 10, BLK 4.)
 STD SEWER MANHOLE 3 EA

SEWER LATERAL "AS-BUILT" CERTIFICATION

Gene D. Hrametzbaugh, R.L.S.
 NEVADA CERT. NO. 8501
 DATE 11/18/85

APPROVAL

CLV SANITATION SUPERVISOR DATE 2-22-85

BENCH MARK

A BRASS CAP IN THE TOP OF CURB AT THE SE RETURN OF WESTCLIFF DR. & ANTELOPE WAY.

ELEVATION: 2431.58

VICINITY MAP



TITLE		PROJECT	
MASTER SEWER PLAN		TENAYA II - UNIT 1	
WO NO 3158T2-1		SHEET 6	
BY		DATE	
SCALE 1" = 40'		OF 10 SHEETS	

REVISION


REV	DATE	BY	REVISION
1	11/14/85	SCD	REVISE SEWER LENGTHS TO 150' - 155'

CONSULTING ENGINEERS • PLANNERS

2300 PASEO DEL PRADO BUILDING A, SUITE 100
 LAS VEGAS, NEVADA 89102 PHONE (702) 873-7550

vtm nevada

RAINBOW WEST - UNIT 1

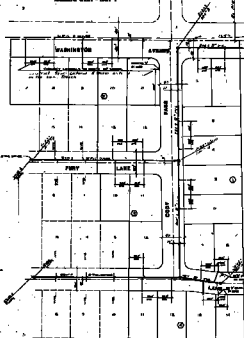

NOTES

1. SEE PLAN FOR LOCATION OF ALL SEWER LINES.
2. SEE PLAN FOR LOCATION OF ALL MANHOLES.
3. SEE PLAN FOR LOCATION OF ALL SEWER LINES.
4. SEE PLAN FOR LOCATION OF ALL MANHOLES.
5. SEE PLAN FOR LOCATION OF ALL SEWER LINES.
6. SEE PLAN FOR LOCATION OF ALL MANHOLES.
7. SEE PLAN FOR LOCATION OF ALL SEWER LINES.
8. SEE PLAN FOR LOCATION OF ALL MANHOLES.
9. SEE PLAN FOR LOCATION OF ALL SEWER LINES.
10. SEE PLAN FOR LOCATION OF ALL MANHOLES.

UNDEVELOPED

QUANTITY ESTIMATE

1. SEE PLAN FOR LOCATION OF ALL SEWER LINES.	1. SEE PLAN FOR LOCATION OF ALL SEWER LINES.
2. SEE PLAN FOR LOCATION OF ALL MANHOLES.	2. SEE PLAN FOR LOCATION OF ALL MANHOLES.
3. SEE PLAN FOR LOCATION OF ALL SEWER LINES.	3. SEE PLAN FOR LOCATION OF ALL SEWER LINES.
4. SEE PLAN FOR LOCATION OF ALL MANHOLES.	4. SEE PLAN FOR LOCATION OF ALL MANHOLES.
5. SEE PLAN FOR LOCATION OF ALL SEWER LINES.	5. SEE PLAN FOR LOCATION OF ALL SEWER LINES.
6. SEE PLAN FOR LOCATION OF ALL MANHOLES.	6. SEE PLAN FOR LOCATION OF ALL MANHOLES.
7. SEE PLAN FOR LOCATION OF ALL SEWER LINES.	7. SEE PLAN FOR LOCATION OF ALL SEWER LINES.
8. SEE PLAN FOR LOCATION OF ALL MANHOLES.	8. SEE PLAN FOR LOCATION OF ALL MANHOLES.
9. SEE PLAN FOR LOCATION OF ALL SEWER LINES.	9. SEE PLAN FOR LOCATION OF ALL SEWER LINES.
10. SEE PLAN FOR LOCATION OF ALL MANHOLES.	10. SEE PLAN FOR LOCATION OF ALL MANHOLES.

SEWER LATERAL "AS-BUILT" CERTIFICATION



APPROVAL

SEE SIGNATURE BLOCK FOR APPROVAL

REVISION NOTES:
A DRAIN CAP IS TO BE INSTALLED AT THE END OF SEWER LINE NO. 4. SEE PLAN FOR LOCATION.

REVISIONS: NONE

VELOCITY MAP



1. SEE PLAN FOR LOCATION OF ALL SEWER LINES.	1. SEE PLAN FOR LOCATION OF ALL SEWER LINES.
2. SEE PLAN FOR LOCATION OF ALL MANHOLES.	2. SEE PLAN FOR LOCATION OF ALL MANHOLES.
3. SEE PLAN FOR LOCATION OF ALL SEWER LINES.	3. SEE PLAN FOR LOCATION OF ALL SEWER LINES.
4. SEE PLAN FOR LOCATION OF ALL MANHOLES.	4. SEE PLAN FOR LOCATION OF ALL MANHOLES.
5. SEE PLAN FOR LOCATION OF ALL SEWER LINES.	5. SEE PLAN FOR LOCATION OF ALL SEWER LINES.
6. SEE PLAN FOR LOCATION OF ALL MANHOLES.	6. SEE PLAN FOR LOCATION OF ALL MANHOLES.
7. SEE PLAN FOR LOCATION OF ALL SEWER LINES.	7. SEE PLAN FOR LOCATION OF ALL SEWER LINES.
8. SEE PLAN FOR LOCATION OF ALL MANHOLES.	8. SEE PLAN FOR LOCATION OF ALL MANHOLES.
9. SEE PLAN FOR LOCATION OF ALL SEWER LINES.	9. SEE PLAN FOR LOCATION OF ALL SEWER LINES.
10. SEE PLAN FOR LOCATION OF ALL MANHOLES.	10. SEE PLAN FOR LOCATION OF ALL MANHOLES.



MASTER SEWER PLAN	UNIT 1
10. SEE PLAN FOR LOCATION OF ALL MANHOLES.	10. SEE PLAN FOR LOCATION OF ALL MANHOLES.