


1 WALL SECTION @ VESTIBULE
SCALE: 3/4" = 1'-0"

2 WALL SECTION @ ENTRANCE CANOPY
SCALE: 3/4" = 1'-0"

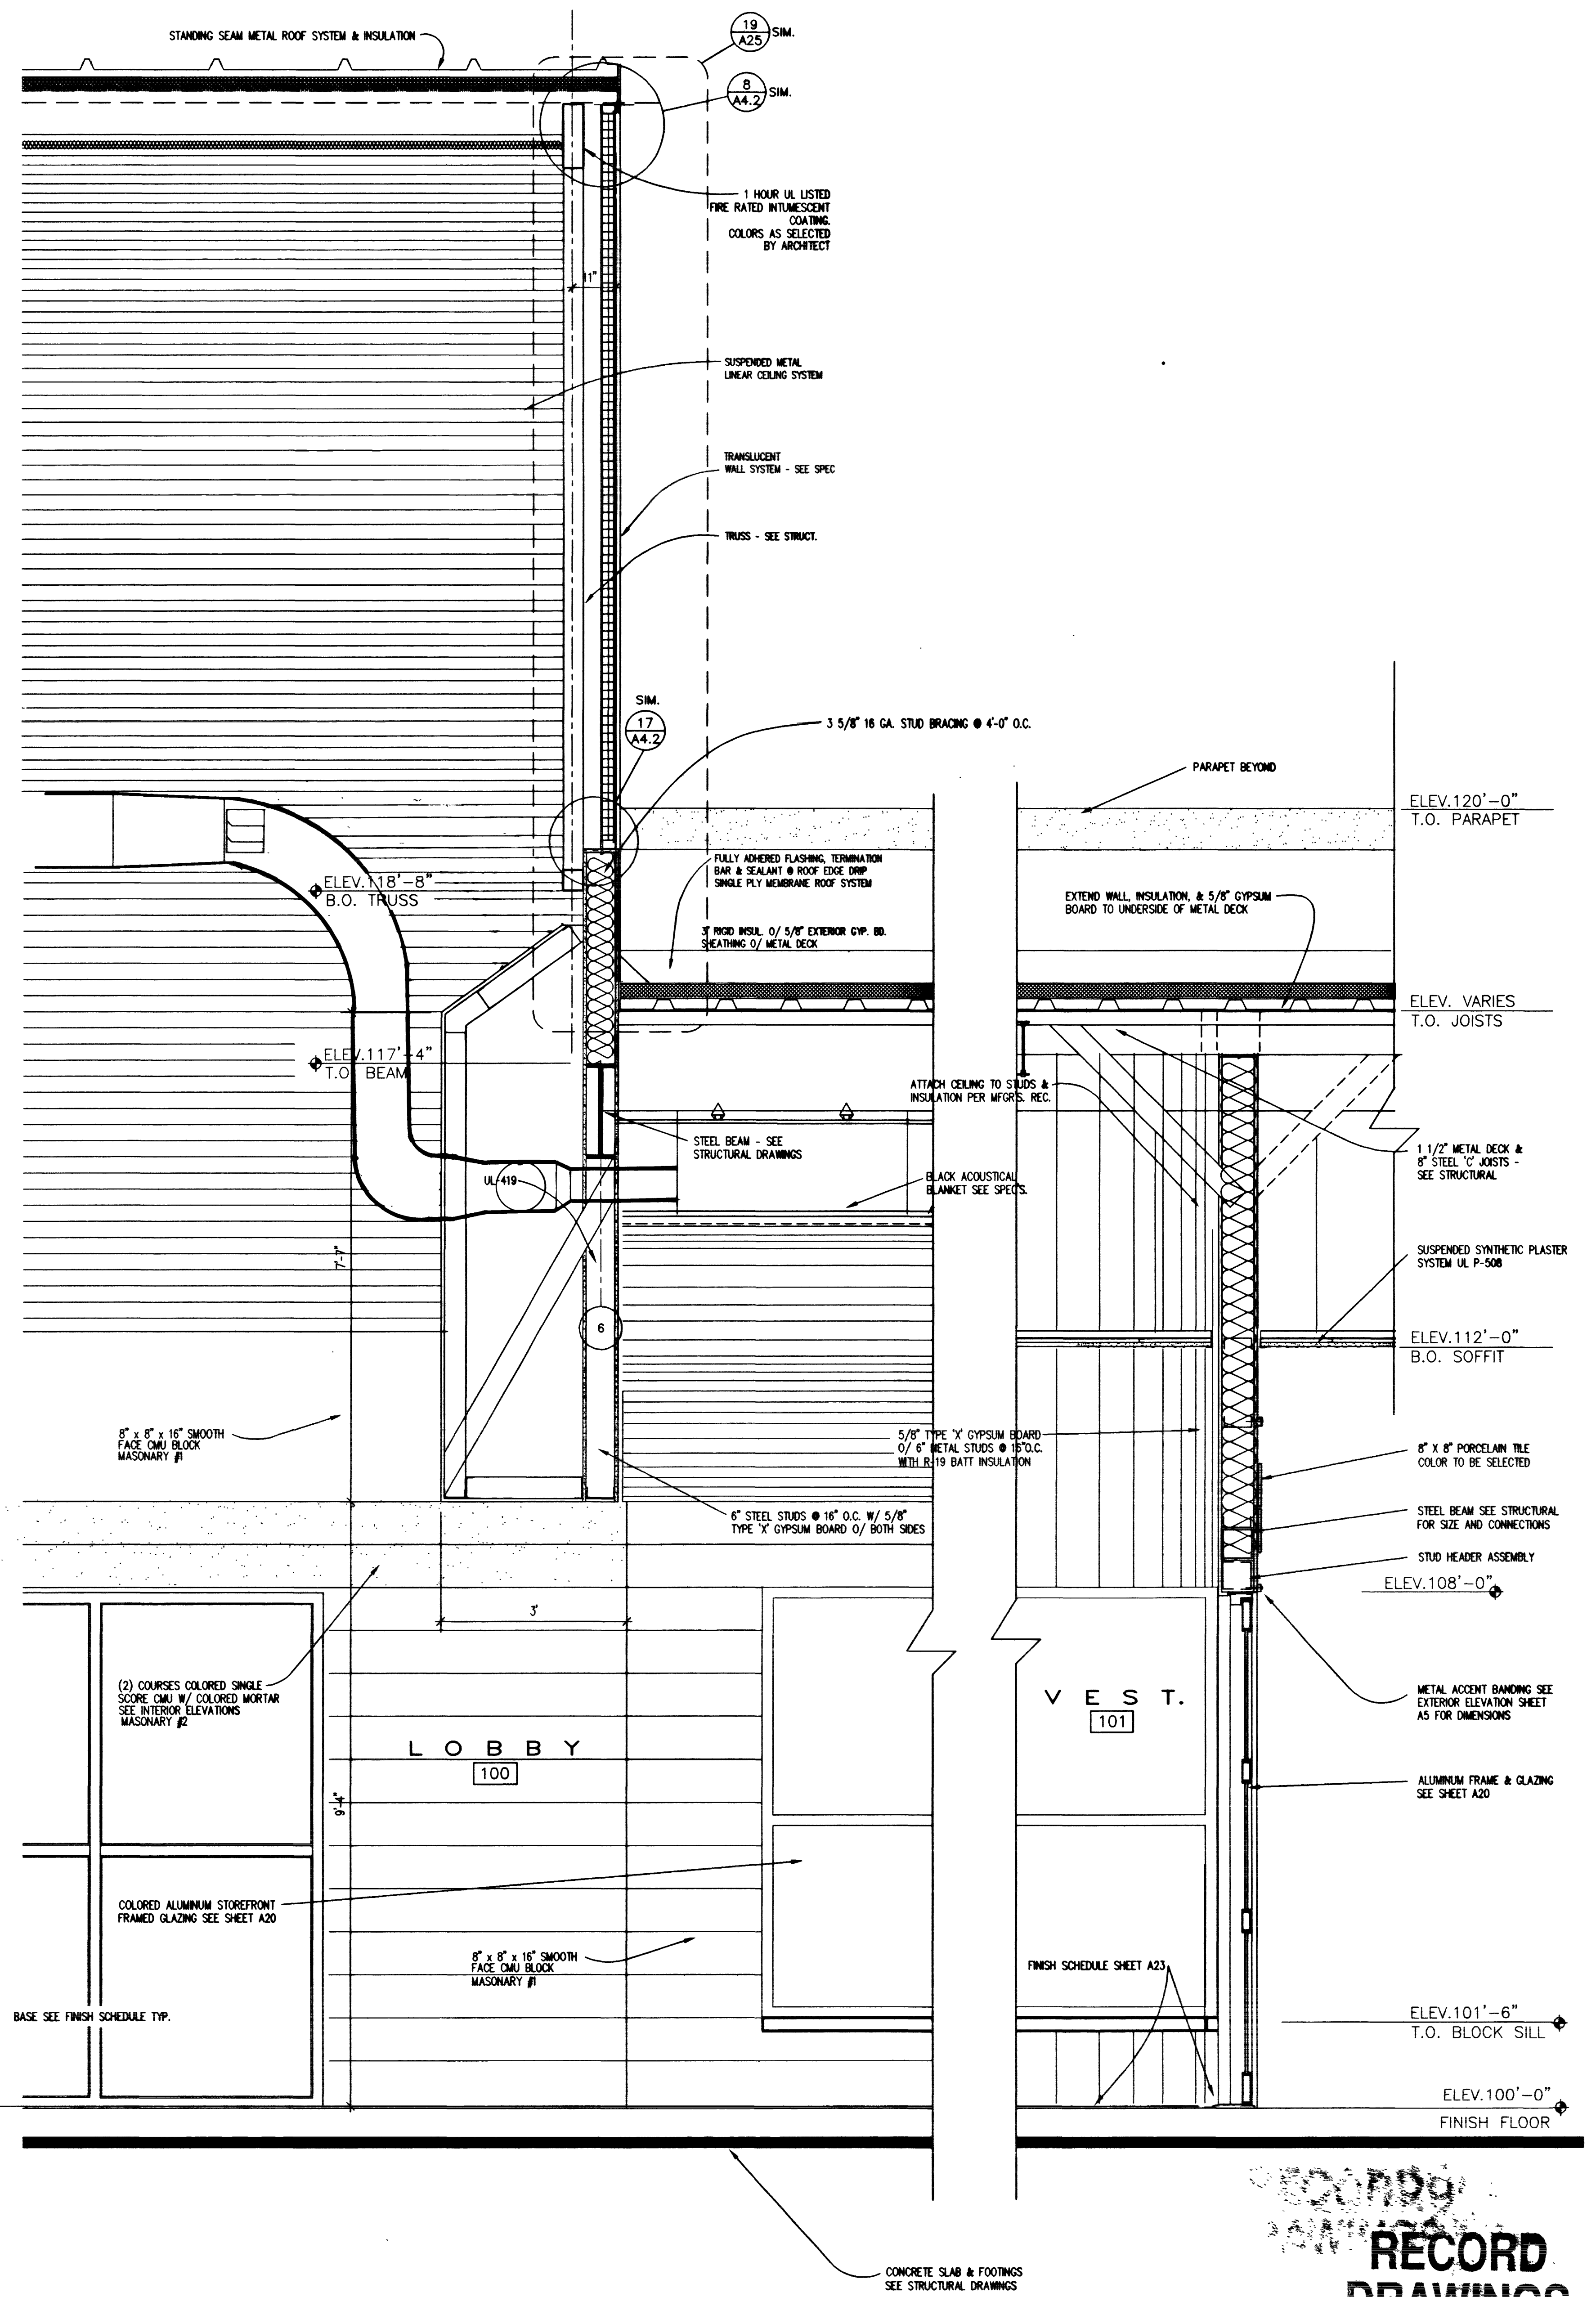

3 WALL SECTION @ LOBBY
SCALE: 3/4" = 1'-0"

RECORD DRAWINGS
18 OF 56
650.60

Any use or reproduction of this document or the attached drawings, or the use of the design materials, shall be considered a violation of the copyright laws of the United States of America. No part of this document may be reproduced or transmitted in any form or by any means, electronic or mechanical, including photocopying, recording, or by any information storage and retrieval system, without the prior written consent of HSA Architects, Inc., a Nevada Corporation.

DATE	
DESCRIPTION	
REVISION	
Wayne Schreiner AIA	Thomas M. Silva AIA
1535 WEST OAKLEY BLVD. LAS VEGAS, NV 89102 (702) 382-0077 FAX (702) 382-0087	
HSA Architects	
WALL SECTIONS	
Sheet Title	CITY OF LAS VEGAS DEPARTMENT OF PARKS AND LEISURE ACTIVITIES THE ARBORS COMMUNITY CENTER @ SUMMERLIN
Job Title	Verify all Dimensions and Conditions of the Site
Job	961001
Date	20 FEB 1998
Drawn By	CRL
Check	WPS
Sheet	A15
	18 of 26

27204