



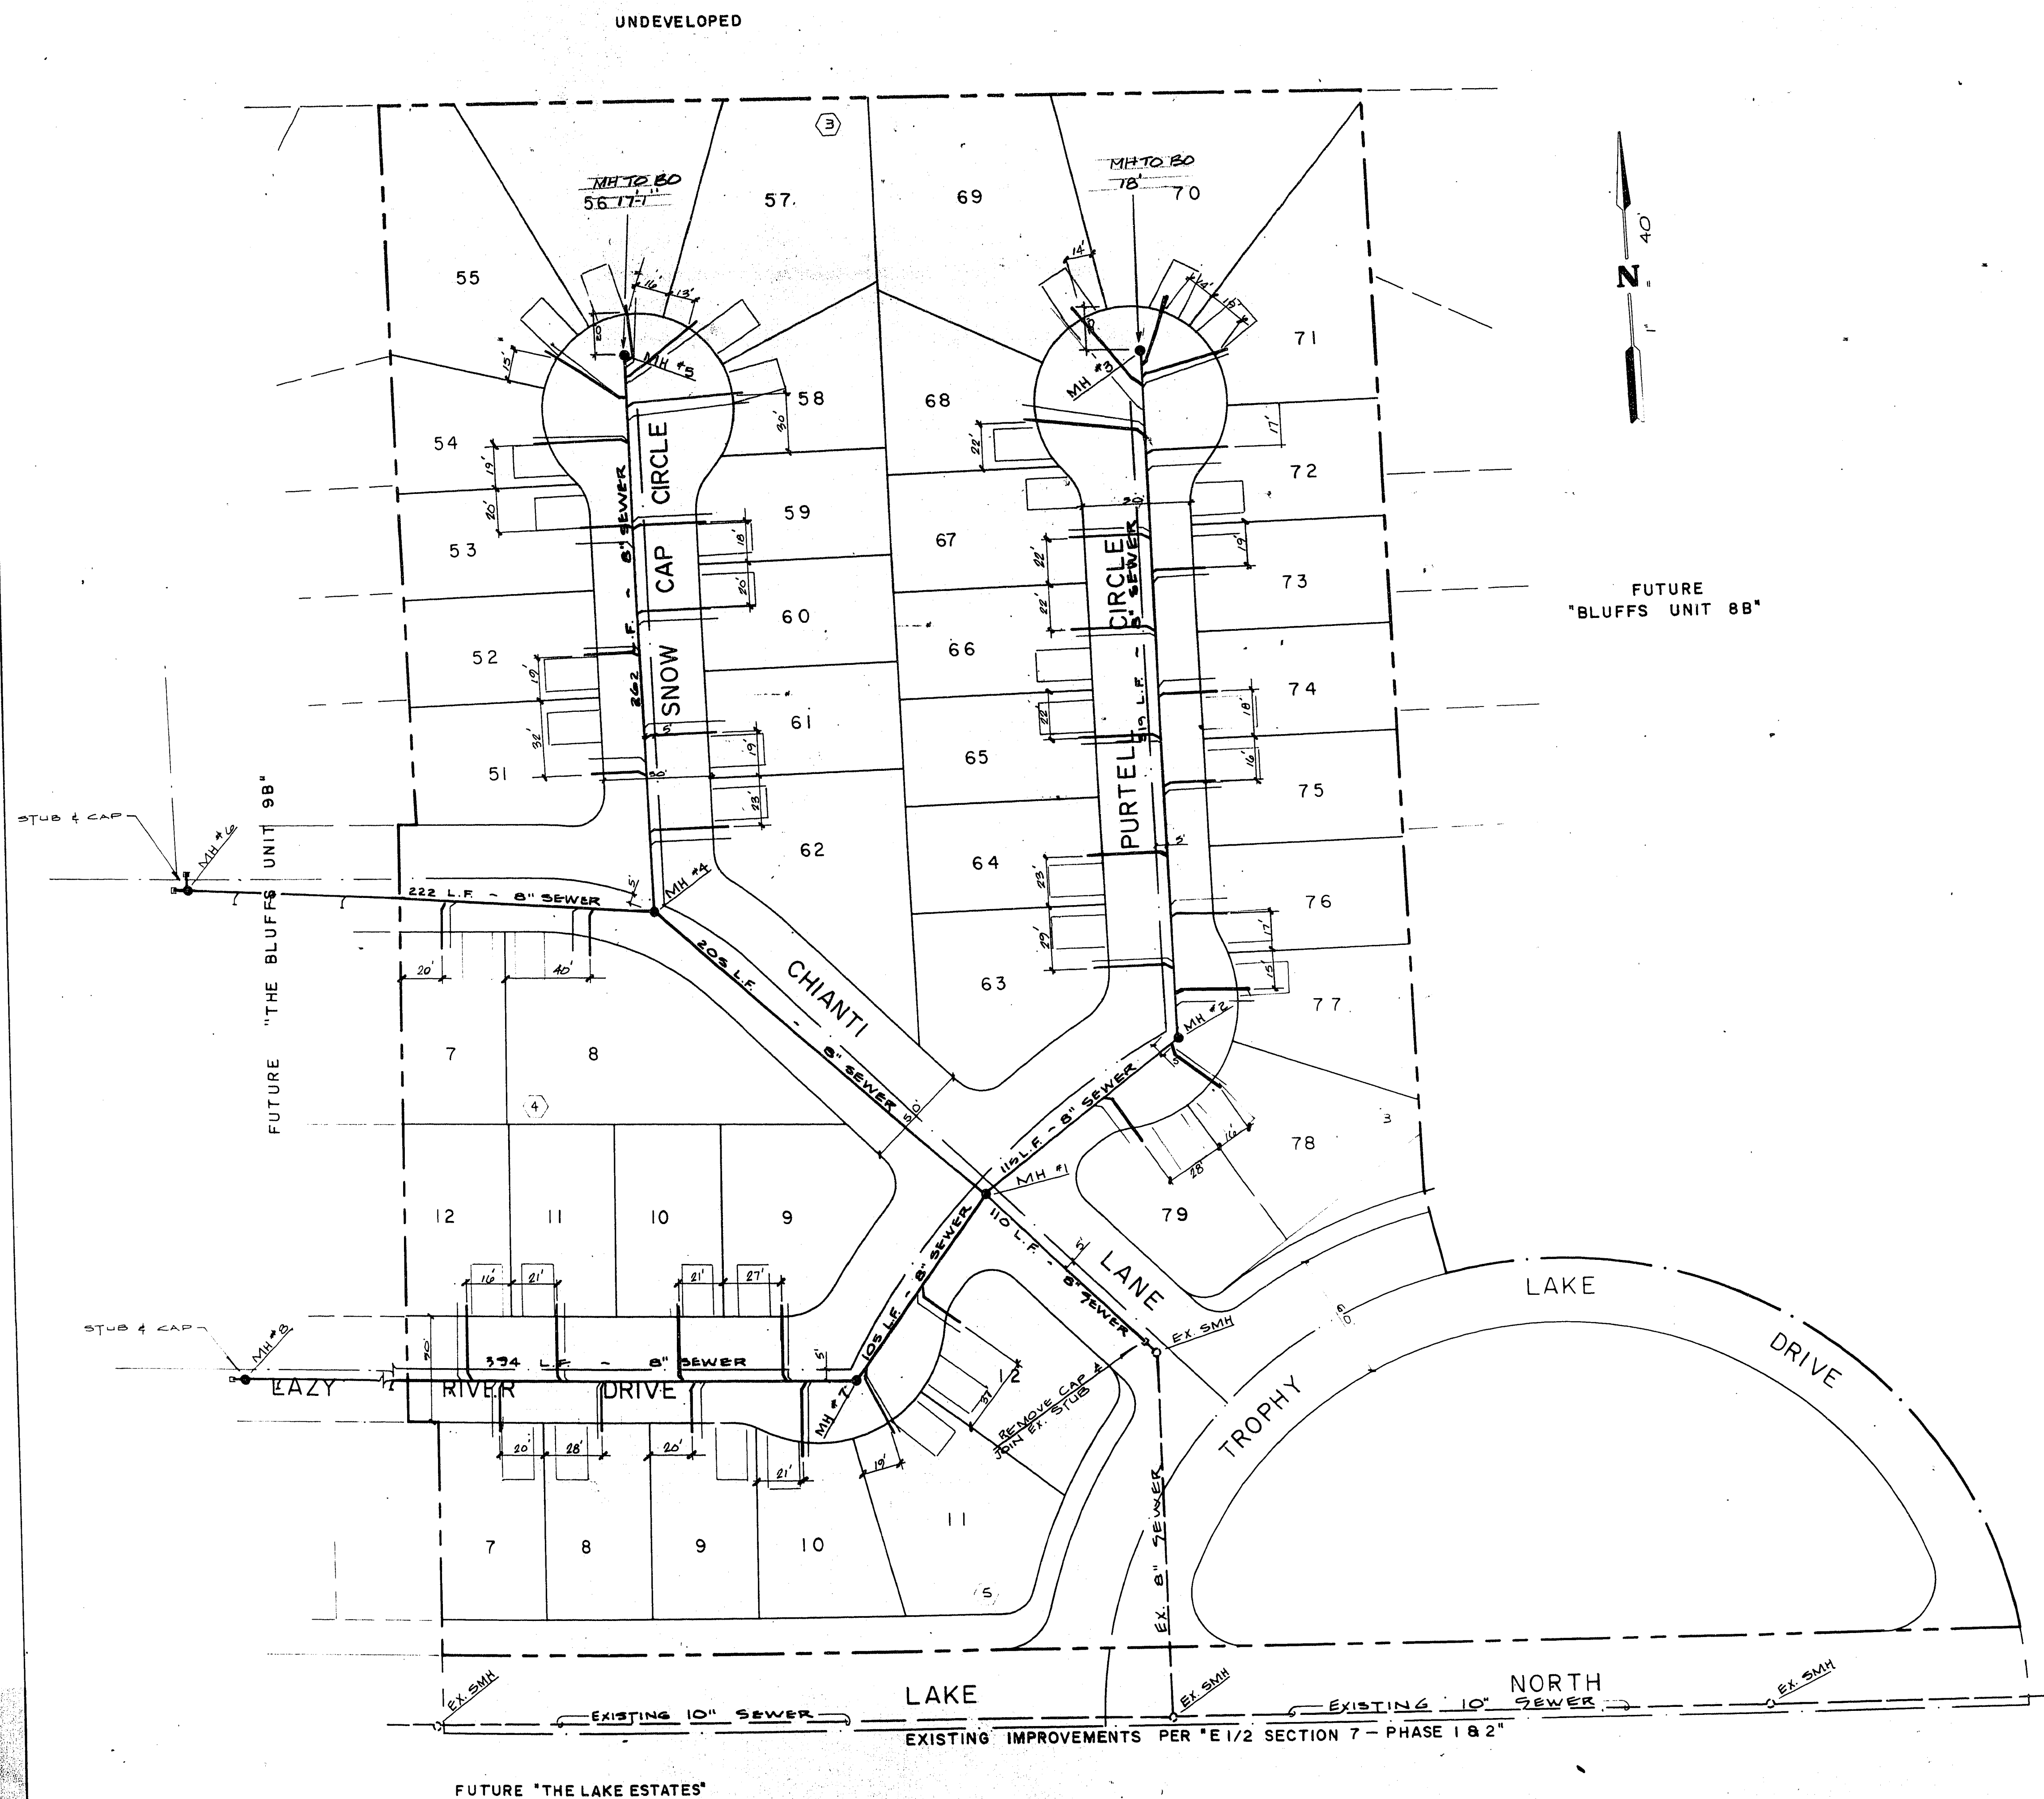

- CITY OF LAS VEGAS GENERAL NOTES**
1. HOUSE SERVICES SHALL COMPLY WITH WESTERN PLUMBING CODE AS TO SEPARATION DISTANCE.
 2. ALL HOUSES TO BE SERVED INDIVIDUALLY AS PER SECTION 313 OF THE UNIFORM PLUMBING CODE.
 3. CONTRACTOR SHALL FURNISH THE ENGINEER WITH AS-BUILT DRAWINGS SHOWING THE EXACT LOCATIONS OF ALL HOUSE CONNECTIONS.
 4. CONCRETE COLLARS TO BE CONSTRUCTED AROUND ALL MANHOLES AND WATER VALVES. CONCRETE COLLARS SHALL BE 1/8" TO 1/4" LOWER THAN ADJACENT FINISH GRADE.
 5. CHISEL S OR G WHEREVER SEWER OR GAS LINES PASS UNDER CURB.

QUANTITY ESTIMATE

STD 4' DIA. MANHOLE	8 EA.
6" SEWER MAIN	1732 LF
4" SEWER LATERALS	2370 LF
1/2" SEWER SERVICE STUBS	8 EA.

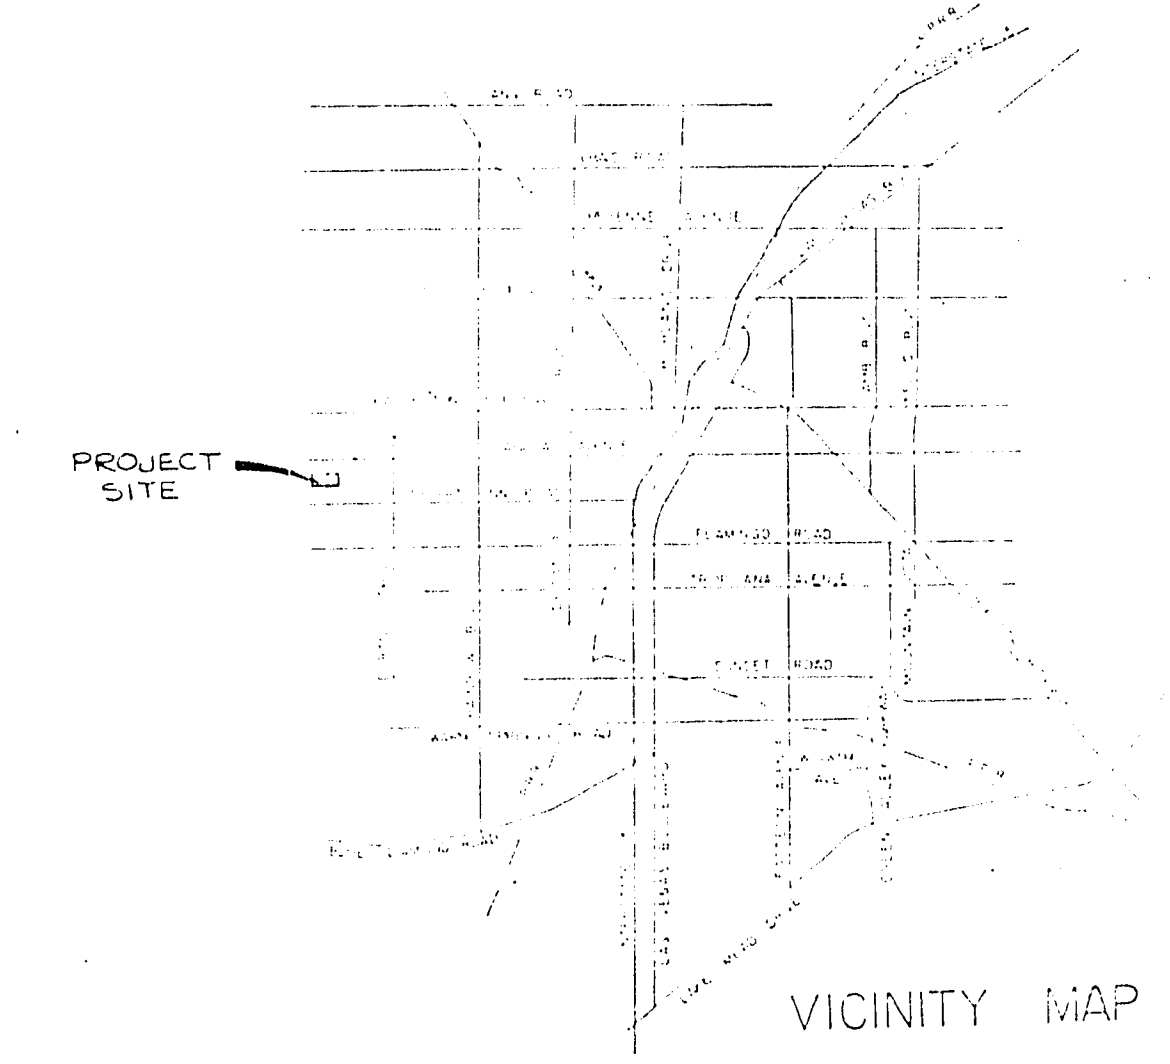

REVISION		ADD BLOCK 15 NORTH ARROW, DRIVEWAYS LOTS 1, 2 AND 3. ADD LEGION AREA. ADD VICINITY MAP.	
REV.	DATE	BY	DATE
1	4-28-87	TB	
ES! ENGINEERS & SURVEYORS INC.			
SUBMITTED BY: PAUL E. VALENTINE, CIVIL			
19-6574			
TITLE		PROJECT	
MASTER SEWER PLAN AS BUILT		THE BLUFFS UNIT 9A	
WO NO. 42073		BY: [Signature]	
DATE 2-87		SCALE Horiz. 1" = 40'	
SHEET 6		OF 8 SHEETS	

As Built 307Y-911-9A