


REV	DATE	BY	REVISION
1	8-24-85	L/J	RELOCATED MH #2, REVISED GRADES
2	9-10-85	L/J	REVISED GRADE & INVERT ELEVATIONS
3	1-25-86	PTB	REVISED SEWER SLOPE TO MATCHUP & PUT IN TIE IN 2/25/86, 2.4% 4/27/85

ENGINEERS & SURVEYORS INCORPORATED
 7022 W. CHARLESTON BLVD.
 LAS VEGAS, NEVADA 89117
 PHONE: 702/363-6415

SUBMITTED BY:
Paul E. ...
 4/27/85

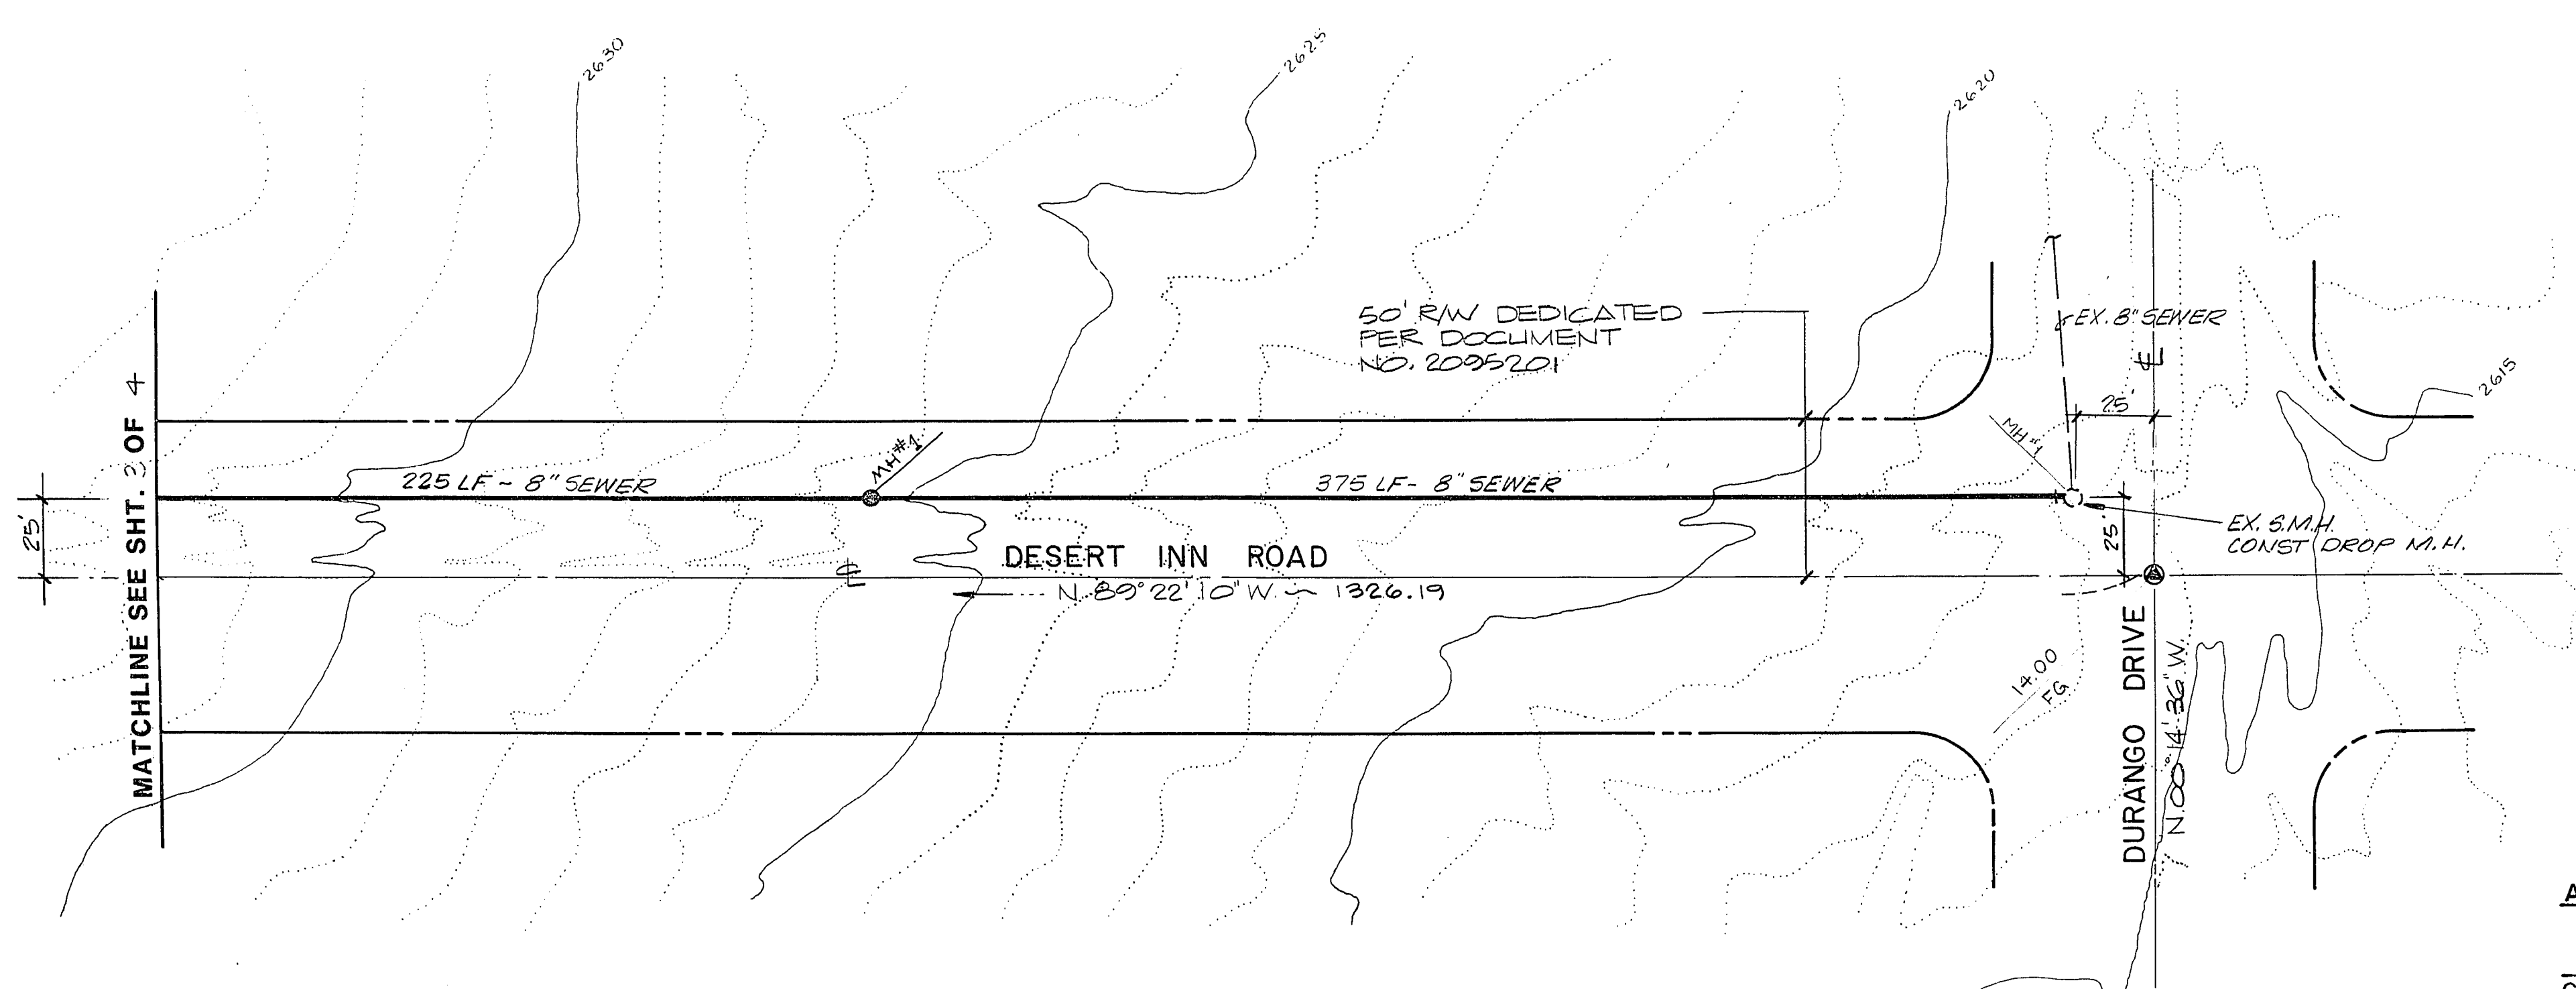

APPROVAL
[Signature]
 C. L. V. SANITATION DATE
[Signature] 12-5-85
 C. L. V. CHIEF LAND DEVELOPMENT DATE



TITLE
OFFSITE SEWER PLAN & PROFILE
 DESERT INN ROAD
 PROJECT
THE LAKES AT WEST SAHARA
 OFFSITE SEWER MAIN FOR BAYSIDE & LEWIS HOMES

WO NO. 830802
BY B. MURNANE
DATE 7-85
SCALE 1"=40'
SHEET 2 OF 4 SHEETS