


REVISION	BY	DATE	REVISION
1	BY	8/26/85	ADD SUPPLEMENTAL TO EXISTING PLAN
2	LH	9-10-85	ADDED NOTE

ENGINEERS & SURVEYORS INCORPORATED
 7022 W. CHARLESTON BLVD
 LAS VEGAS, NEVADA 89117
 PHONE: 702 / 363-6415

SUBMITTED BY: [Signature]

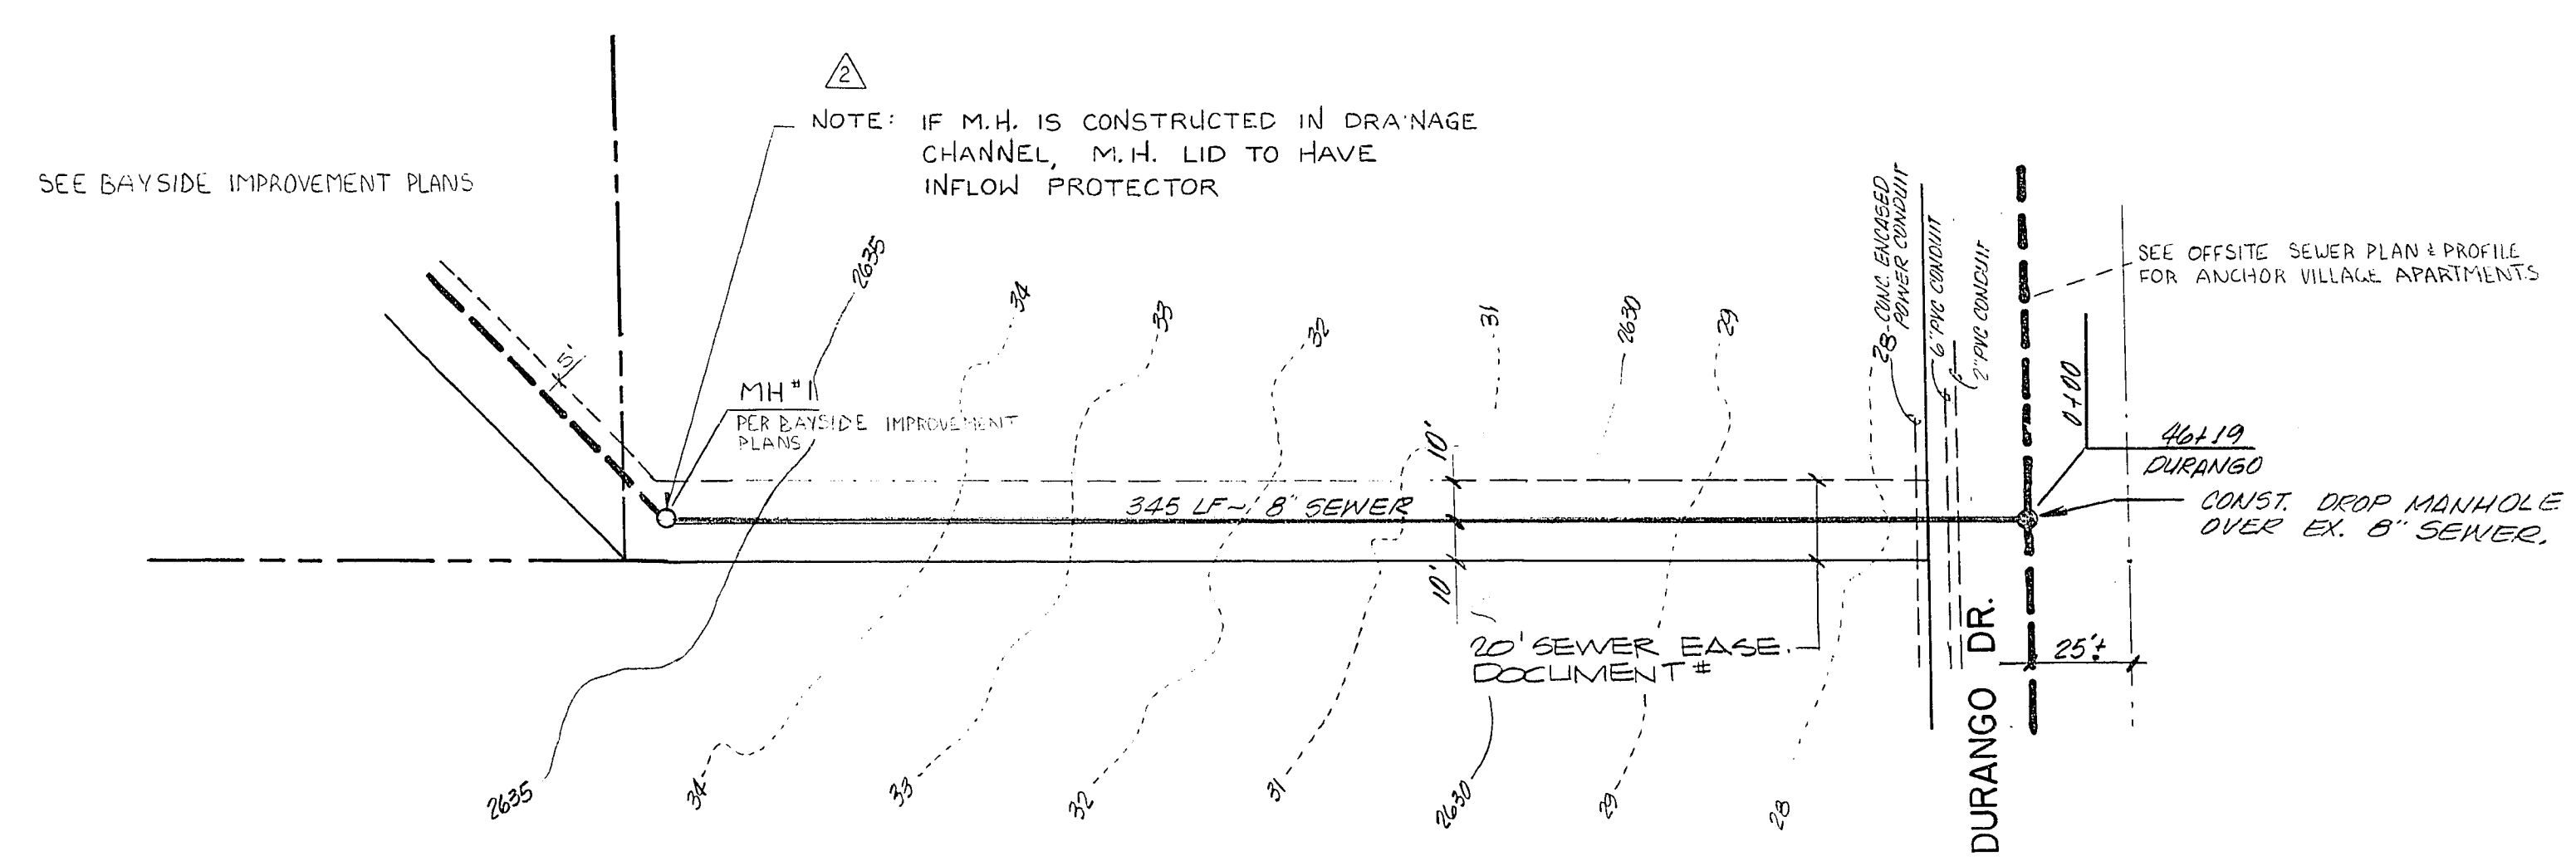

APPROVAL

[Signature]
 C.L.V. SANITATION DATE 12-5-85

[Signature]
 C.L.V. CHIEF LAND DEVELOPMENT DATE 12-5-85

TITLE OFFSITE SEWER PLAN & PROFILE

PROJECT THE LAKES AT WEST SAHARA
 OFFSITE SEWER MAIN FOR BAYSIDE & LEWIS HOMES

WO NO. 830802
BY B. MURNANE
DATE 7-85
SCALE 1" = 40'
SHEET 4
OF 4 SHEETS