

**LEGEND:**


---	EXISTING GAS LINE
- - - -	PROPOSED MAIN GAS LINE
- · - · -	PROPOSED SERVICE GAS LINE
---	BOUNDARY LINE
- · - · -	RIGHT OF WAY LINE
---	STREET CENTERLINE
- · - · -	BACK OF CURB / LOT LINE
- · - · -	EX. BACK OF CURB / LOT LINE
---	SEWER LINE
---	WATER LINE
---	FIRE HYDRANT
---	STORM DRAIN LINE

- CONSTRUCTION NOTES:**
1. SUGGESTED GAS LOCATIONS ARE TO CLEAR SUBSTRUCTURES. LOCATE IN FIELD.
  2. ALL PIPELINE CONSTRUCTION SHALL CONFORM TO APPLICABLE JURISDICTION SPECIFICATIONS.
  3. DO NOT SCALE THIS DRAWING.
  4. SERVICE(S) TO BE 2" PE UNLESS OTHERWISE NOTED.
  5. RISER & METERS AT THIS LOCATION.  $\Delta$
  6. GAS MAINS SHALL BE PURGED PER THE OPERATIONS MANUAL.
  7. ALL MAIN TIE-INS REQUIRING TEES ARE TO BE FULL FLOW TEES, UNLESS OTHERWISE STATED.
  8. DECATUR IS PAVED, COMPLY WITH RTC STANDARDS.

**PURGE NOTE:**  
PURGE PLAN WAS COMPLETED IN ACCORDANCE WITH THE OPERATIONS MANUAL GUIDELINES BY:  
Name \_\_\_\_\_ Date \_\_\_\_\_

**APPROVED FOR CONSTRUCTION**  
THIS APPROVAL IS FOR WORK IN CLV R/W OR CLV EASEMENTS ONLY. OBTAINING PERMISSIONS OR EASEMENTS FOR WORK SHOWN ON PRIVATE PROPERTY IS THE RESPONSIBILITY OF THE UTILITY.  
APPROVAL \_\_\_\_\_ DATE \_\_\_\_\_

**REVISED**

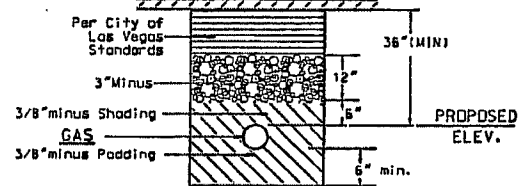

Call before you dig  
1-800-227-2600  
CLV COUNTY UTILITY DEPARTMENT  
1-702-455-7544

SYSTEM <u>D_VALLEY_WIDE</u>	I REVIEWED THE PROCEDURES PERFORMED AND FOUND THEM ADEQUATE <input checked="" type="checkbox"/> INADEQUATE <input type="checkbox"/>
DR. NO. <u>x609y522-1DR</u> SYSTEM M.A.D.P. <u>60#</u>	INADEQUATE COMMENTS:
SEGMENT M.A.D.P. <u>N/A</u> SYSTEM M.D.P. <u>43#</u>	SIGNATURE: _____ DATE: _____
	SIGNATURE: _____ DATE: _____

**NOTE:**  
THERE IS 18' OF 2" PE IN THE CITY OF LAS VEGAS R/W.

AS-BUILT DRAWING-PRESSURE TEST DATA			
PIPE DIA.	TEST MEDIUM	TEST METHOD	
PIPE LENGTH	<input type="checkbox"/> AIR <input type="checkbox"/> GAUGE	<input type="checkbox"/> CHART	
PIPE TYPE	<input type="checkbox"/> NITROGEN <input type="checkbox"/> WATER	<input type="checkbox"/> SOAP	
MIN. DURATION		GAUGE / PRESS. REC. SNR	
TEST PRES. (PSIG)	START	END	
TIME			
DATE	PROPOSED	INSTL. RET.	INSTL. RET.
PERFORMED BY		COMPLETED	

CONSTRUCTION		ISOLATION AREA	W. R. NO.
INSPECTOR	FOREMAN	27	979358
REVIEWED BY		LOCATION	TILE NO.
		T20S.R60E	S25
PERMIT INFORMATION			
Tax Code Area-02-0207			
CITY OF LAS VEGAS			

ENG. TECH. BILL GRENNAN	PHONE 365-2173
ACCOUNT REP. JOHN WRIGHT	PHONE 528-7729
PROJECT CONTACT RICH RIAL	702-376-0527
SHEET NO. 01 OF 01	SCALE 1" = 40'
DWN. BY BLA	CHKD. BY BLA
APPVD. BY	
TITLE	
THE RESIDENCES @ VILLAGE SQUARE	
DECATUR BLVD & VEGAS DR	

REVISIONS

NO.	DESCRIPTION	BY	DATE	APPVD.
1	REVISED TO SERV BLDG 2 ONLY.	DF	03/10/10	
2	RE-LOCATED RISER.	DF	12/14/09	

**Southwest Gas Corporation**

UNIT NO.	UNIT TYPE	INSTL.	RET.	INSTL.	RET.
		PROPOSED		COMPLETED	

122431