


DISK # DISK
DRAWING
PLOT DATE 45753

STA 153+00
MATCH LINE


STA 153+00
MATCH LINE

BACK OF CURB DATA				
CURVE	DELTA	RADIUS	LENGTH	TANGENT
C2	88°52'41"	30.00'	46.54'	29.42'

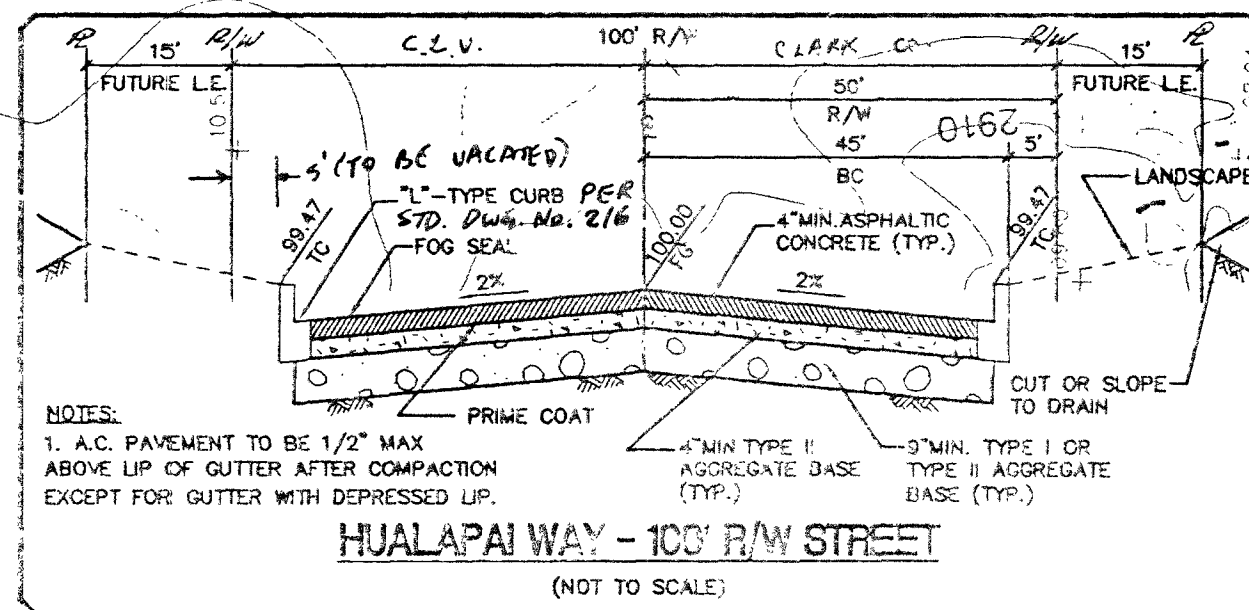

SIDEWALK RAMP DATA	
PER C.V. STD DWG NO. 235, CASE 1	
N.O.	R
H-1	4.5' 12.0'

I CERTIFY THAT THIS GRADING PLAN IS IN CONFORMANCE WITH THE APPROVED DRAINAGE STUDY AT THE CITY OF LAS VEGAS FOR THIS PROJECT.
DANIEL LORUBIO, JR. 5/19/96
DATE

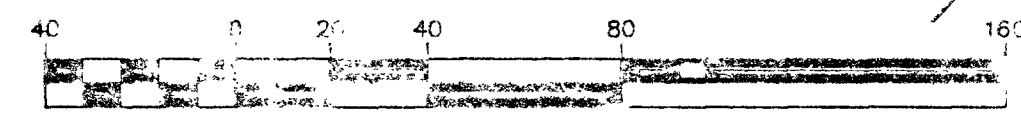

APPROVED FOR CONSTRUCTION
5/19/96
DATE

PECCOLE NEVADA CORP.
PECCOLE WEST PHASE II
PLAN AND PROFILE - HUALAPAI WAY
STA. 153+00 TO 164+00

PENACONE
CIVIL ENGINEERING • LAND SURVEYING • PLANNING
CONSTRUCTION MANAGEMENT • ADA CONSULTING
6763 WEST CHATEAU BOULEVARD
LAS VEGAS, NEVADA 89107 (702) 251-1115

DATE: 03/19/96
DRAWN BY: [Signature]
DESIGNED BY: [Signature]
JOB NO.: 0145.0025
SCALE: AS SHOWN

REVISIONS
NO. DESCRIPTION
DATE

