

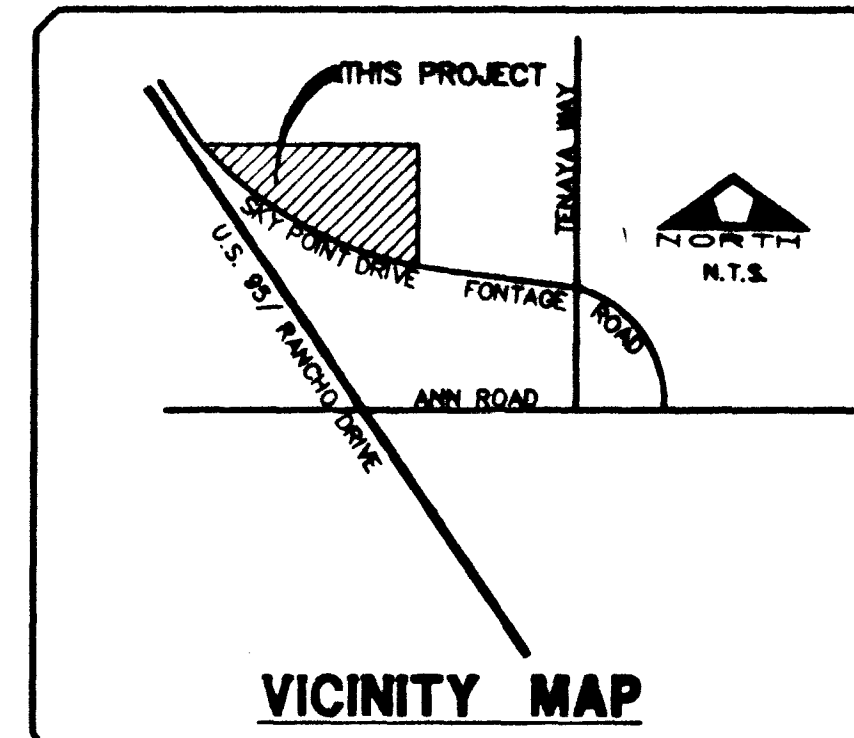


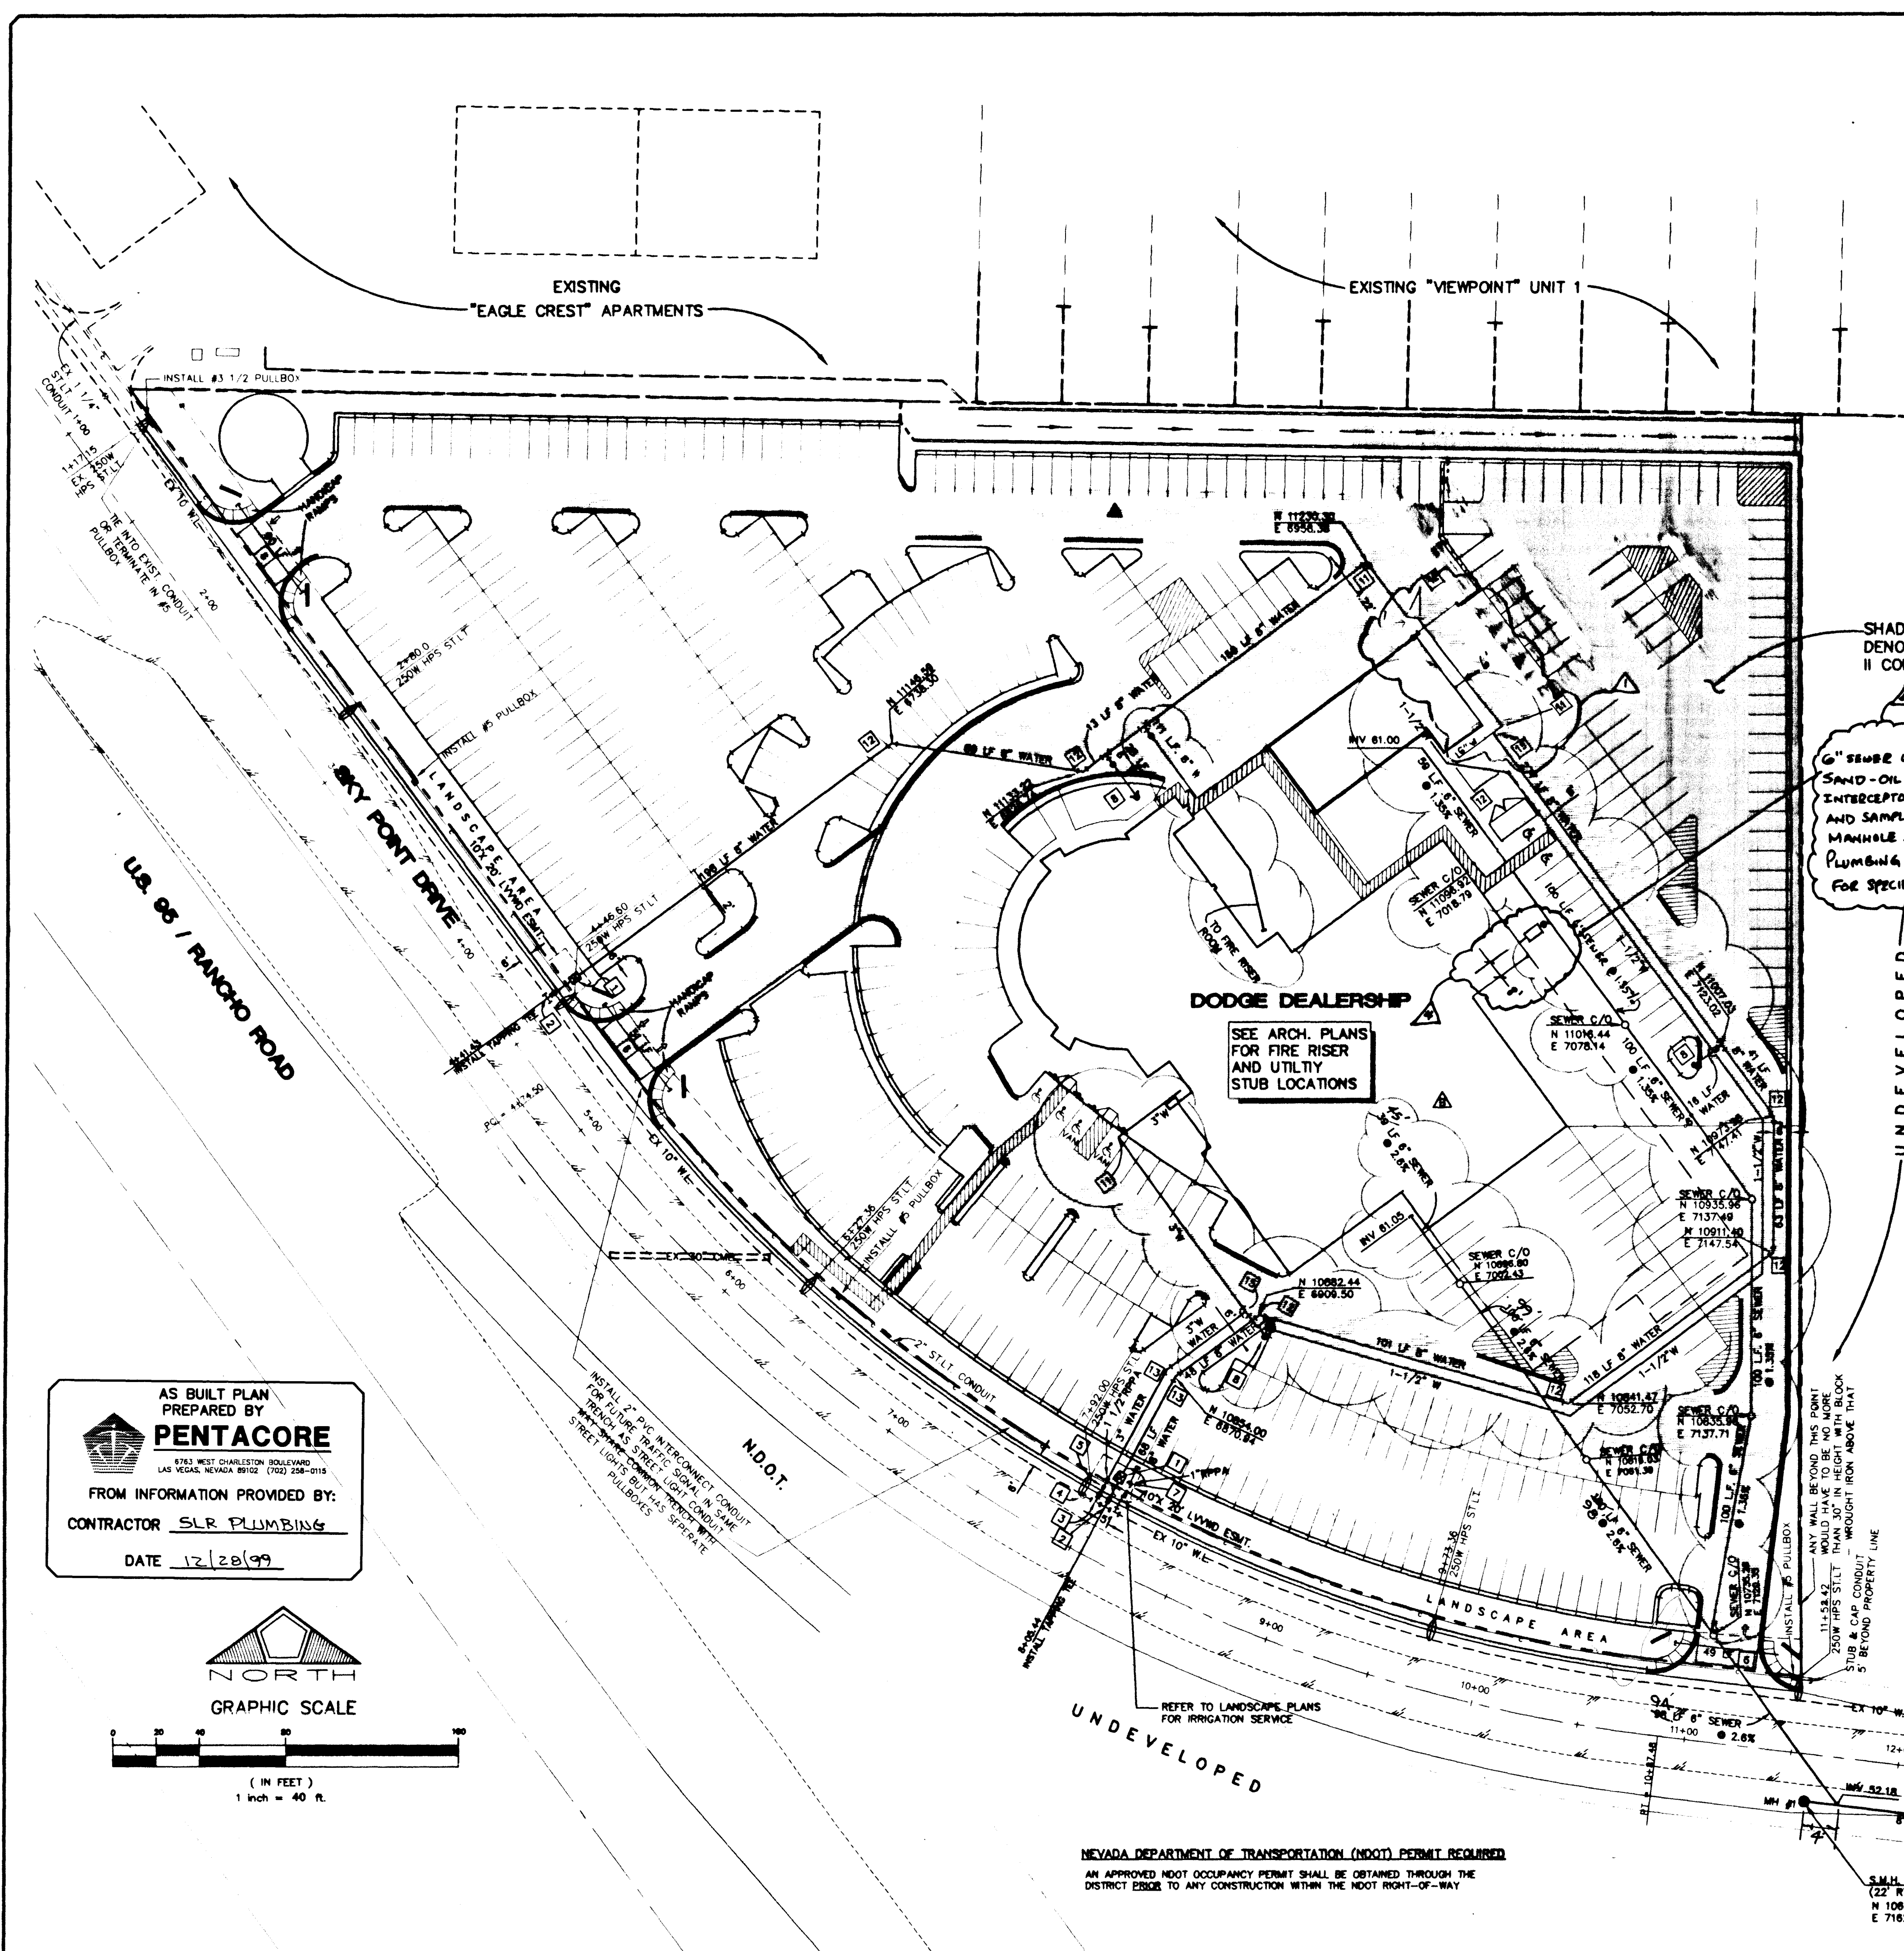


**INSTALLATION OF DOUBLE CHECK DETECTOR ASSEMBLY**  
THE DOUBLE CHECK DETECTOR ASSEMBLY SHALL BE INSTALLED IN ACCORDANCE WITH THE UOACS PLATE 208.  
ANY BLOCK WALL OR OTHER FENCE MATERIAL SHALL BE DESIGNED AND CONSTRUCTED AROUND THE OUTSIDE OF THE EASEMENT(S), SO AS TO ALLOW THE DISTRICT DIRECT ACCESS FROM THE ADJACENT RIGHT-OF-WAY.  
**2-8" DODAS**  
**REDUCED PRESSURE PRINCIPLE ASSEMBLY**  
APPROVED REDUCED PRESSURE PRINCIPLE ASSEMBLY(S) SHALL BE INSTALLED PER THE UOACS PLATE NO. 11A. NO WATER SHALL BE TAKEN FROM A SERVICE REQUIRING BACKFLOW PREVENTION UNTIL THE REDUCED PRESSURE PRINCIPLE ASSEMBLY HAS BEEN SUCCESSFULLY TESTED BY THE LVWD.  
ANY BLOCK WALL OR OTHER FENCE MATERIAL SHALL BE DESIGNED AND CONSTRUCTED AROUND THE OUTSIDE OF THE EASEMENT(S), SO AS TO ALLOW THE DISTRICT DIRECT ACCESS FROM THE ADJACENT RIGHT-OF-WAY.  
**1-1" RPPA & 1-1 1/2" RPPA**

- CONSTRUCTION NOTES**
1. INSTALL 8" DOUBLE CHECK DETECTOR
  2. INSTALL 10" X 8" TAPPING TEE AND SLEEVE WITH 8" TAPPING VALVE.
  3. INSTALL 10" X 1 1/2" SERVICE SADDLE
  4. INSTALL 10" GV (CUT-IN)
  5. INSTALL 1 1/2" WATER METER & RPPA
  6. INSTALL 1" IRRIGATION SLEEVE.
  7. INSTALL 1" R.P.P.A. & 1" IRRIGATION WATER METER.
  8. INSTALL FIRE HYDRANT ASSEMBLY WITH 8" GATE VALVE.
  9. INSTALL 8" GATE VALVE.
  10. INSTALL 8" GATE VALVE.
  11. INSTALL 90° BEND
  12. INSTALL 45° BEND
  13. INSTALL 22.5° BEND
  14. INSTALL 11.25° BEND
  15. INSTALL TEE
  16. INSTALL CROSS

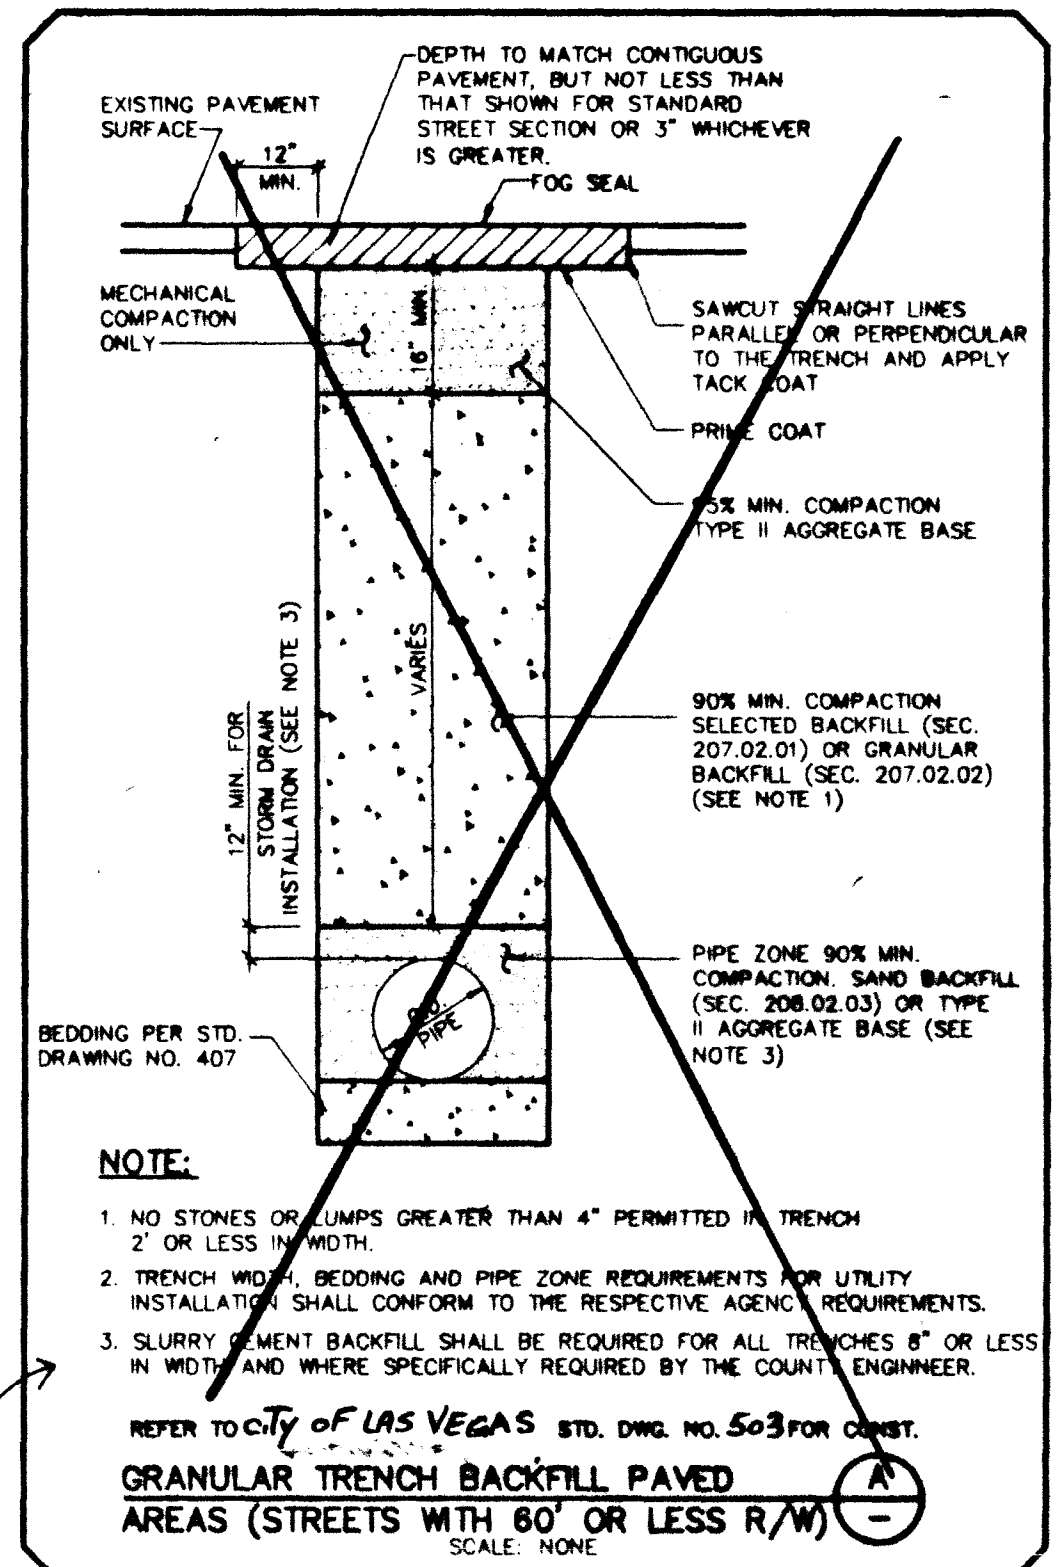


**BENCHMARK**  
CITY OF LAS VEGAS BENCHMARK NO. 11V0346H000  
RIVET & PLATE IN TOP OF CURB AT THE SOUTHWEST CORNER OF PAINTED MIRAGE ROAD & ANN ROAD.  
ELEVATION = 720.063 METERS (NAV08) - DATUM USED  
ELEVATION = 2362.4176 FEET (NAV08) - DATUM USED

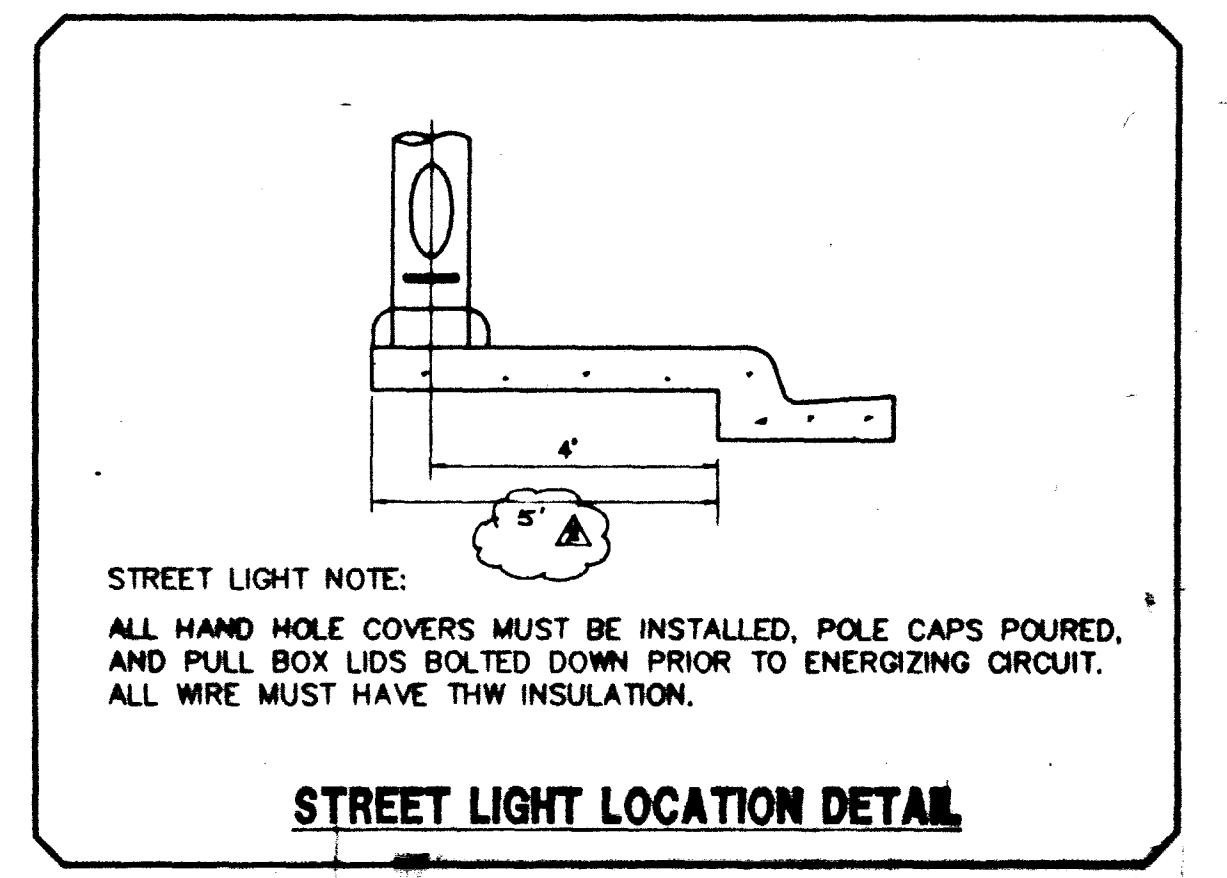

**STREET LIGHT NOTE:**  
ALL HAND HOLE COVERS MUST BE INSTALLED, POLE CAPS POURED, AND PULL BOX LIDS BOLTED DOWN PRIOR TO ENERGIZING CIRCUIT. ALL WIRE MUST HAVE THW INSULATION.

**APPROVALS**  
PROJECT NAME: **TOM SAITTA DODGE**  
DATE: **8/8/97**  
SIGNED: **Shirley P. Kaden**  
LAS VEGAS VALLEY WATER DISTRICT  
SIGNED: **Tom Saitta**  
DODGE DEALERSHIP  
DATE: **7-31-97**  
CITY OF LAS VEGAS FIRE DEPARTMENT

AS BUILT PLAN  
PREPARED BY  
**PENTACORE**  
6763 WEST CHARLESTON BOULEVARD  
LAS VEGAS, NEVADA 89102 (702) 258-0115  
FROM INFORMATION PROVIDED BY:  
CONTRACTOR **SLR PLUMBING**  
DATE **12/28/99**

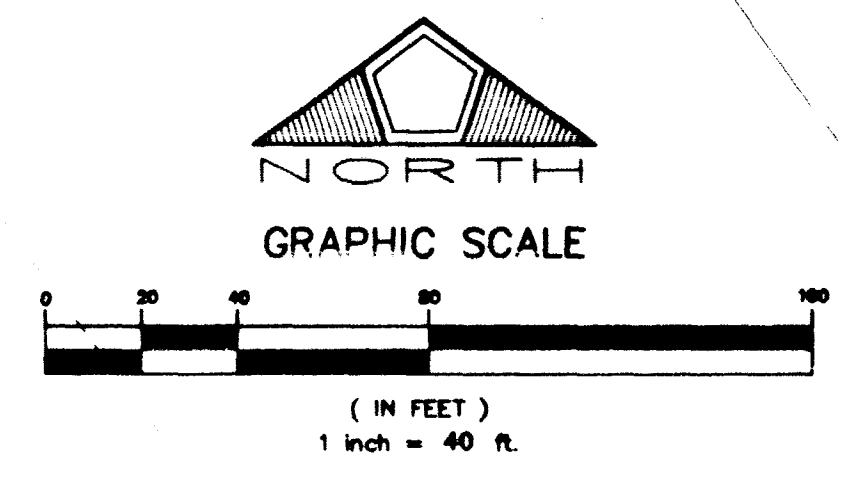

NEVADA DEPARTMENT OF TRANSPORTATION (NDOT) PERMIT REQUIRED  
AN APPROVED NDOT OCCUPANCY PERMIT SHALL BE OBTAINED THROUGH THE DISTRICT ENGINEER TO ANY CONSTRUCTION WITHIN THE NDOT RIGHT-OF-WAY

**PENTACORE**  
CIVIL ENGINEERING & LAND SURVEYING - PLANNING  
CONSULTING ENGINEERS - CONSTRUCTION MANAGEMENT  
LAS VEGAS, NEVADA 89102 (702) 258-0115

**TOM SAITTA DODGE**  
DODGE DEALERSHIP  
UTILITY PLAN

**C7**  
OF 10

7/30/97

107-12650