
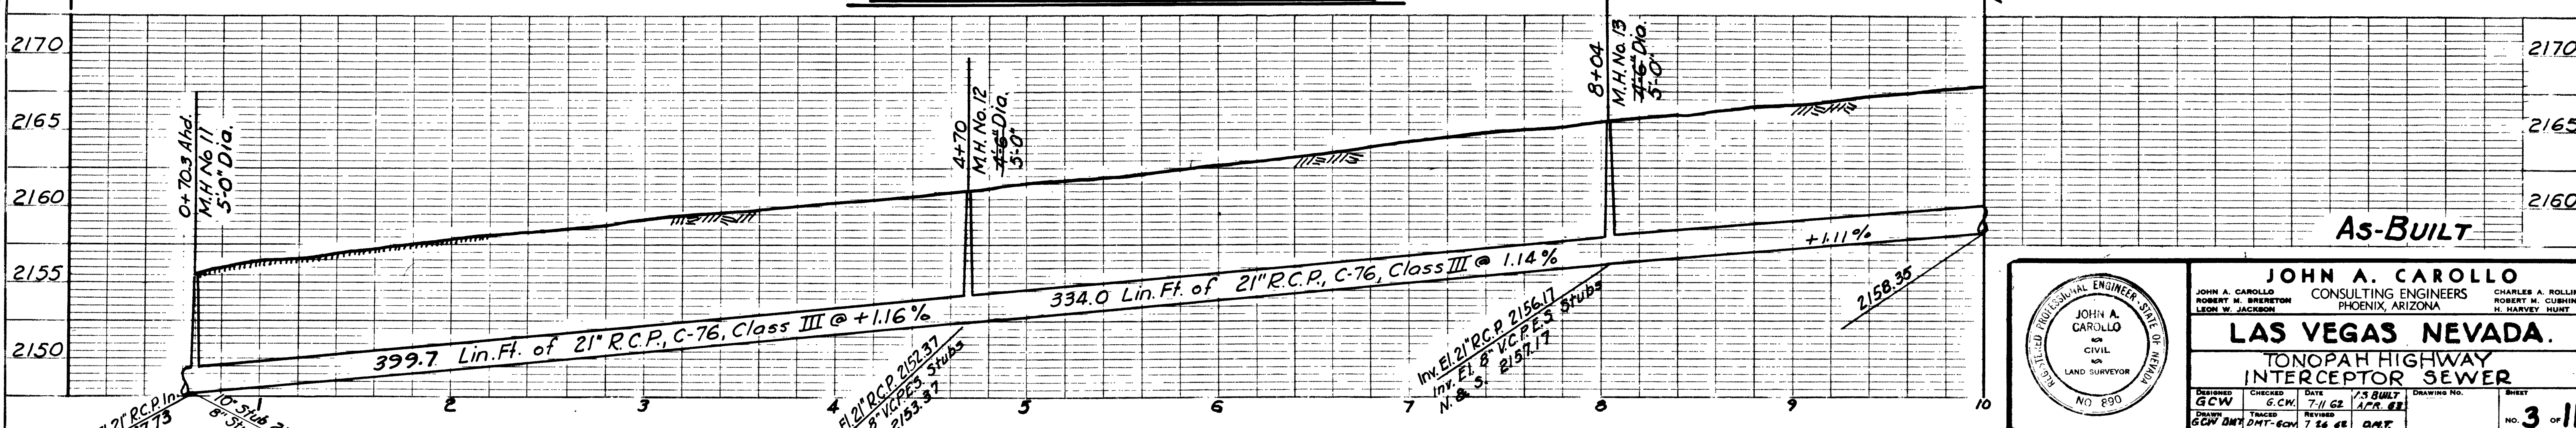
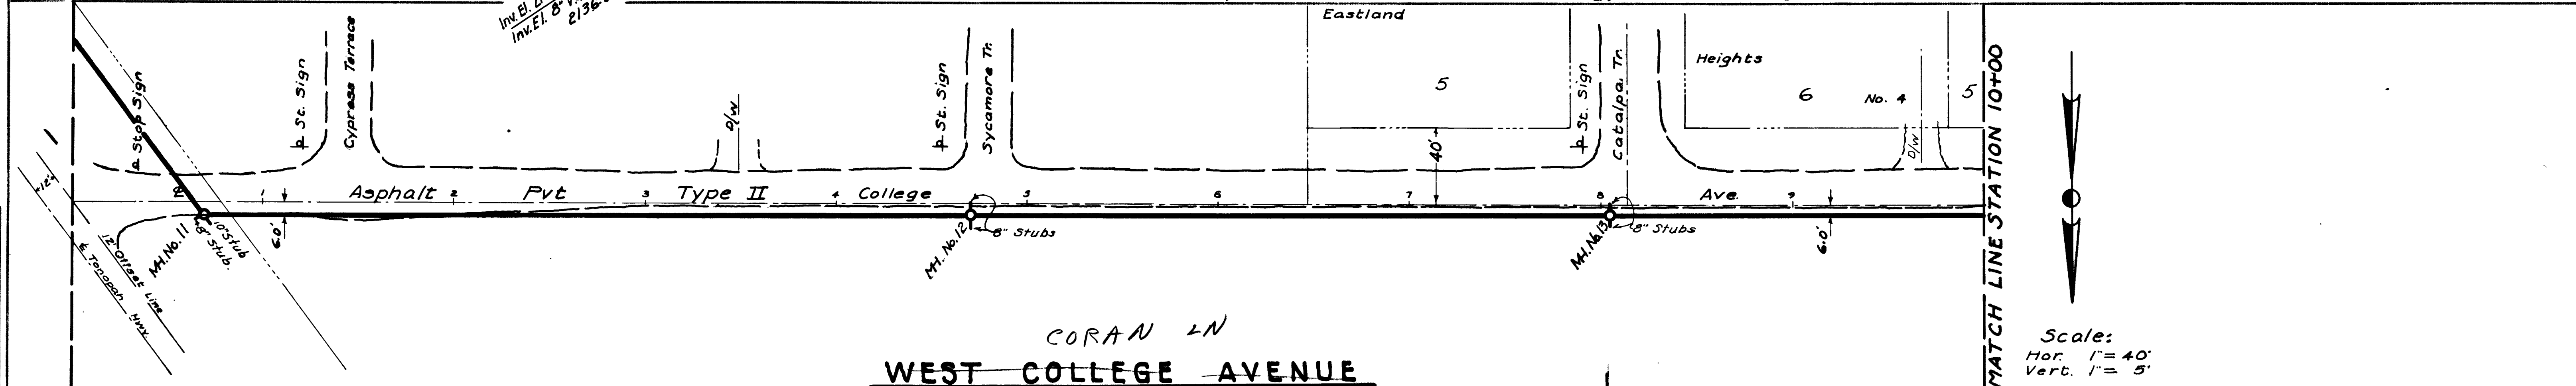
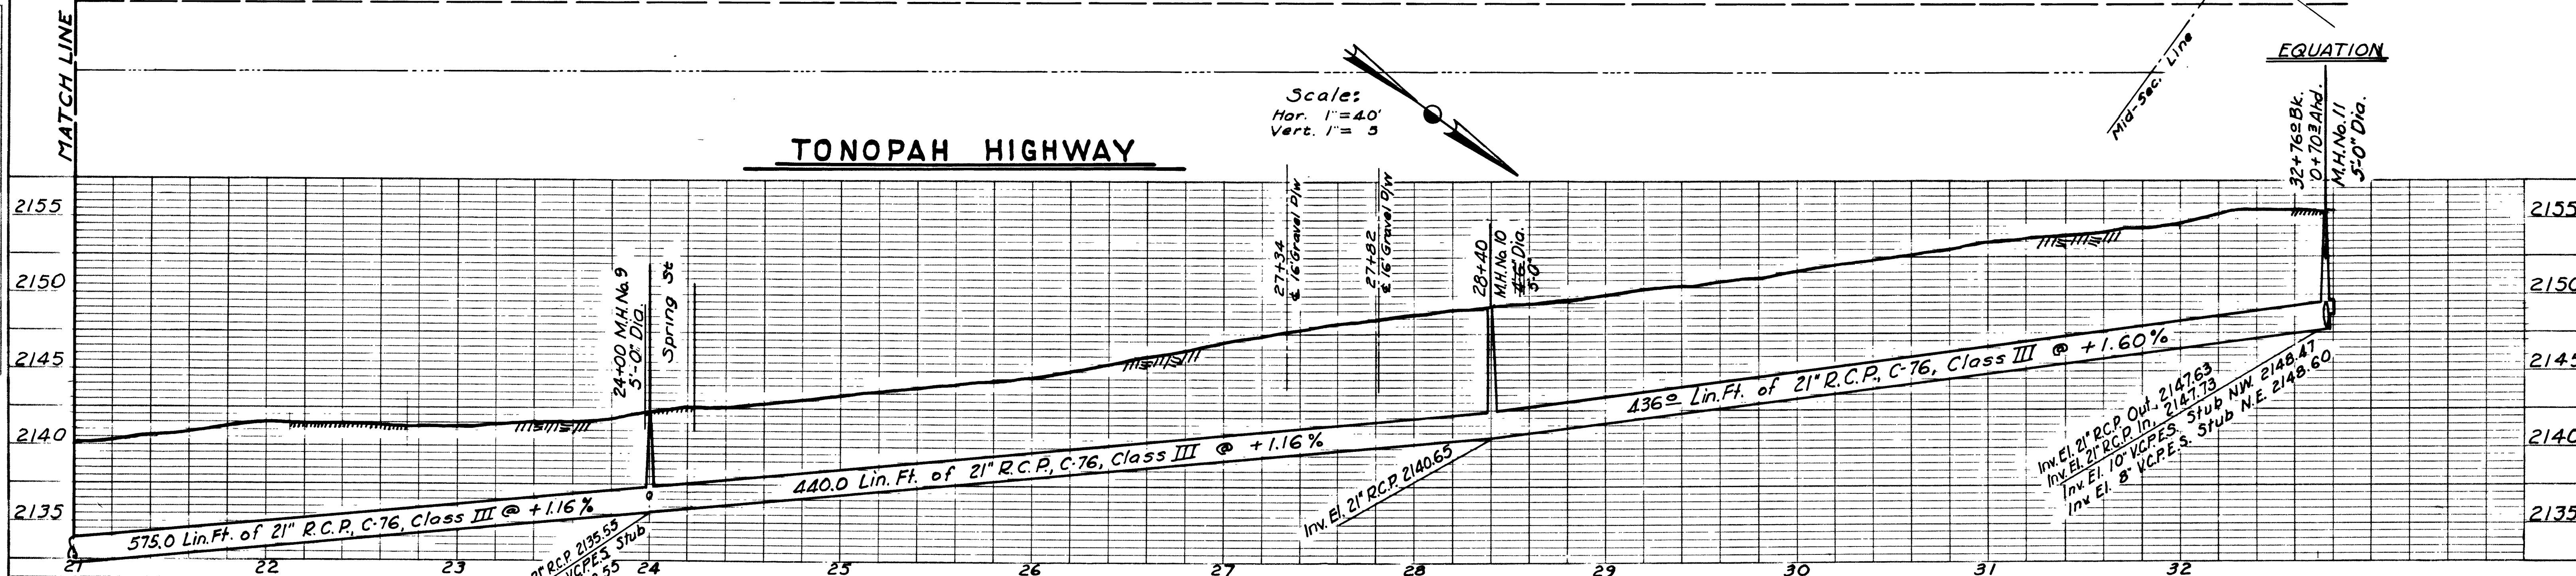


DATE	
BY	
PLAN	
NO.	
DATE	
BY	
PROFILE	
NO.	


DATE	
BY	
PROFILE	
NO.	

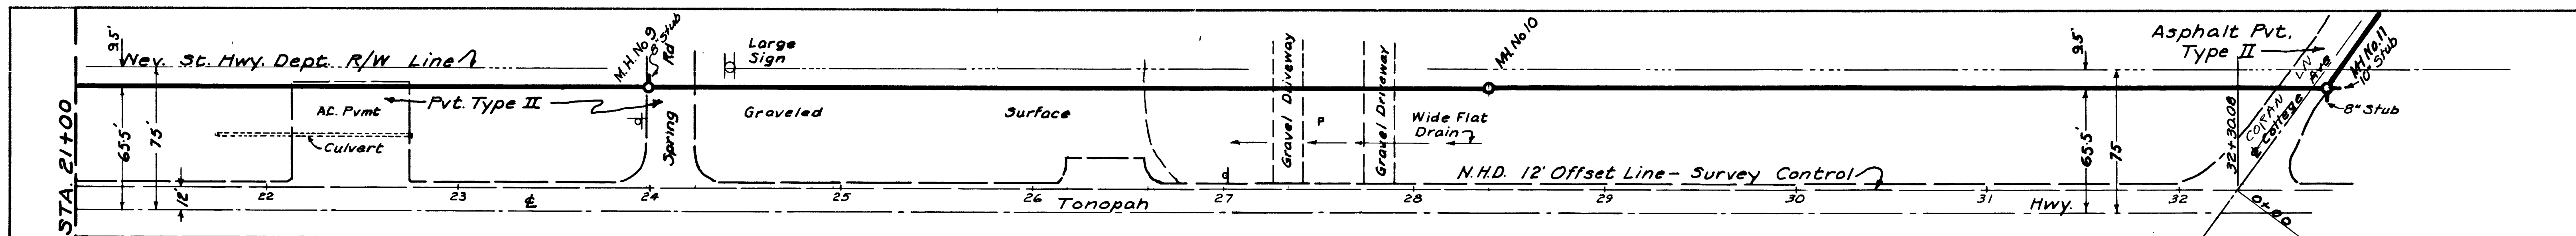

EQUATION
 $32+76.8 \text{ Bk. } 10+70 \text{ A.M. } 5-0 \text{\"/>$

Scales:
 Hor. 1" = 40'
 Vert. 1" = 5'

Scales:
 Hor. 1" = 40'
 Vert. 1" = 5'

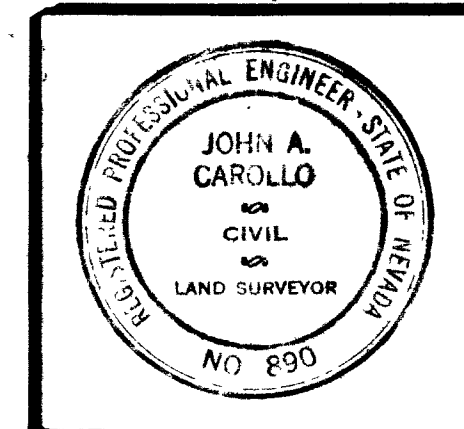

JOHN A. CAROLLO
 CONSULTING ENGINEERS
 PHOENIX, ARIZONA

LAS VEGAS NEVADA.
 TONOPAH HIGHWAY
 INTERCEPTOR SEWER

DESIGNED	GCW	CHECKED	GCW	DATE	7/1/62	AS BUILT	1/28/62
DRAWN	GCW	TRACED	DMT	REVIEWED	7/26/62	DATE	

NO. 3 of 11

