


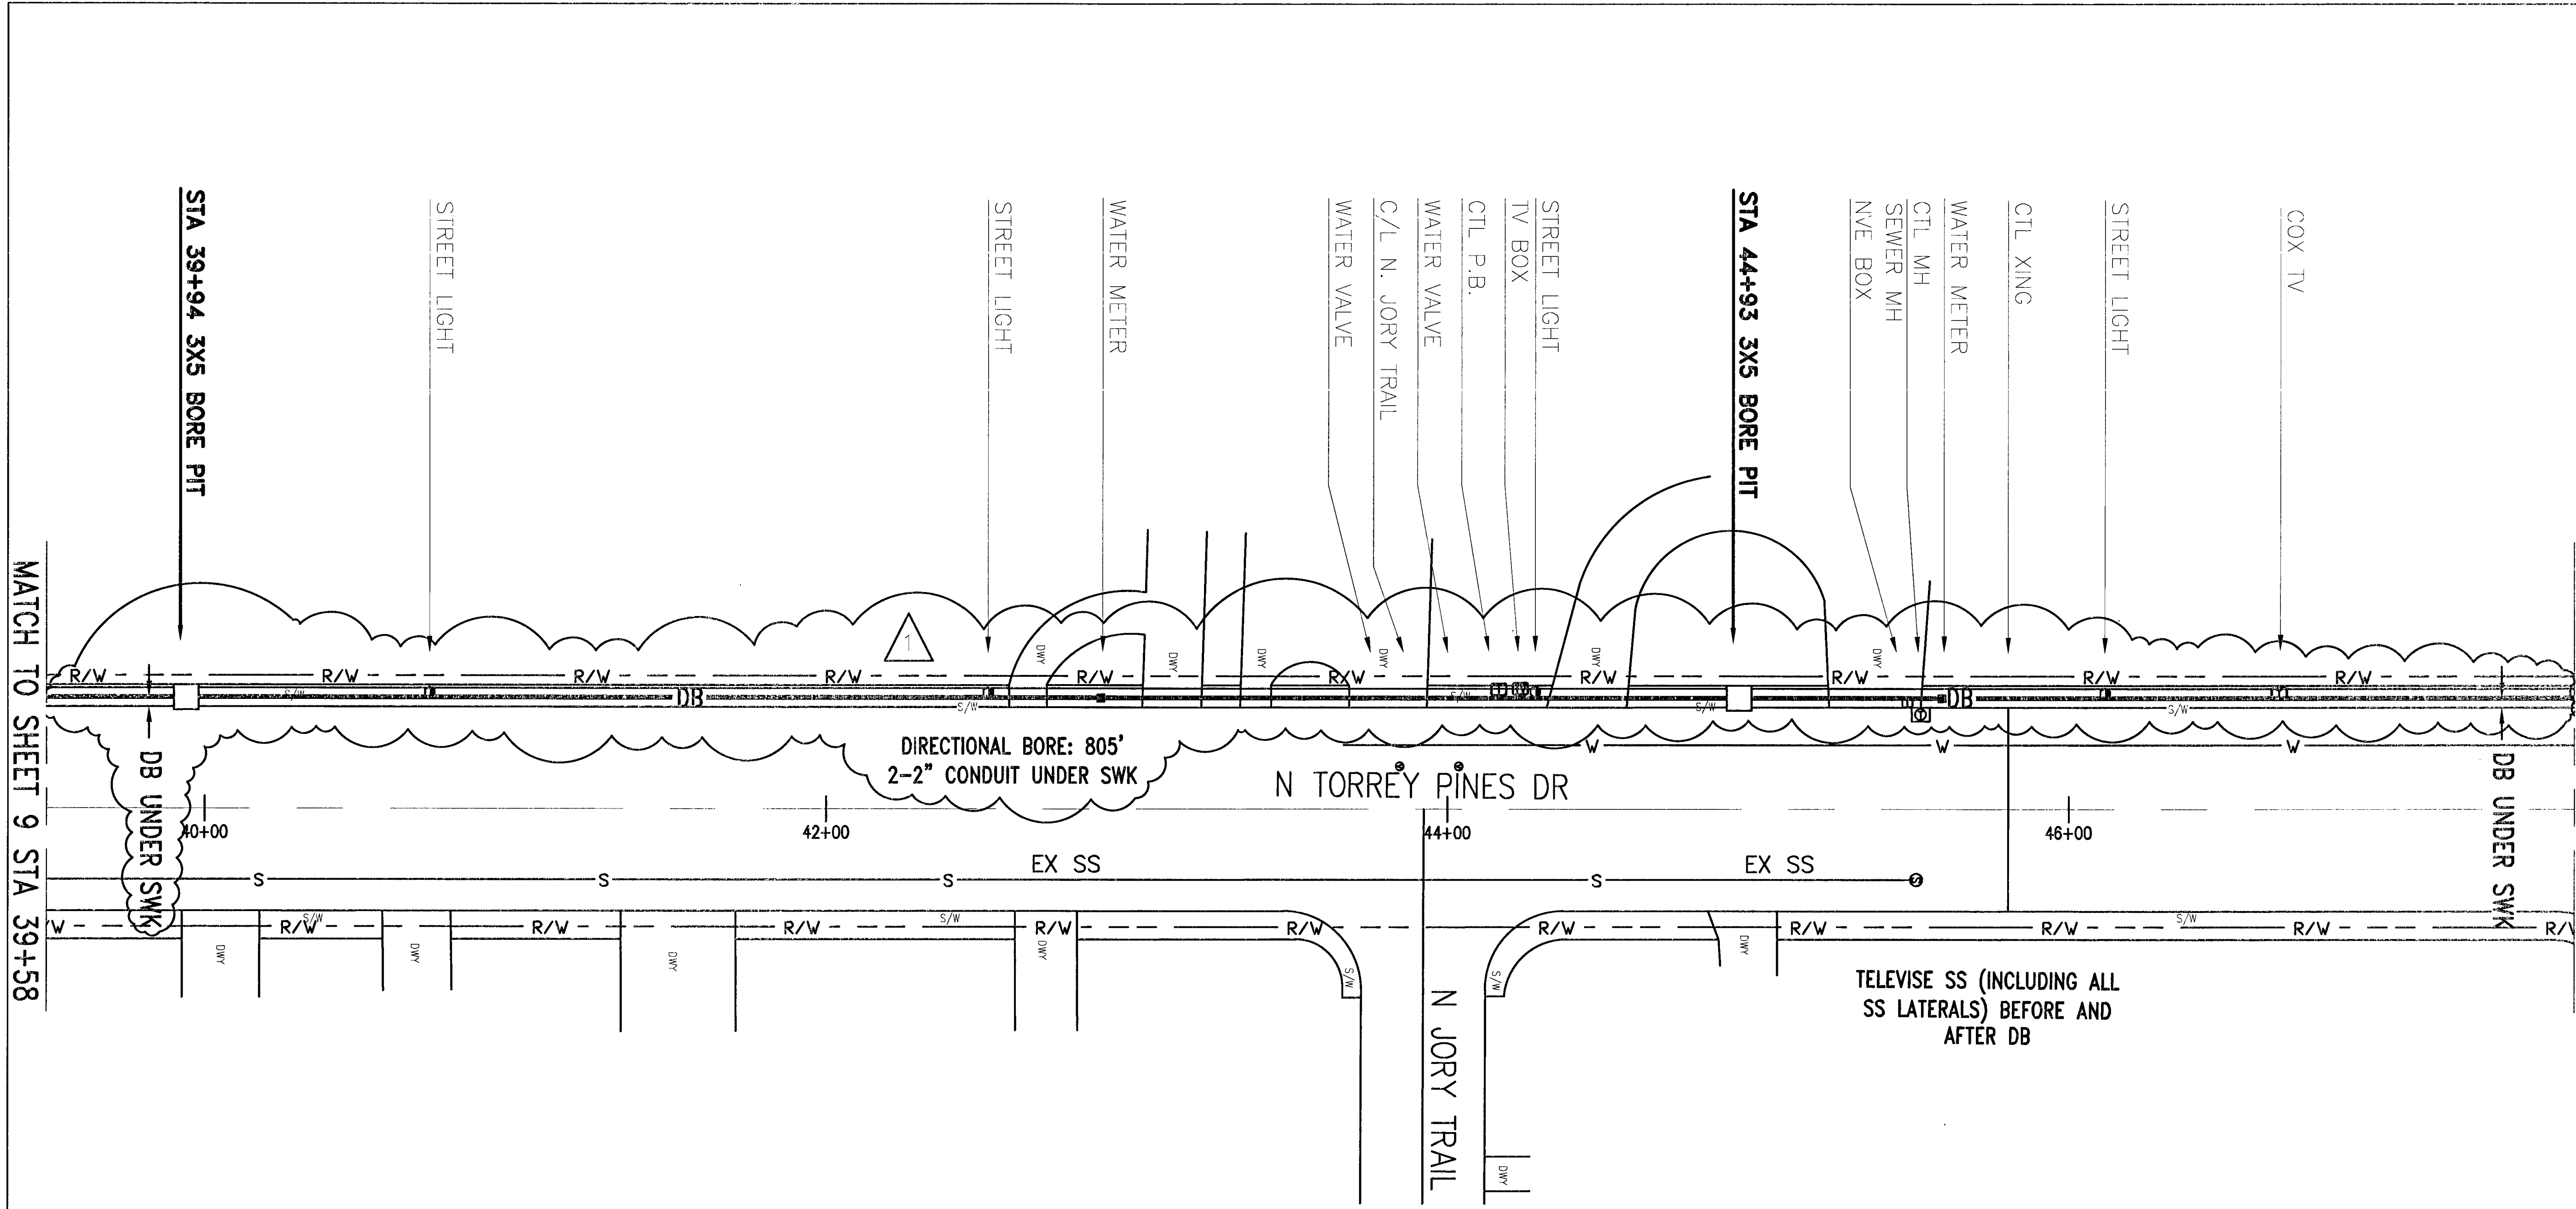

PROJECT: _____

SEG/SPAN: _____ SEG

FROM _____
TO _____
TO _____

SECTION: 11
TOWNSHIP: 20S
RANGE: 60E

Know what's below.
Call before you dig.

CenturyLink

TITLE: FIBER OPTIC CABLE ROUTE

N. TORREY PINES DR
GOWAN RD TO CRAIG RD

REVISIONS

DATE	DESCRIPTION	INITIAL
3/14	CHANGE ALIGNMENT	JW
	PK 3-13-14	

MP _____ TO MP _____

SHEET 10 OF 11

DWG. NO. _____
CTL E.422282

NOTE:
DUE TO EXISTING UTILITIES THE CONTRACTOR WILL AT VARIOUS TIMES NEED TO OPEN A WINDOW IN ASPHALT ROADWAY OR SIDEWALK TO DETERMINE EXISTING UTILITY DEPTHS. THE WINDOW WILL BE REPAIRED TO CITY SPECIFICATIONS AS DICTATED BY THE CITY INSPECTOR. POT HOLE LOCATIONS NOT SHOWN ON PLAN REQUIRE SEPARATE PERMIT.

PAGE NARRATIVE:
CONTINUE BORING NORTH ALONG N TORREY PINES DR A DISTANCE OF 805'.

RUS LIST	EST QTY	ACT QTY
BHF(30x60x30)T	-	
BORE PIT	2	
BFOV(2)(2)OT	-	
BM60(2-2)PD	805'	
BM73	10'	

REPLAT