


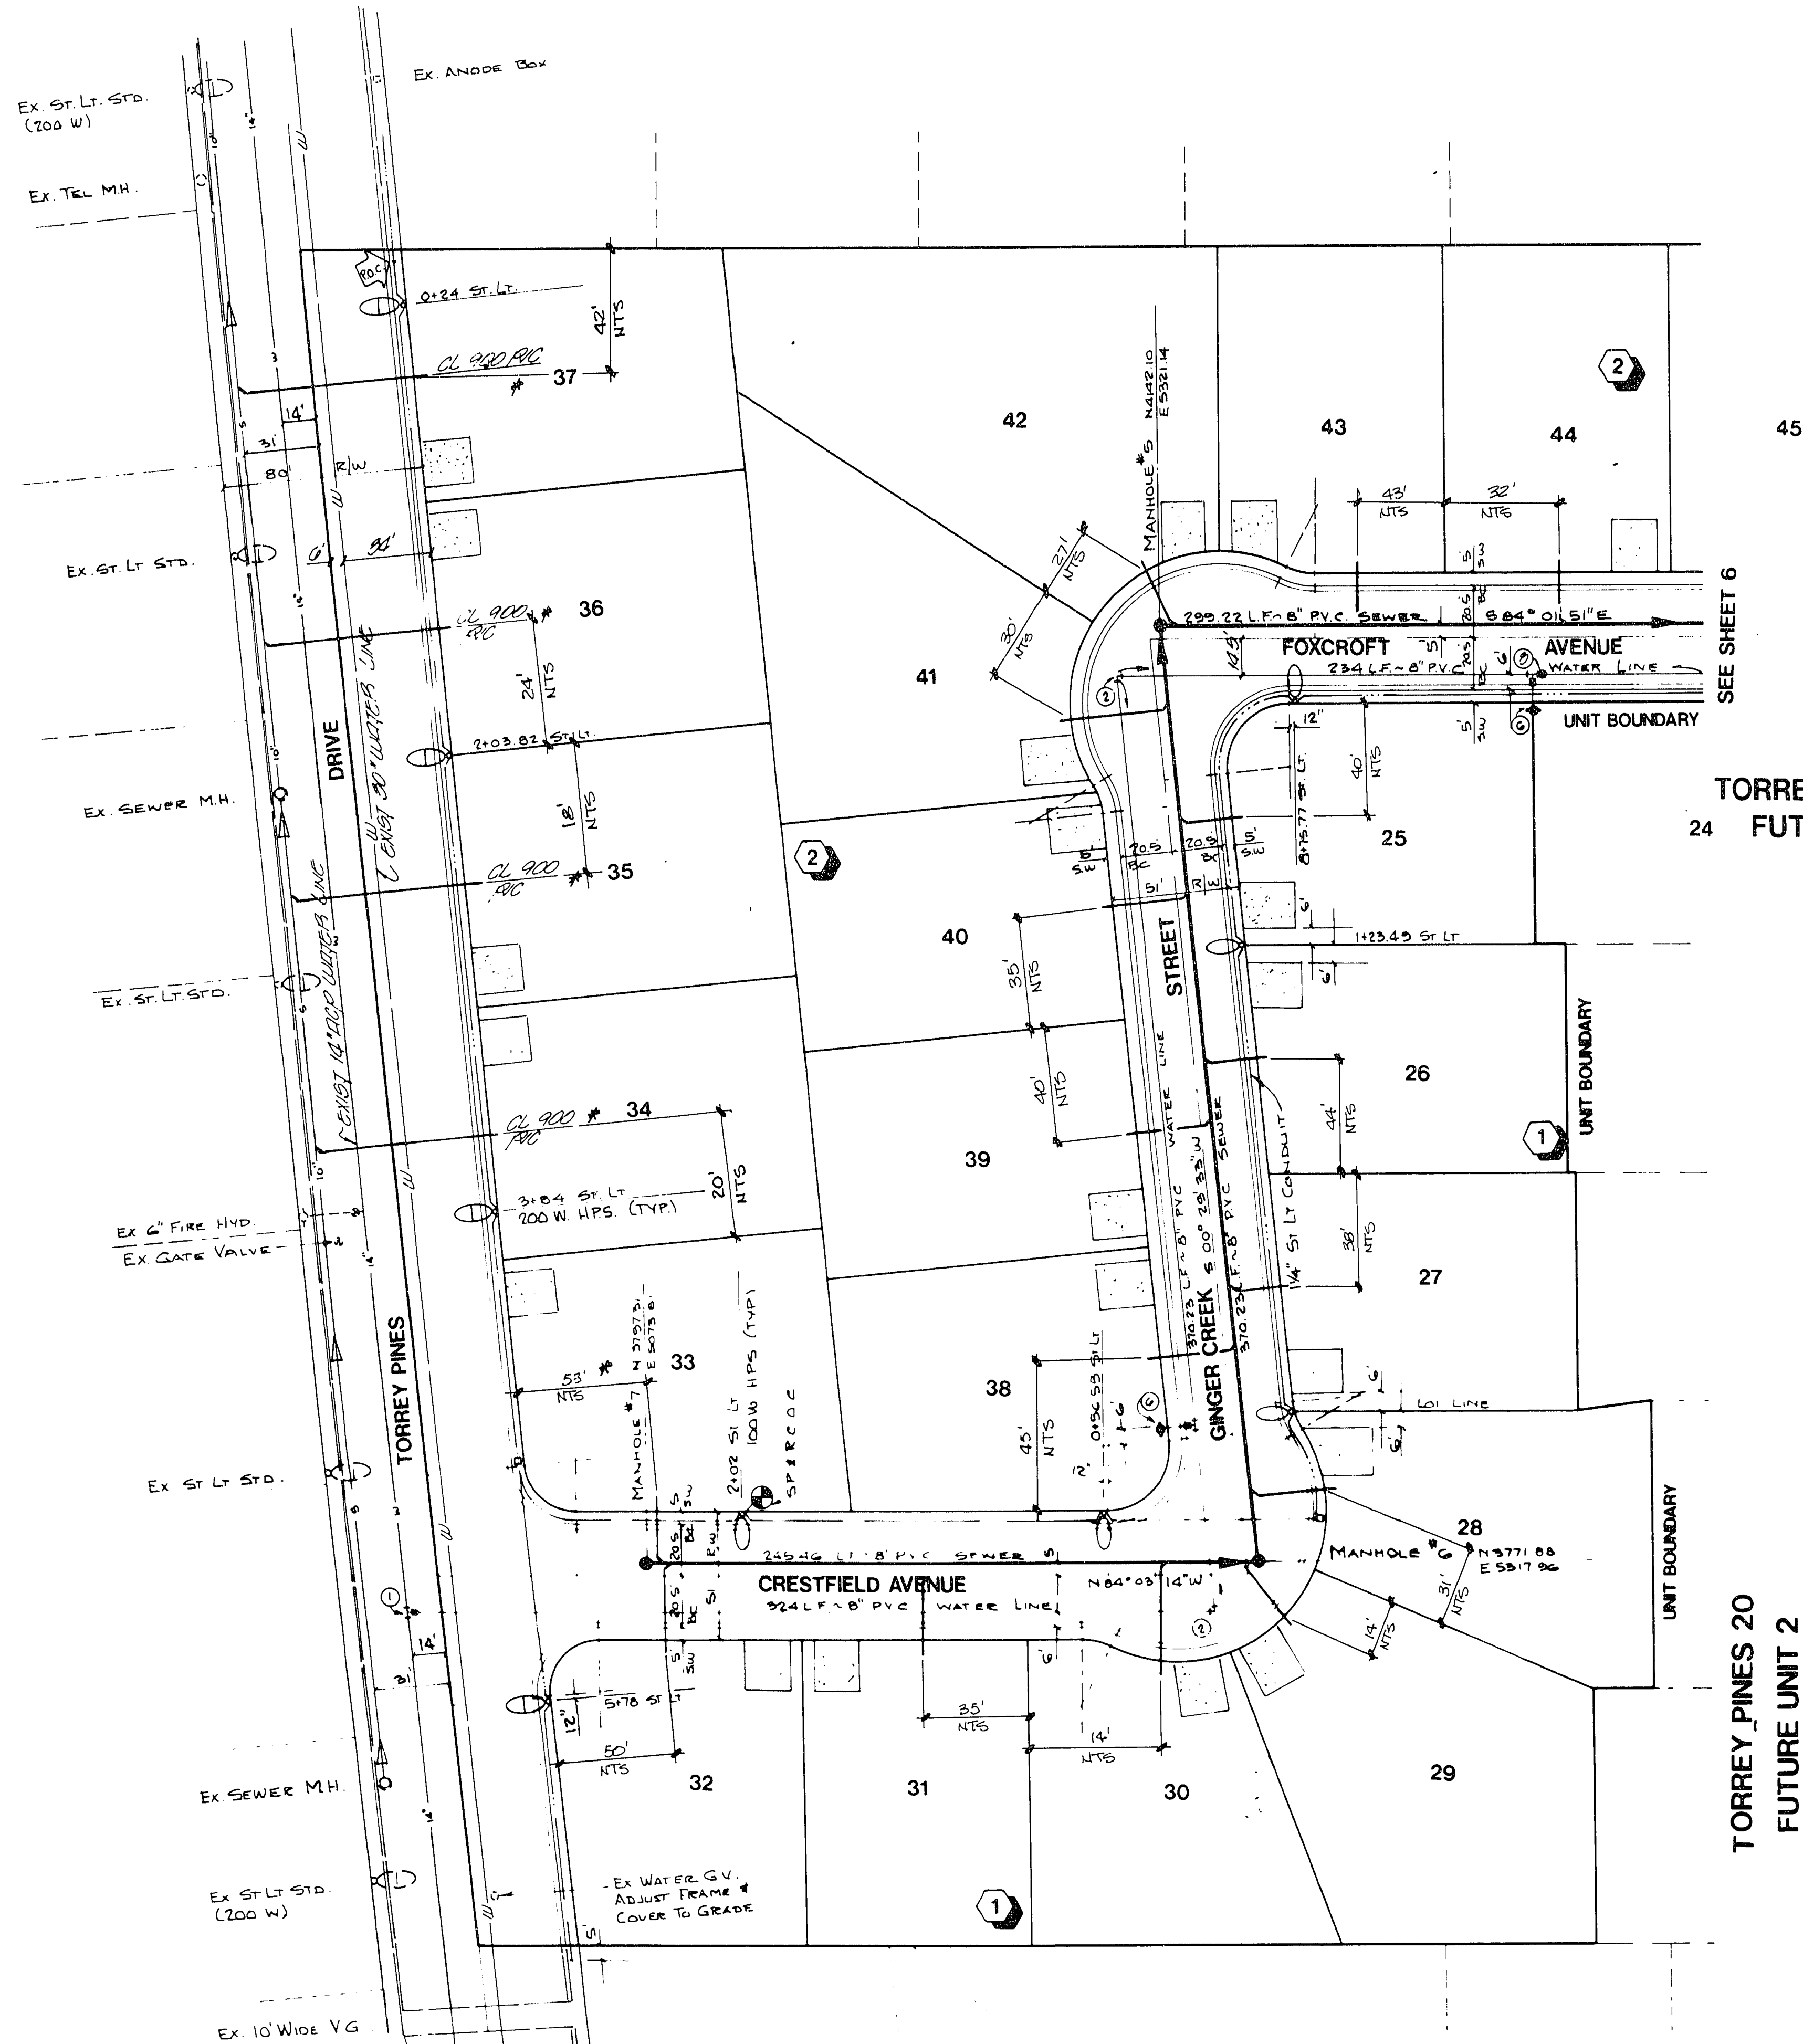

BENCHMARK


CITY OF LAS VEGAS BENCHMARK
1LV00-11NNE6
RIVET & PLATE IN TOP OF CURB AT THE
SOUTHWEST RETURN OF ALEXANDER ROAD
AND MAVERICK STREET.
ELEVATION = 2271.343

2 working
days
Call
before you
Dig
1-800-227-2800

**SEWER LATERAL "AS-BUILT"
CERTIFICATION**

Stephen P. Gurlides
8/10/95
STEPHEN P. GURLIDES, P.L.S.
NEVADA CERT. NO.: 9105

APPROVED FOR CONSTRUCTION
[Signature] 6/01/94
LWVWD DATE

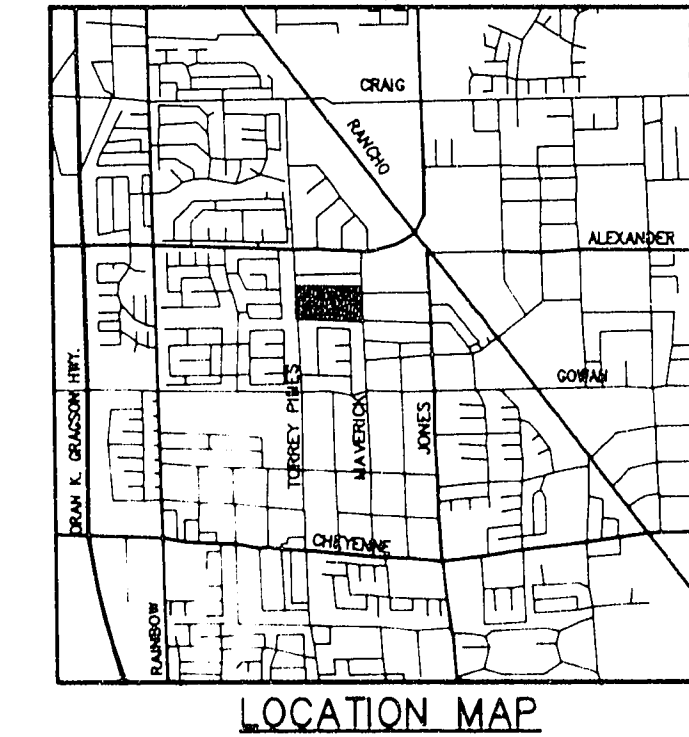

SEWER LATERAL AS-BUILT

PROJECT
TORREY PINES 20
UNIT 1

WO NO. **4589-1**
BY **EEB/KFN**
DATE **MARCH 94**
SCALE **1" = 40'**
SHEET **7** OF 11 SHEETS

DESERT PINE PROPERTY
CITY OF LAS VEGAS, NEVADA



CONSULTING ENGINEERS • PLANNERS • LAND SURVEYORS
2727 SOUTH RAINBOW BOULEVARD
LAS VEGAS, NEVADA 89102-5148 PHONE (702) 873-7550 FAX (702) 362-2597

11-13-15 "As Built" 3074-4324-1