
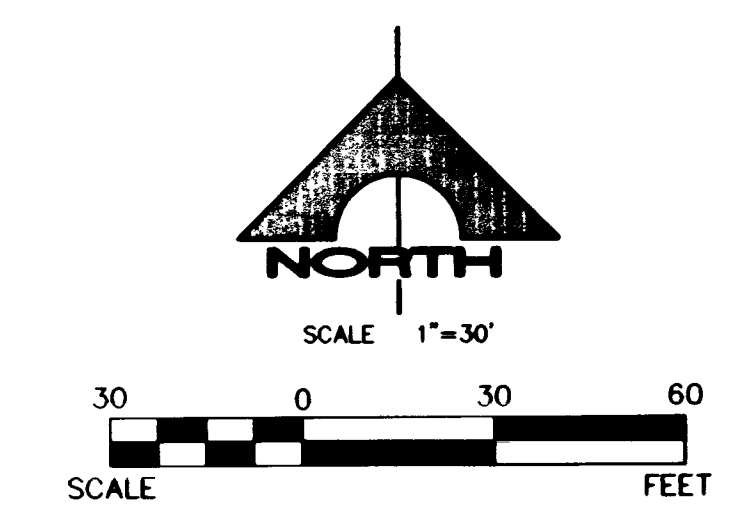


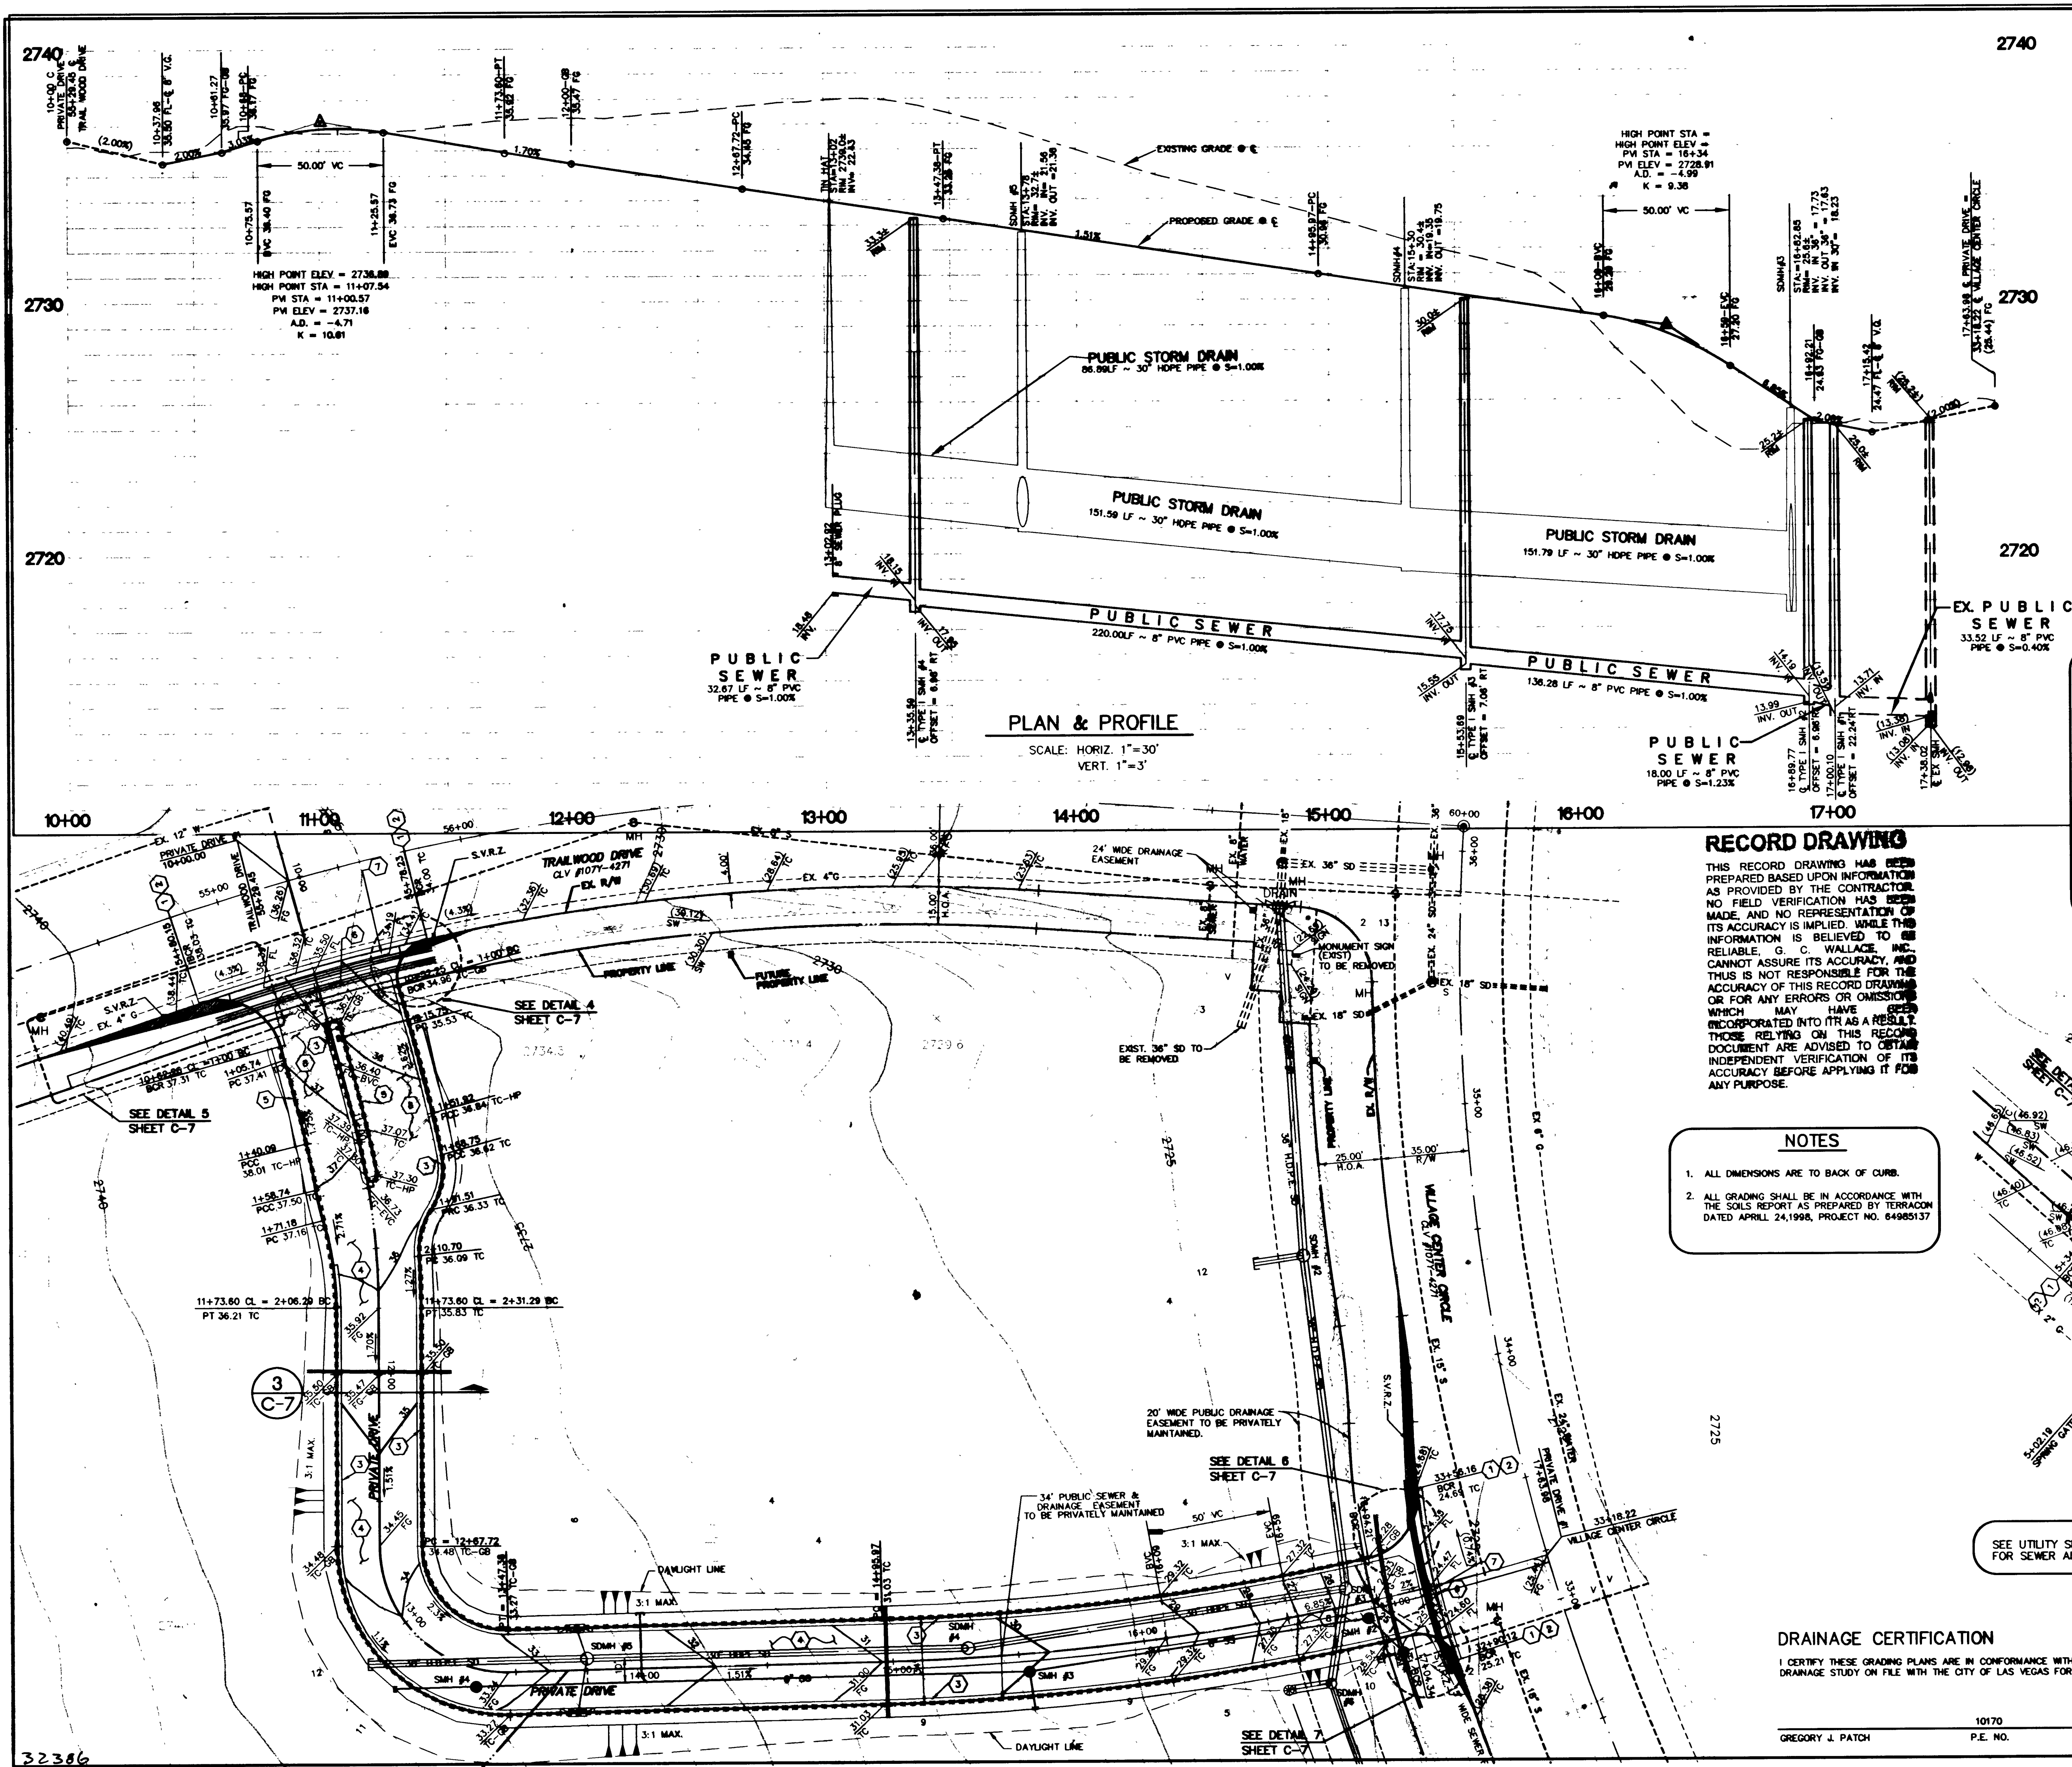


PLAN & PROFILE  
SCALE: HORIZ. 1"=30'  
VERT. 1"=3'

**RECORD DRAWING**  
THIS RECORD DRAWING HAS BEEN PREPARED BASED UPON INFORMATION AS PROVIDED BY THE CONTRACTOR. NO FIELD VERIFICATION HAS BEEN MADE, AND NO REPRESENTATION OF ITS ACCURACY IS IMPLIED. WHILE THIS INFORMATION IS BELIEVED TO BE RELIABLE, G. C. WALLACE, INC. CANNOT ASSURE ITS ACCURACY, AND THIS IS NOT RESPONSIBLE FOR THE ACCURACY OF THIS RECORD DRAWING OR FOR ANY ERRORS OR OMISSIONS WHICH MAY HAVE BEEN INCORPORATED INTO IT AS A RESULT. THOSE RELYING ON THIS RECORD DOCUMENT ARE ADVISED TO OBTAIN INDEPENDENT VERIFICATION OF ITS ACCURACY BEFORE APPLYING IT FOR ANY PURPOSE.

- NOTES**
1. ALL DIMENSIONS ARE TO BACK OF CURB.
  2. ALL GRADING SHALL BE IN ACCORDANCE WITH THE SOILS REPORT AS PREPARED BY TERRACON DATED APRIL 24, 1998, PROJECT NO. 64985137.

- GRADING NOTES**
1. SAWCUT EXISTING CURB & MATCH. CONTRACTOR SHALL VERIFY EXISTING CURB ELEVATION AND REPORT ANY DISCREPANCIES TO THE ENGINEER PRIOR TO COMMENCEMENT OF CONSTRUCTION.
  2. CONSTRUCT COMMERCIAL DRIVEWAY & 8' WIDE VALLEY GUTTER PER SUMMERLIN DWG NO. S-61, AND S-64.
  3. CONSTRUCT "L" TYPE CURB PER SUMMERLIN DWG. S-47.
  4. CONSTRUCT 3" AC PAVING OVER 4" TYPE II AGGREGATE BASE OVER COMPACTED SUBGRADE PER DETAIL 1, SHEET C-7. SEE SOILS REPORT PREPARED BY TERRACON DATED APRIL 24, 1998, PROJECT NO. 64985137 FOR MORE INFORMATION.
  5. CONSTRUCT TYPE "A" CURB PER DETAIL 2, SHEET C-7.
  6. EXISTING SIDEWALK TO BE REMOVED.
  7. EXISTING TREES TO BE REMOVED BY OWNER PRIOR TO DEMOLITION.
  8. CONSTRUCT DECORATIVE PAVING, SEE LANDSCAPE PLANS FOR EXACT LOCATION, COLOR, AND FINISH.

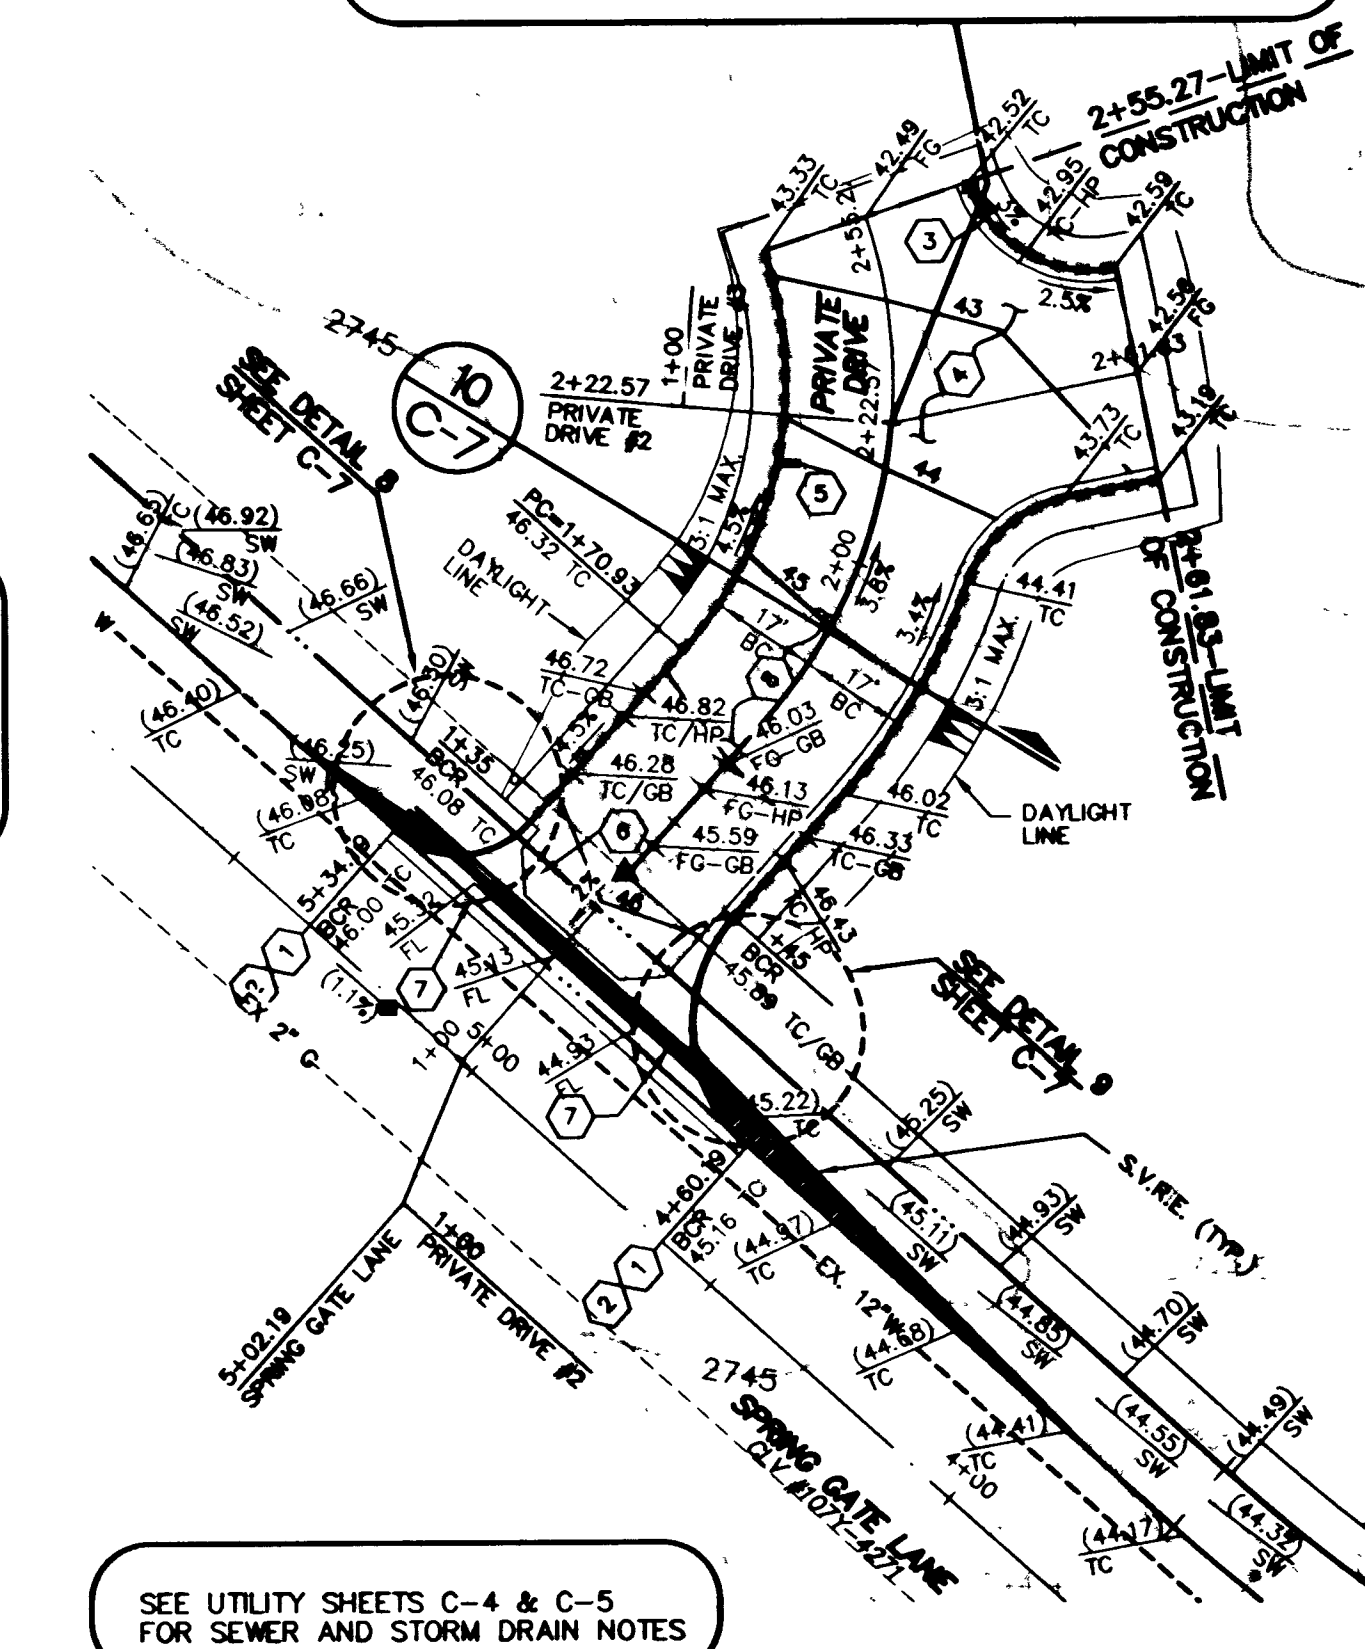

**DRAINAGE CERTIFICATION**  
I CERTIFY THESE GRADING PLANS ARE IN CONFORMANCE WITH THE APPROVED DRAINAGE STUDY ON FILE WITH THE CITY OF LAS VEGAS FOR THIS PROJECT.

GREGORY J. PATCH  
P.E. NO. 10170  
DATE



**Call before you Dig.**  
1-800-227-2600  
UNDERGROUND SERVICE (US)

THE HOWARD HUGHES CORPORATION  
Parcel E  
SHEET  
**C-2**  
2 OF 2 SHTS

G. C. WALLACE, INC.  
Engineers/Planners/Surveyors  
1555 SOUTH RAINBOW BLVD. LAS VEGAS, NEVADA 89146  
TELEPHONE: (702) 804-2000 FAX: (702) 804-2299  
E-MAIL: G.WALLACE@GWCORP.COM

| DATE     | REVISION | DESCRIPTION        |
|----------|----------|--------------------|
| 12/03/00 | REV. 1   | REVISED ELEVATIONS |
| 12/03/00 | REV. 2   | REV. DATE          |