

KEY MAP

SCALE: NTS


- NOTES:
 1. SEE SHEET L3.00 FOR PLANTING LEGEND
 2. SEE SHEETS L3.04 FOR PLANTING DETAILS

**RECORD DRAWINGS
 NOT FOR CONSTRUCTION**


1. TO ALTER THESE DOCUMENTS FOR ANOTHER PROJECT BY ANYONE OTHER THAN THE ORIGINAL ARCHITECT IS A VIOLATION OF NRS 623.

2. THIS RECORD DRAWING HAS BEEN PREPARED IN PART, BASED UPON INFORMATION FURNISHED BY THE GENERAL CONTRACTOR, WHILE THIS INFORMATION IS BELIEVED TO BE RELIABLE, THE DESIGN PROFESSIONAL CANNOT ASSURE ITS ACCURACY, AND THIS IS NOT RESPONSIBLE FOR THE ACCURACY OF THIS RECORD DRAWING OR FOR ANY ERRORS OR OMISSIONS WHICH MAY HAVE BEEN INCORPORATED INTO IT AS A RESULT. THE DESIGN PROFESSIONAL CANNOT AND DOES NOT WARRANT THEIR ACCURACY.

3. INFORMATION THAT MAY BE INCLUDED WOULD BE SIGNIFICANT CHANGES TO PLANTING OR IRRIGATION LAYOUT PLANS AND ASSOCIATED DRAWINGS, MINOR DIMENSION OR CONSTRUCTION DETAIL CHANGES MAY NOT BE INCLUDED.

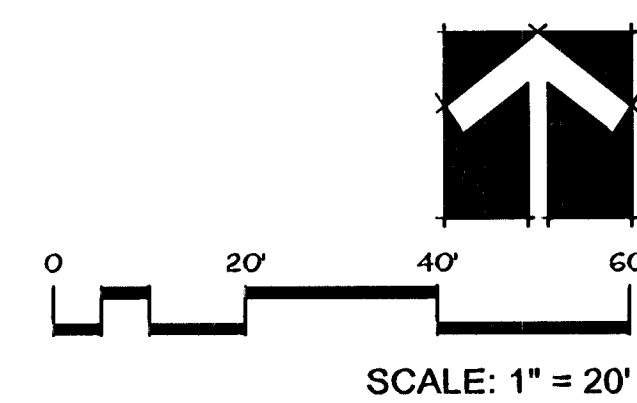


SCALE: 1" = 20'

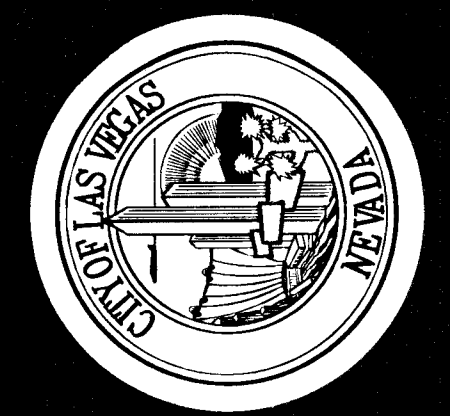

REVISIONS
 RECORD DRAWING 3-17-11
 REVISED PER AS-BUILTS
 PROVIDED BY JNJ 4-27-11

CONSULTANT
 southwick LA
 702.897.3108
 12 Commerce Center Drive
 Henderson, NV, 89014
 www.southwickla.com

CITY OF LAS VEGAS
 TROPICAL DURANGO PARK PHASE 1 AND 2
 NORTHWEST CORNER OF TROPICAL PKWY. & DURANGO
 PLANTING PLAN

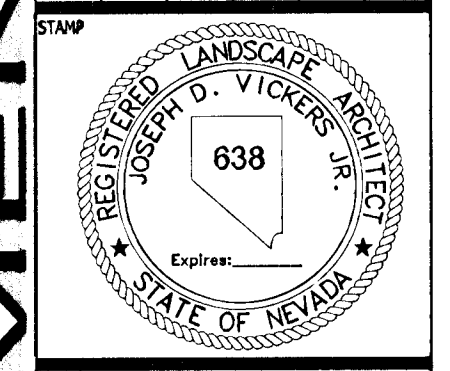

OWNER: CITY OF LAS VEGAS
 DEPARTMENT OF PUBLIC WORKS

400 EAST STEWART AVENUE
 LAS VEGAS, NEVADA 89101
 PHONE: (702) 229-6535
 FAX: (702) 386-4546
 TDD: (702) 386-9108

DRAWN: ESJ/JDY
 FILE: 09-019
 DATE: March 2010
 SCALE: 1"=20'
 BID NO: 09.15341.03
 CLV DWG NO: 650.103
 HANSEN NO: XXX

SHEET NO
L3.03

127010

DRAWINGS AS INSTRUMENTS OF SERVICE ARE THE PROPERTY OF THE DESIGN PROFESSIONAL. THESE DRAWINGS ARE NOT TO BE REPRODUCED OR COPIED IN ANY MANNER WITHOUT THE WRITTEN CONSENT OF THE DESIGN PROFESSIONAL. THESE DRAWINGS ARE NOT TO BE USED FOR ANY OTHER PROJECT WITHOUT THE WRITTEN CONSENT OF THE DESIGN PROFESSIONAL.