

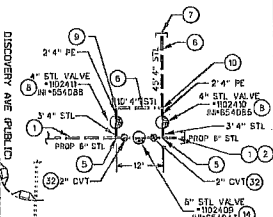


WR-722929
DETAIL "A"
(NOT TO SCALE)

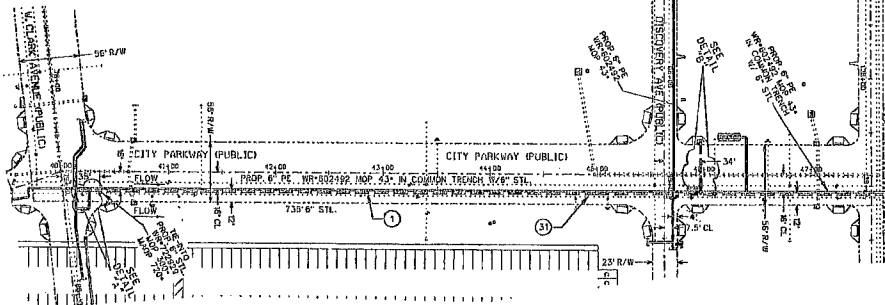

DETAIL "B"
(NOT TO SCALE)

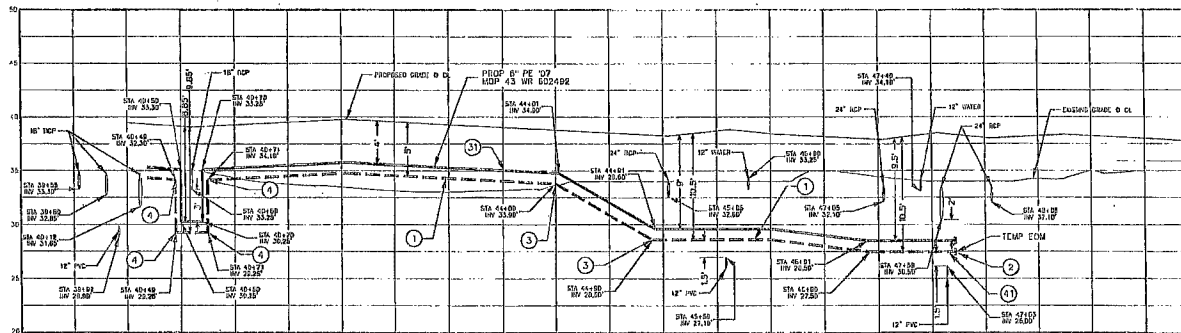

CITY PARKWAY
SCALE: HORIZ. 1"=40'
VERT. 1"=4'



SYSTEM: F008-125
PA. NO. 86247332-120
SHEET NO. 3 OF 3
DATE: 4/15/07

I HEREBY CERTIFY THAT THE INFORMATION CONTAINED HEREIN IS TRUE AND CORRECT TO THE BEST OF MY KNOWLEDGE AND BELIEF.
DATE: 4/15/07
SIGNATURE: [Signature]

AS-BUILT DRAINING-PRESSURE TEST DATA

PIPE DIA.	TEST METHOD	TEST RESULT
18" PVC	100% WATER	100% PASS
18" PVC	100% AIR	100% PASS
18" PVC	100% GAS	100% PASS

VISUAL INSPECTION CERTIFICATION

LINE NUMBER	INSPECTOR	DATE
1	125-27	4/15/07
2	125-27	4/15/07
3	125-27	4/15/07

CONSTRUCTION

CONTRACT NO.	W. R. NO.
125-27	629406
125-27	629406
125-27	629406

CUSTOMER: SGA CYCLE ROUTE: AREA 38, LV 21

SUB. TECH. UTIL. BUREAU PHONE 265-2173

PROJECT NO. 125-27-120 PHONE 265-2173

PROJECT NO. 125-27-120 PHONE 265-2173

SCALE: 1" = 40' DATE: 4/15/07

UNION PARK 6" STL PH1

GRAND CENTRAL & BONNEVILLE



12/862

107V4816-1-SWG-3