
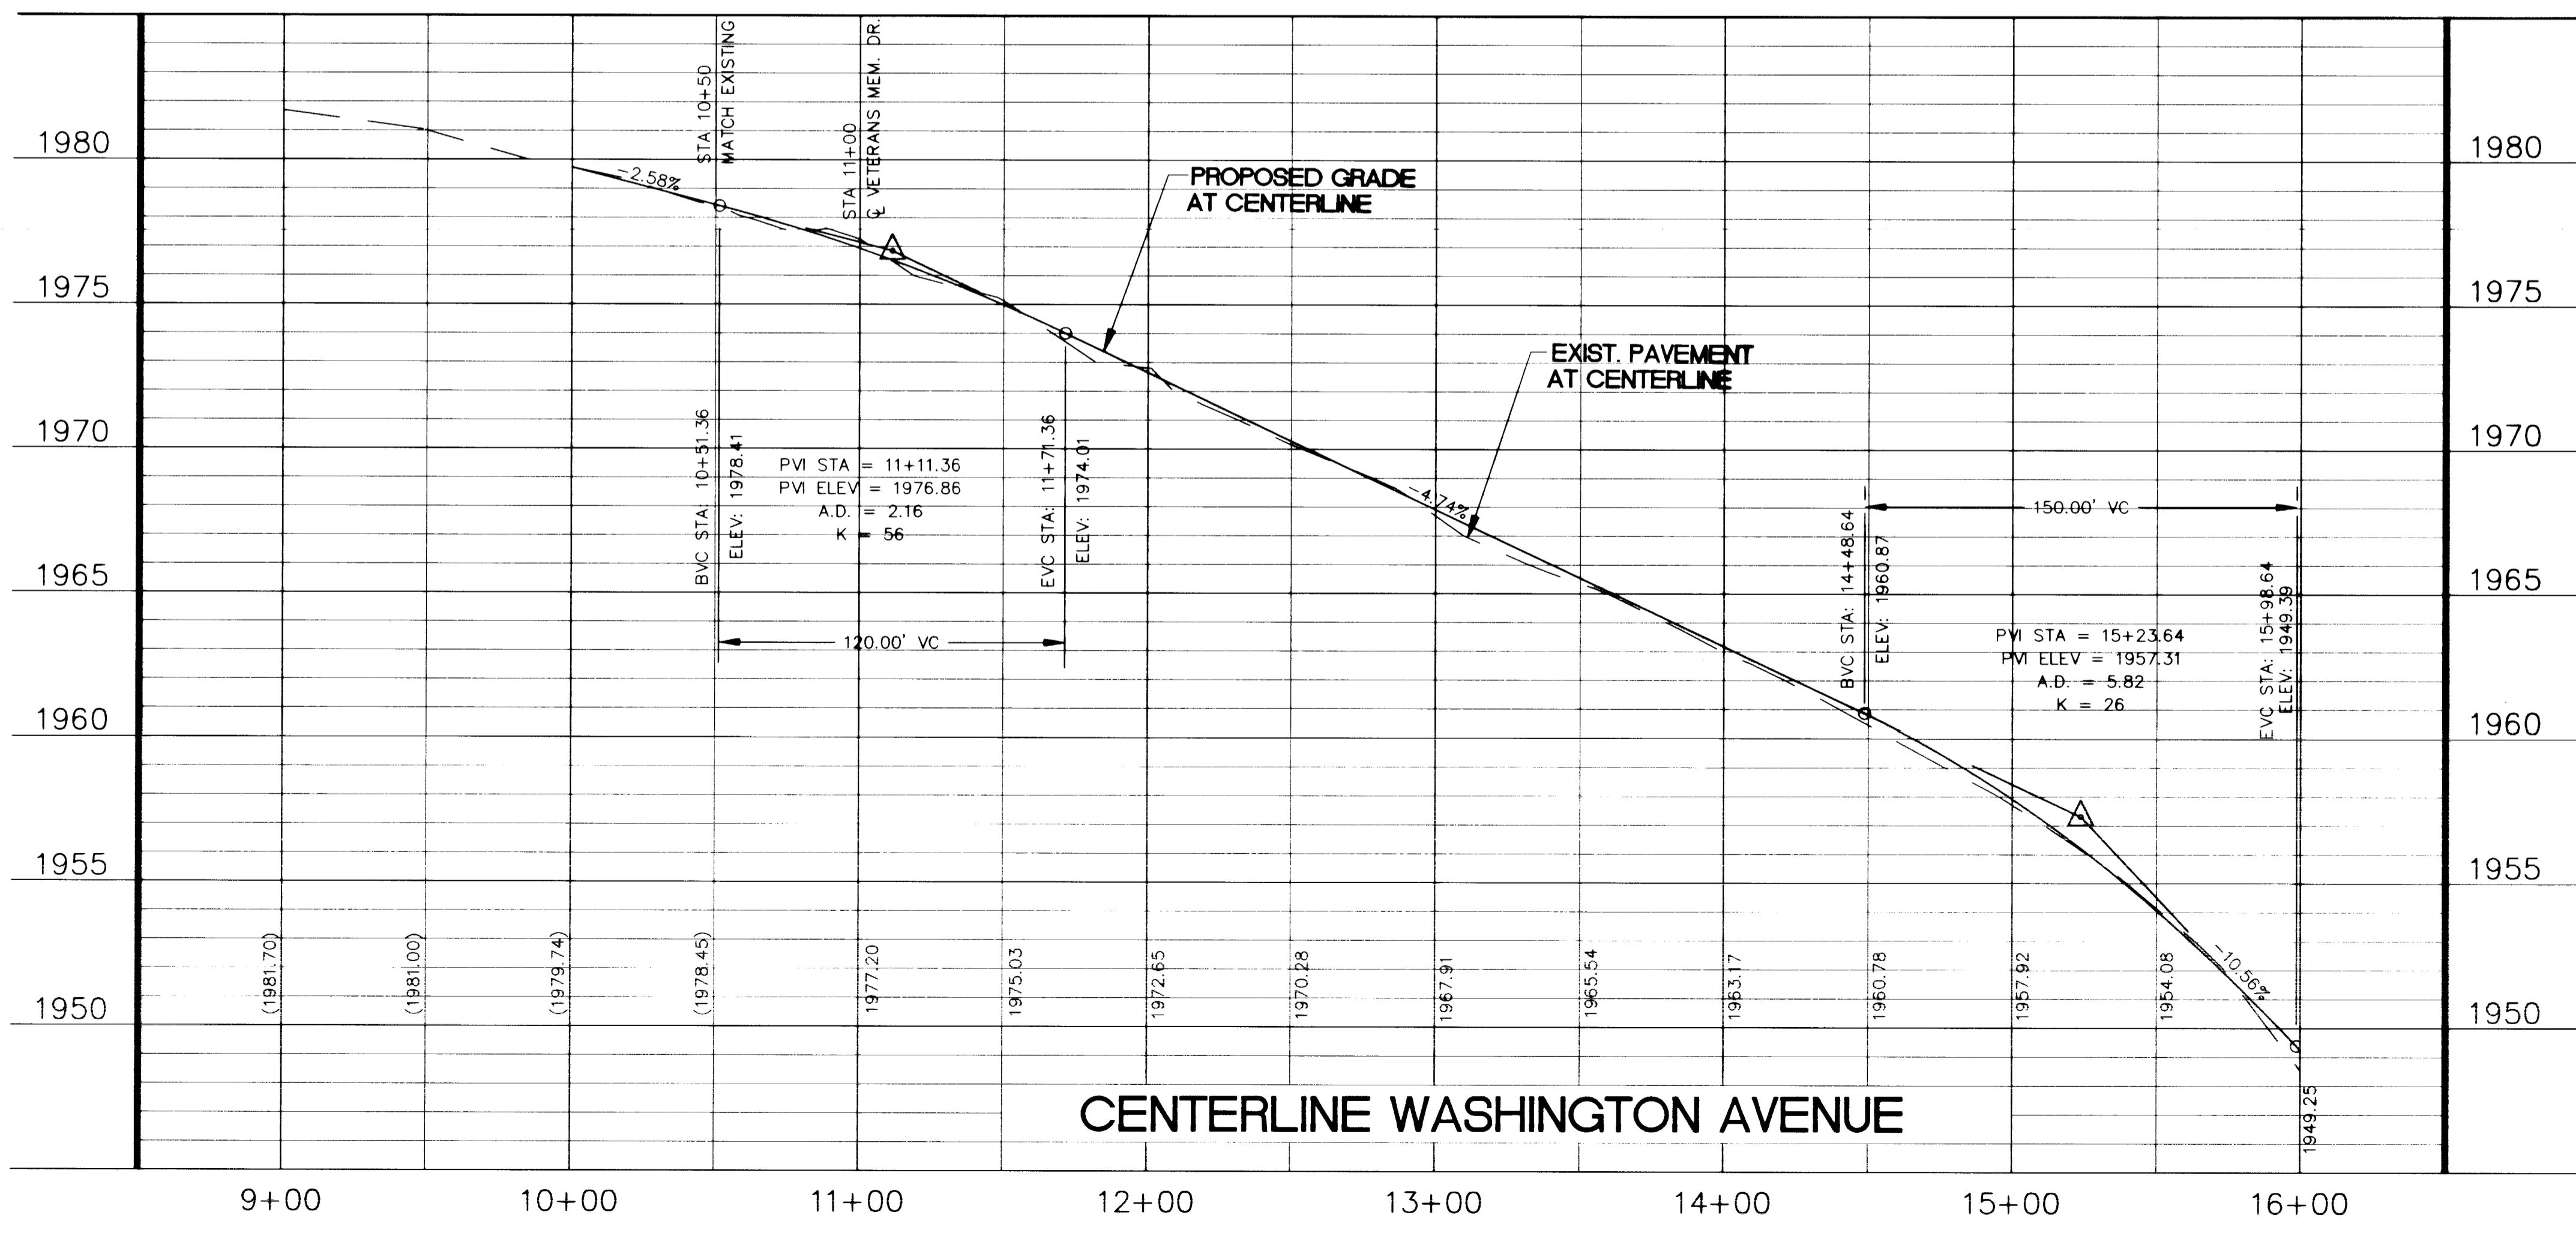


**CONSTRUCTION NOTES**

- ① REMOVE & REPLACE EXISTING AC PAVEMENT FOR 100' R/W, WITHOUT MEDIAN PER USD NO. 203. (SEE SHT PS FOR DETAILS)
- ⑤ VERTICAL ADJUST WATER VALVE COVER.
- ⑥ VERTICAL ADJUST MANHOLE.
- ⑩ SAWCUT AC, ACTUAL LOCATION TO BE DETERMINED BY THE ENGINEER AT TIME OF CONSTRUCTION.

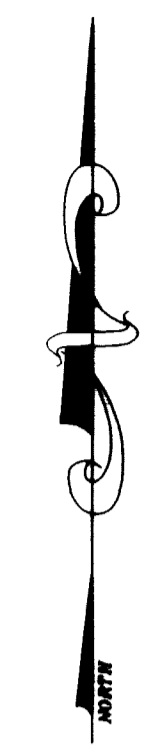

REVISIONS	
No.	Date

**RECORD DRAWING**  
 This drawing is a record drawing and is not to be used for construction. It is to be used for reference only. It is the responsibility of the engineer to verify the accuracy of the information shown on this drawing. It is not to be used for any other purpose without the written consent of the engineer.

DESIGNED: CSS  
 DRAWN: RP/JS  
 CHECKED: LHC  
 JOB No: 667-95  
 HORIZ: 1"=40'  
 VERT: 1"=4'  
 DATE: 12/01/98



**Carter Burgess**  
 Consultants in Engineering,  
 Planning and the Environment  
 2955 East Sunset Road, Suite 105  
 Las Vegas, NV 89120  
 (702) 798-1007 Fax: (702) 798-7056

PROJECT: CITY OF LAS VEGAS  
 UPPER WASHINGTON AVENUE CONVEYANCE SYSTEM  
 PHASE 1  
 DESCRIPTION: ROADWAY IMPROVEMENTS PLAN AND PROFILE  
 WASHINGTON AVE. STA. 10+00 TO 16+00  
 PROJECT NO. 98.1730.21-RC

DRAWING NO. 731-54E

SHEET PD3  
 28 OF 35

