



WASHINGTON AVENUE

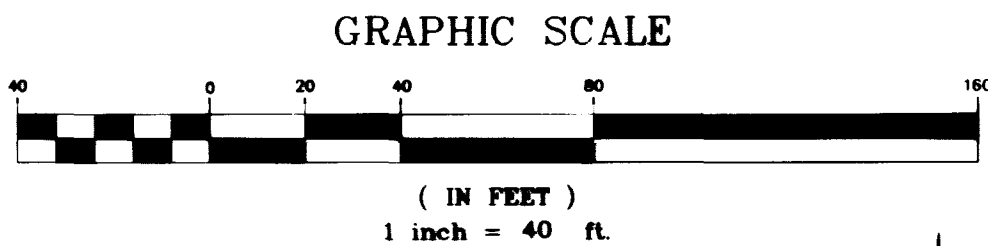

MATCH LINE STA. 24+00
SEE SHT NO PD4

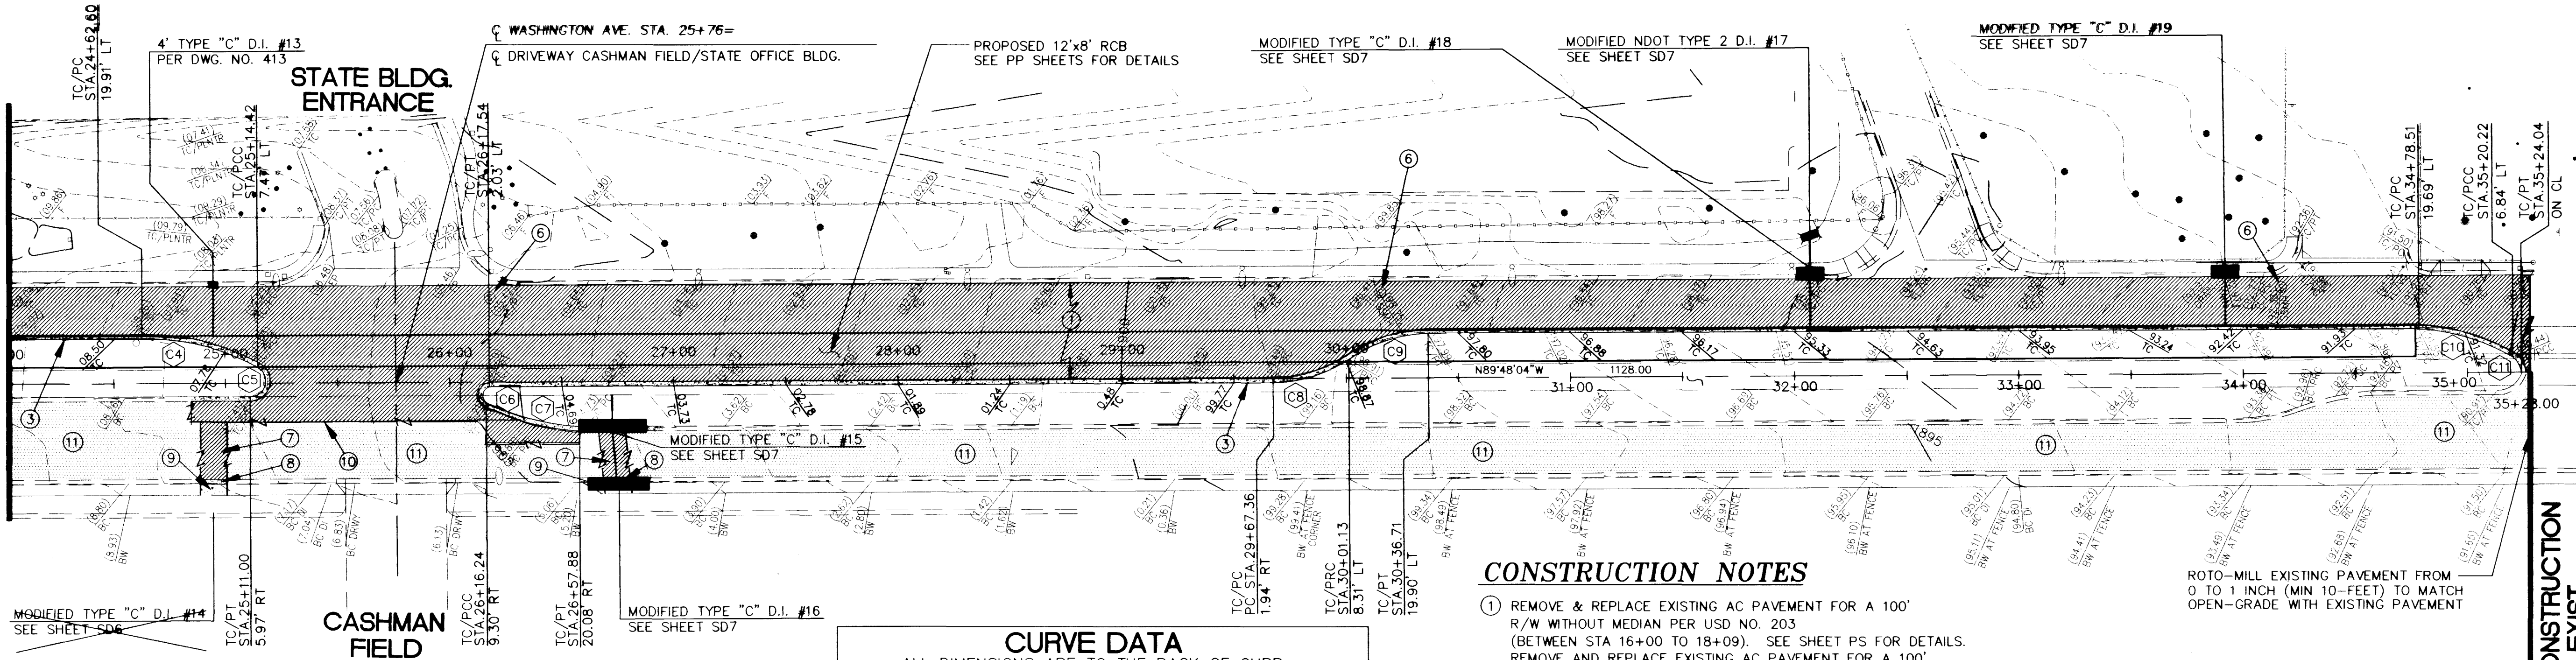


CURVE DATA				
ALL DIMENSIONS ARE TO THE BACK OF CURB				
CURVE	RADIUS	LENGTH	TANGENT	DELTA
C4	100.00'	54.02'	27.69'	30°57'04"
C5	7.00'	18.41'	26.76'	150°40'53"
C6	4.00'	10.86'	18.51'	155°36'36"
C7	120.00'	42.35'	21.40'	20°13'13"
C8	65.00'	35.74'	18.33'	31°30'08"
C9	65.00'	37.96'	19.54'	33°27'31"
C10	95.00'	44.04'	22.42'	26°33'37"
C11	11.00'	8.01'	4.19'	41°44'29"

CONSTRUCTION NOTES

- 1 REMOVE & REPLACE EXISTING AC PAVEMENT FOR A 100' R/W WITHOUT MEDIAN PER USD NO. 203 (BETWEEN STA 16+00 TO 18+09). SEE SHEET PS FOR DETAILS. REMOVE AND REPLACE EXISTING AC PAVEMENT FOR A 100' R/W WITH MEDIAN PER USD NO. 203 (BETWEEN STA 18+09 TO 35+28). SEE SHEET PS FOR DETAILS.
- 3 REMOVE & REPLACE EXISTING L-TYPE MEDIAN CURB & GUTTER PER USD NO. 219.
- 5 VERTICAL ADJUST WATER VALVE COVER.
- 6 VERTICAL ADJUST MANHOLE COVER.
- 7 RECONSTRUCT PER DWG NO. 504.
- 8 REMOVE AND REPLACE "L" TYPE CURB & GUTTER.
- 9 REMOVE & REPLACE SIDEWALK PER DWG NO. 234.
- 10 SAWCUT AC, ACTUAL LOCATION TO BE DETERMINED BY THE ENGINEER AT TIME OF CONSTRUCTION.
- 11 OVERLAY EXISTING PAVEMENT WITH 1-INCH PLANTMIX BITUMINOUS SURFACE OPEN-GRADE

ROTO-MILL EXISTING PAVEMENT FROM 0 TO 1 INCH (MIN 10- FEET) TO MATCH OPEN-GRADE WITH EXISTING PAVEMENT

END PAVEMENT RECONSTRUCTION
STA. 35+28 MATCH EXIST

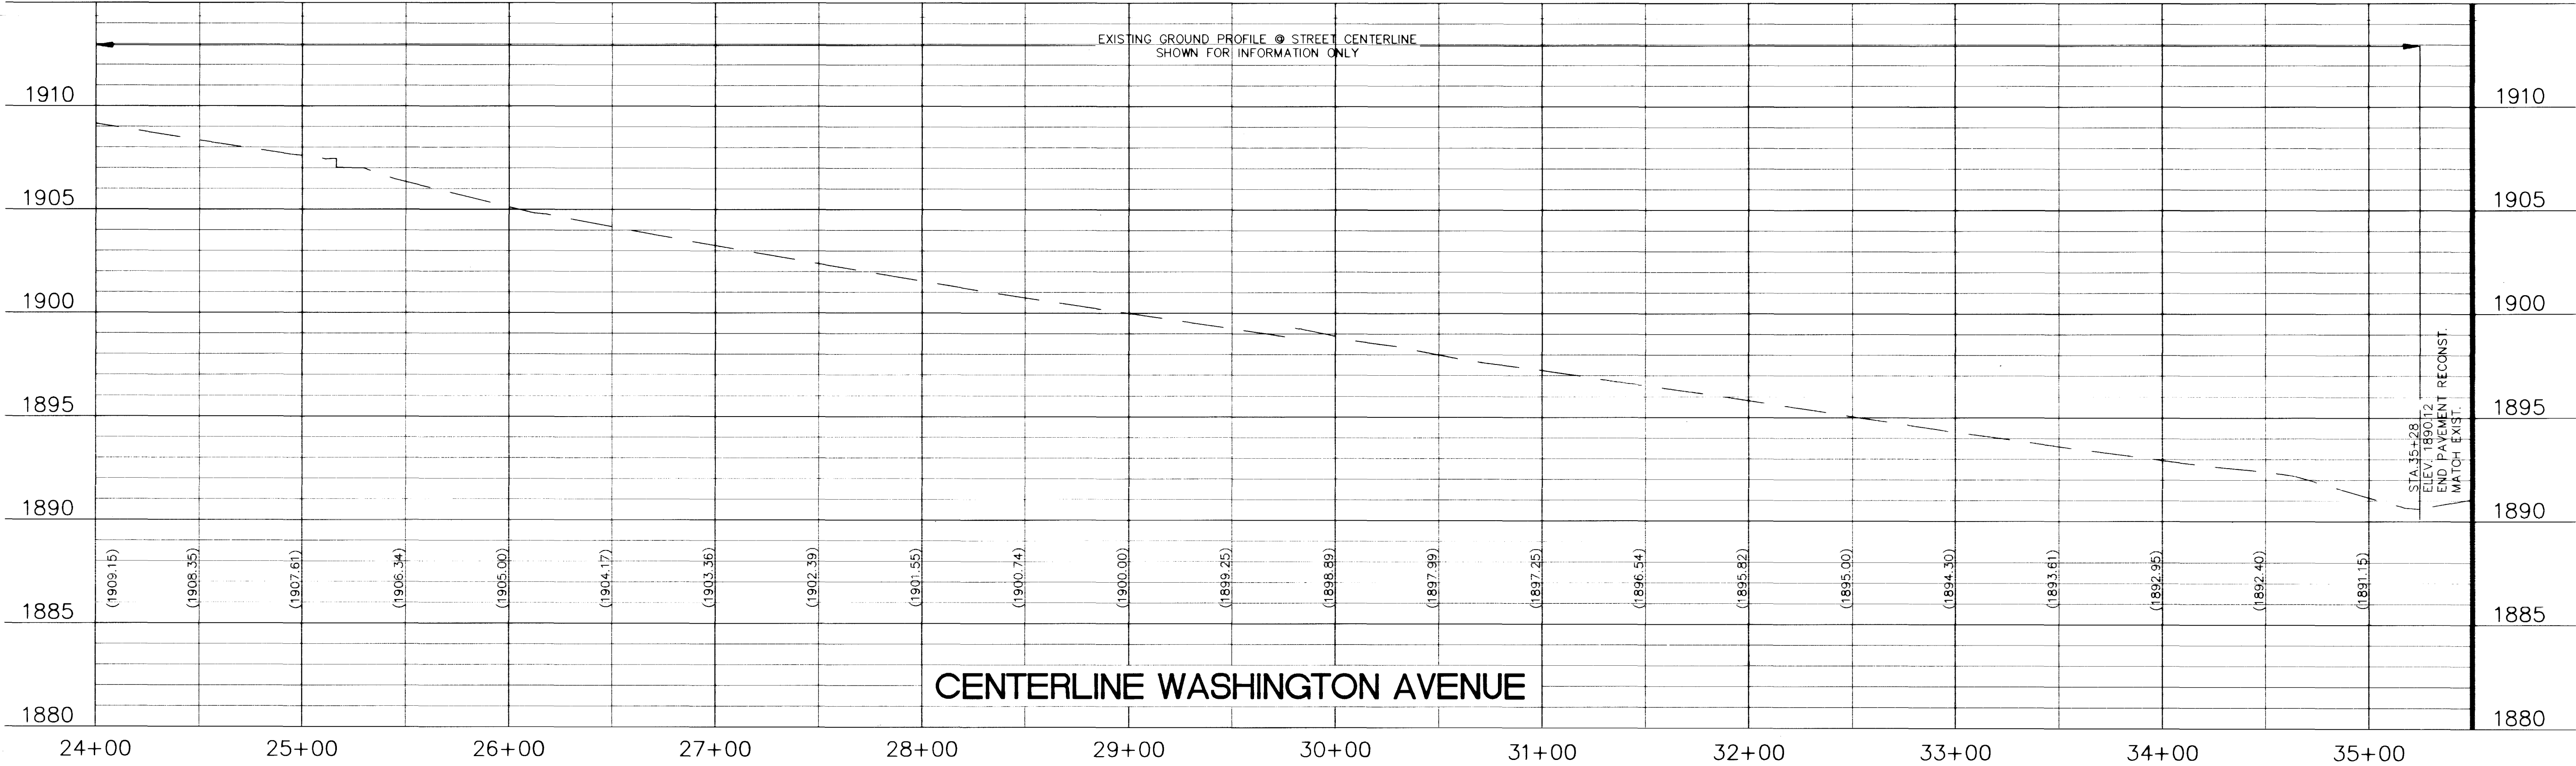

REVISIONS

No.	Date	CHKD	APPD

RECORD DRAWINGS

These drawings are to be used for construction of the project. They are not to be used for any other purpose without the written consent of the engineer. The engineer is not responsible for any errors or omissions in these drawings.

DESIGNED: CCS

DRAWN: RP/JS

CHECKED: LIG

JOB No: 661-95

HORIZ: 1"=40'

VERT: 1"=4'

DATE: 12/01/98

Carter Burgess

Consultants in Engineering,
Planning and the Environment
2955 East Sunset Road, Suite 105
Las Vegas, NV 89120
(702) 795-1007 Fax (702) 795-7056

PROJECT: CITY OF LAS VEGAS
UPPER WASHINGTON AVENUE CONVEYANCE SYSTEM


DESCRIPTION: PHASE 1
ROADWAY IMPROVEMENTS PLAN AND PROFILE
WASHINGTON AVENUE STA. 24+00 TO 35+28
PROJECT NO. 98.1730.21-RC

DRAWING NO. 731-54E

SHEET PD5

30 OF 35

WASHINGTON AVENUE

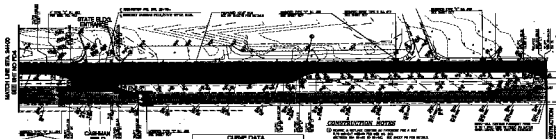

ALL TEMPERATURES ARE IN °C, RAIN IN CM				
DATE	TEMPERATURE	WIND	WINDSPEED	RAIN
1/1/00	10.0	10.0	10.0	10.0
2/1/00	11.0	11.0	11.0	11.0
3/1/00	12.0	12.0	12.0	12.0
4/1/00	13.0	13.0	13.0	13.0
5/1/00	14.0	14.0	14.0	14.0
6/1/00	15.0	15.0	15.0	15.0
7/1/00	16.0	16.0	16.0	16.0
8/1/00	17.0	17.0	17.0	17.0
9/1/00	18.0	18.0	18.0	18.0
10/1/00	19.0	19.0	19.0	19.0

- [illegible]

