



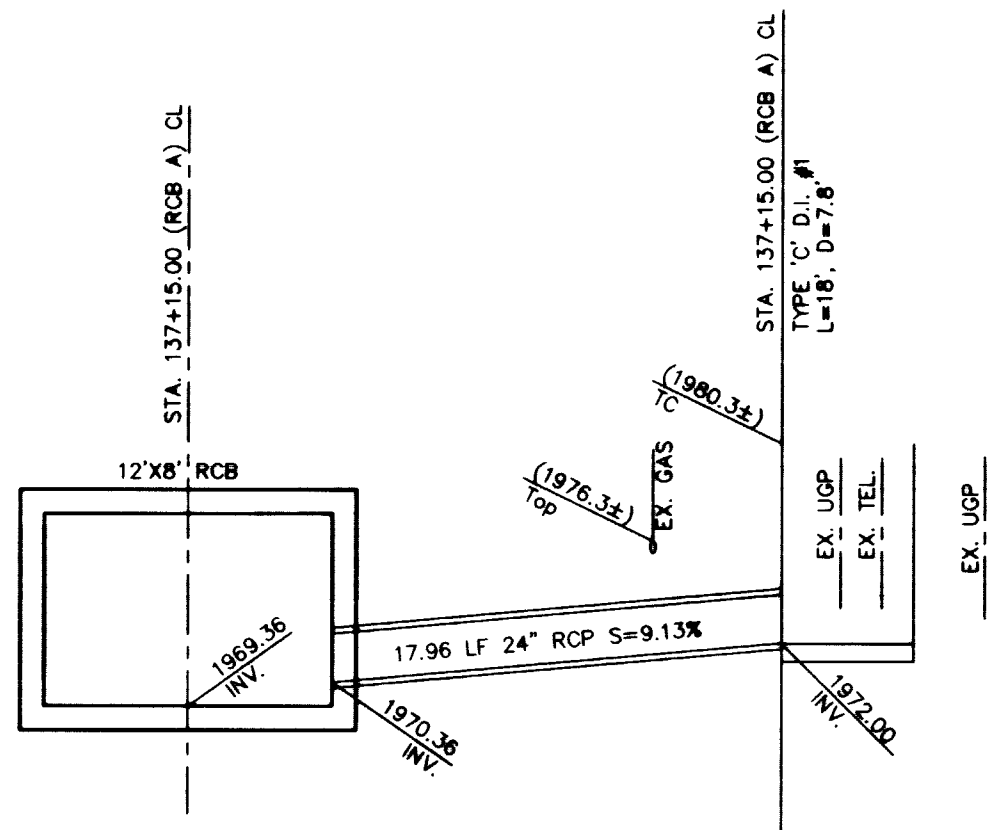


18' MODIFIED TYPE 'C' DROP INLET 1

STA. 137+15.00 (RCB A) NTS
(SEE DETAIL 2 ON SHEET SD8)

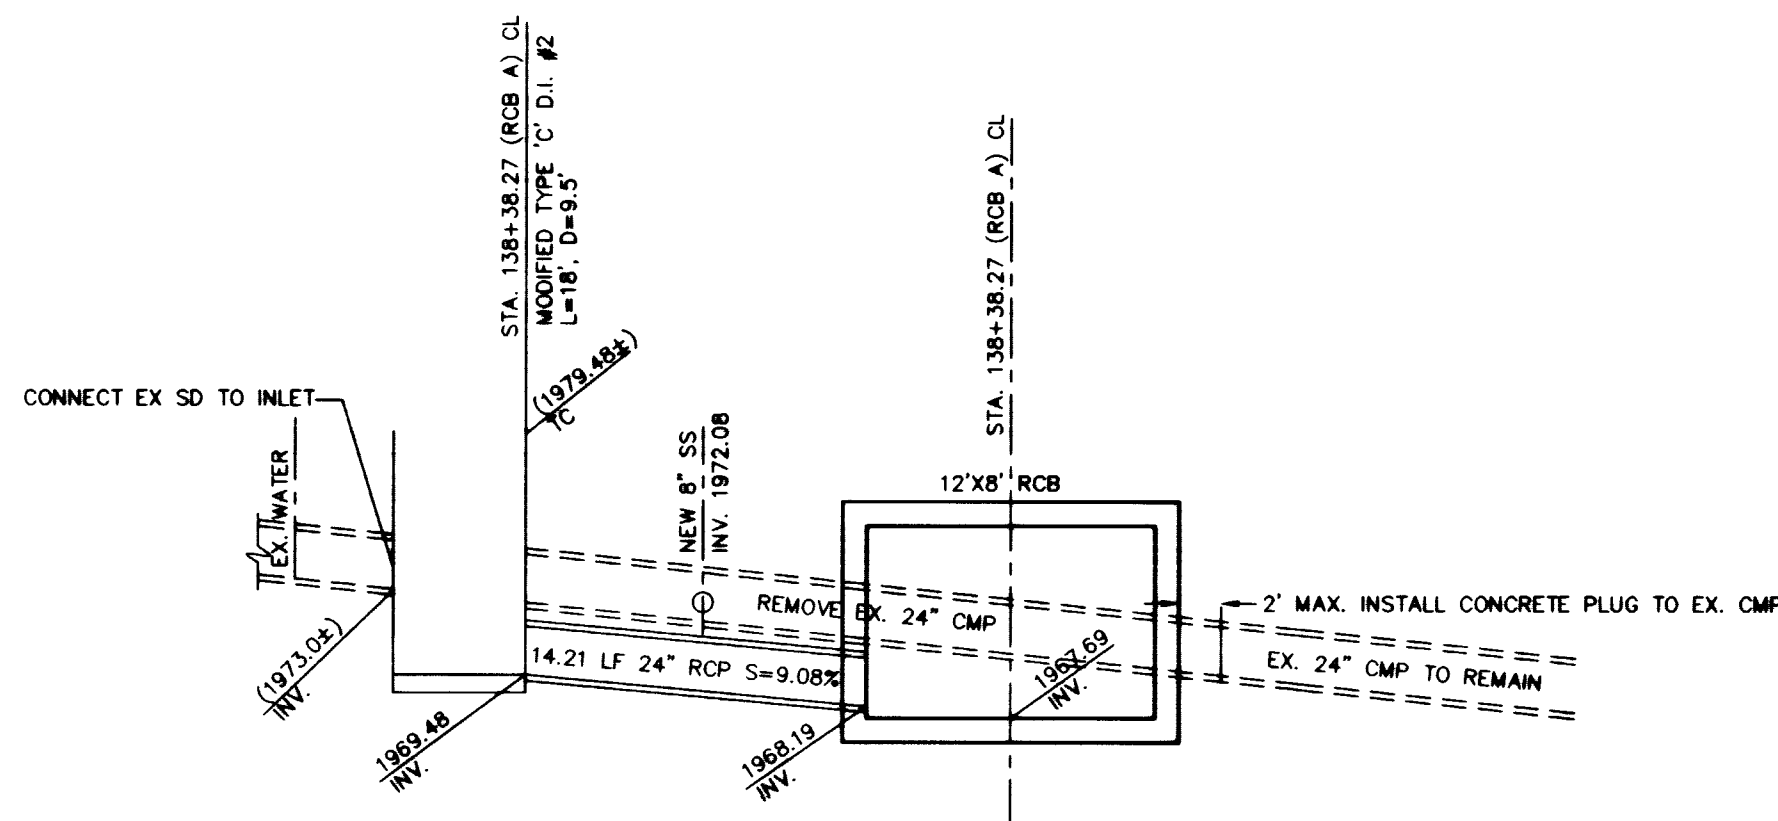


18' MODIFIED TYPE 'C' DROP INLET 2

STA. 138+38.27 (RCB A) NTS
(SEE DETAIL 2 ON SHEET SD8)

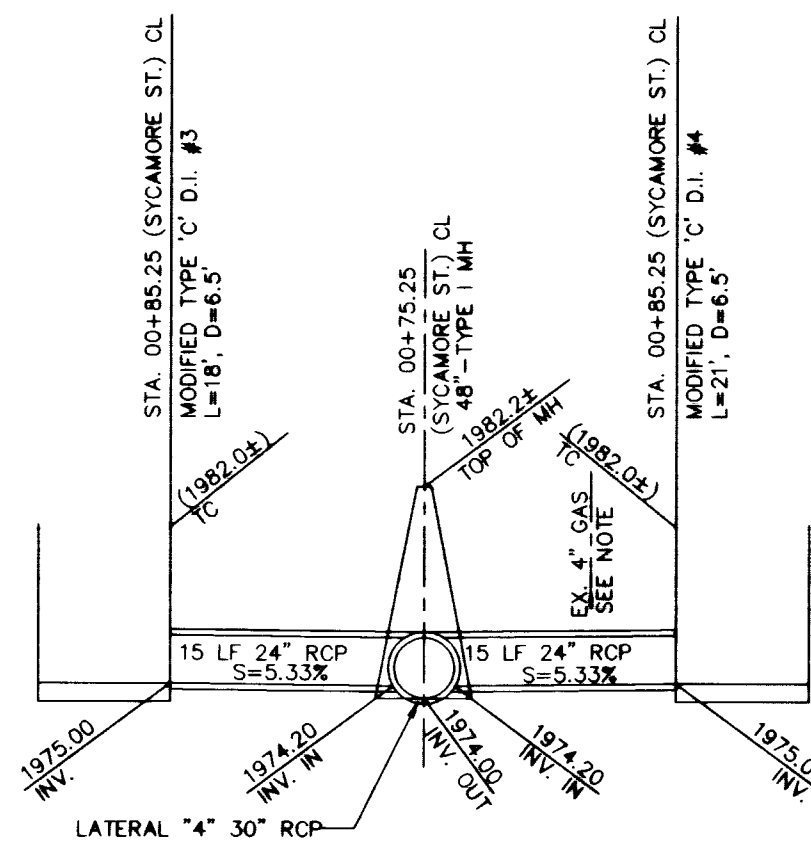


**18' MODIFIED TYPE 'C' DROP INLETS 3
21' MODIFIED TYPE 'C' DROP INLETS 4**

STA. 00+85.25 (SYCAMORE LANE) NTS
(SEE DETAIL 2 ON SHEET SD8)

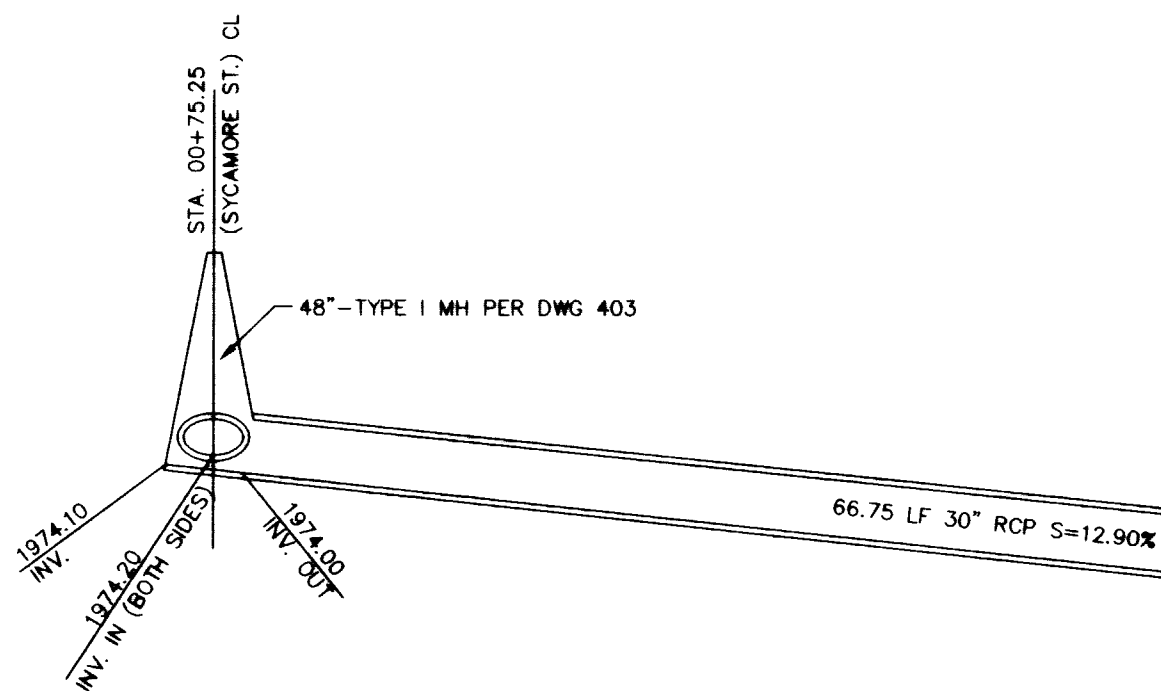


LATERAL PIPE

NTS

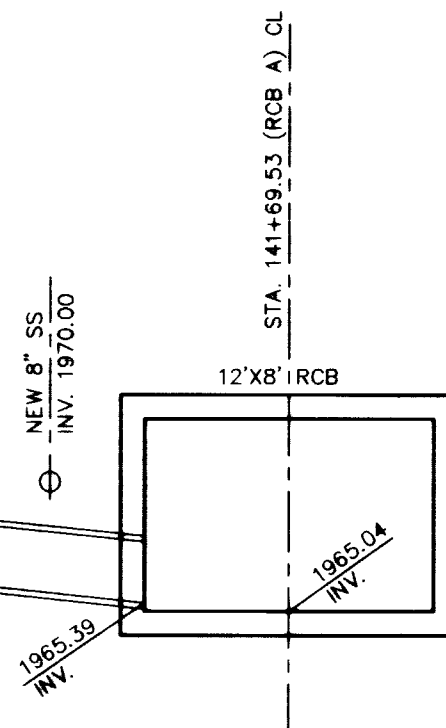


27' NDOT TYPE '11' DROP INLET 5

STA. 149+00 (RCB A) NTS
(PER R-4.6.2 (609))

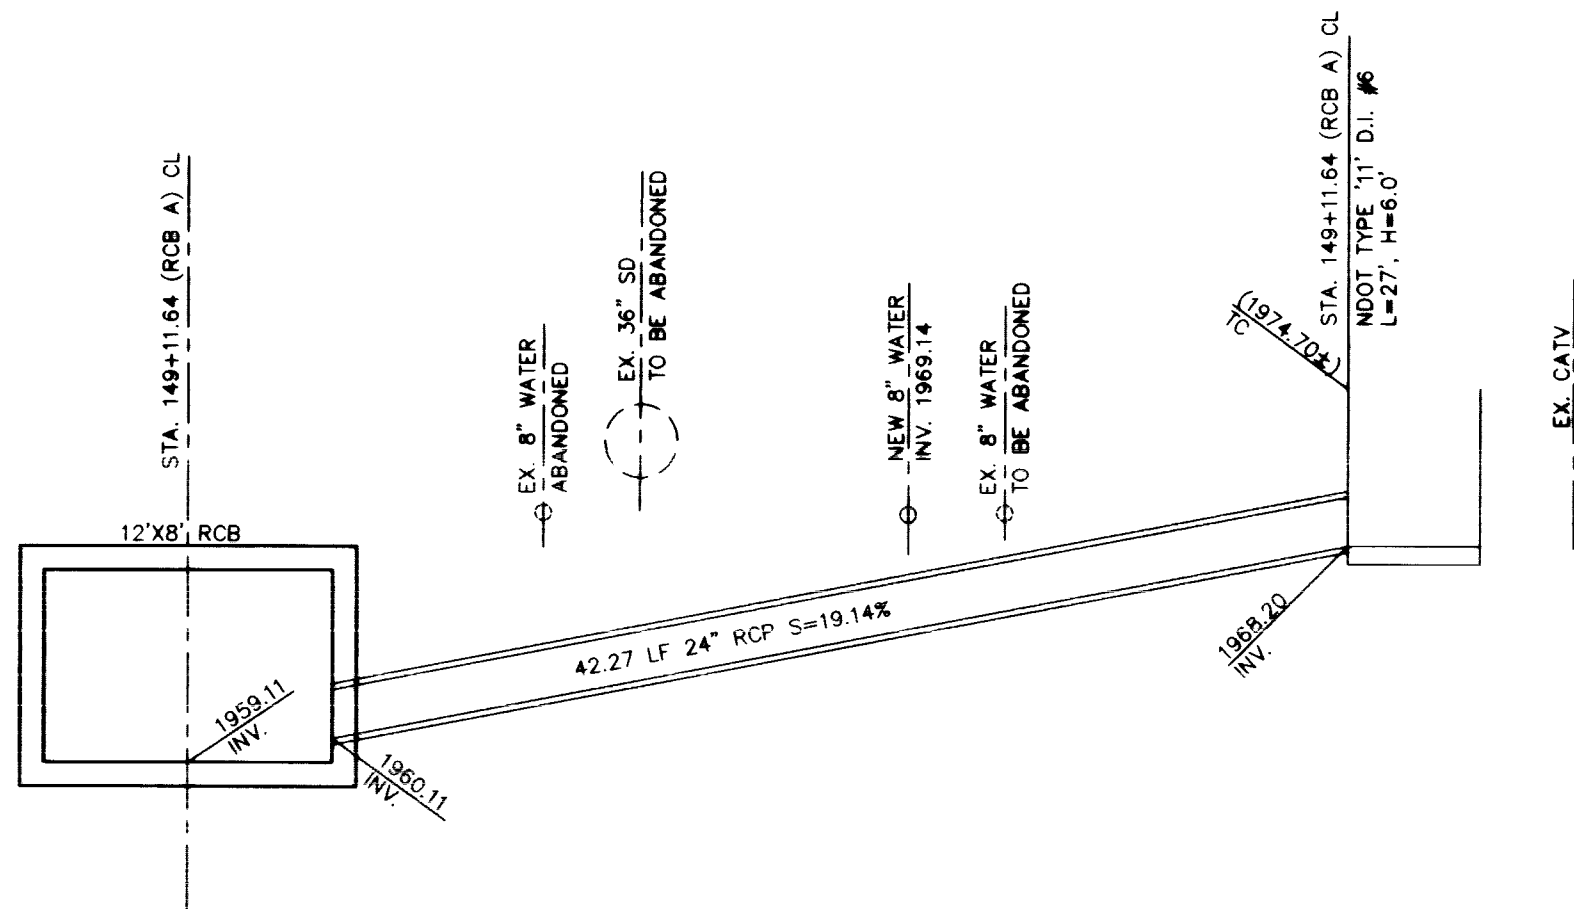

27' NDOT TYPE '11' DROP INLET 6

STA. 149+11.64 (RCB A) NTS
(PER R-4.6.2 (609))

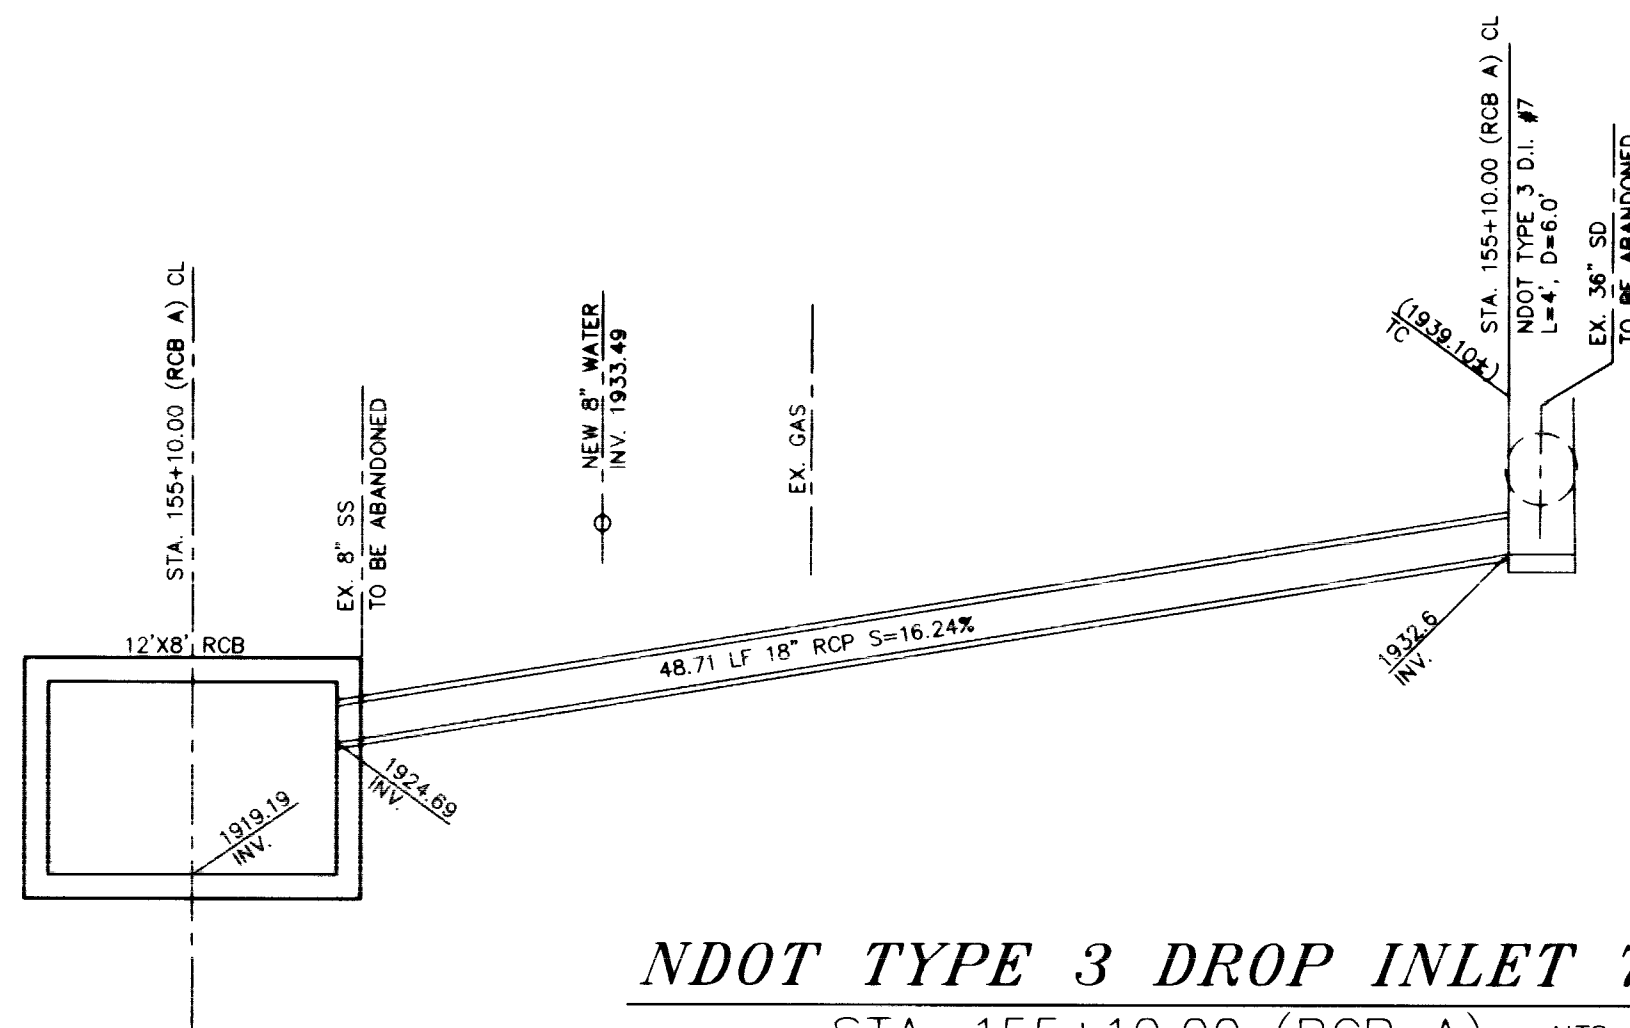

NDOT TYPE 3 DROP INLET 7


STA. 155+10.00 (RCB A) NTS
(PER R-4.3.1.(609))

REVISIONS		RECORD DRAWING	
No.	Date	No.	Date

DESIGNED:	ET
DRAWN:	ET
CHECKED:	GKC
JOB No:	681-95
HORIZ:	AS NOTED
VERT:	AS NOTED
DATE:	12/01/99

**Carter Burgess**
Consultants in Engineering,
Architecture, Planning
2955 East Sunset Road, Suite 105
Las Vegas, NV 89120
(702) 798-1007 Fax (702) 798-7056

PROJECT:	CITY OF LAS VEGAS	
	UPPER WASHINGTON AVENUE CONVEYANCE SYSTEM	
	PHASE 1	
DESCRIPTION:	DROP INLET PROFILES	
	PROJECT NO. 98.1730.21-RC	
DRAWING NO.	731-54E	
SHEET	SD5	
16	OF	35

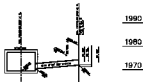

18' MODIFIED TYPE 'C' DROP INLET
 STA. 13+61.50 (RICH A) 400
 (SEE DETAIL 2 ON SHEET 3048)




18" MODIFIED TYPE 'C' DROP INLET &
STA. 138438.77 (EOD A) =
(SEE DETAIL 2 ON SHEET 5040)




18' MODIFIED TYPE 'C' DROP INLETS 3
21' MODIFIED TYPE 'C' DROP INLETS 4
STA. 00+88.35 (HYCAMORE LAKE) END
(SEE DETAIL 2 ON SHEET 500)


LATERAL PIPE

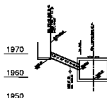

27' MDOT TYPE '11' DROP INLET 5
STA 149+00 (RIS A) 50
(PER R-4.6.2 (800))

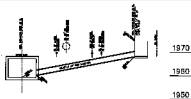

27' NGOT TYPE '11' DROP INLET 0
STA. 140+71.84 (RCD A) 48
(PCR R=4.5.2 (8091))

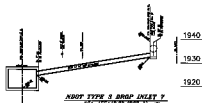

NDOT TYPE 3 DROP INLET 7
STA. 166+10.00 (NCH A) PM
(PER N-4.3.1.(6)(M))