



CONSTRUCTION NOTES

- 1 CONSTRUCT 12'x8' RCB
- 2 CONSTRUCT RCB MANHOLE PER DETAIL B, SHEET SD-1
- 5 SAWCUT AC, ACTUAL LOCATION TO BE DETERMINED BY THE ENGINEER AT THE TIME OF CONSTRUCTION.
- 8 REMOVE EXISTING GATE. SEE SHEET UN FOR NOTES
- 9 INSTALL & NEW 16'-FOOT SINGLE SWING GATE PER NDOT R-6.3.2 (616), SEE SHEET UN FOR DETAILS
- 12 REMOVE AND REPLACE EXISTING CURB & GUTTER PER DRAWING NO. 216
- 19 REMOVE EXISTING CONCRETE HEADWALL AND CONSTRUCT 8 FOOT CIP CONNECTION. SEE DETAIL C SHEET SD2 FOR DETAILS
- 21 RELOCATE EXISTING GAS MAIN (BY OTHERS)
- 23 REMOVE EXISTING CHAIN LINK FENCE
- 24 CONSTRUCT 72" CHAIN LINK 38 FENCE PER NDOT R-6.3.1 (616)
- 26 CONTRACTOR COORDINATION WITH SWG; SEE SWG NOTES ON SHEET UN.
- 27 REMOVE ABANDONED SEWER MAIN AND MANHOLES

MATCH LINE BOX 'A' STA. 126+00

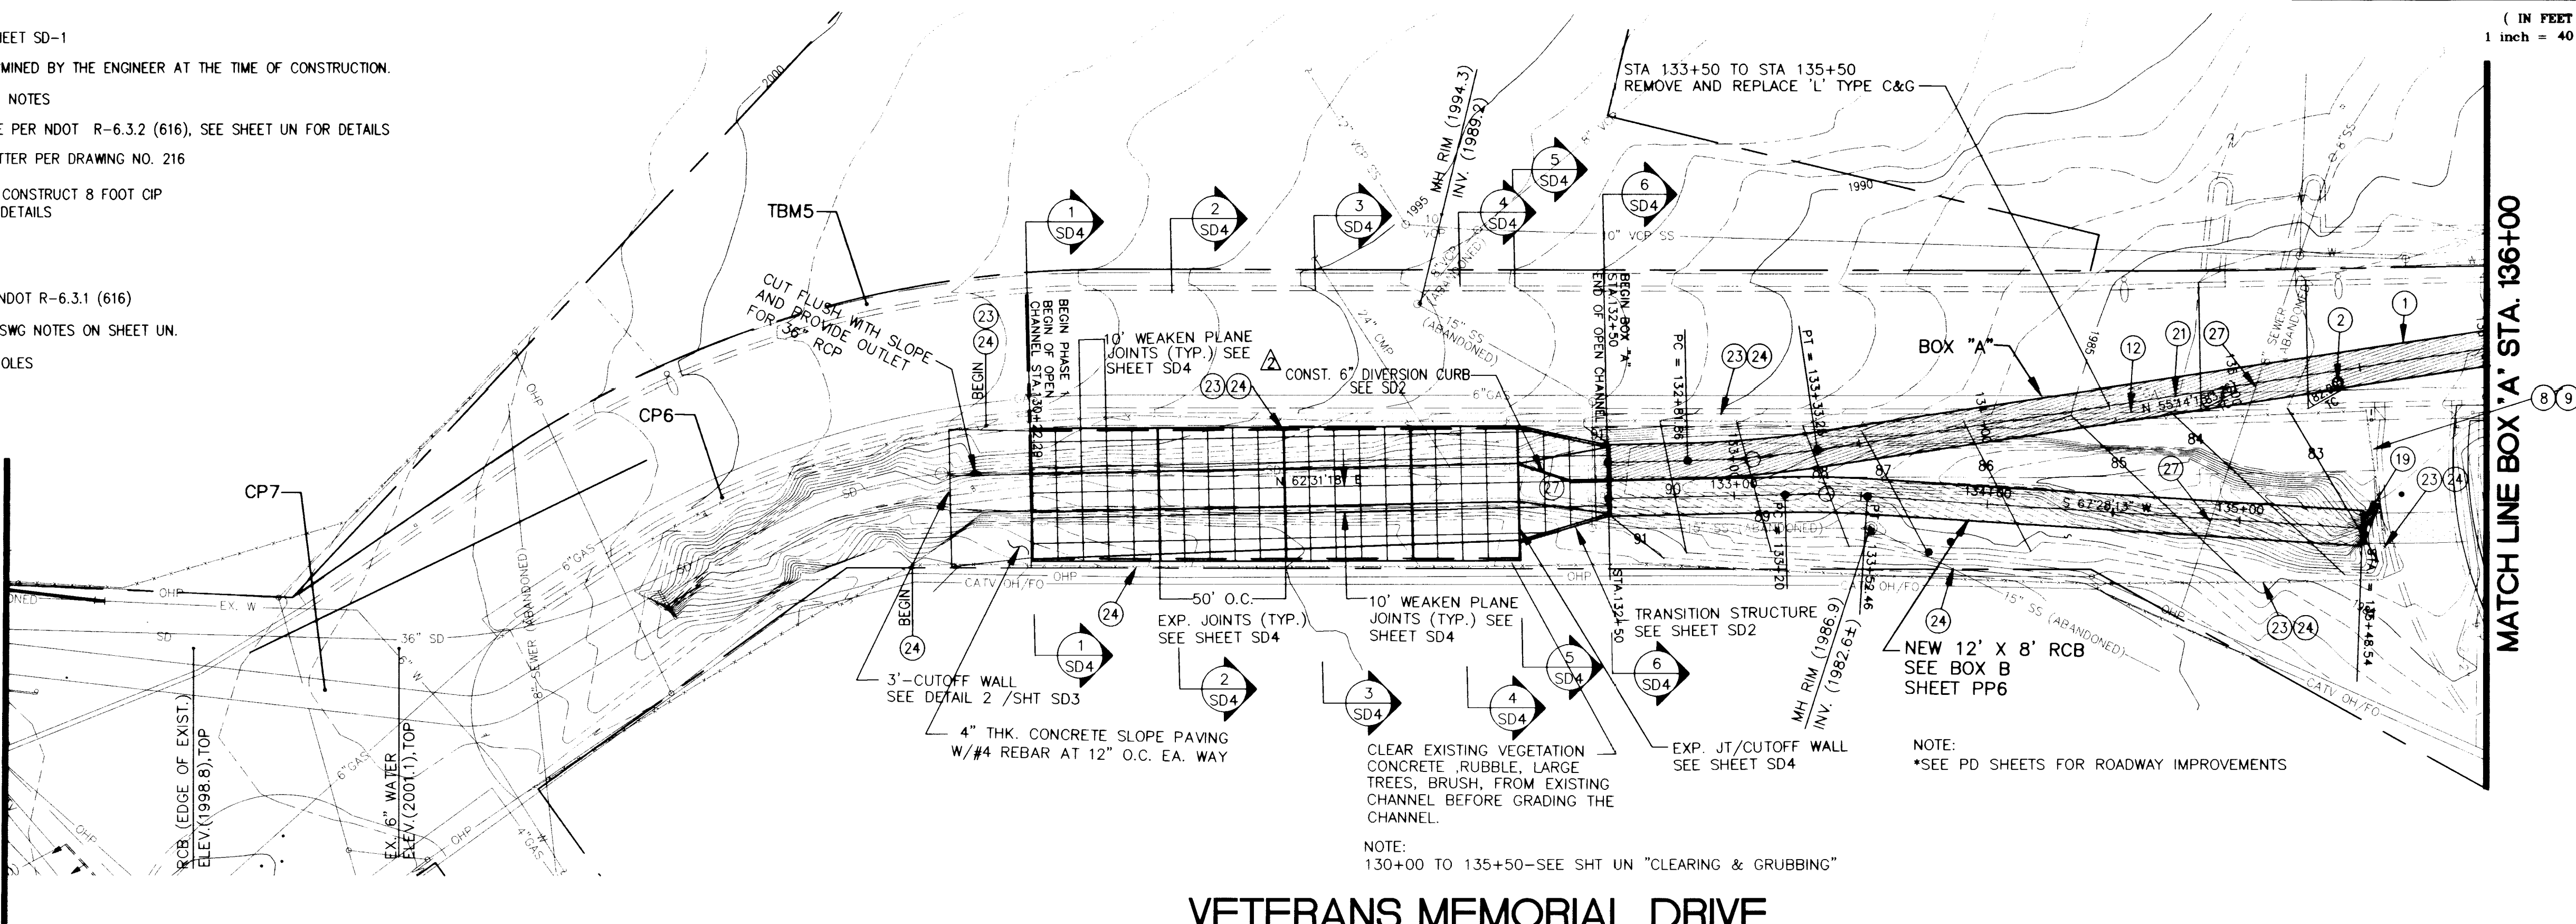

VETERANS MEMORIAL DRIVE

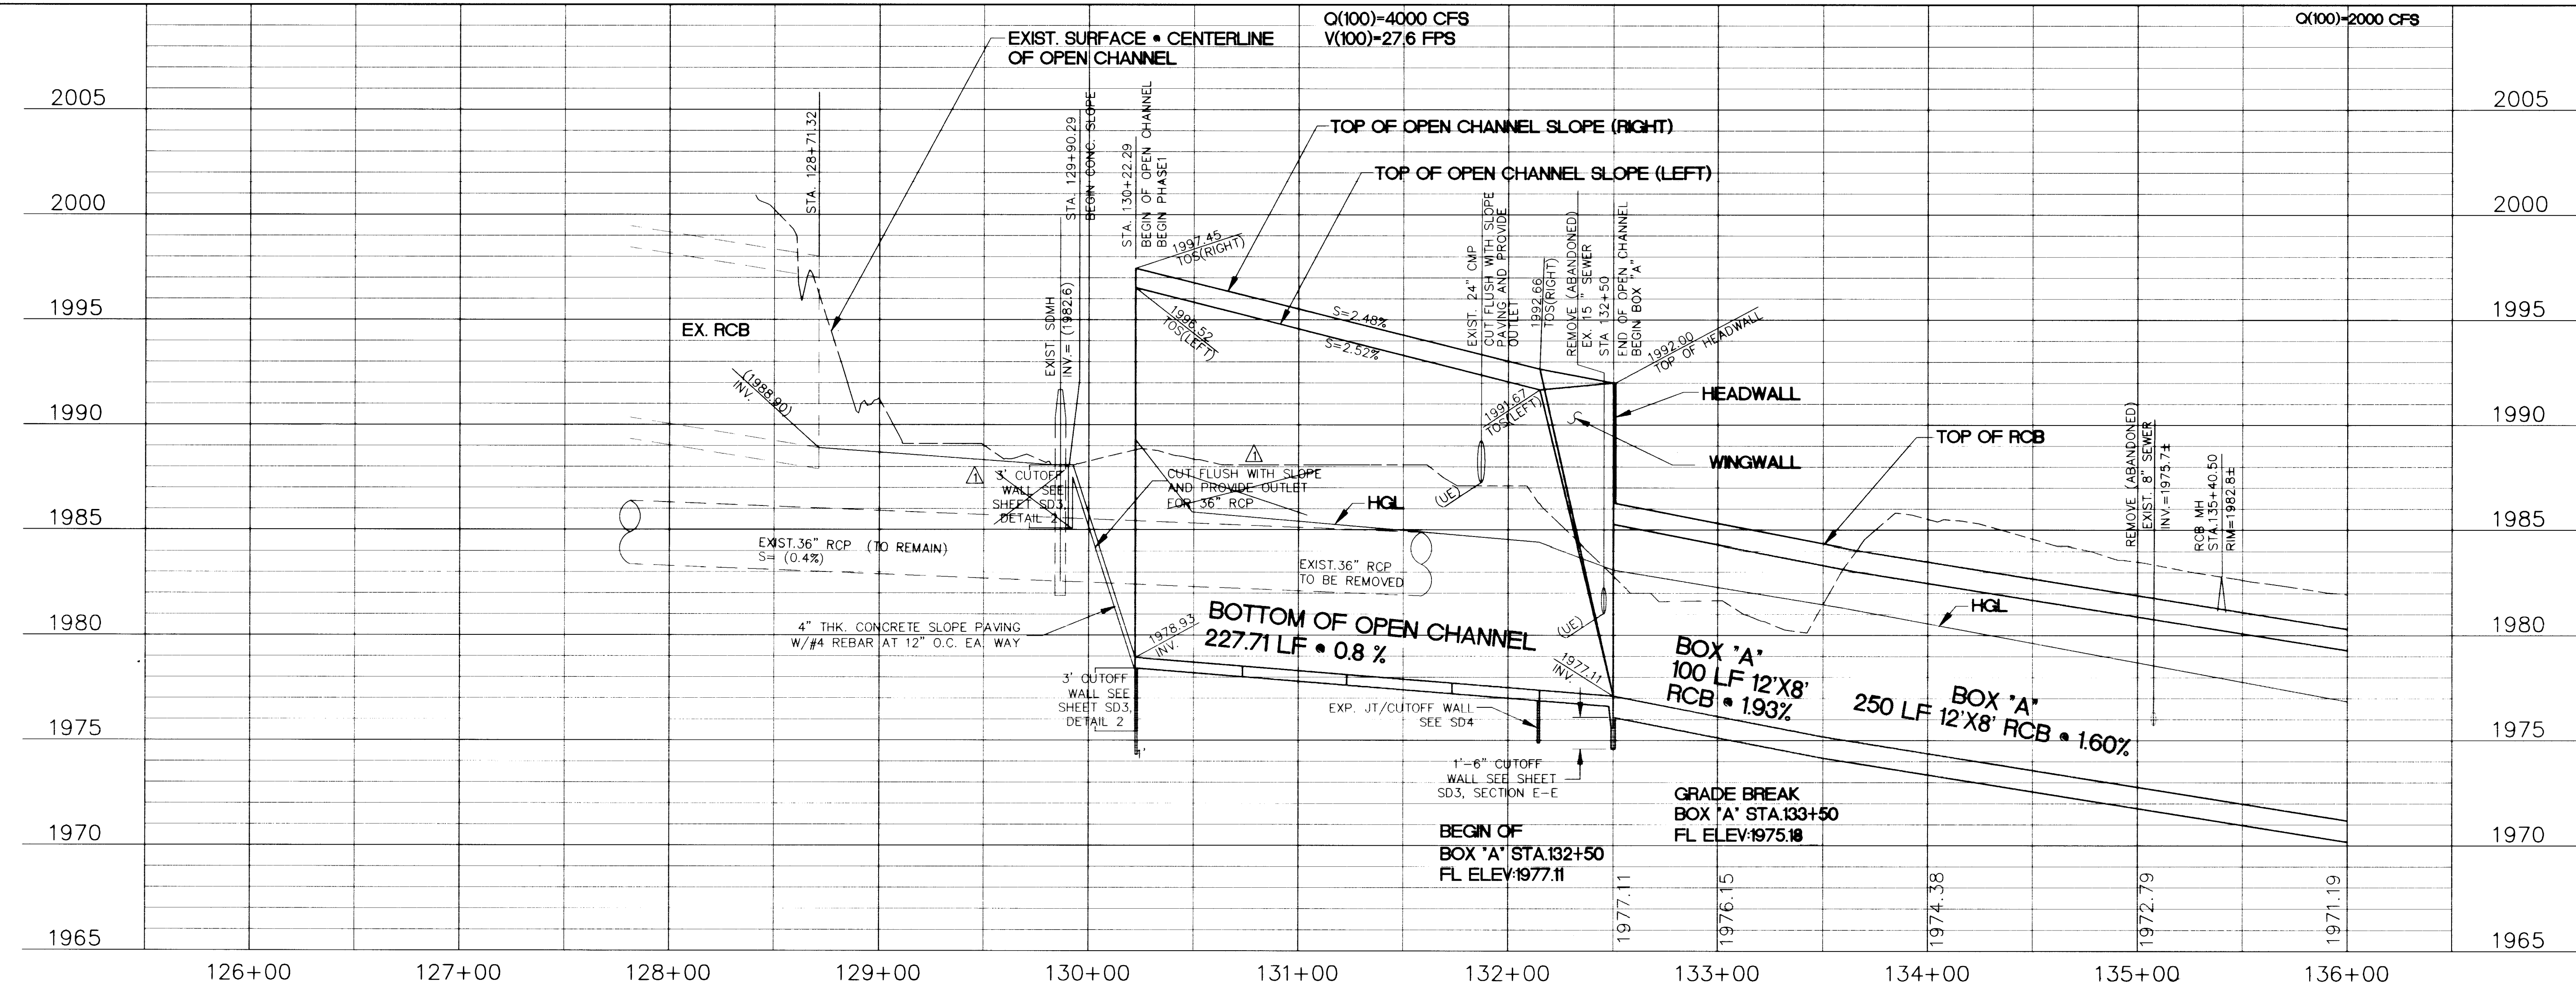

GRAPHIC SCALE

(IN FEET)
1 inch = 40 ft.

MATCH LINE BOX 'A' STA. 136+00


Call before you Dig
1-800-227-2600
SAFETY ALERT
Call before you Overhead
593-6111
OVERHEAD SERVICE ALERT

PROJECT:		CITY OF LAS VEGAS		DRAWING NO.				
DESCRIPTION:		UPPER WASHINGTON AVENUE CONVEYANCE SYSTEM		731-54E				
		PHASE 1		SHEET				
		DRAINAGE STRUCTURE PLAN AND PROFILE		PP1				
		STATION 130+22.29 TO 136+00		6 OF 35				
		PROJECT NO. 98.1730.21-RC						
Carter & Burgess Consultants in Engineering, Planning and the Environment 2955 East Sunset Road, Suite 105 Las Vegas, NV 89120 (702) 798-1001 Fax (702) 798-7056				DESIGNED: FT/GAC DRAWN: RP/ET/JS CHECKED: GGB JOB No: 681-95 HORIZ: 1"=40' VERT: 1"=4' DATE: 12/01/99				
RECORD DRAWINGS These Record Drawings have been prepared by the Engineer and are to be used for construction purposes only. They are not to be used for any other purpose without the written consent of the Engineer.				REVISIONS				
				No.	Date	CHD	APPD	
				1	7/28/99	DELETED CUT OFFWALL, 36" RCP	G.R.B.	S.F.
						NOT CUT FLUSH WITH SLOPE.	G.R.B.	S.F.
				2	7/28/99	ADD (6" DIVERSION CURB NOTE)	G.R.B.	S.F.


CONSTRUCTION NOTES

1. EXISTING ROAD WIDE
2. EXISTING ROAD WIDE (SCALE 1:1000)
3. EXISTING ROAD WIDE (SCALE 1:1000)
MATCH LINE SEE PLAN SHEET 100

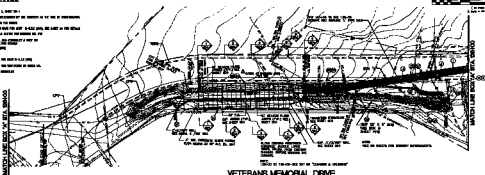

VETERANS MEMORIAL DRIVE

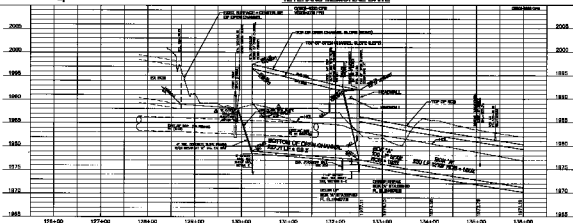

City of San Diego
 OFFICE OF THE CITY ENGINEER
 731-542
 PP1