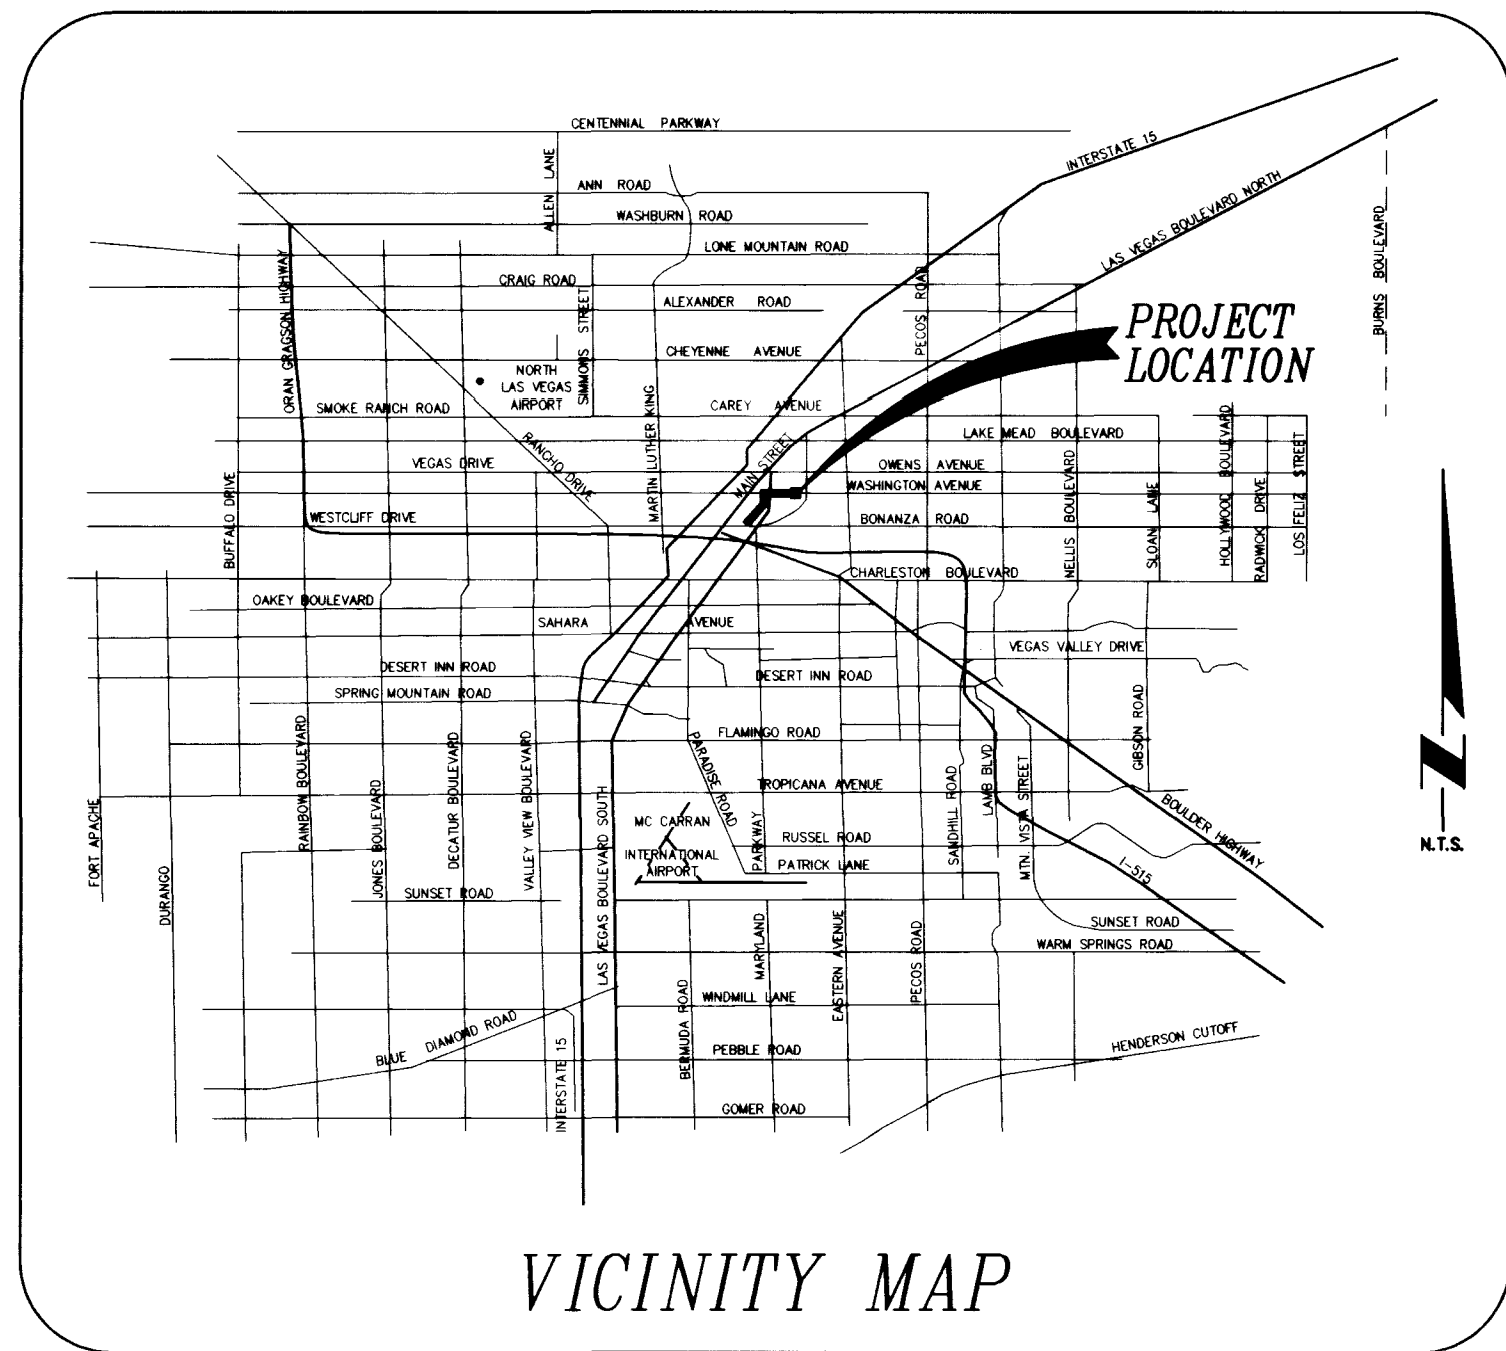


DEPARTMENT OF PUBLIC WORKS



VICINITY MAP

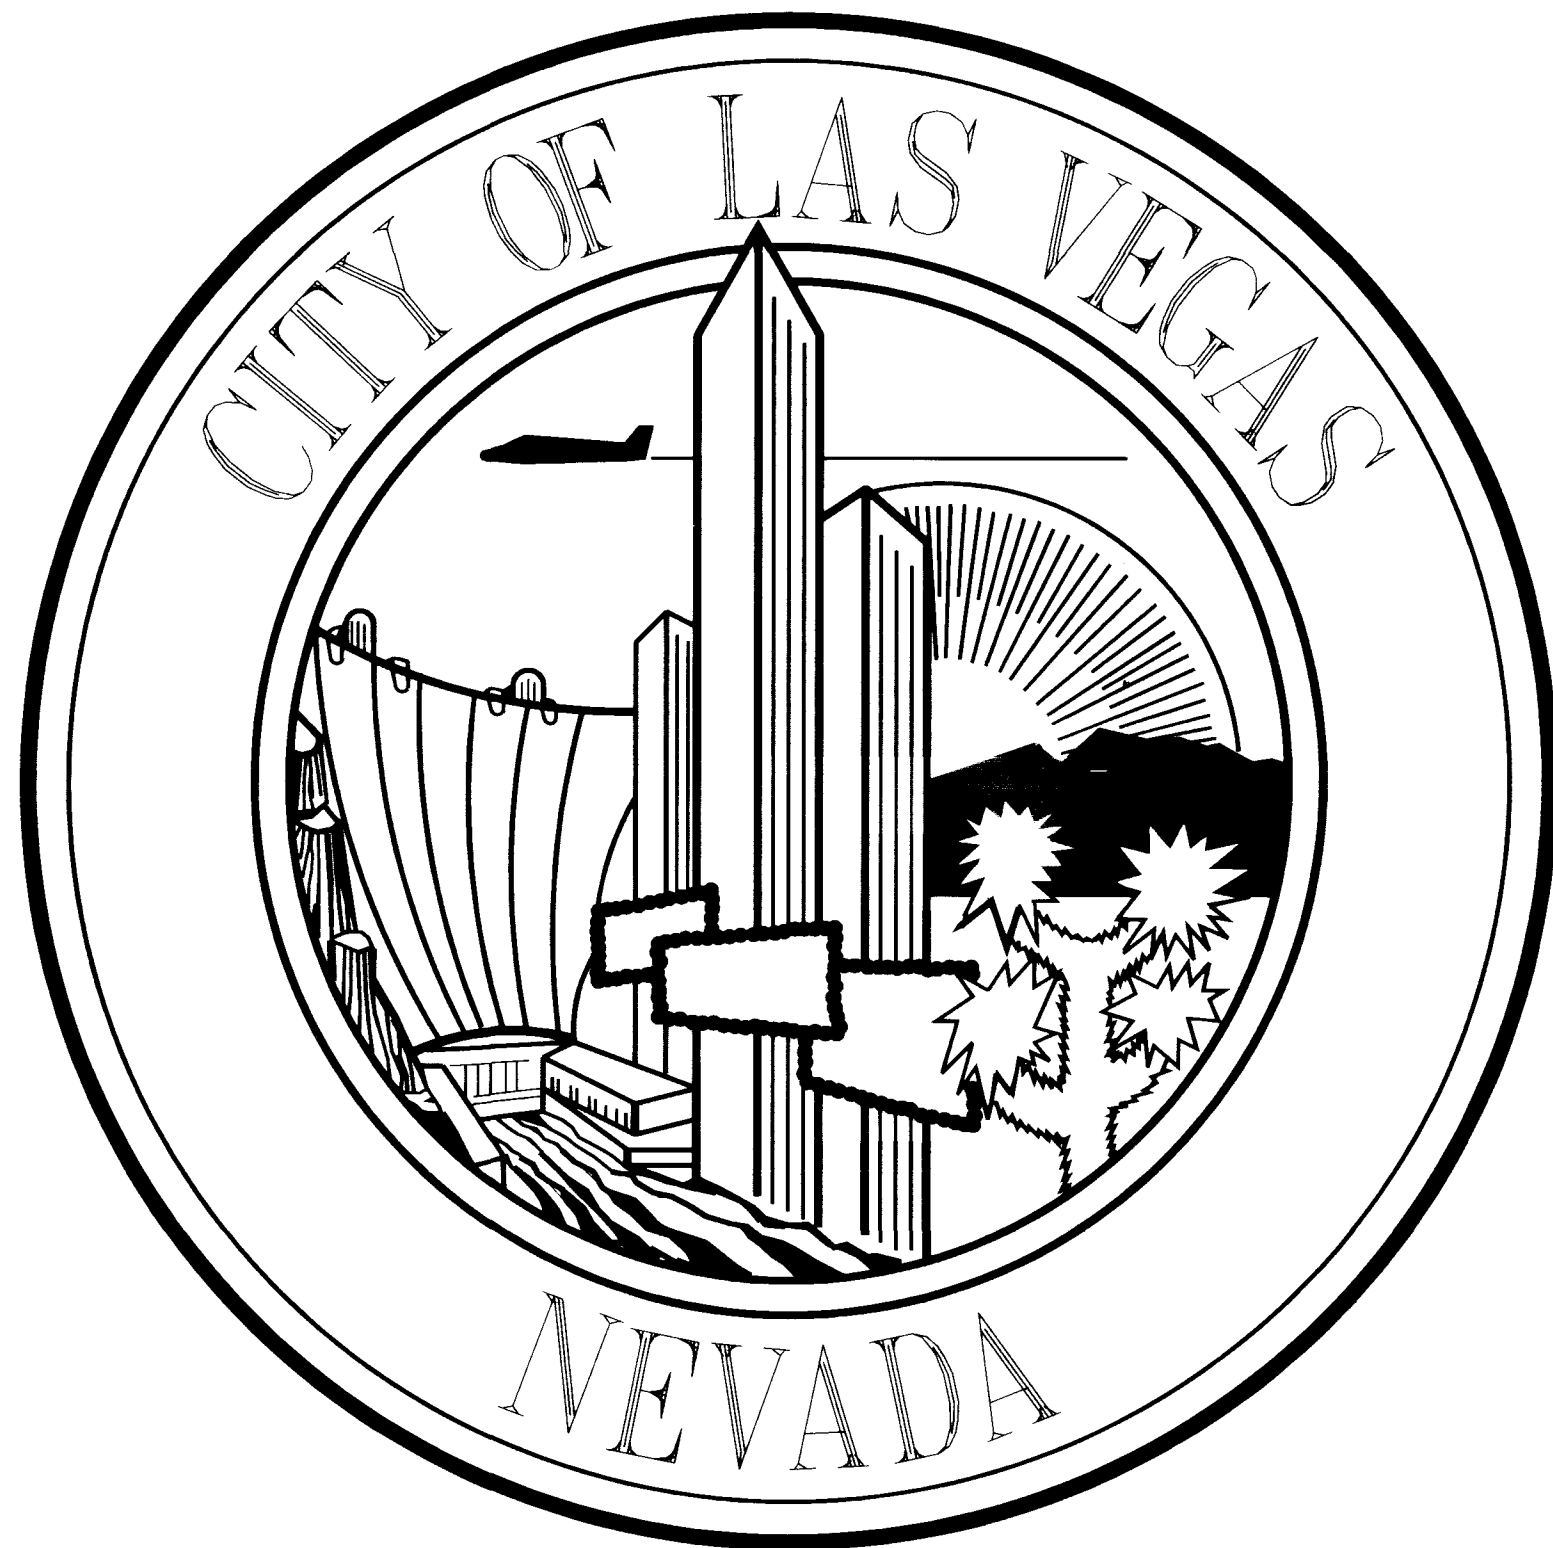
Mayor:
Jan Laverty Jones

Councilmen:
Arnie Adamsen
Larry Brown
Michael J. McDonald
Gary Reese

City Manager:
Larry Barton

Director of Public Works:
Richard D. Goecke

City Engineer:
Dennis Anderson, P.E.



APPROVALS

CITY ENGINEER	DATE
CLV MANAGER CONSTRUCTION SERVICES	DATE
CLV ADA ADMINISTRATOR	DATE
CLV TRAFFIC ENGINEER	DATE
C.C. REGIONAL FLOOD CONTROL DISTRICT	DATE
LAS VEGAS VALLEY WATER DISTRICT	DATE
NEVADA POWER COMPANY	DATE
SOUTHWEST GAS COMPANY	DATE
SPRINT CENTRAL TELEPHONE-NEVADA	DATE
PRIME CABLE COMPANY	DATE

REVISIONS

No.	Date	CHKD	APPD

RECORD DRAWINGS
These drawings are to be used for record purposes only. They are not to be used for construction purposes. Any changes or additions to these drawings must be approved by the City Engineer and the Clark County Regional Flood Control District.

DESIGNED BY: CRB/CAC	DATE: 12/01/99
DRAWN BY: RPP	
CHECKED BY: LHC	
JOB NO: 681-95	
HORIZ: NONE	
VERT: NONE	

Carter Burgess
Consultants in Engineering,
Planning and the Environment
2955 East Sahara Road, Suite 105
(702) 798-1007 Fax (702) 798-7056


PROJECT: CITY OF LAS VEGAS UPPER WASHINGTON AVENUE CONVEYANCE SYSTEM	DESCRIPTION: PHASE 1 COVER SHEET PROJECT NO. 98.1730.21-RC
---	--

DRAWING NO. 731-54E	SHEET CS 1 OF 35
------------------------	------------------------

UPPER WASHINGTON AVENUE CONVEYANCE SYSTEM PHASE 1

FANTASY LANE TO VETERANS MEMORIAL DRIVE
FUNDING PROVIDED BY CLARK COUNTY REGIONAL FLOOD CONTROL DISTRICT

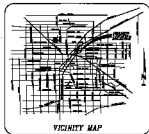DEPARTMENT OF PUBLIC WORKS



Materials

Jan Laverdy Jones

Councilmen:

Arvid Adamson

Larry Brown

Michael J. McDonald

Gary Rennie

City Manager:

Larry Barton

Director of Public Works:

Richard D. Goetsch

City Engineer:

Dennis Anderson, P.E.



APPROVALS

[illegible]

48 JULIAN ROBERTSON, ESQ.

100

2008 RELEASE UNDER E.O. 14176

42. **ANSWER: C** AND **PURPOSE: SCENE**

Year	1990	1991	1992	2100
------	------	
[illegible]

	1987	1988	1989	2439	2
--	------	------	---

[illegible]

UPPER WASHINGTON AVENUE CONVEYANCE SYSTEM
PHASE 1

FANTASY LANE TO VETERANS MEMORIAL DRIVE
FUNDING PROVIDED BY CLARK COUNTY REGIONAL FLOOD CONTROL DISTRICT