



LEGEND

- Border between City of Las Vegas & Clark County
 - Right of Way
 - Center Line
 - Survey Line
 - Existing Facility
 - Proposed Facility
 - Future Facility
 - G Gas Line
 - W Water Line w/ Valve
 - S Sewer Line w/ Manhole
 - Edge of existing A.C. Paving
 - A.C. Paving to be removed
 - Proposed Nuisance Water Drain w/ Junction Box
 - Type II Inlet
 - Type I Curb Inlet
 - Utility Pole w/ Anchor
 - Street Lighting
 - Traffic Sign
 - Traffic Signal w/ Street Light
 - Mail Box
 - Fire Hydrant
 - Water Meter
 - Fence, Wall
 - Shrub
 - Tree w/ Size
 - 03-2 Boring for Soil Test
 - Survey Monument
 - ▲ Bench Mark
- ELECTRICAL LINES NOT SHOWN

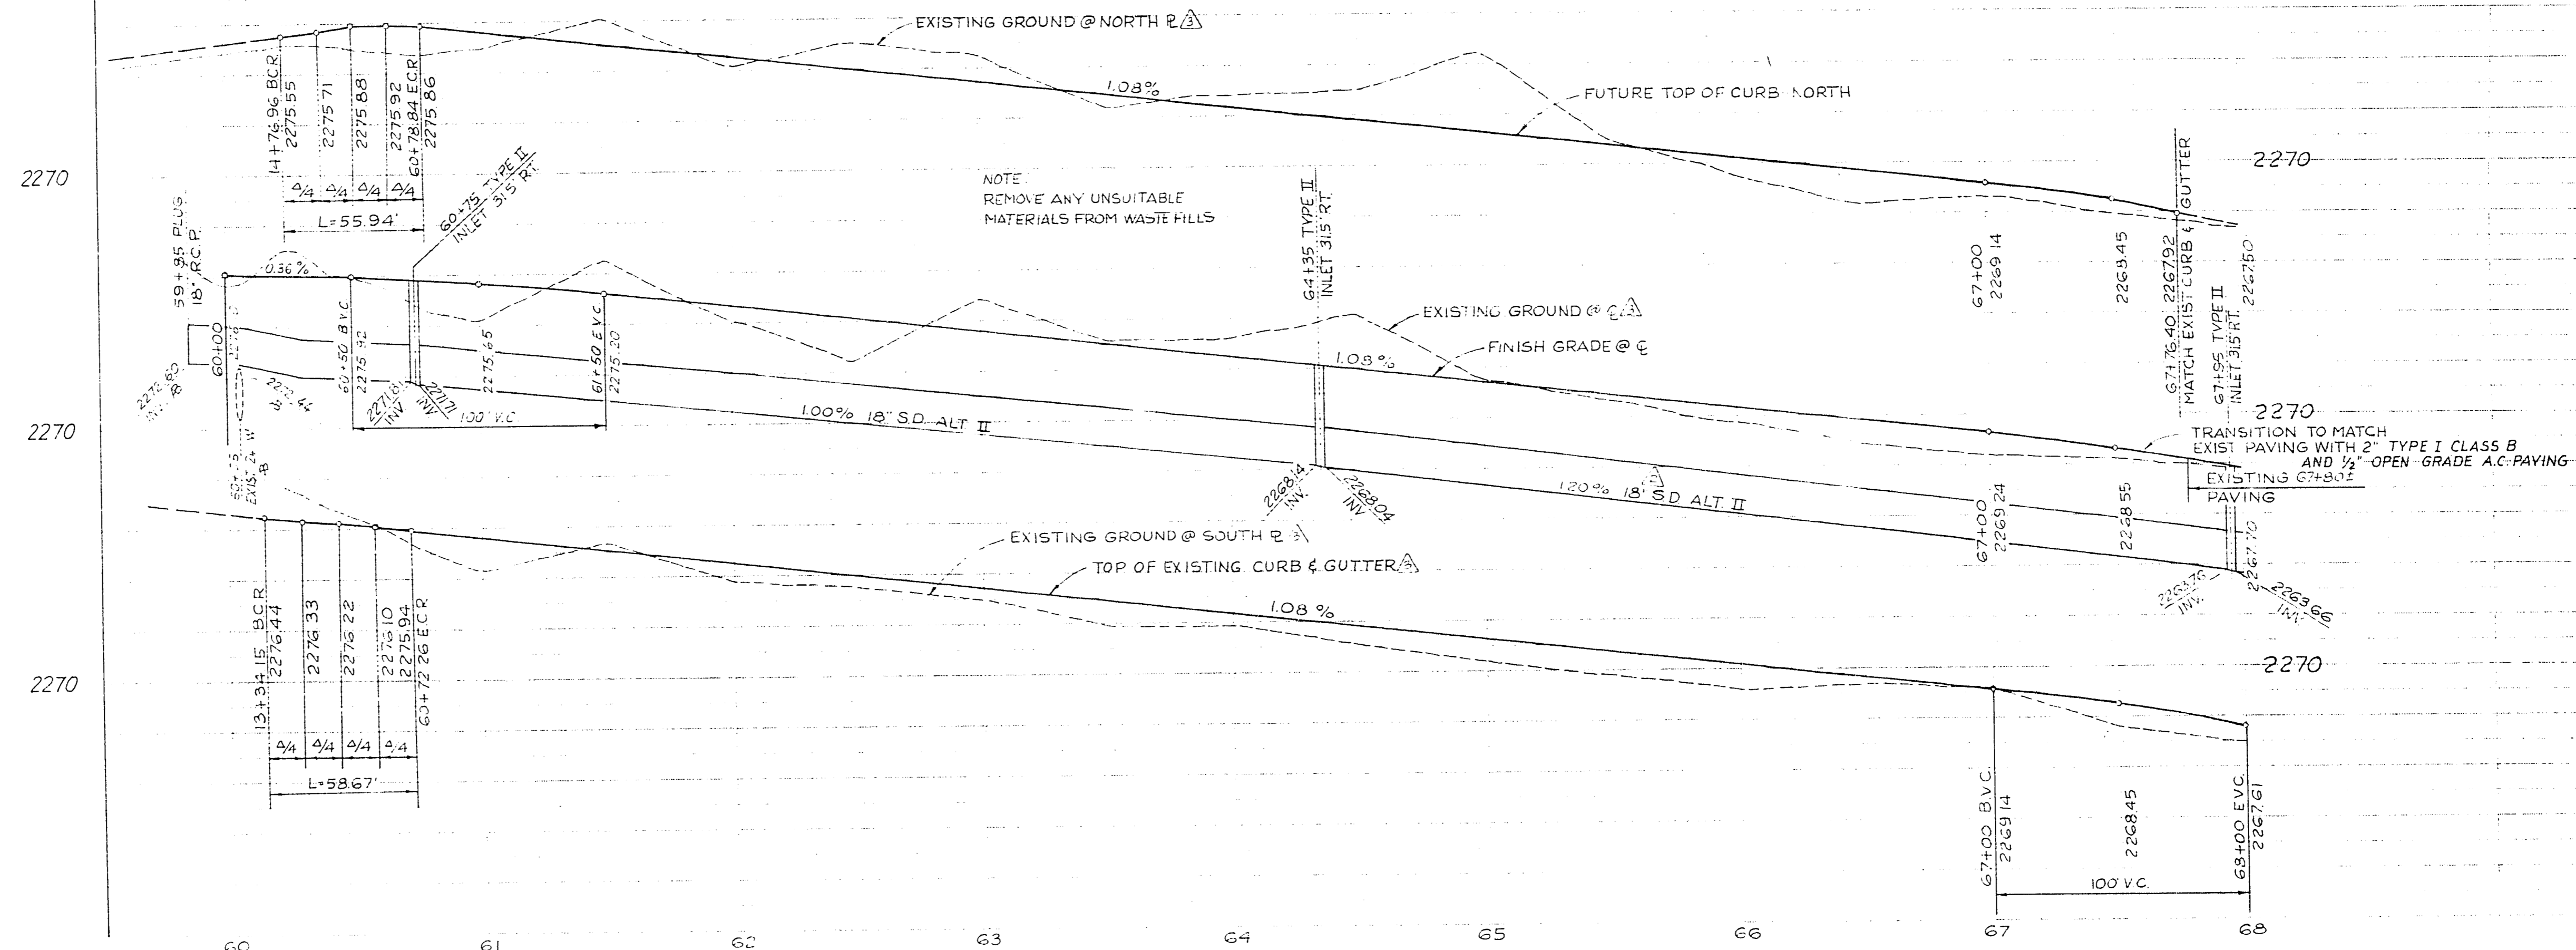

SECTION CORNER MONUMENT WILL BE REFERENCED AND CLV MONUMENT SET IN CONCRETE WILL BE RESET BY CONTRACTOR AFTER PAVING IS COMPLETED. SEE SPECS.

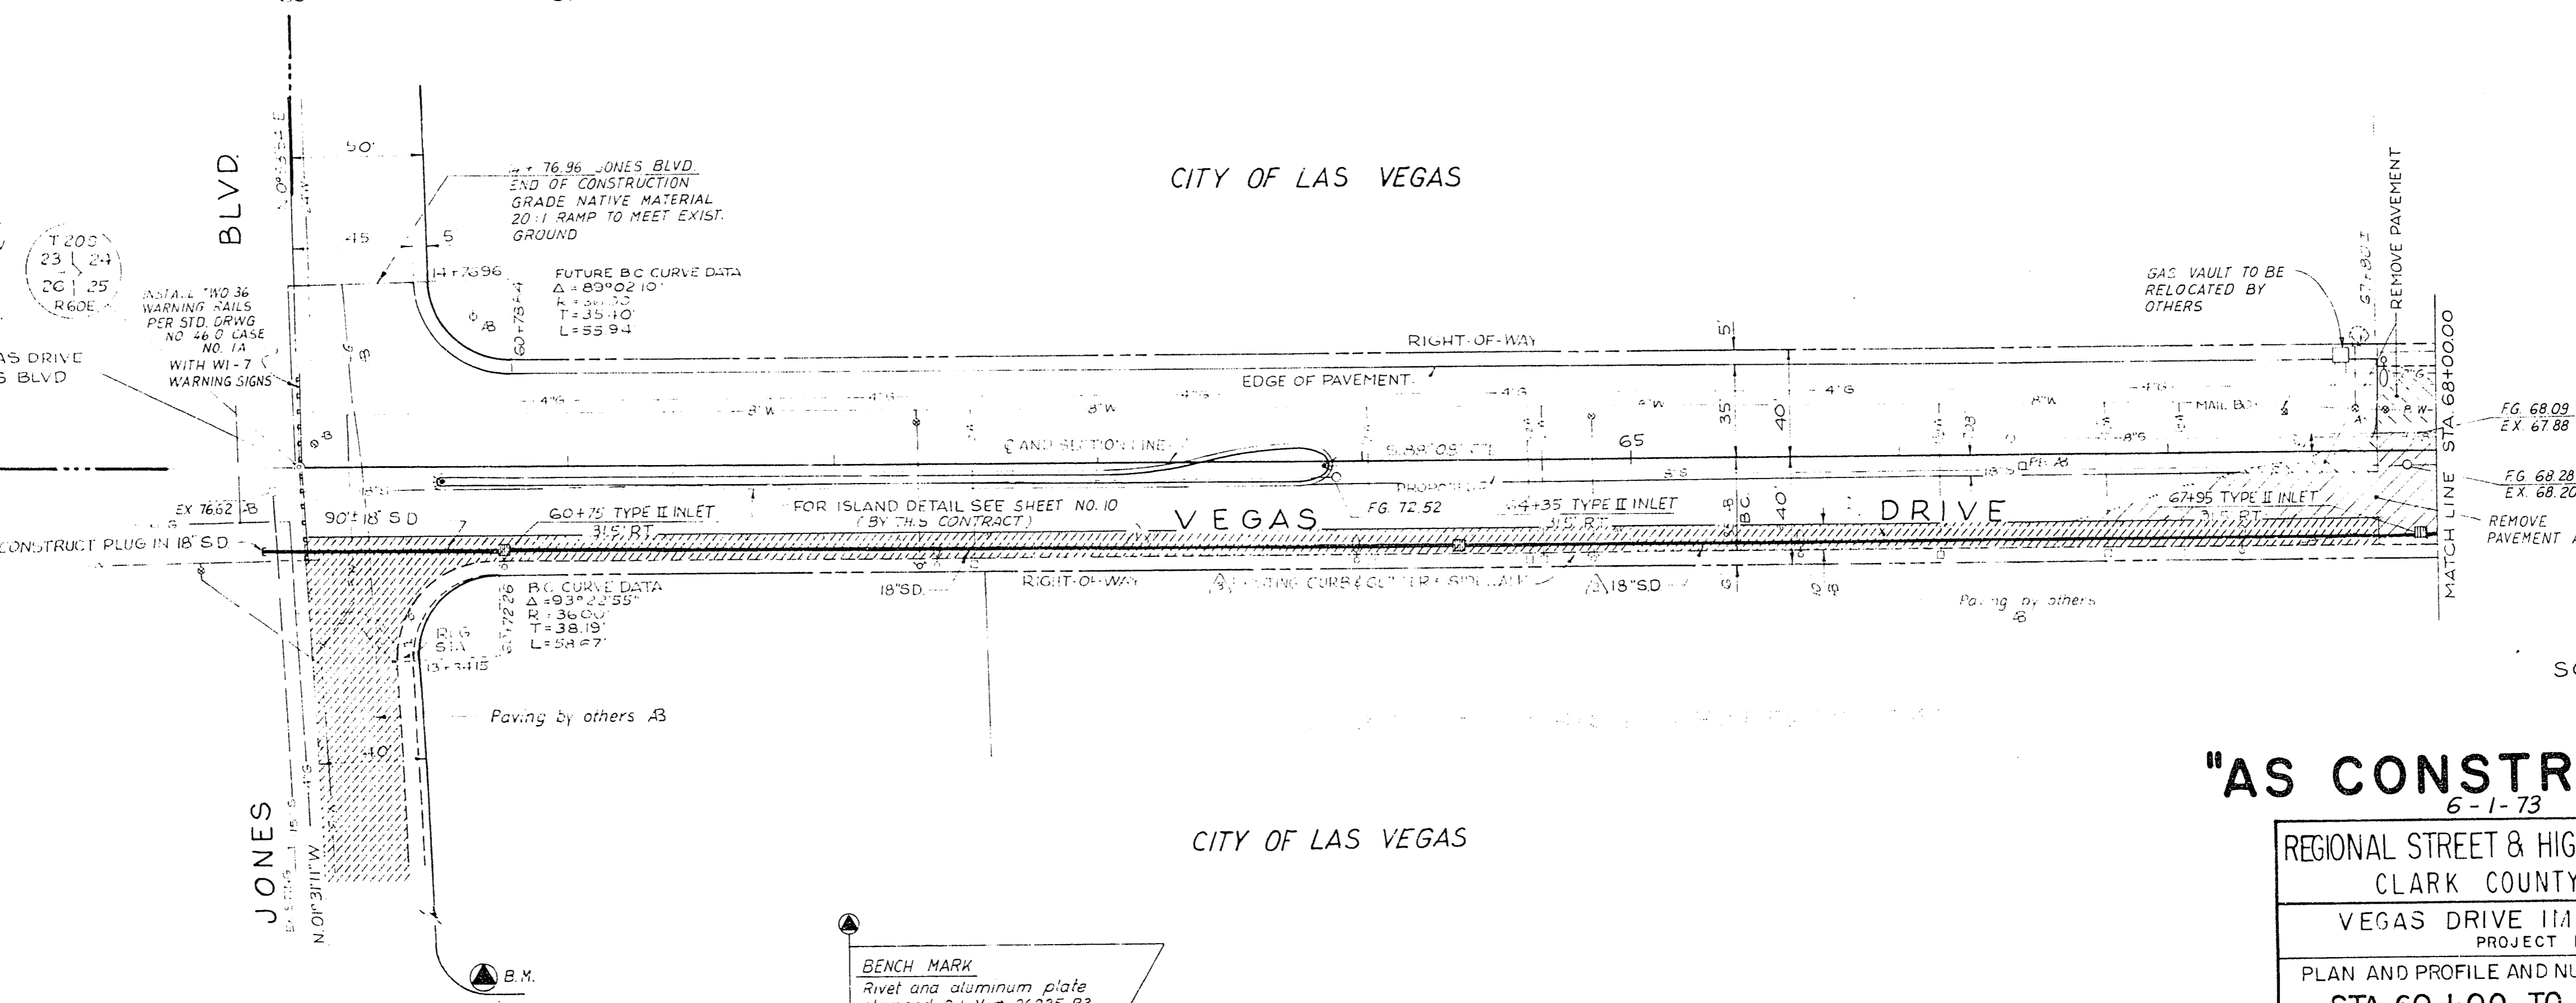

SCALE: HORIZ. 1"=40'
VERT. 1"=4'

"AS CONSTRUCTED"
6-1-73

REGIONAL STREET & HIGHWAY COMMISSION
CLARK COUNTY, NEVADA
VEGAS DRIVE IMPROVEMENTS
PROJECT NO. 4A
PLAN AND PROFILE AND NUISANCE WATER DRAIN
STA. 60+00 TO STA. 68+00
VEGAS DRIVE

DESIGN R.L.G.	BOYLE ENGINEERING	SHEET NO.	2
DRAWN G.M.B.A.H.	1700 COMMERCE ST. LAS VEGAS, NEVADA	C.A.N.	07-0947-00-00
DATE	3-29-71	OF 15 SHEETS	

107-V912