


CITY OF LAS VEGAS

75+00 TO 77+65 EXCAVATE FROM R/W TO R/W EXIST. MATERIAL TO CALICHE (SEE DB-5 & DB-6) AND BACKFILL WITH TYPE II GRAVEL BASE MATERIAL WITH 6" LIFTS COMPACTED TO 95% RELATIVE DENSITY. USE EXTREME CAUTION TO EXCAVATION IN VICINITY OF EXIST. GAS MAINS. NOTIFY UTILITY AGENCIES 24 HOURS PRIOR TO EXCAVATING IN THIS AREA.

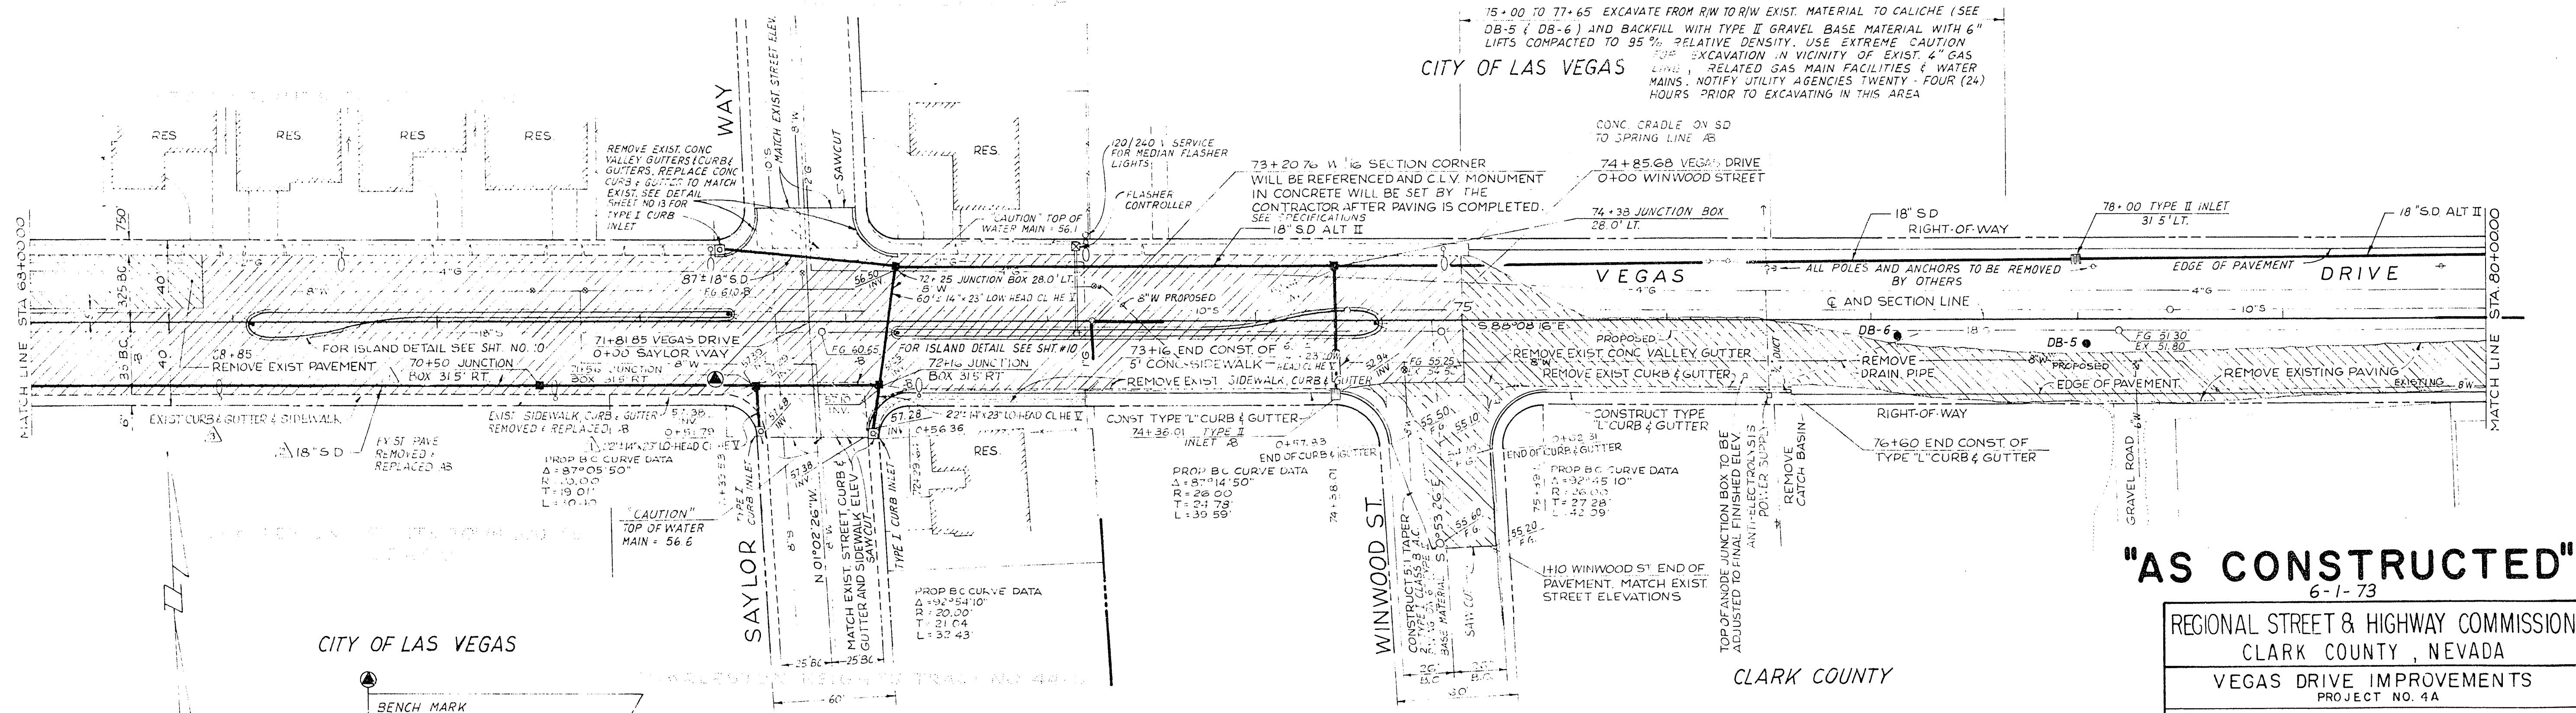

CITY OF LAS VEGAS

CLARK COUNTY

**"AS CONSTRUCTED"**  
6-1-73

REGIONAL STREET & HIGHWAY COMMISSION  
CLARK COUNTY, NEVADA

VEGAS DRIVE IMPROVEMENTS  
PROJECT NO. 4A

PLAN AND PROFILE AND NUISANCE WATER DRAIN  
STA. 68+00 TO STA. 80+00  
VEGAS DRIVE

SCALE HORIZ 1"=40'  
VERT 1"=4'

BENCH MARK  
Rivet and aluminum plate stamped  
C.L.V. # 060 25 34 on top of 5" x 4" curb return of Saylor Way and Vegas Drive  
Elevation = 2261.14  
Note: This B.M. will be disturbed during construction.

|         |            |   |  |
|---------|------------|---|--|
| DESIGN  | R.L.G.     | BOYLE ENGINEERING                       | 1209 COMMERCIAL ST., LAS VEGAS, NEVADA |
| DRAWING | G.M.B.A.H. |   |  |
| DATE    | 3-29-71    |   |  |
| APP     | C.A.N.     |   |  |
| CHECKED | S.C.D.     |   |  |
| REV.    | DATE       | DESCRIPTION                             |  |
| 1       | 10-22-71   | ADD EXISTING IMPROVEMENTS               |  |
| 2       | 10-22-71   | CHANGE 18" RCP 40.0 D TO 18" S.D. (TYP) |  |
| 3       | 10-22-71   | ADD STORM DRAIN - JOINER TO SAYLOR      |  |