


SCALE: HORIZ 1"=40'  
VERT 1"=4'

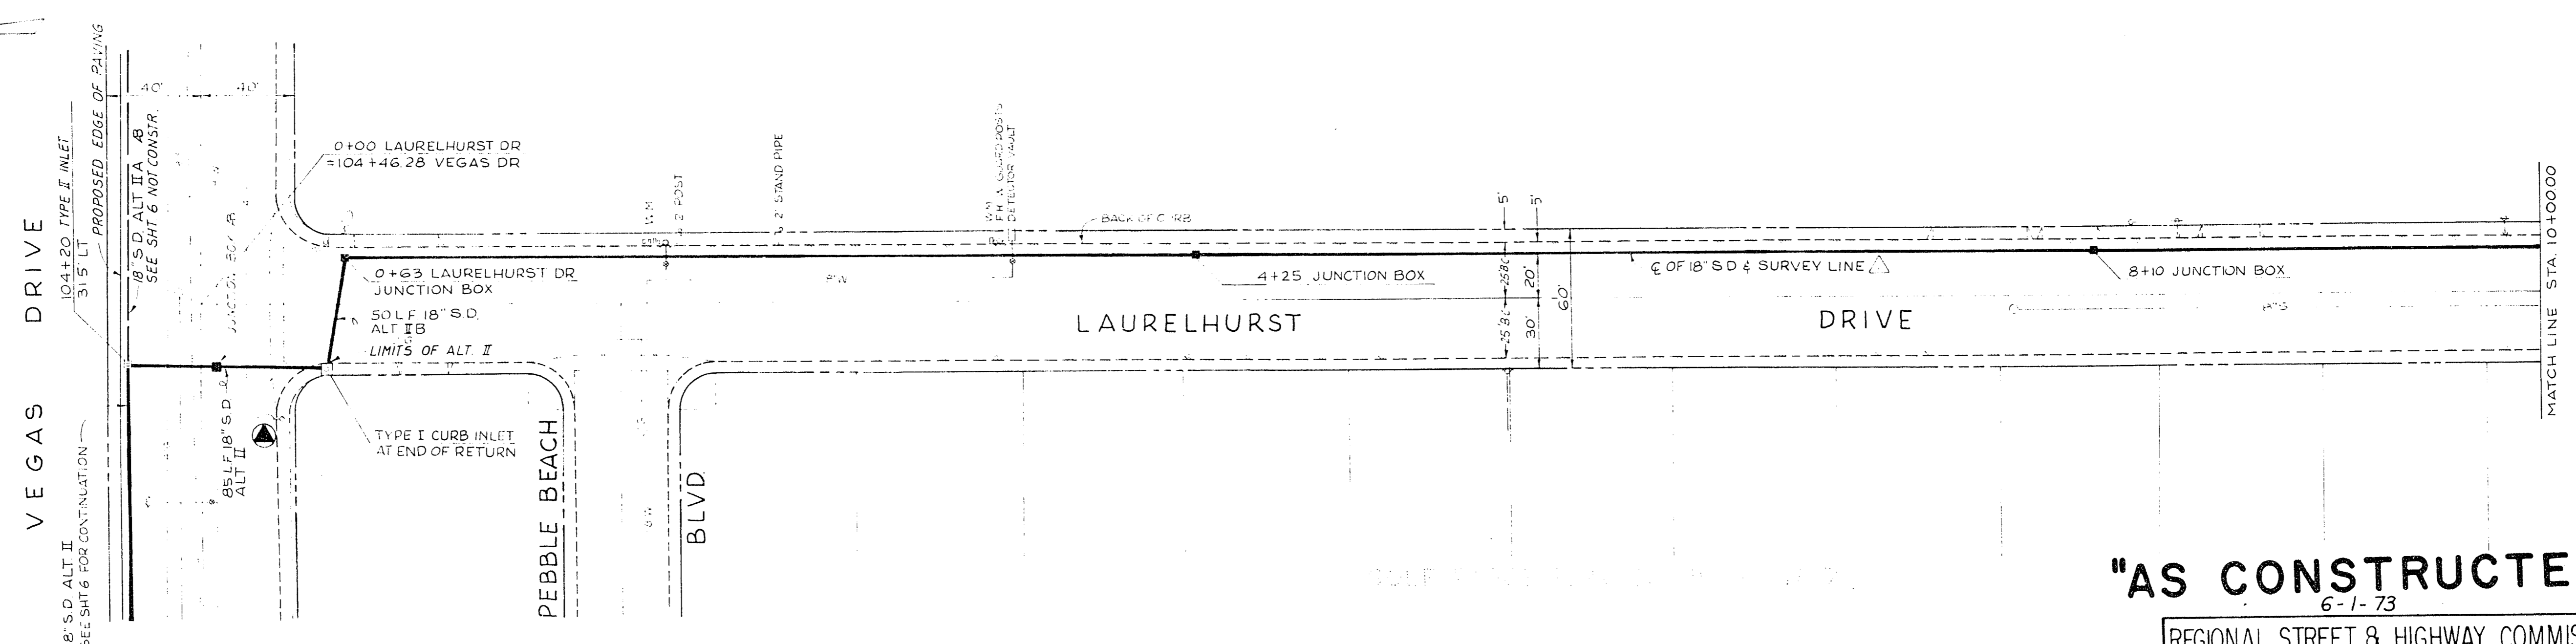

**BENCH MARK**  
Rivet and aluminum plate stamped  
C.L.V. = 06025.45 on top of SW curb  
return of Vegas Dr and Laurelhurst St.  
Elevation = 2215.98

**"AS CONSTRUCTED"**  
6-1-73

REGIONAL STREET & HIGHWAY COMMISSION  
CLARK COUNTY, NEVADA  
VEGAS DRIVE IMPROVEMENTS  
PROJECT NO. 4A  
NUISANCE WATER DRAIN  
ALT II B STA. 0+00 TO STA. 10+00  
LAURELHURST DRIVE

DESIGN: R.L.G.	BOYLE ENGINEERING	SHEET NO.
DRAWN: GIMBAH	1209 COMMERCE ST. LAS VEGAS, NEVADA	7
CHECKED: S.C.D.	DATE: 3-29-71	C.A.N.
APP:	DATE:	07-0947-00-00 OF 15 SHEETS

107-V 912