



① Street Section Vegas Drive
Station 75+00 to 86+40

② Street Section Vegas Drive
Station 76+60 to 86+40

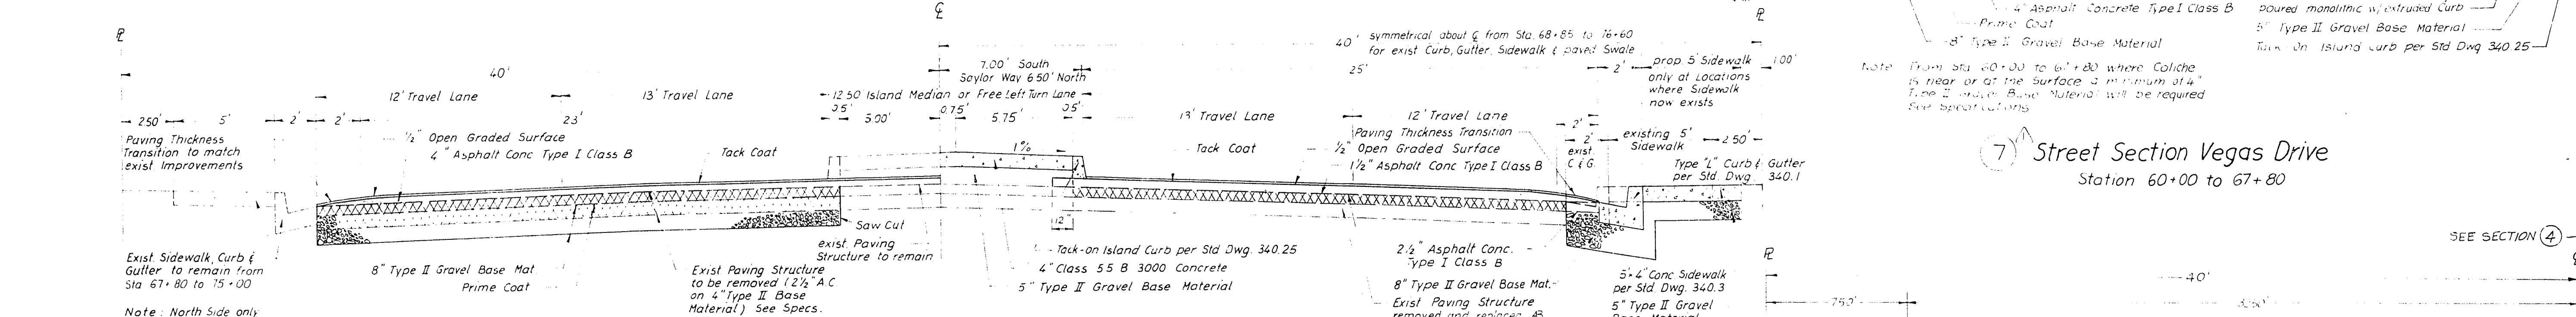


③ Street Section Vegas Drive
Station 67+80 to 68+85

④ Street Section Vegas Drive
Station 67+80 to 76+60

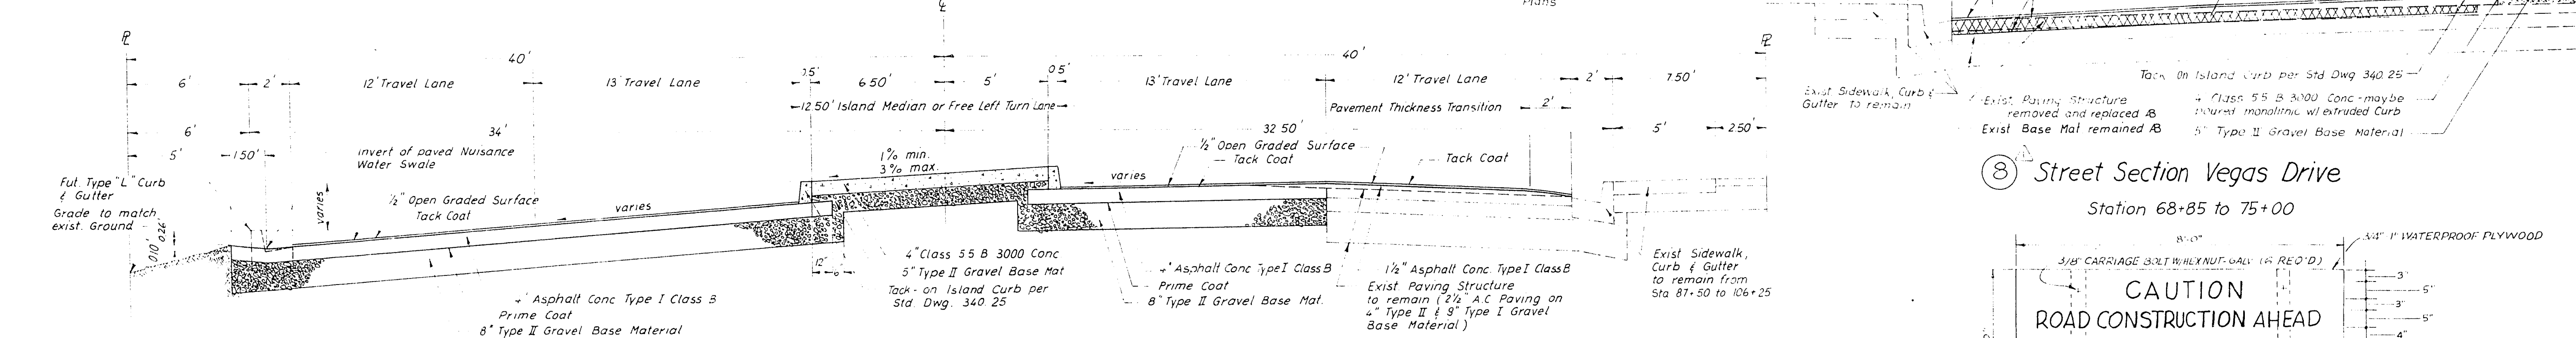


⑤ Street Section Vegas Drive
Station 86+40 to 106+25

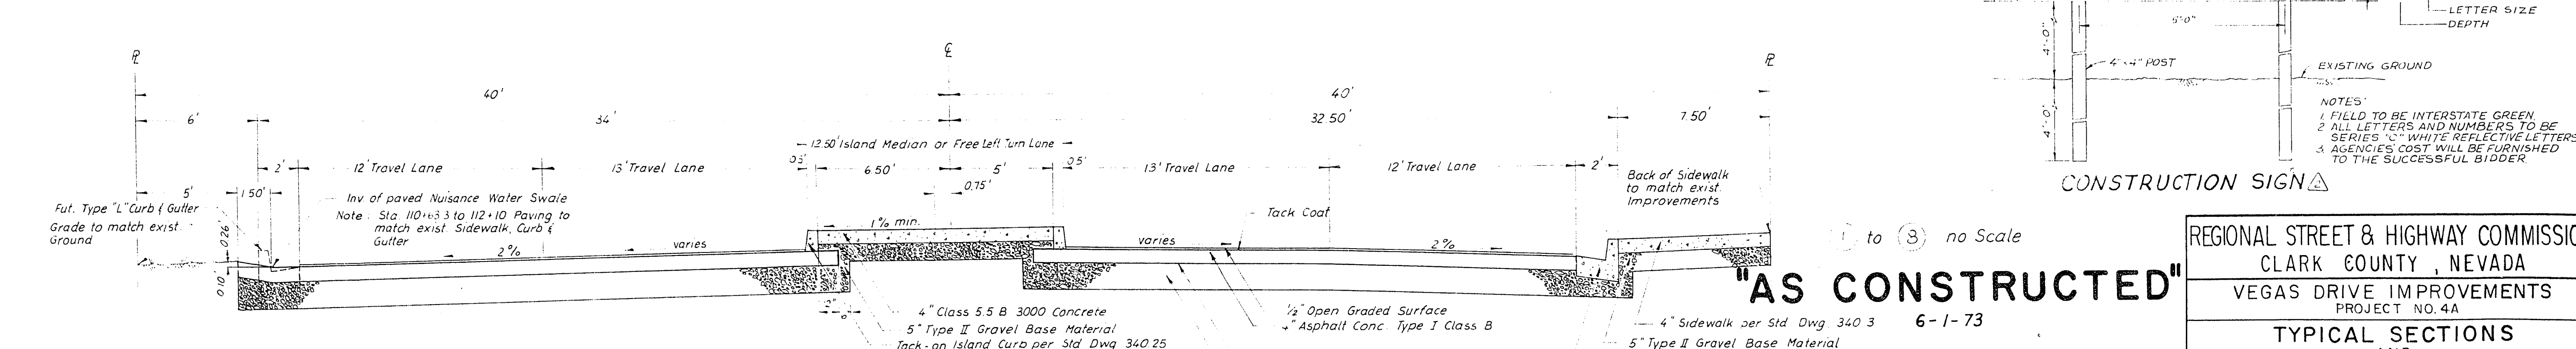

⑥ Street Section Vegas Drive
Station 106+25 to 112+10
except as noted

⑦ Street Section Vegas Drive
Station 60+00 to 67+80

⑧ Street Section Vegas Drive
Station 68+85 to 75+00

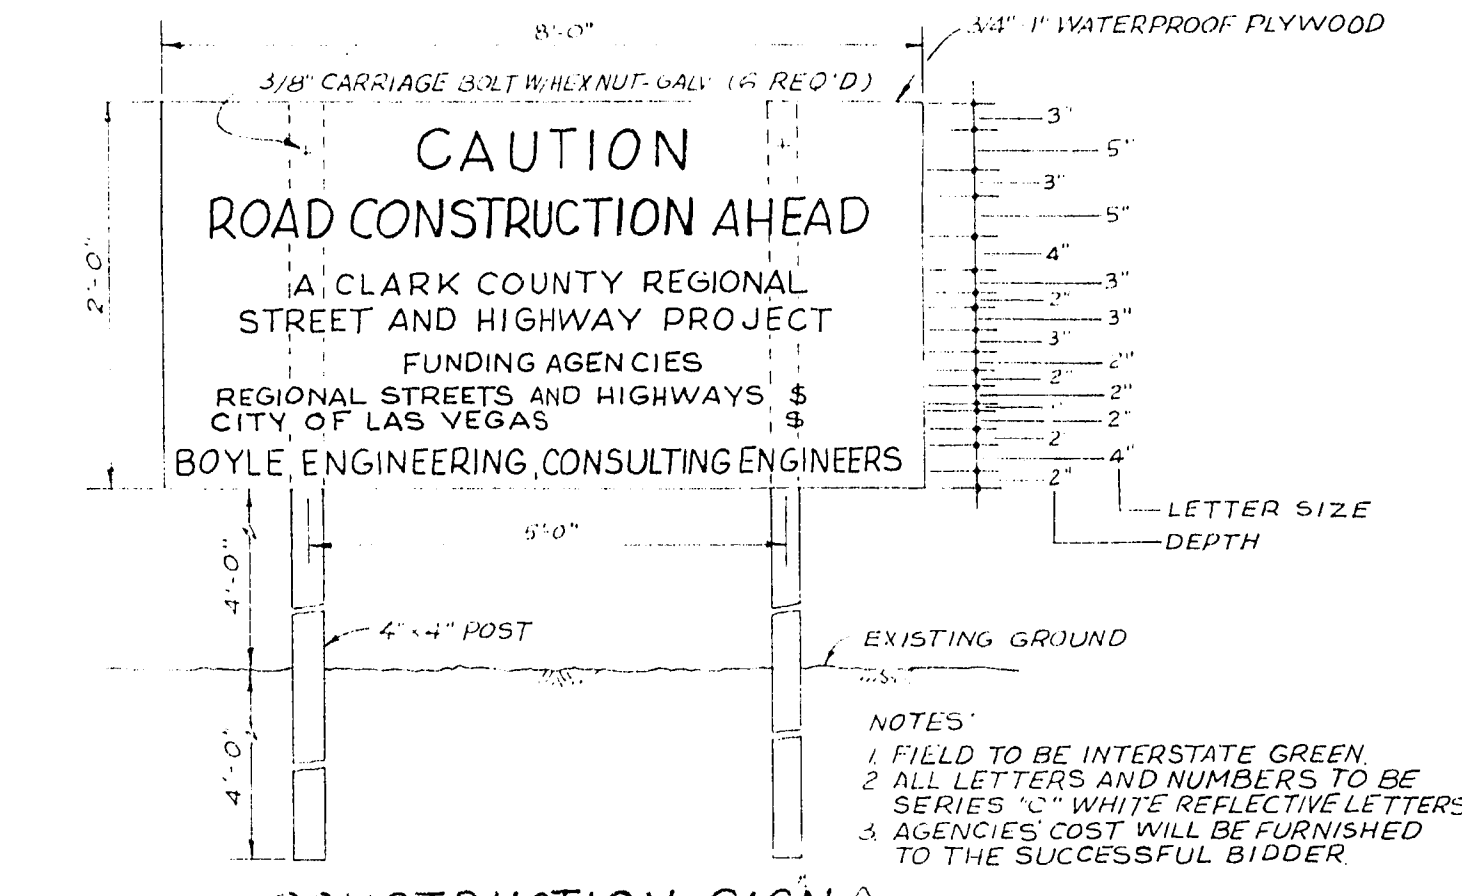

"AS CONSTRUCTED"

REGIONAL STREET & HIGHWAY COMMISSION	
CLARK COUNTY, NEVADA	
VEGAS DRIVE IMPROVEMENTS	
PROJECT NO. 4A	
TYPICAL SECTIONS	
AND	
CONSTRUCTION DETAILS	
DATE: 3-29-71	BY: CAN
PROJECT: 070947-00-00	DATE: 15

3-21-72	ADDED CONSTRUCTION SIGN	BY: RLG
3-24-72	ADDED (8) STREET SECTION - VEGAS DRIVE	BY: G.M.
		BY: SCD

214-142 107-V912