


12-1-20

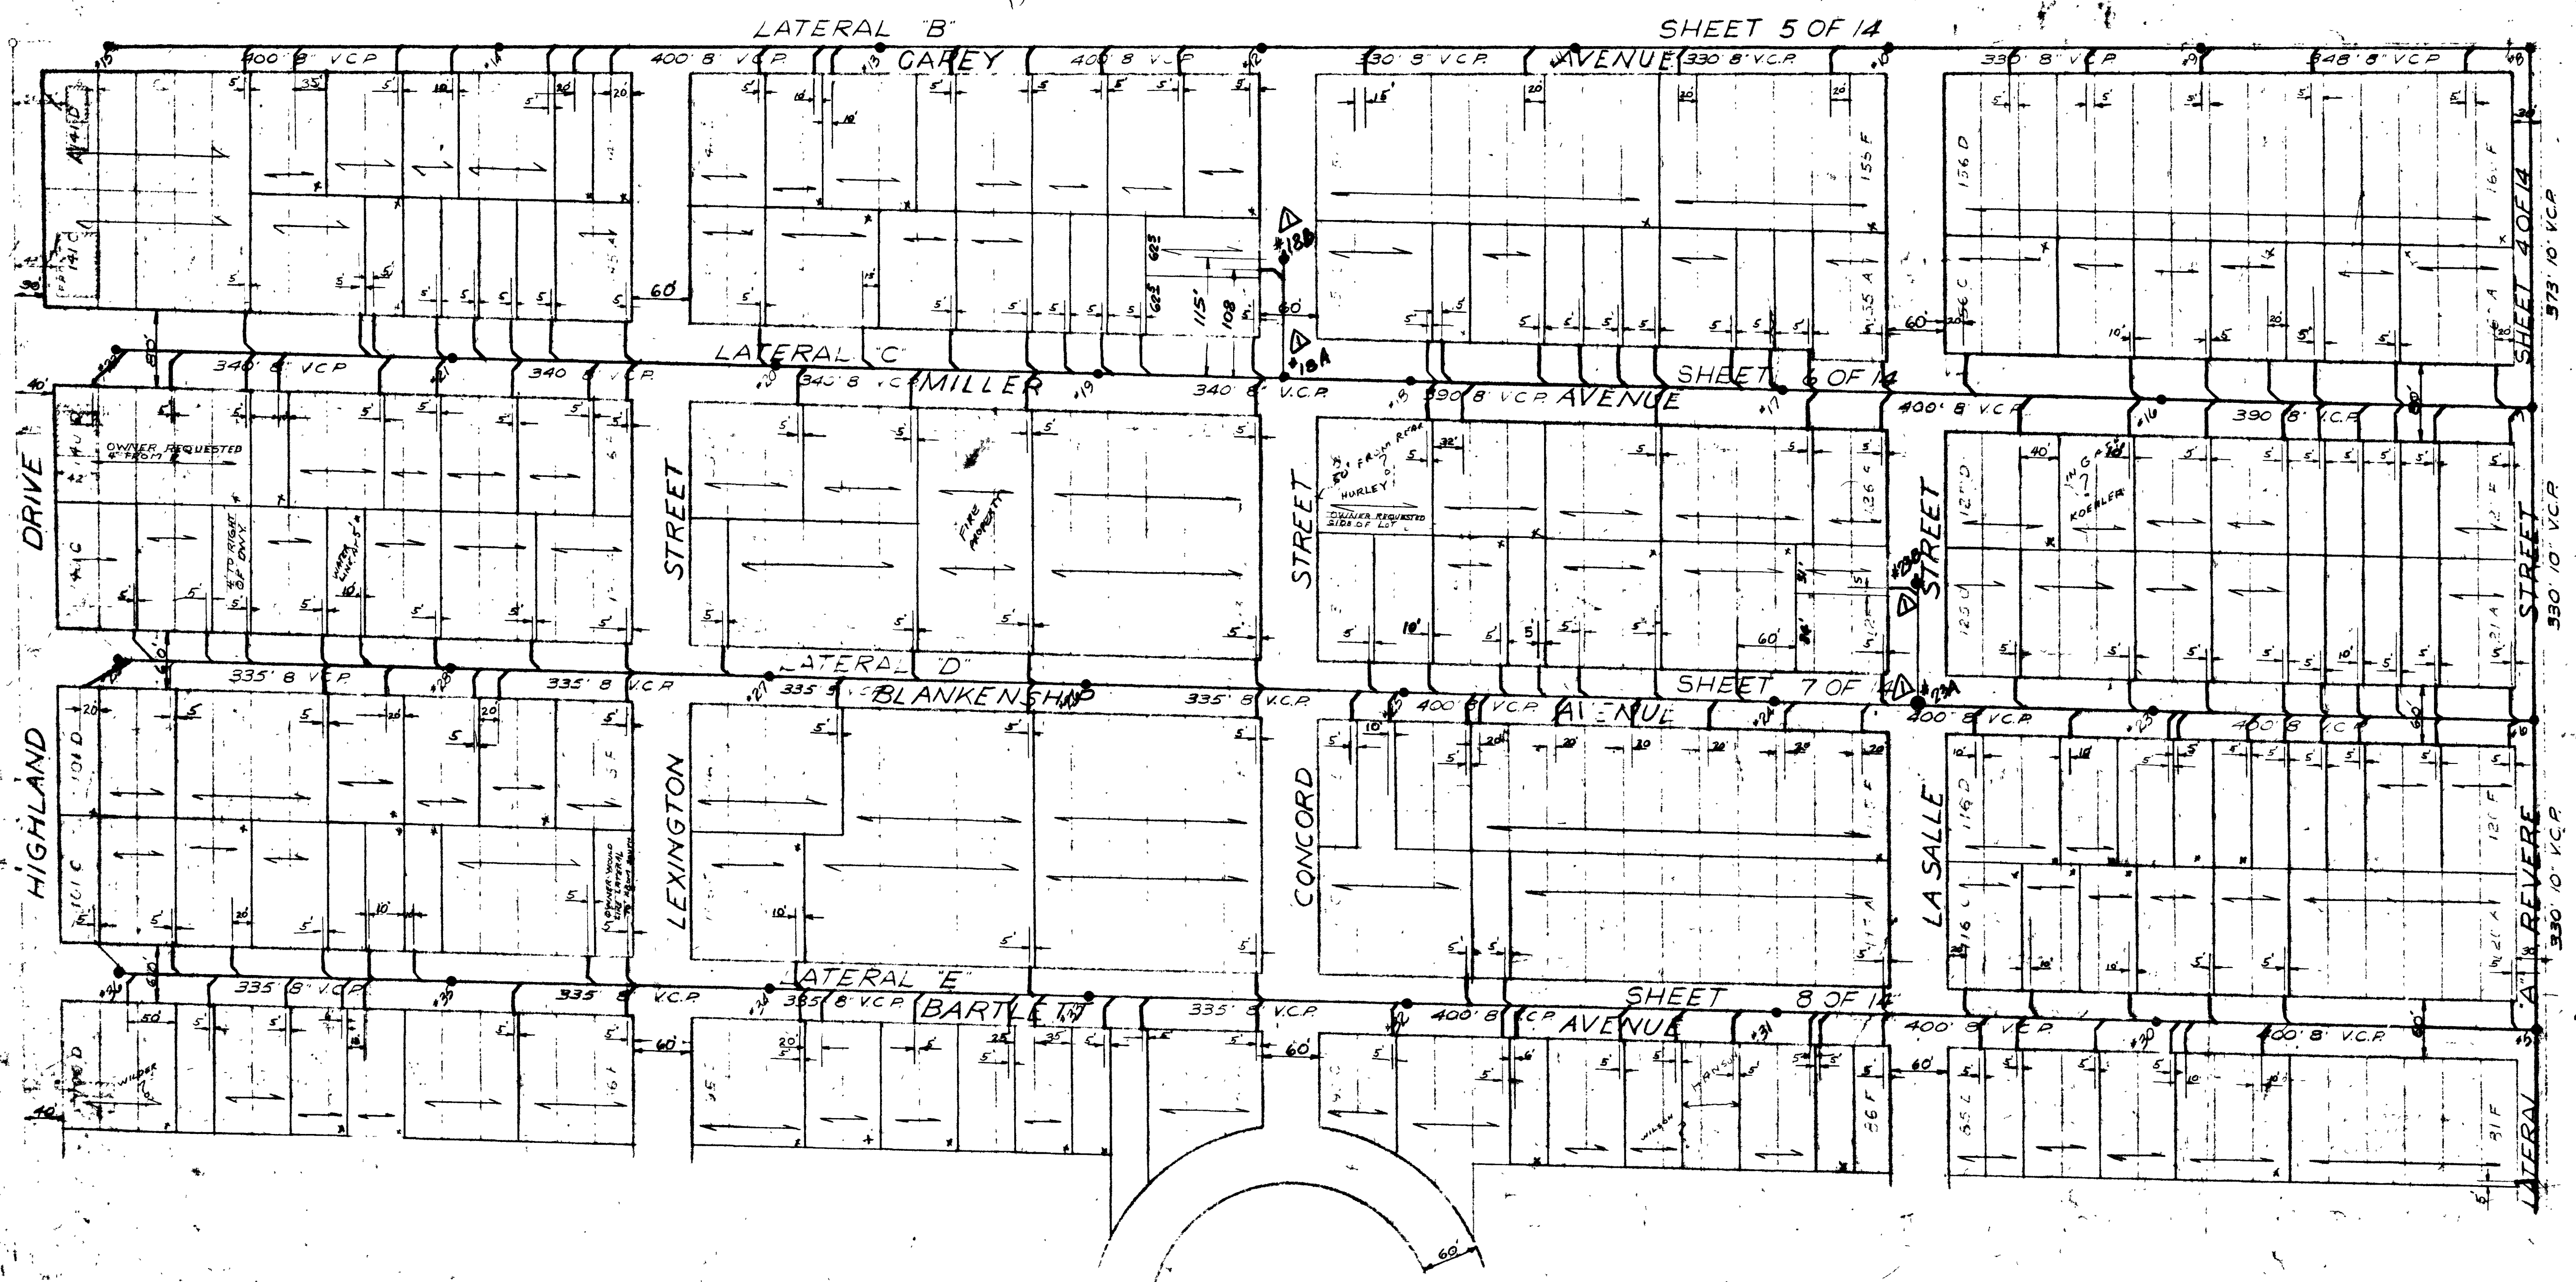


11-23-65 Revision-A MH² & 240 SVCR ADDED
195 Sewer Laterals Added
REV'D APPROVED BY *[Signature]* DATE 11-24-68
CITY ENGINEER
APPROVED BY *[Signature]* DATE 11-23-68
SURT. OF SANITATION

SAD 467 307-VPI

CITY OF LAS VEGAS NEVADA ENGINEERING DEPT.		
VEGAS HEIGHTS S.A.D. OVERALL SANITARY SEWER PLAN		
DATE 11-23-68	SCALE AS SHOWN	PROJECT NO. 467
APPROVED BY CITY ENGINEER <i>[Signature]</i>		

CONTRACT
DRAWING
JUNE 7 1965
11-23-68

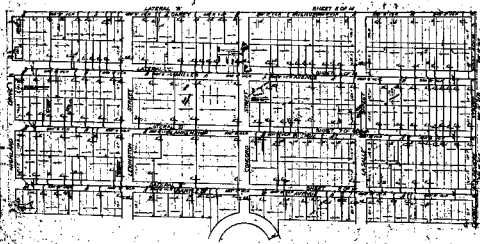

APPROVED FOR THE CITY OF LAS VEGAS
 ENGINEERING DEPT.
 12-1-50

UNITED STATES

CITY OF LAS VEGAS, NEVADA	
ENGINEERING DEPT.	
NO.	12-1-50
DATE	12-1-50
BY	12-1-50
FOR	12-1-50
REMARKS	12-1-50