


1A-1-62

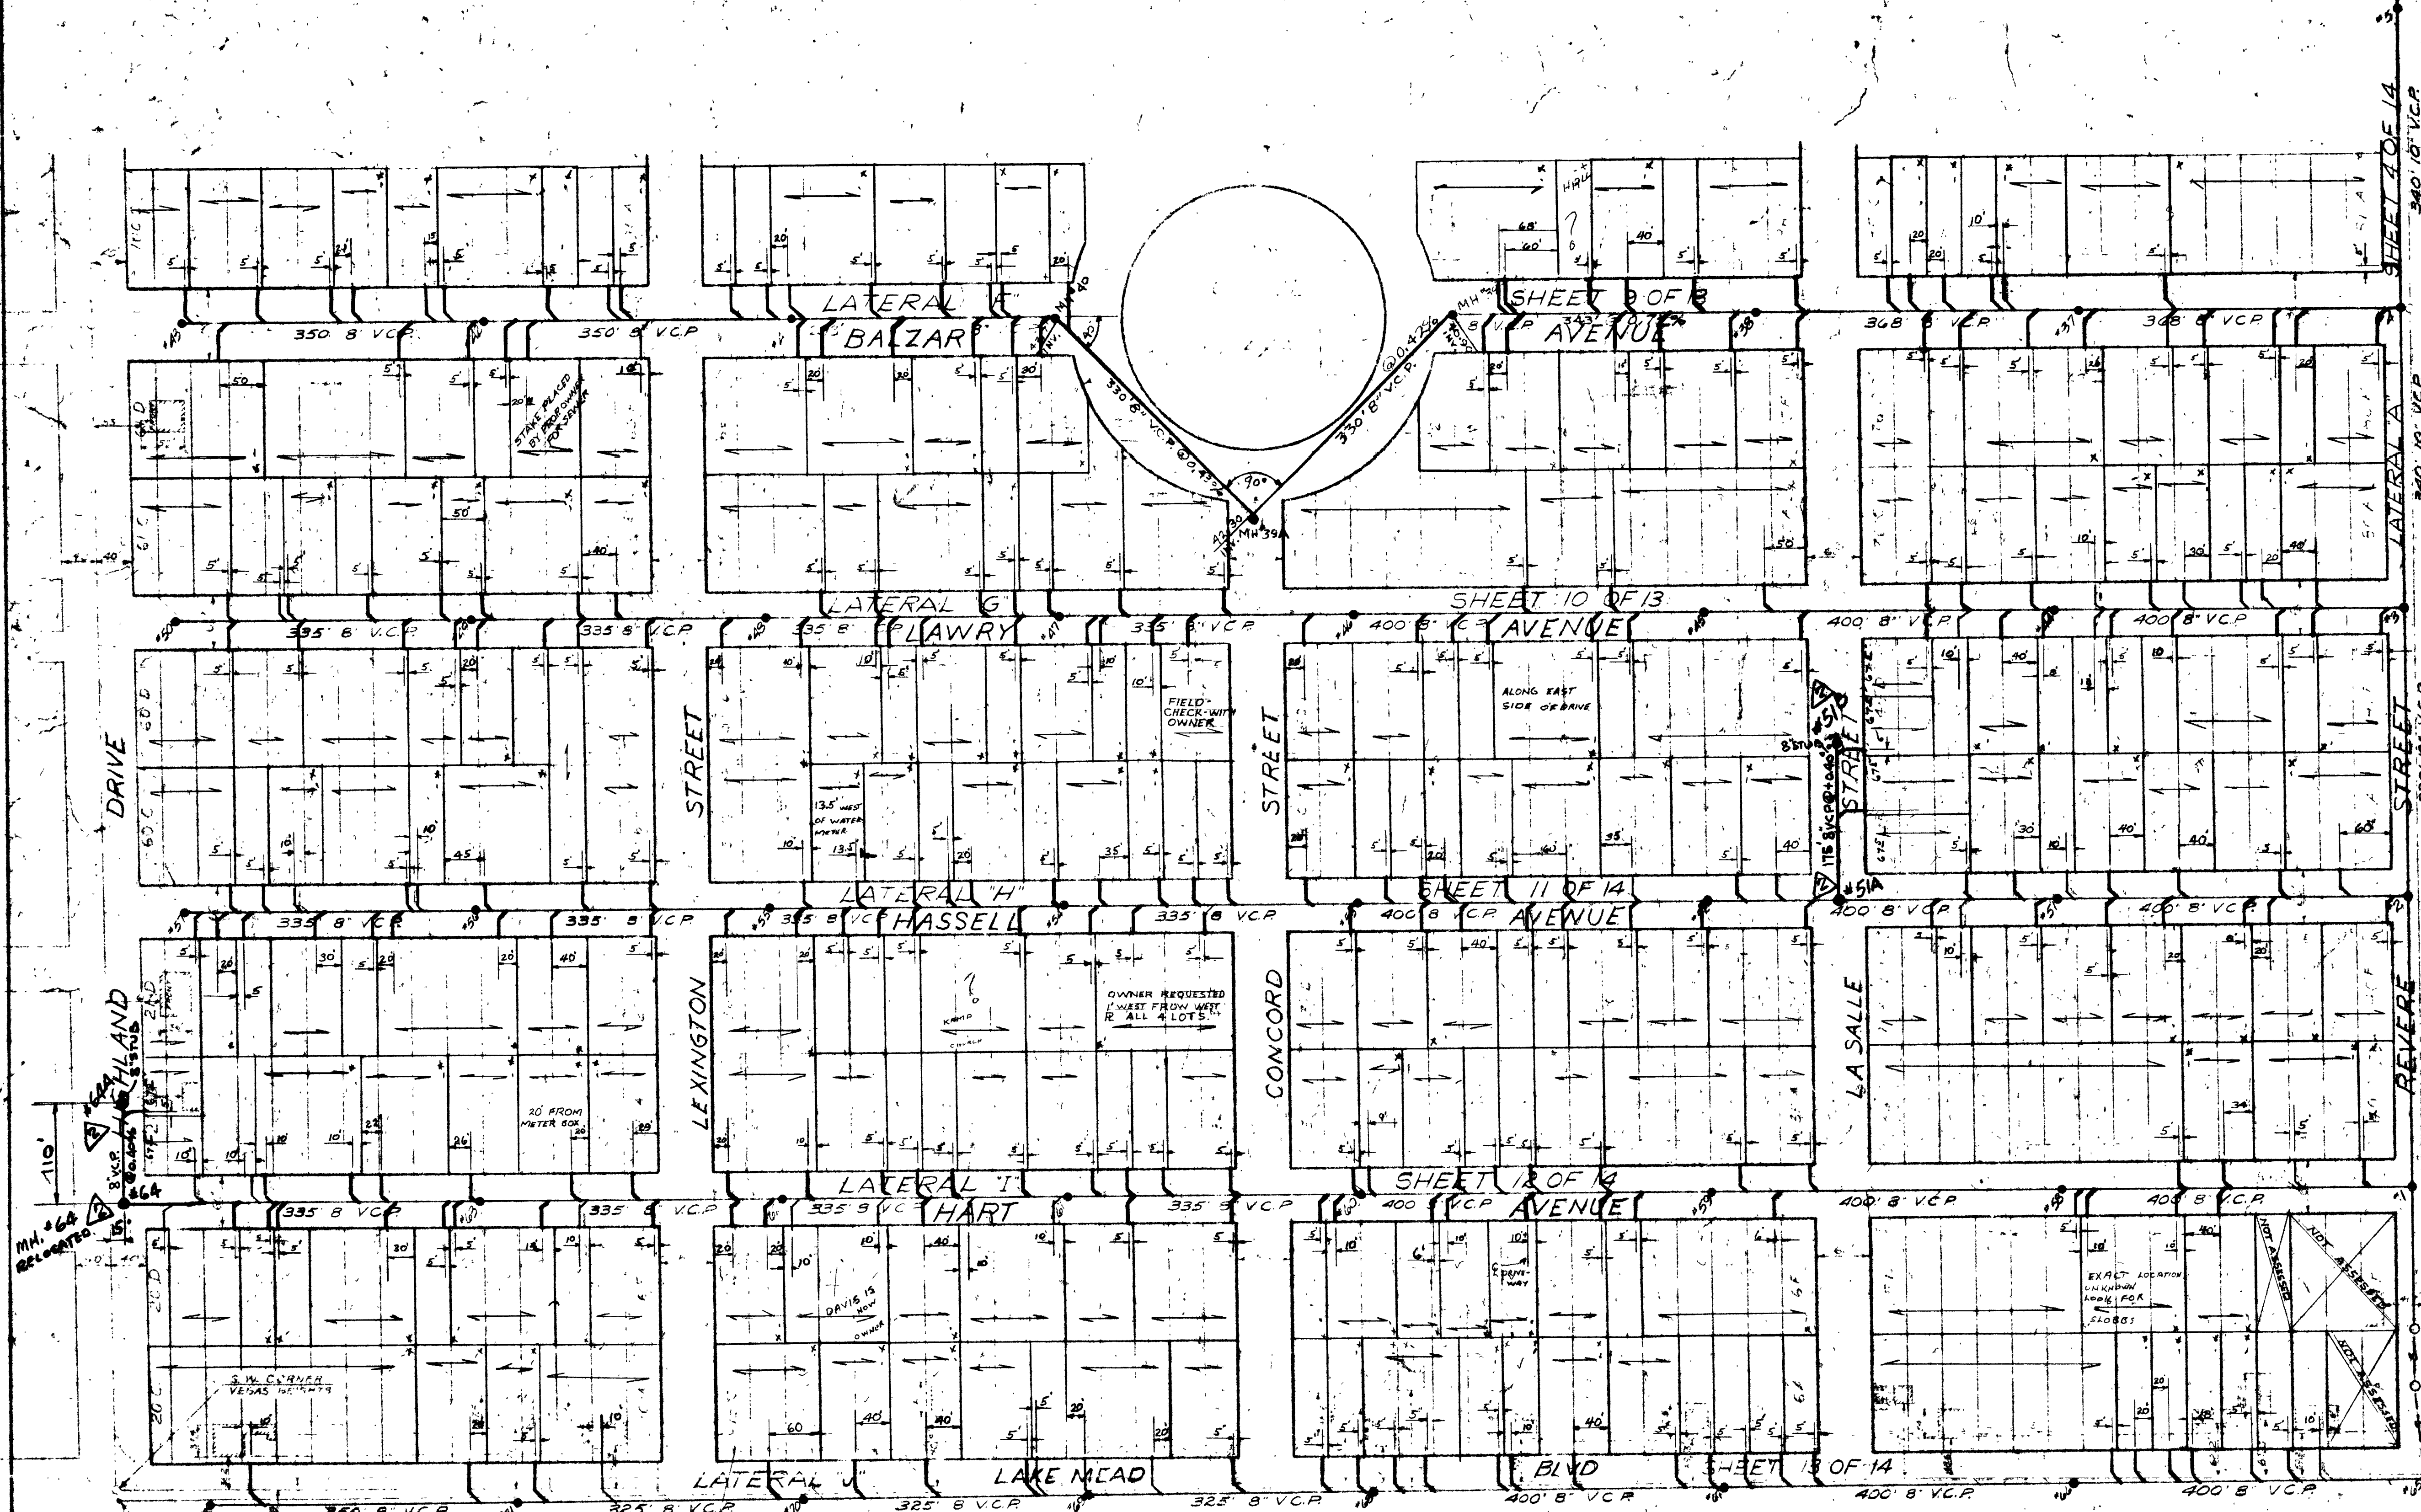

LEGEND
BUILDINGS FROM SURVEY DATA
BUILDINGS FROM AERIAL PHOTO
EXISTING UTILITIES SHOWN ON PLAN & PROFILE
NOTE: EXISTING UTILITIES ARE LOCATED ON THE PLANS FOR THE CONVENIENCE OF THE CONTRACTOR ONLY. THE CONTRACTOR SHALL BEAR FULL RESPONSIBILITY FOR PROTECTION OF UTILITIES AND THE CITY BEARS NO RESPONSIBILITY FOR UTILITIES NOT SHOWN ON THE PLANS OR NOT IN THE LOCATION SHOWN ON THE PLANS.

REVISION
SEWER ALIGNMENT MODIFIED TO REMAIN WITHIN EXISTING RIGHT OF WAY
APPROVED BY [Signature] 9/2/65
CITY ENGINEER

APPROVED BY [Signature] 11-23-65
Supt. of Sanitation
Revision 11-23-65 3 Manholes And 360' 8" V.C.P. Added, 278' Sewer
Laterals Added, M.H. 64 To Be Relocated
REV. APPROVED BY [Signature] 11-24-65
CITY ENGINEER DATE

S.A.D. 467

CITY OF LAS VEGAS NEVADA			
ENGINEERING DEPT. 307-VB1			
VEGAS HEIGHTS S.A.D. OVERALL SANITARY SEWER PLAN			
NO.	DATE	SCOR	BY
1	11-18-64	SCOR	DR. BOOD
2	11-25-64	SCOR	DR. W. B. BATES-ER
3	11-23-65	SCOR	DR. [Signature]
APPROVED BY CITY ENGINEER		DATE	4-3-66
[Signature]		DATE	4-3-66

CONTRACT
DRAWING
JUNE 7 1965
FEB 3 1965

